


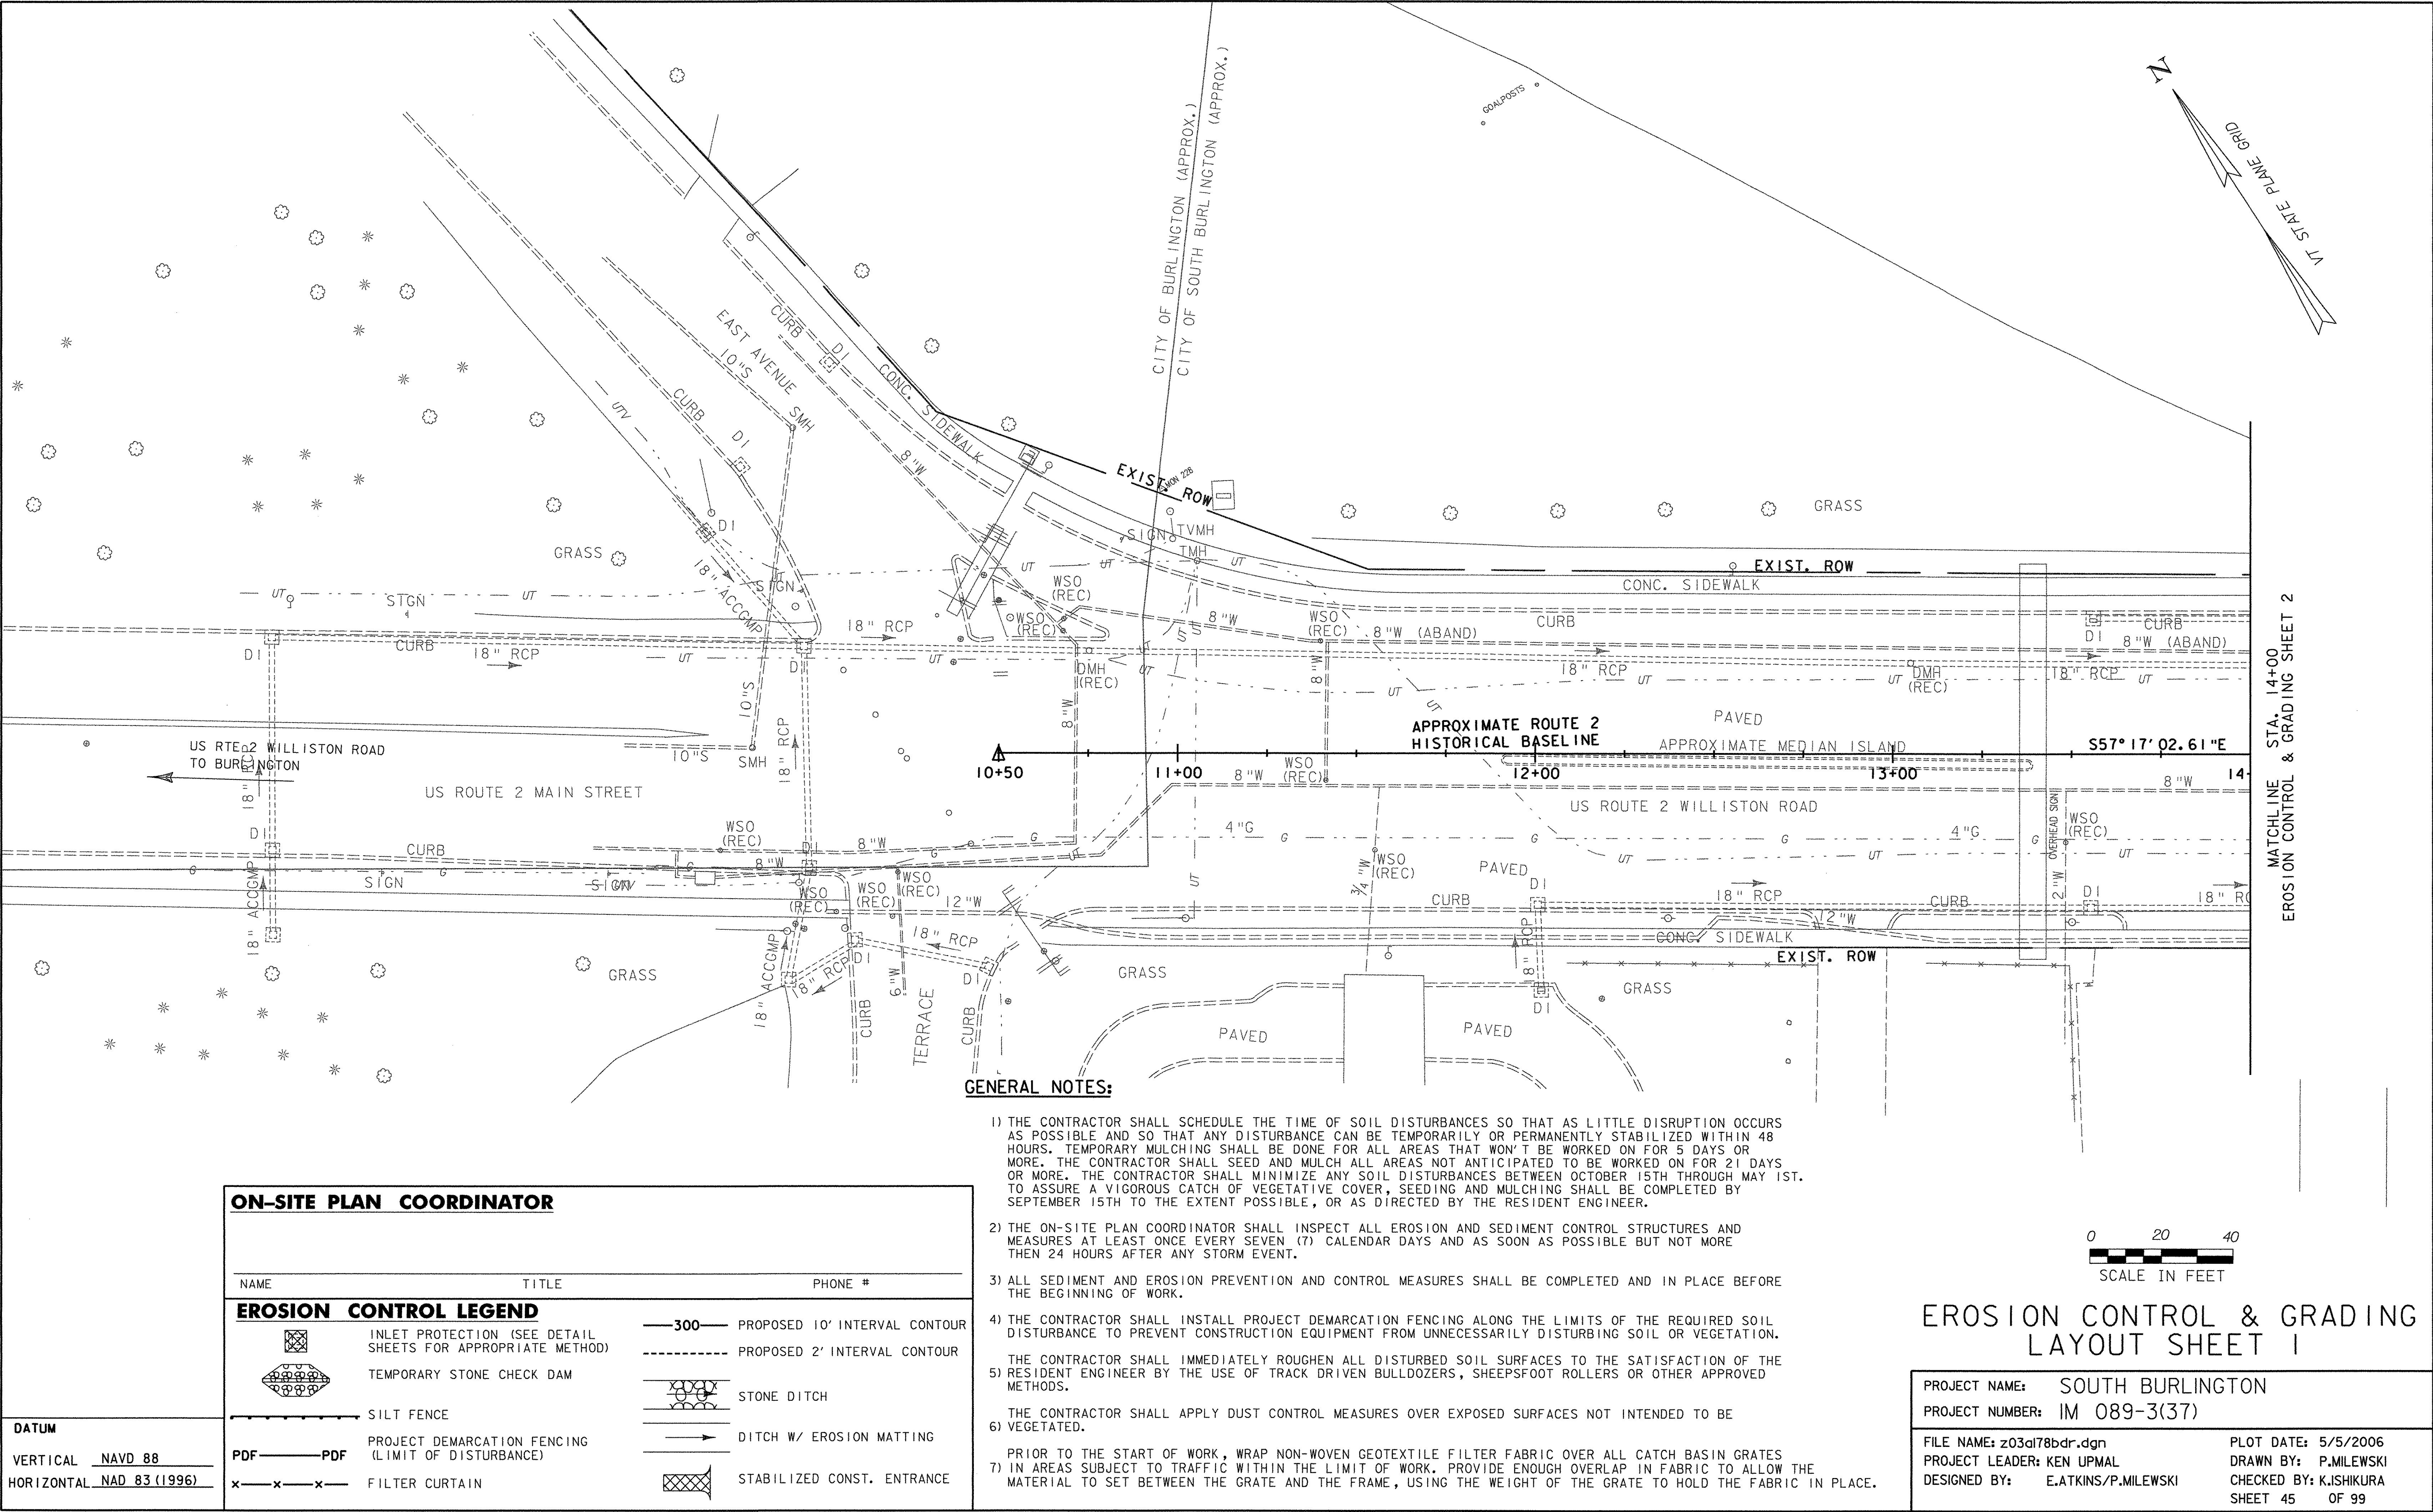

ON-SITE PLAN COORDINATOR

NAME	TITLE	PHONE #
EROSION CONTROL LEGEND		
	INLET PROTECTION (SEE DETAIL SHEETS FOR APPROPRIATE METHOD)	
	TEMPORARY STONE CHECK DAM	
	SILT FENCE	
	PROJECT DEMARCATION FENCING (LIMIT OF DISTURBANCE)	
	FILTER CURTAIN	
	PROPOSED 10' INTERVAL CONTOUR	
	PROPOSED 2' INTERVAL CONTOUR	
	STONE DITCH	
	DITCH W/ EROSION MATTING	
	STABILIZED CONST. ENTRANCE	

EROSION CONTROL & GRADING LAYOUT SHEET 1

PROJECT NAME:	SOUTH BURLINGTON	PLOT DATE:	5/5/2006
PROJECT NUMBER:	IM 089-3(37)	DRAWN BY:	P.MILEWSKI
FILE NAME:	z03a178bdr.dgn	CHECKED BY:	K.JSHKURA
PROJECT LEADER:	KEN UPMAL	SHEET	45 OF 99
DESIGNED BY:	E.ATKINS/P.MILEWSKI		