



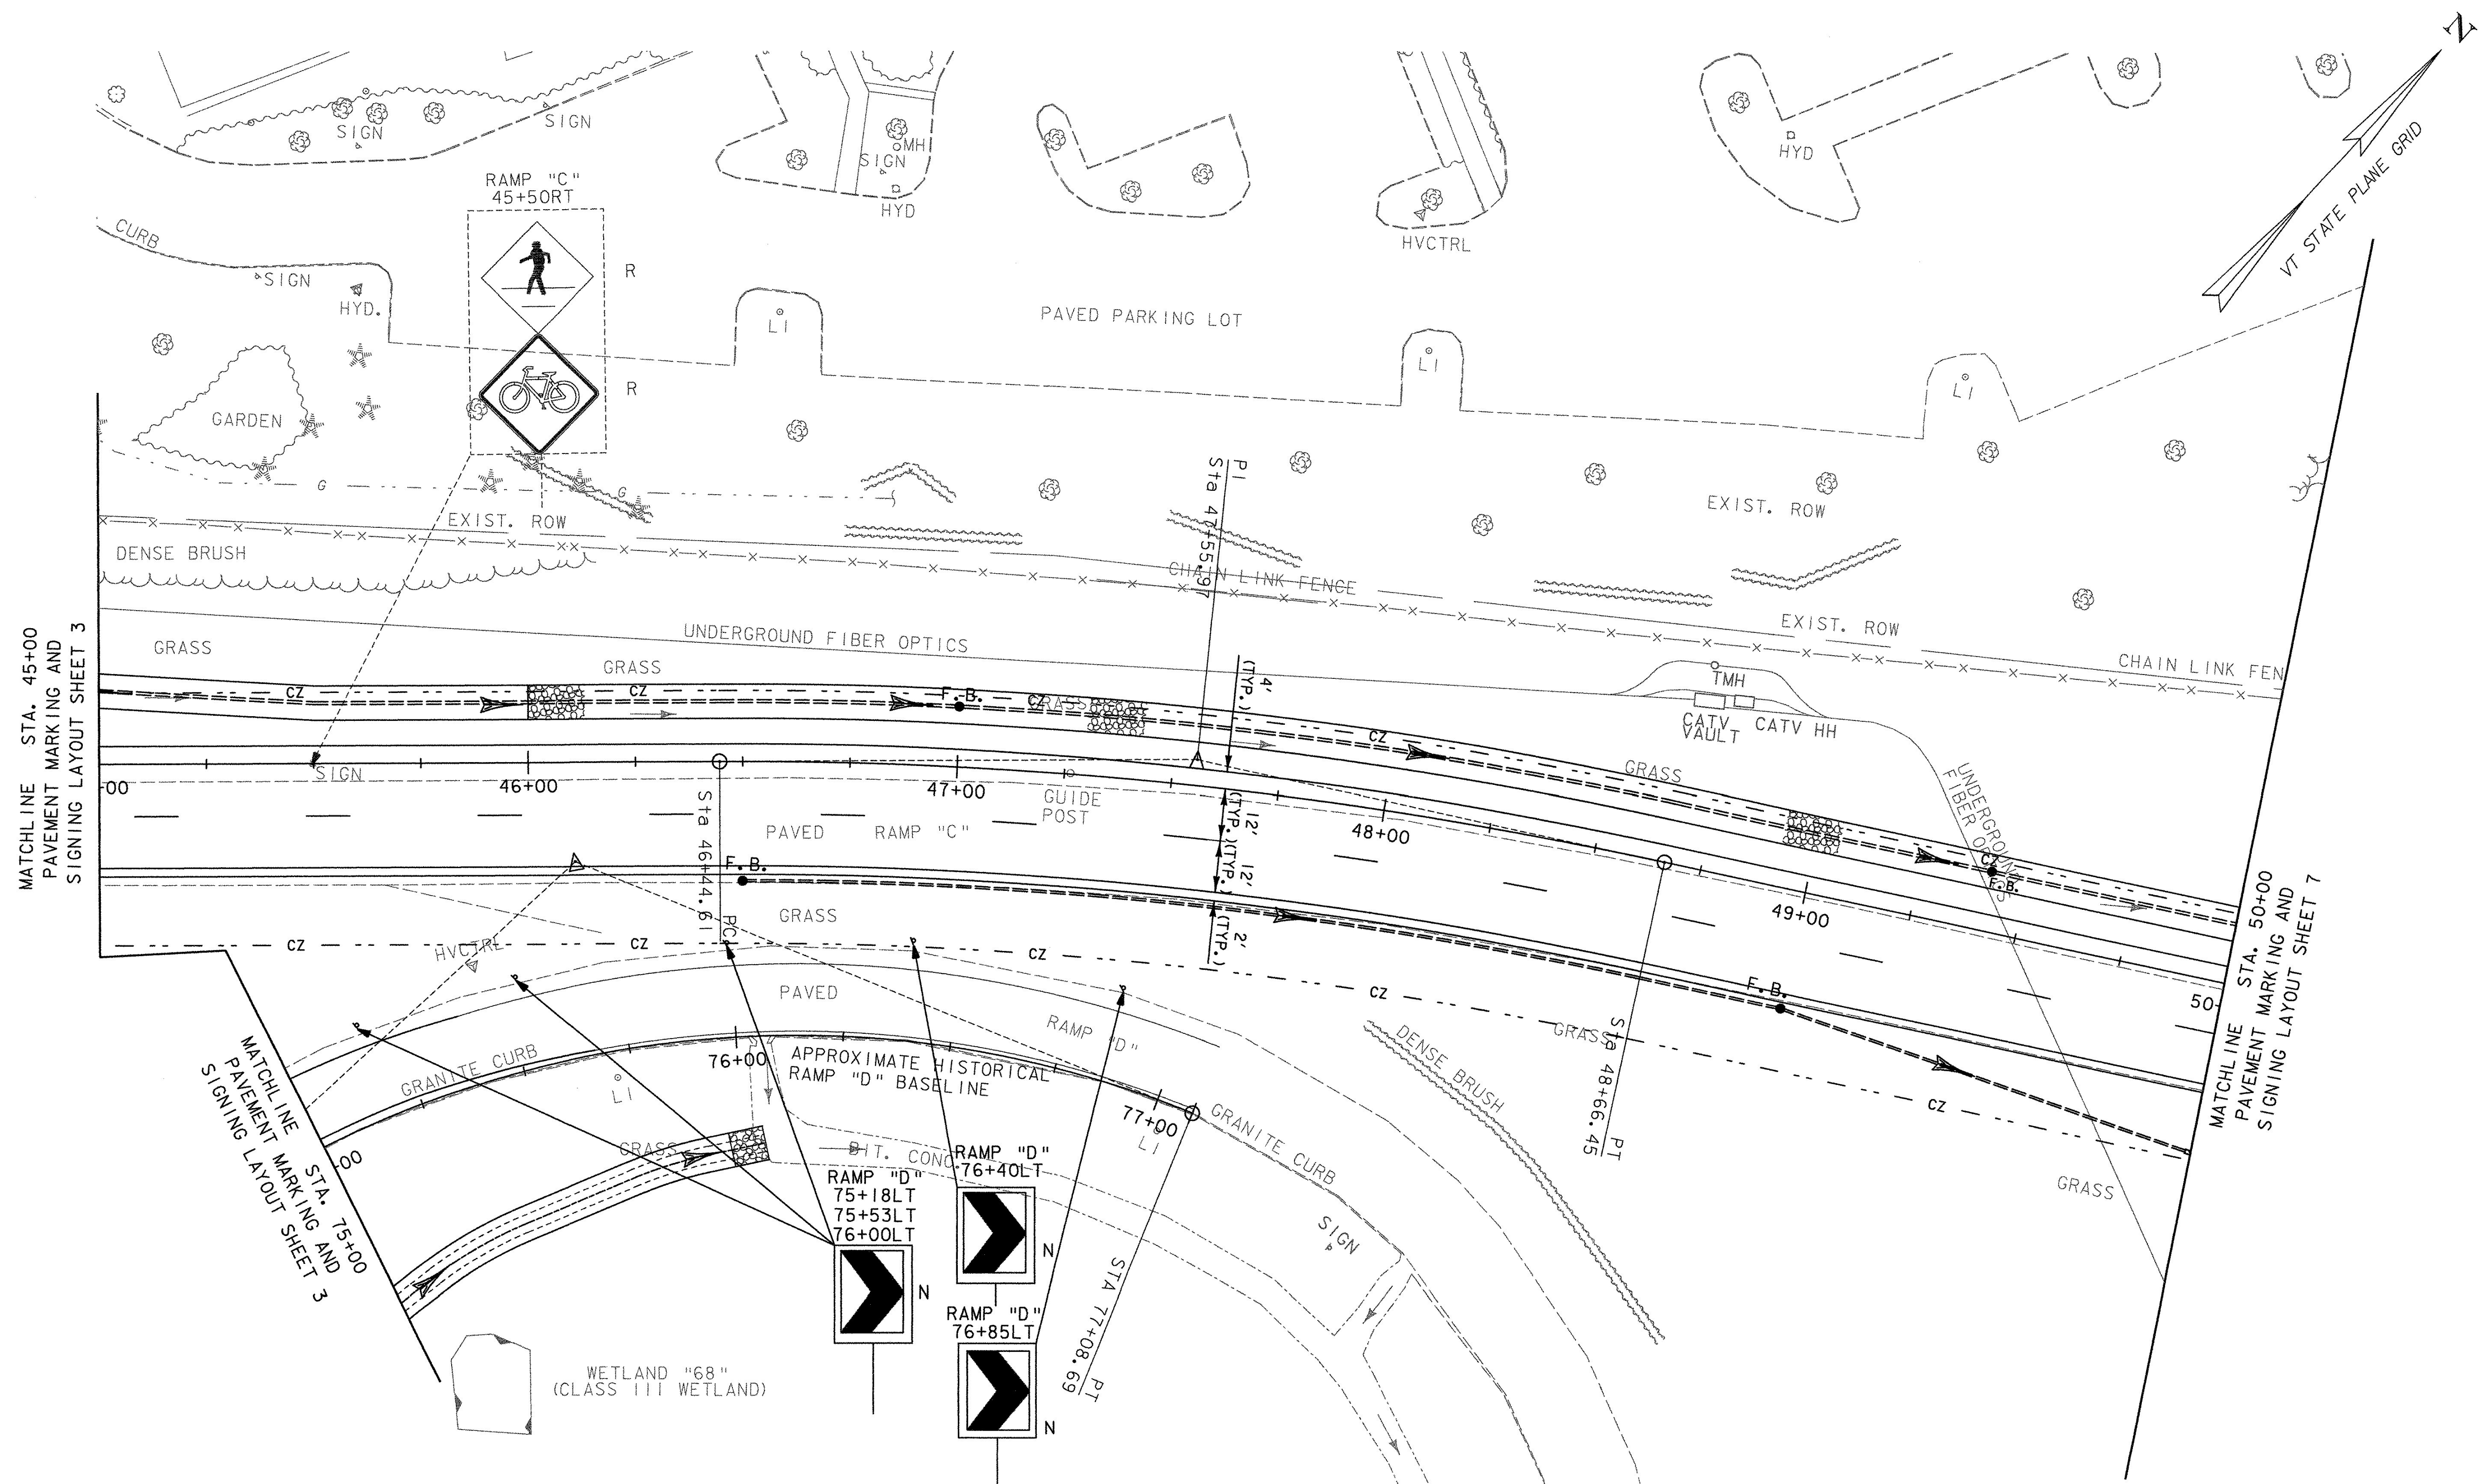

MATCHLINE STA. 45+00
PAVEMENT MARKING AND
SIGNING LAYOUT SHEET 3

MATCHLINE STA. 50+00
PAVEMENT MARKING AND
SIGNING LAYOUT SHEET 7

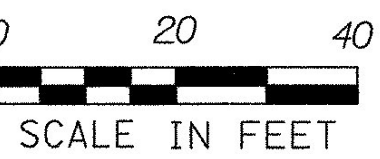

SIGN LEGEND	
[Symbol]	= EXISTING SIGN
[Symbol]	= NEW SIGN
R	= REMOVE EXISTING SIGN AND POST
R+S	= SALVAGE SIGN AND RELOCATE TO NOTED LOCATION WITH NEW SIGN POST, REMOVE AND DISPOSE EXISTING SIGN POST
N	= NEW
RET	= RETAIN AT EXISTING LOCATION
B-B	= BACK TO BACK

DATUM
VERTICAL NAVD 88
HORIZONTAL NAD 83 (1996)

DURABLE 6" WHITE LINE
RAMP "C" 45+00 ~ 50+00, 500 LF
RAMP "C" 45+00 ~ 50+00, 13 X 10' = 130 LF
RAMP "D" 75+00 ~ 75+67, 67 LF

TEMPORARY 6" WHITE LINE
RAMP "C" 45+00 ~ 50+00, 500 LF
RAMP "C" 45+00 ~ 50+00, 13 X 10' = 130 LF
RAMP "D" 75+00 ~ 75+67, 67 LF

DURABLE 6" YELLOW LINE
RAMP "C" 45+00 ~ 50+00, 500 LF
RAMP "D" 75+00 ~ 75+39, 42 LF

TEMPORARY 6" YELLOW LINE
RAMP "C" 45+00 ~ 50+00, 500 LF
RAMP "D" 75+00 ~ 75+39, 42 LF

REMOVING SIGNS
2 EACH

PAVEMENT MARKING AND SIGNING LAYOUT SHEET 6

PROJECT NAME: SO. BURLINGTON I-89 RAMP "C"
PROJECT NUMBER: IM 089-3(37)

FILE NAME: z03dl78pmbdr.dgn PLOT DATE: 5/5/2006
PROJECT LEADER: KEN UPMAL DRAWN BY: V.KACOYANNAKIS
DESIGNED BY: V.KACOYANNAKIS CHECKED BY: J.FORD
SHEET 59 OF 99