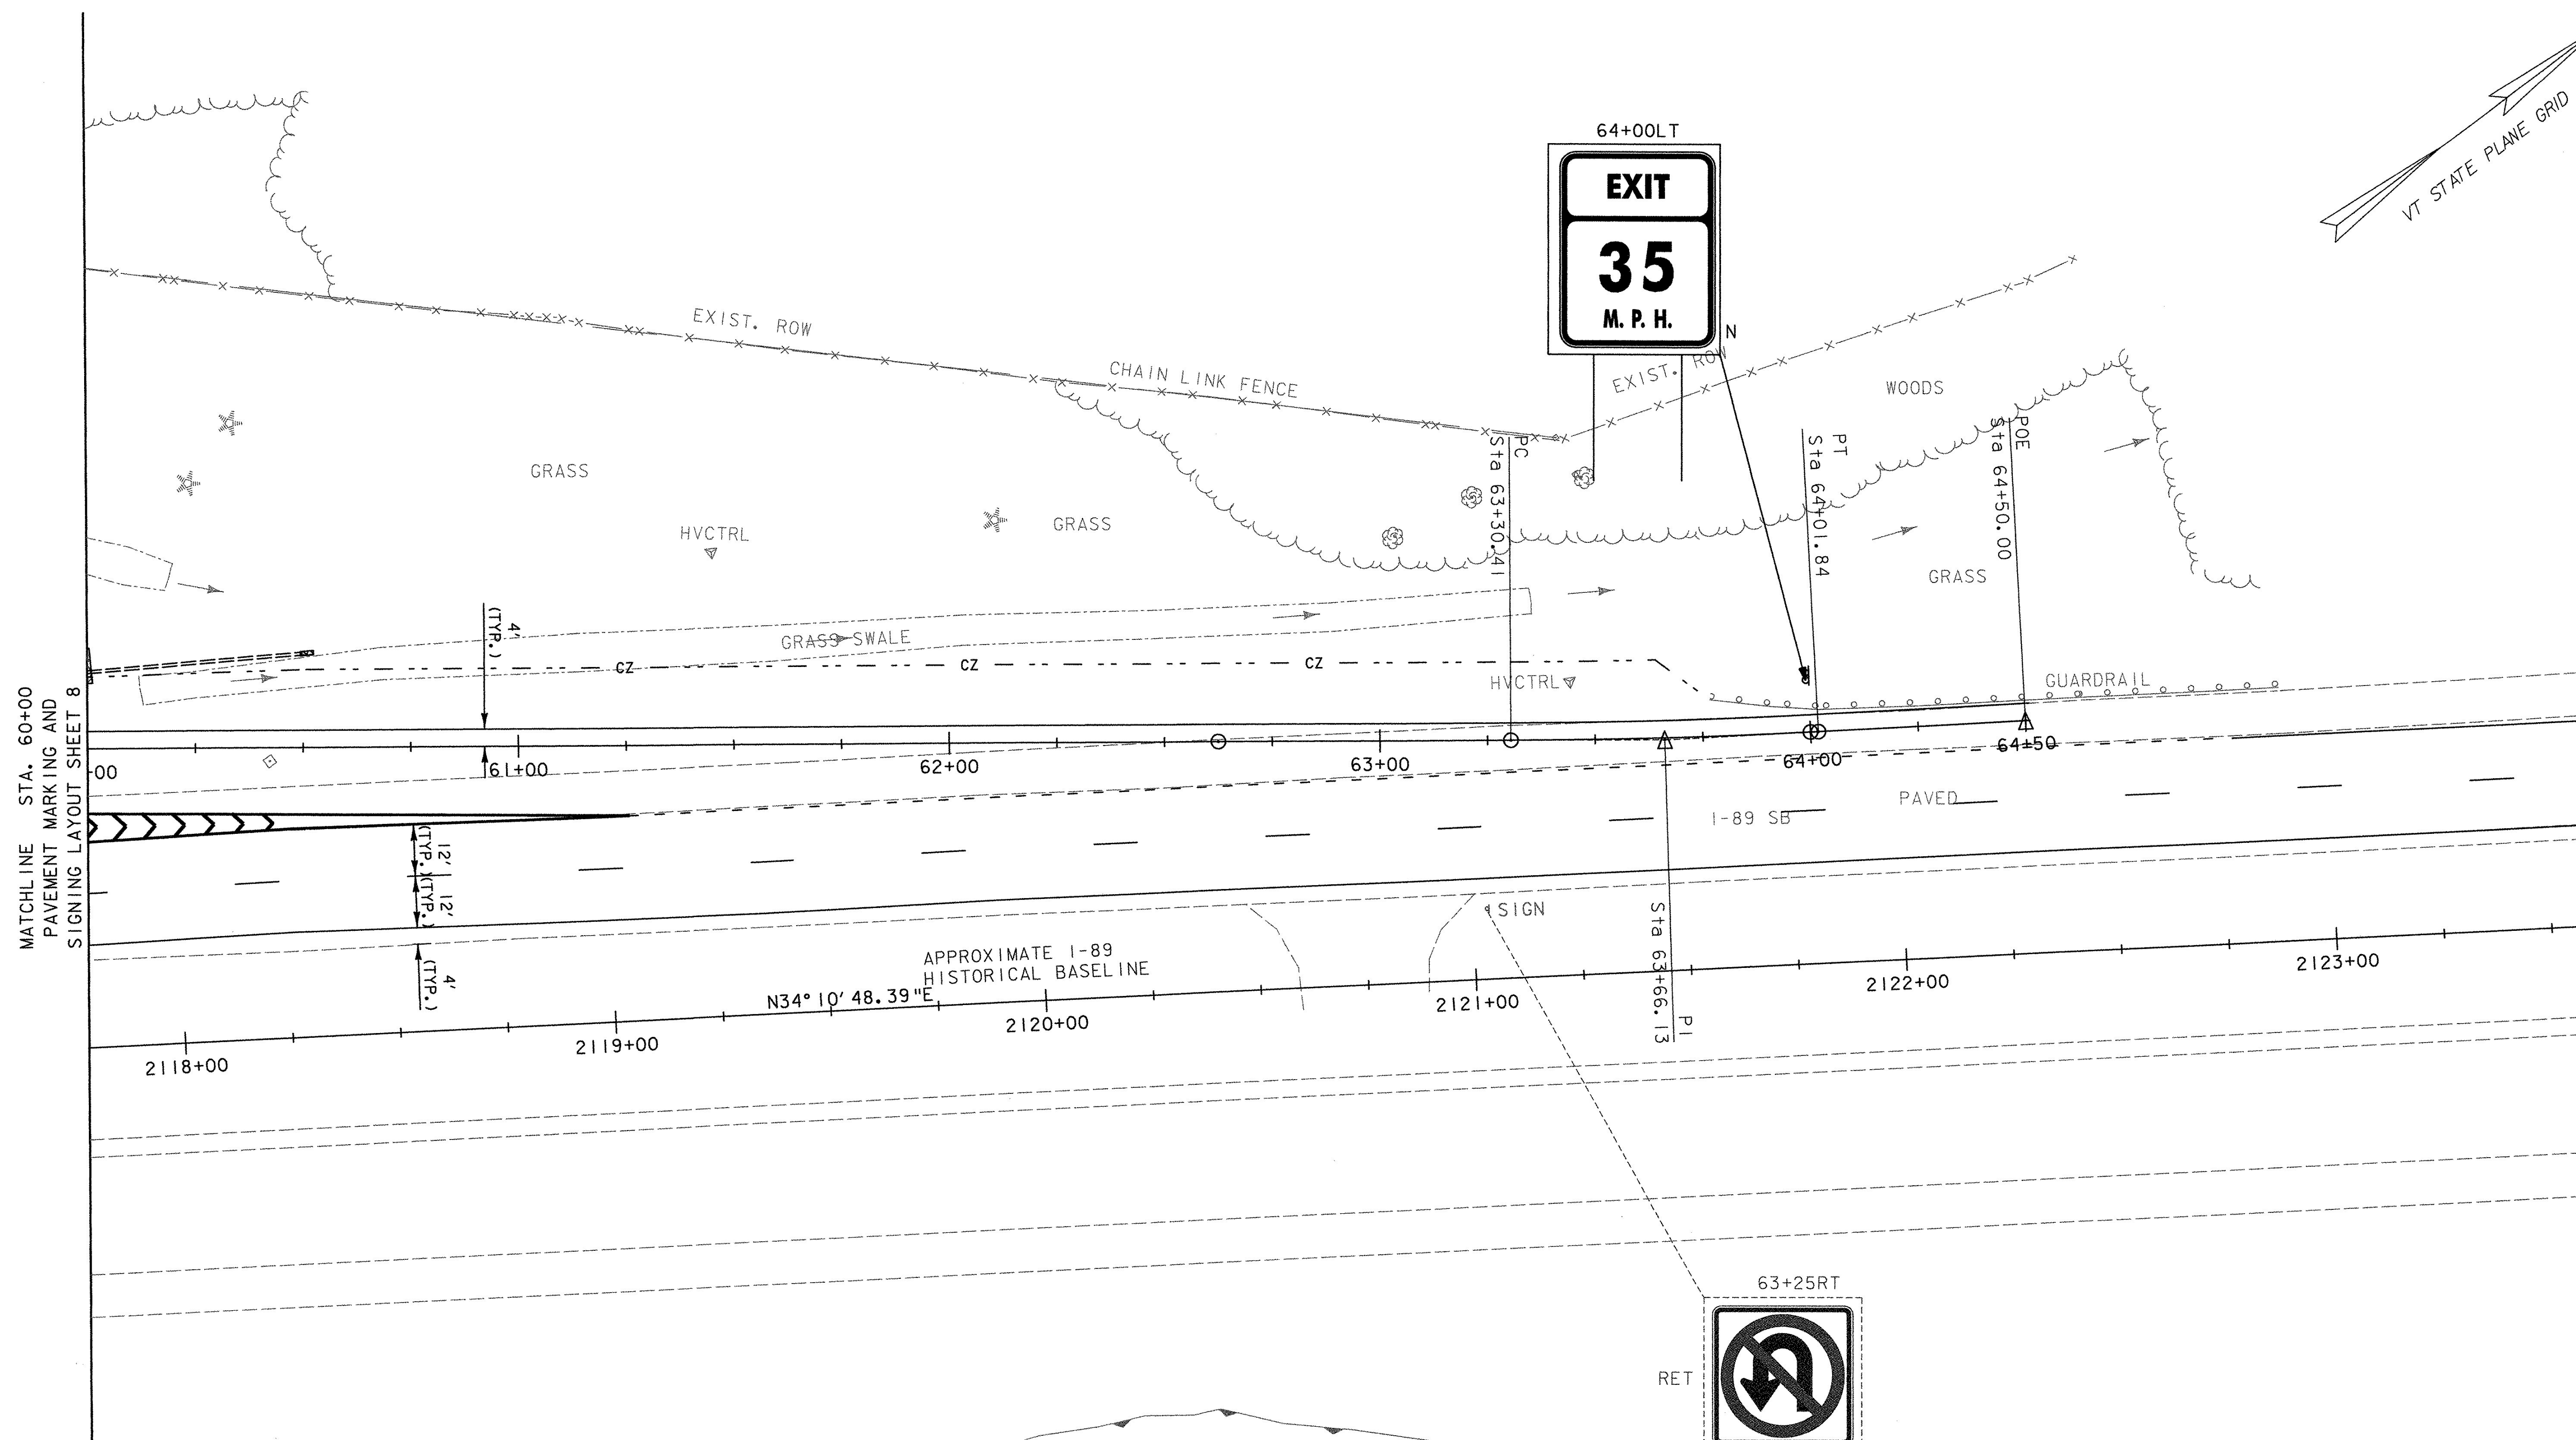
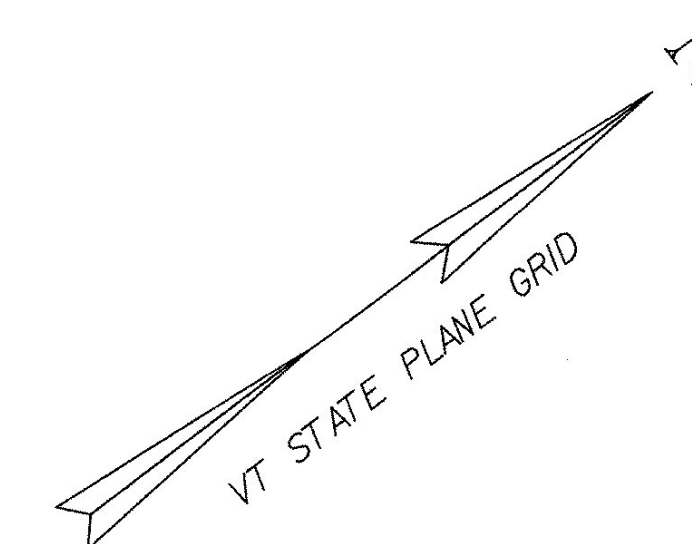


DATUM
VERTICAL NAVD 88
HORIZONTAL NAD 83 (1996)

SIGN LEGEND	
	= EXISTING SIGN
	= NEW SIGN
R	= REMOVE EXISTING SIGN AND POST
R+S	= SALVAGE SIGN AND RELOCATE TO NOTED LOCATION WITH NEW SIGN
N	= NEW
RET	= RETAIN AT EXISTING LOCATION
B-B	= BACK TO BACK

DURABLE 6" WHITE LINE
RAMP "C" 60+00 ~ 64+50, 450 LF
I-89 2119+05 ~ 212+75, 62 X 2' = 124 LF
I-89 2117+75 ~ 2124+00, 17 X 10' = 170 LF

TEMPORARY 6" WHITE LINE
RAMP "C" 60+00 ~ 64+50, 450 LF


DURABLE 12" WHITE LINE
RAMP "C" 60+00 ~ 61+25, 125 LF
I-89 2117+80 ~ 2119+05, 125 LF
CHEVRON MARKINGS 56+55 ~ 60+45, 46 LF

TEMPORARY 12" WHITE LINE
RAMP "C" 60+00 ~ 61+25, 125 LF
CHEVRON MARKINGS 56+55 ~ 60+45, 46 LF

DURABLE 6" YELLOW LINE
I-89 2117+75 ~ 2124+00, 625 LF

REMOVAL OF EXISTING PAVEMENT MARKINGS
I-89 2117+78 ~ 2124+00 LT

NOTE:
SEE TRAFFIC MANAGEMENT PLANS FOR
TEMPORARY PAVEMENT MARKINGS ON I-89.

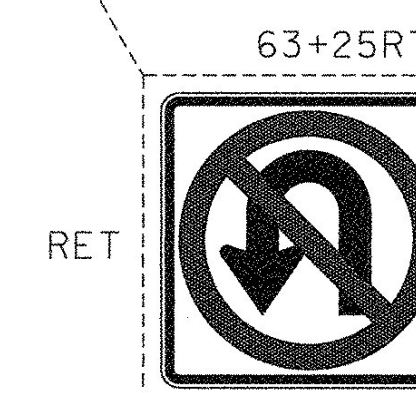

PAVEMENT MARKING AND SIGNING LAYOUT SHEET 9

PROJECT NAME: SO. BURLINGTON I-89 RAMP "C"
PROJECT NUMBER: IM 089-3(37)

FILE NAME: z03dl78pmbdr.dgn PLOT DATE: 5/5/2006
PROJECT LEADER: KEN UPMAL DRAWN BY: V.KACOYANNAKIS
DESIGNED BY: V.KACOYANNAKIS CHECKED BY: J.FORD
SHEET 62 OF 99