


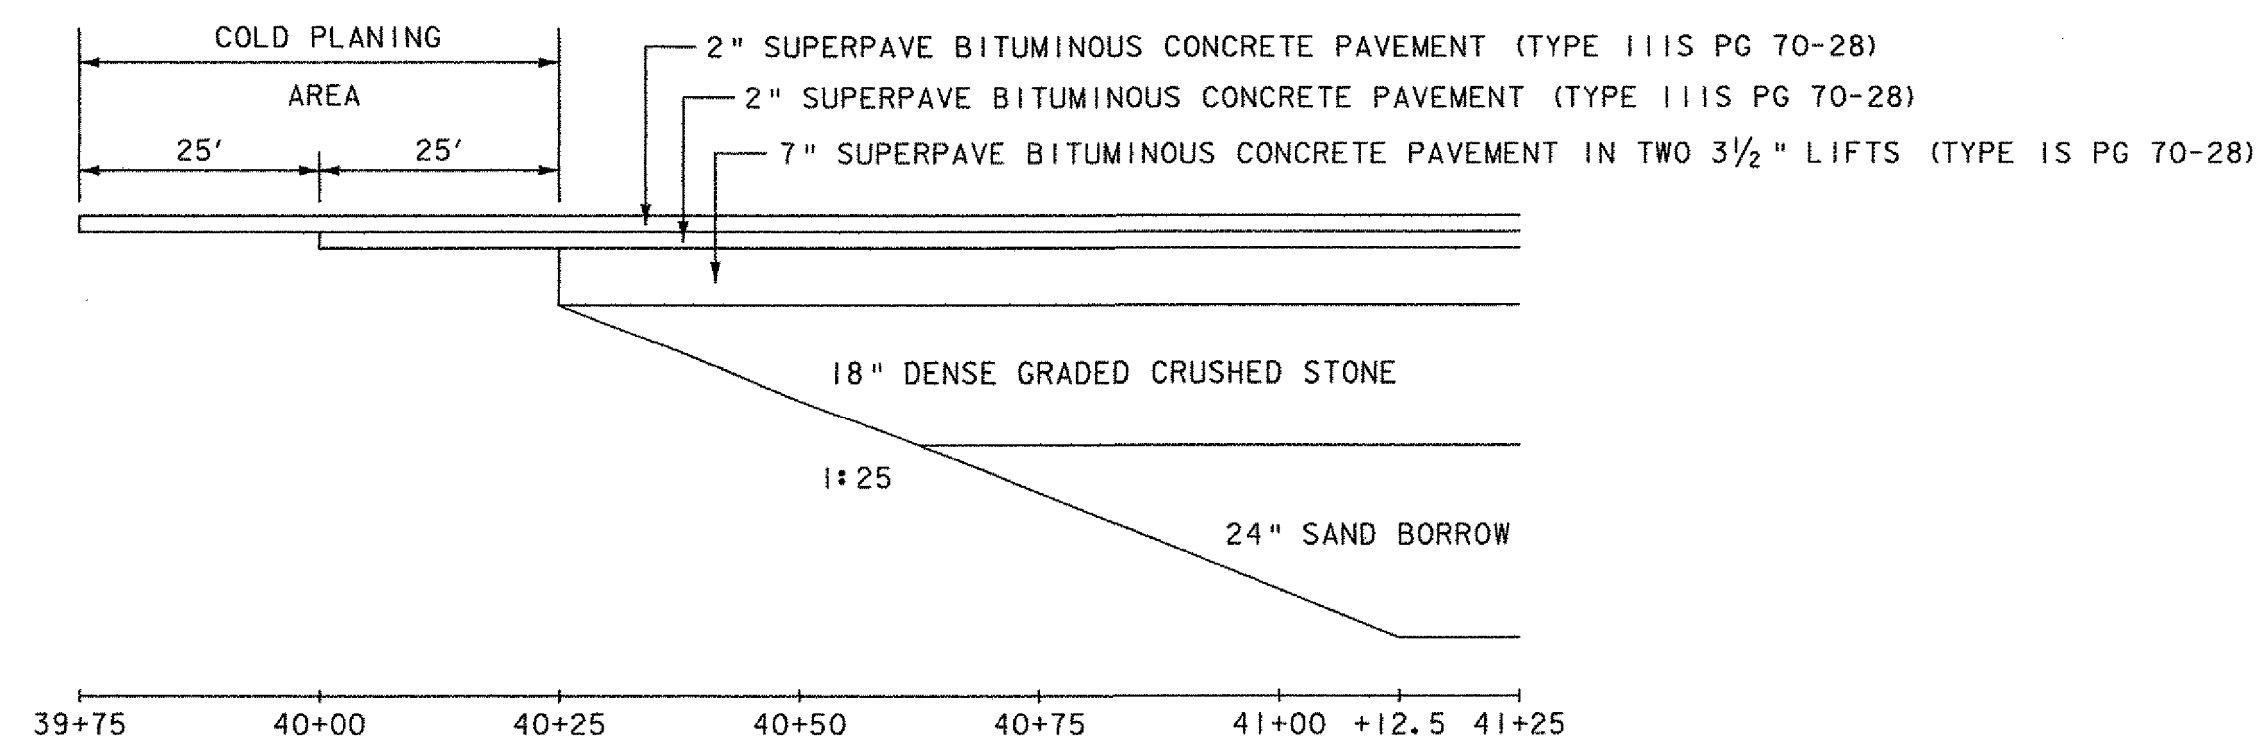
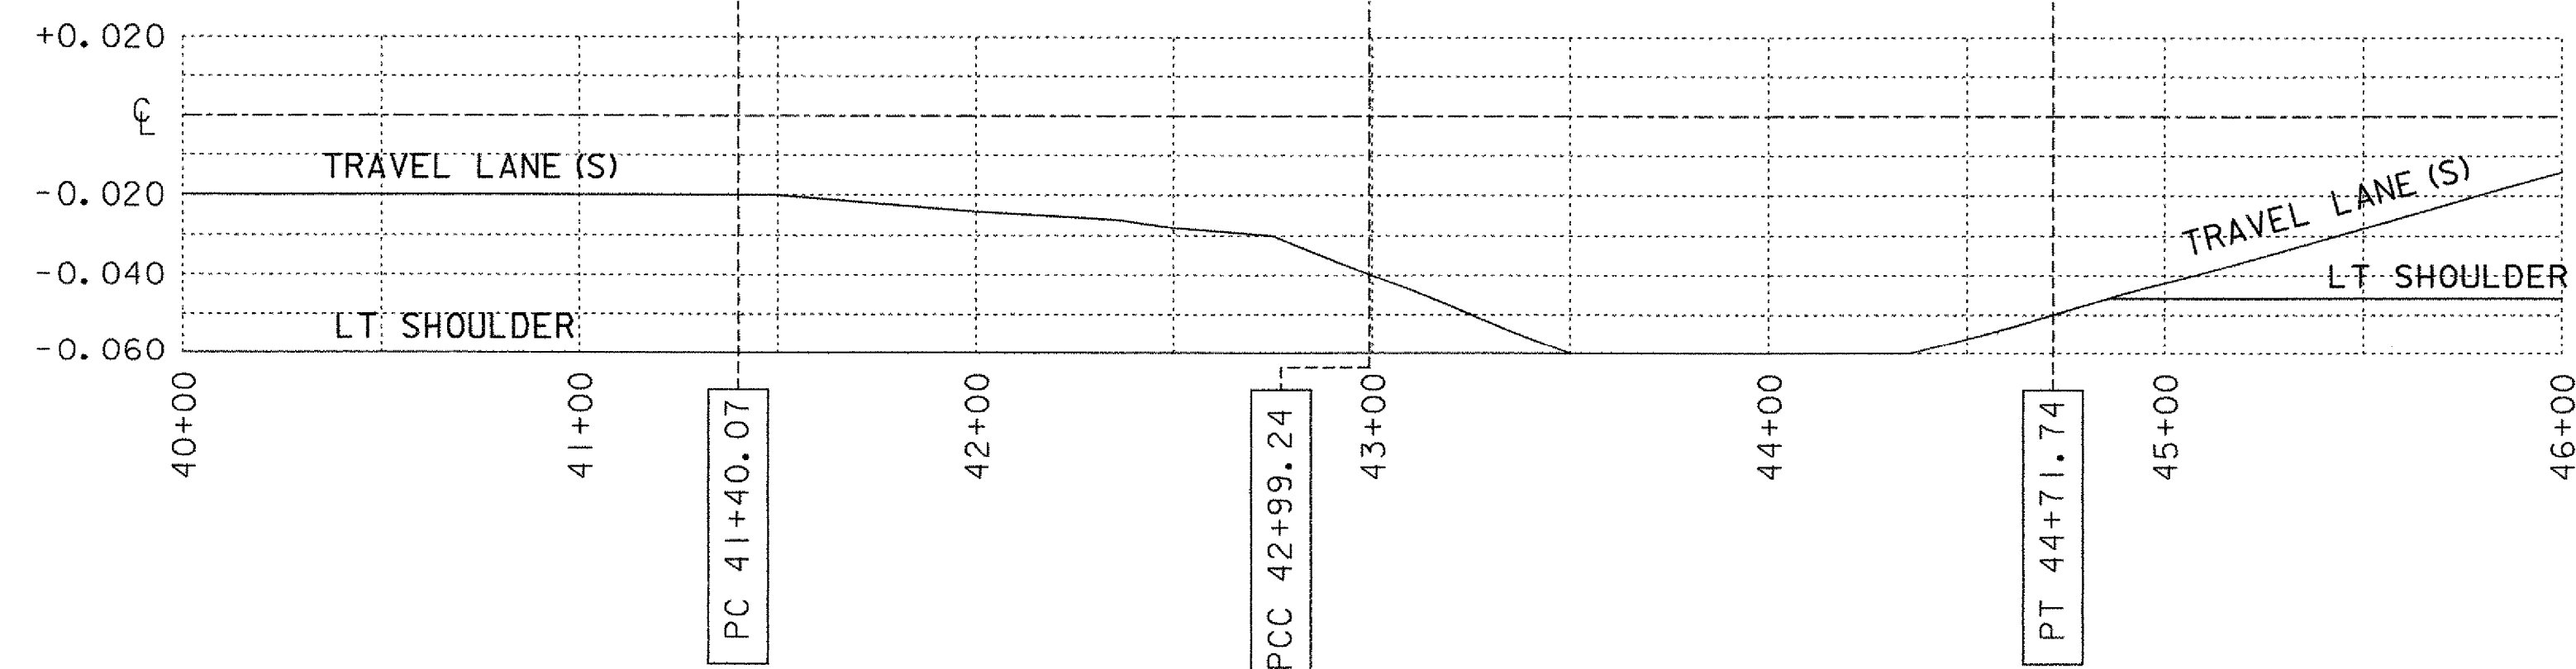
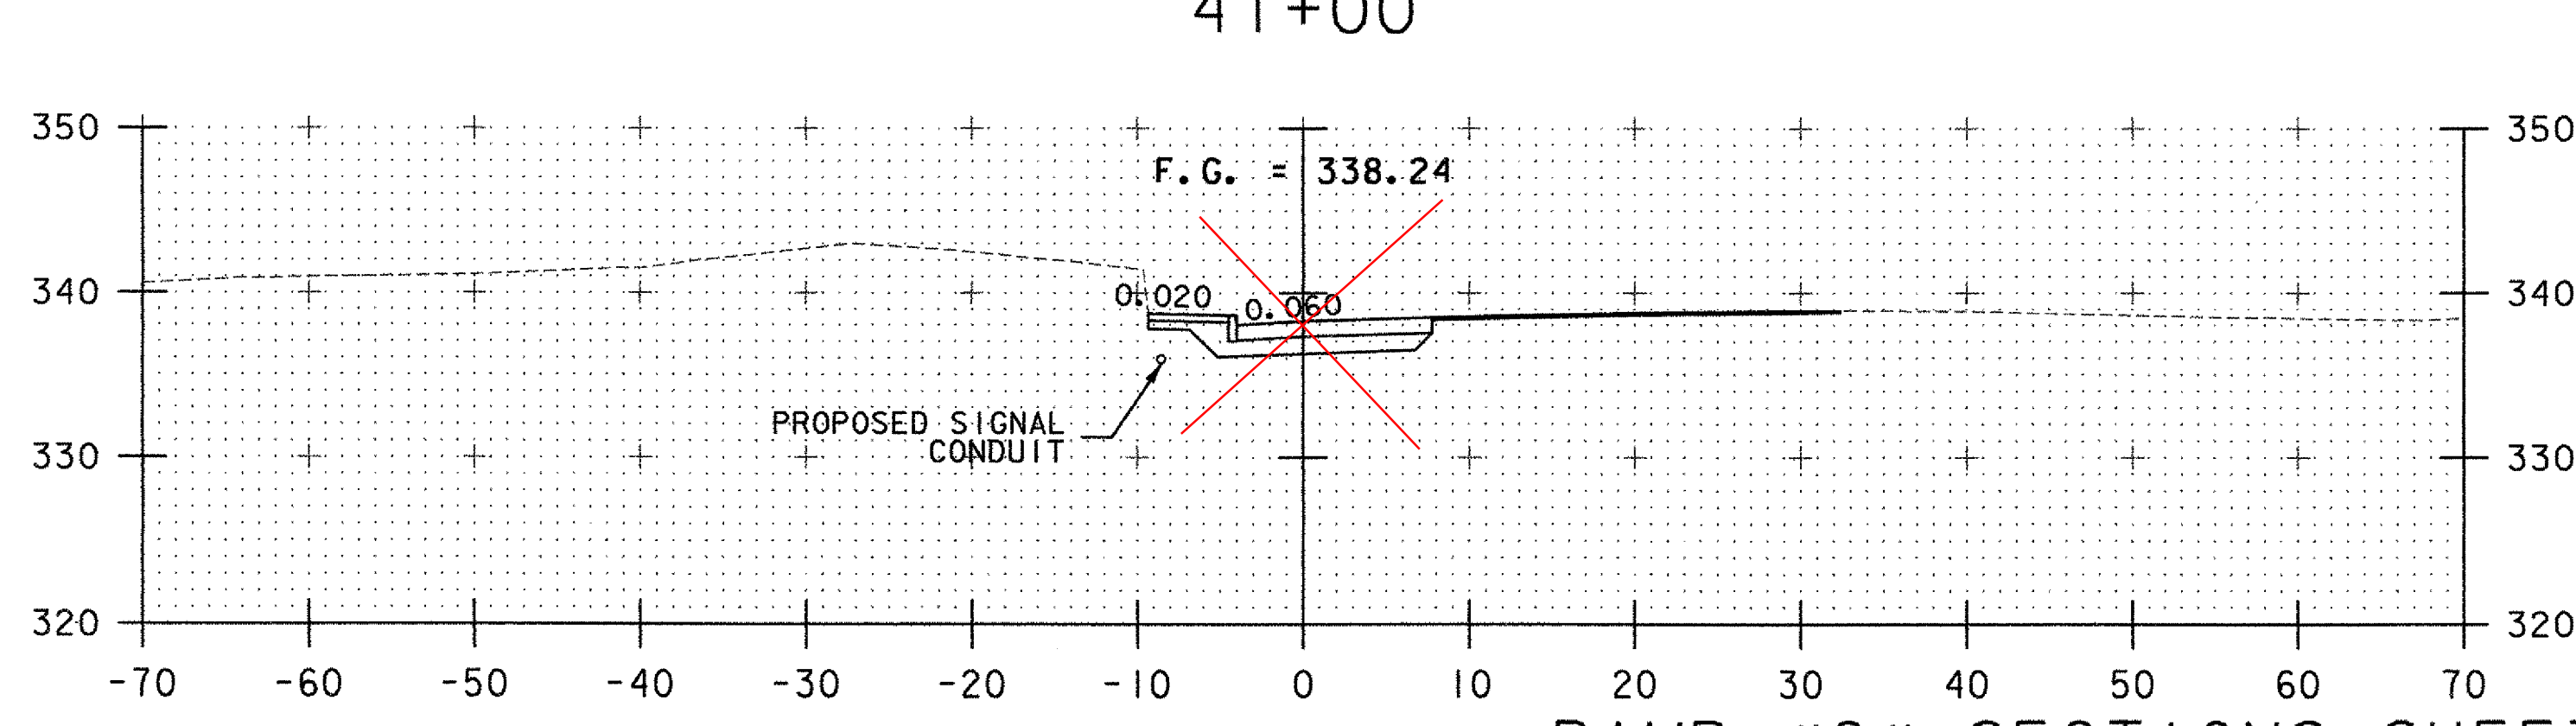
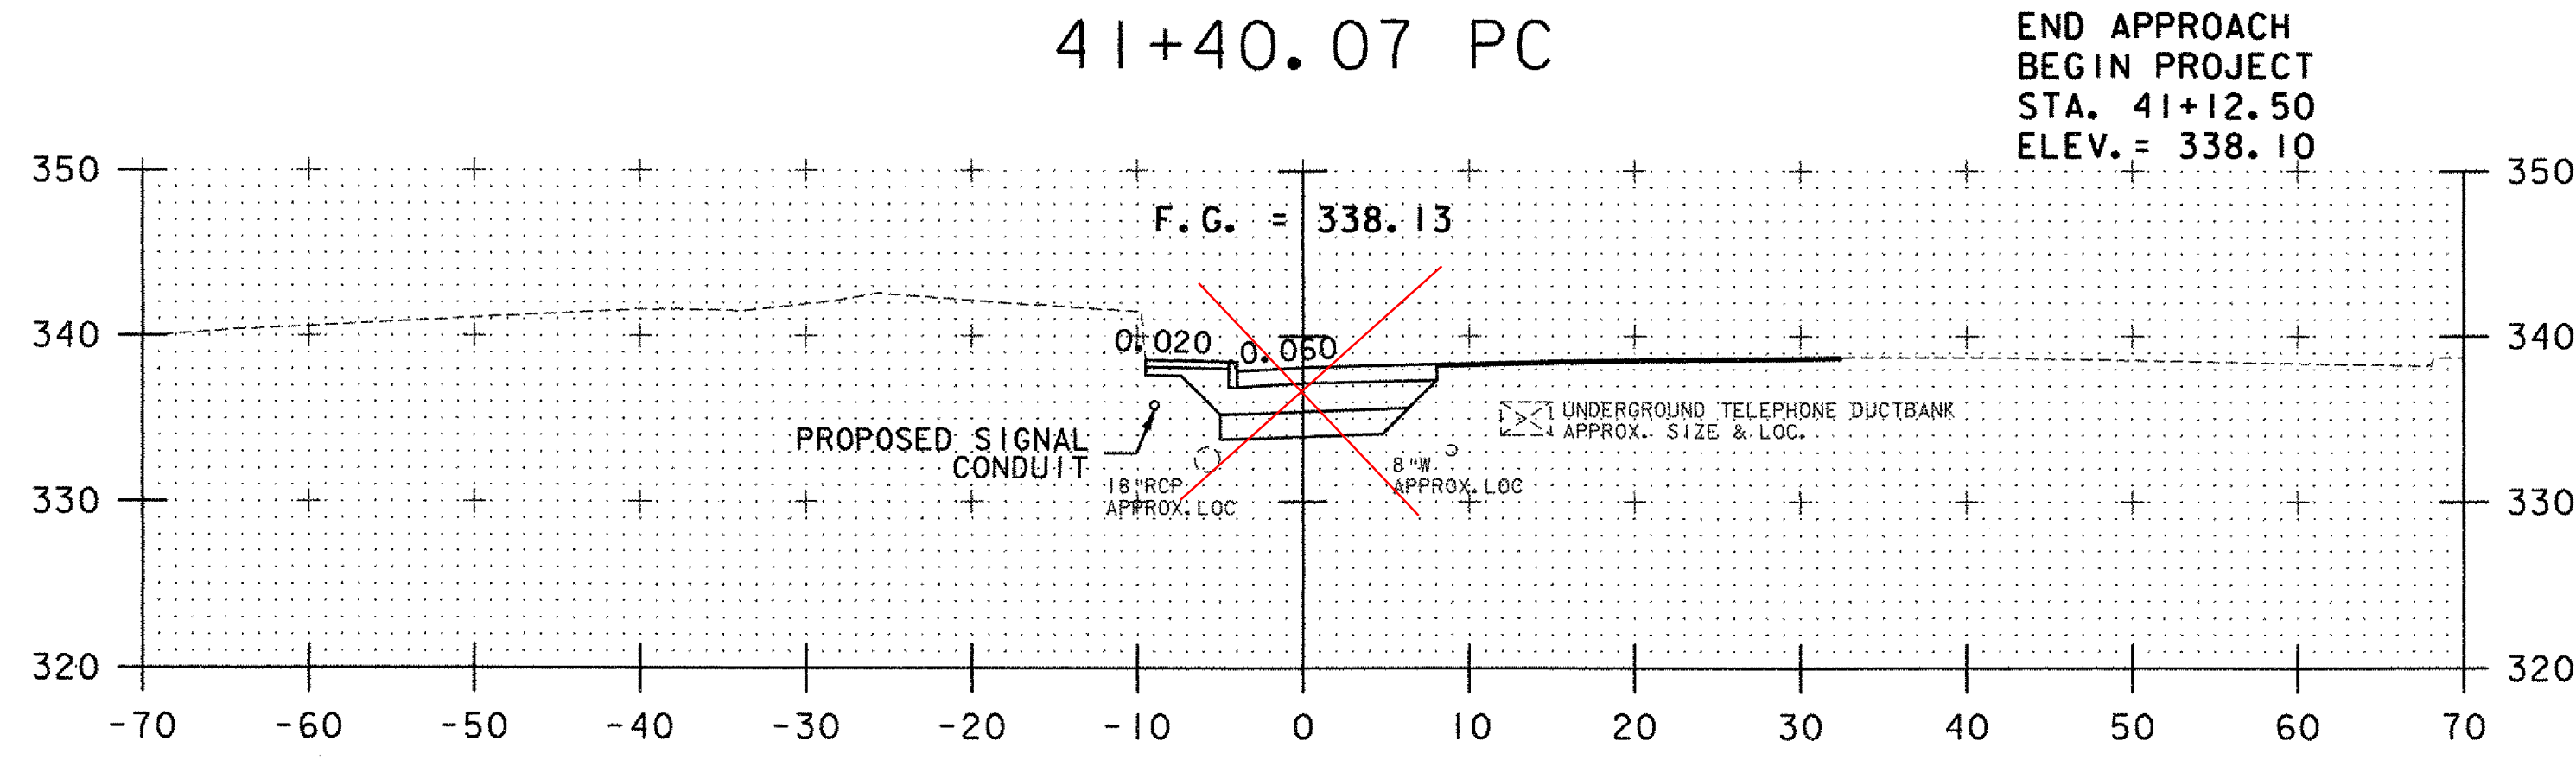
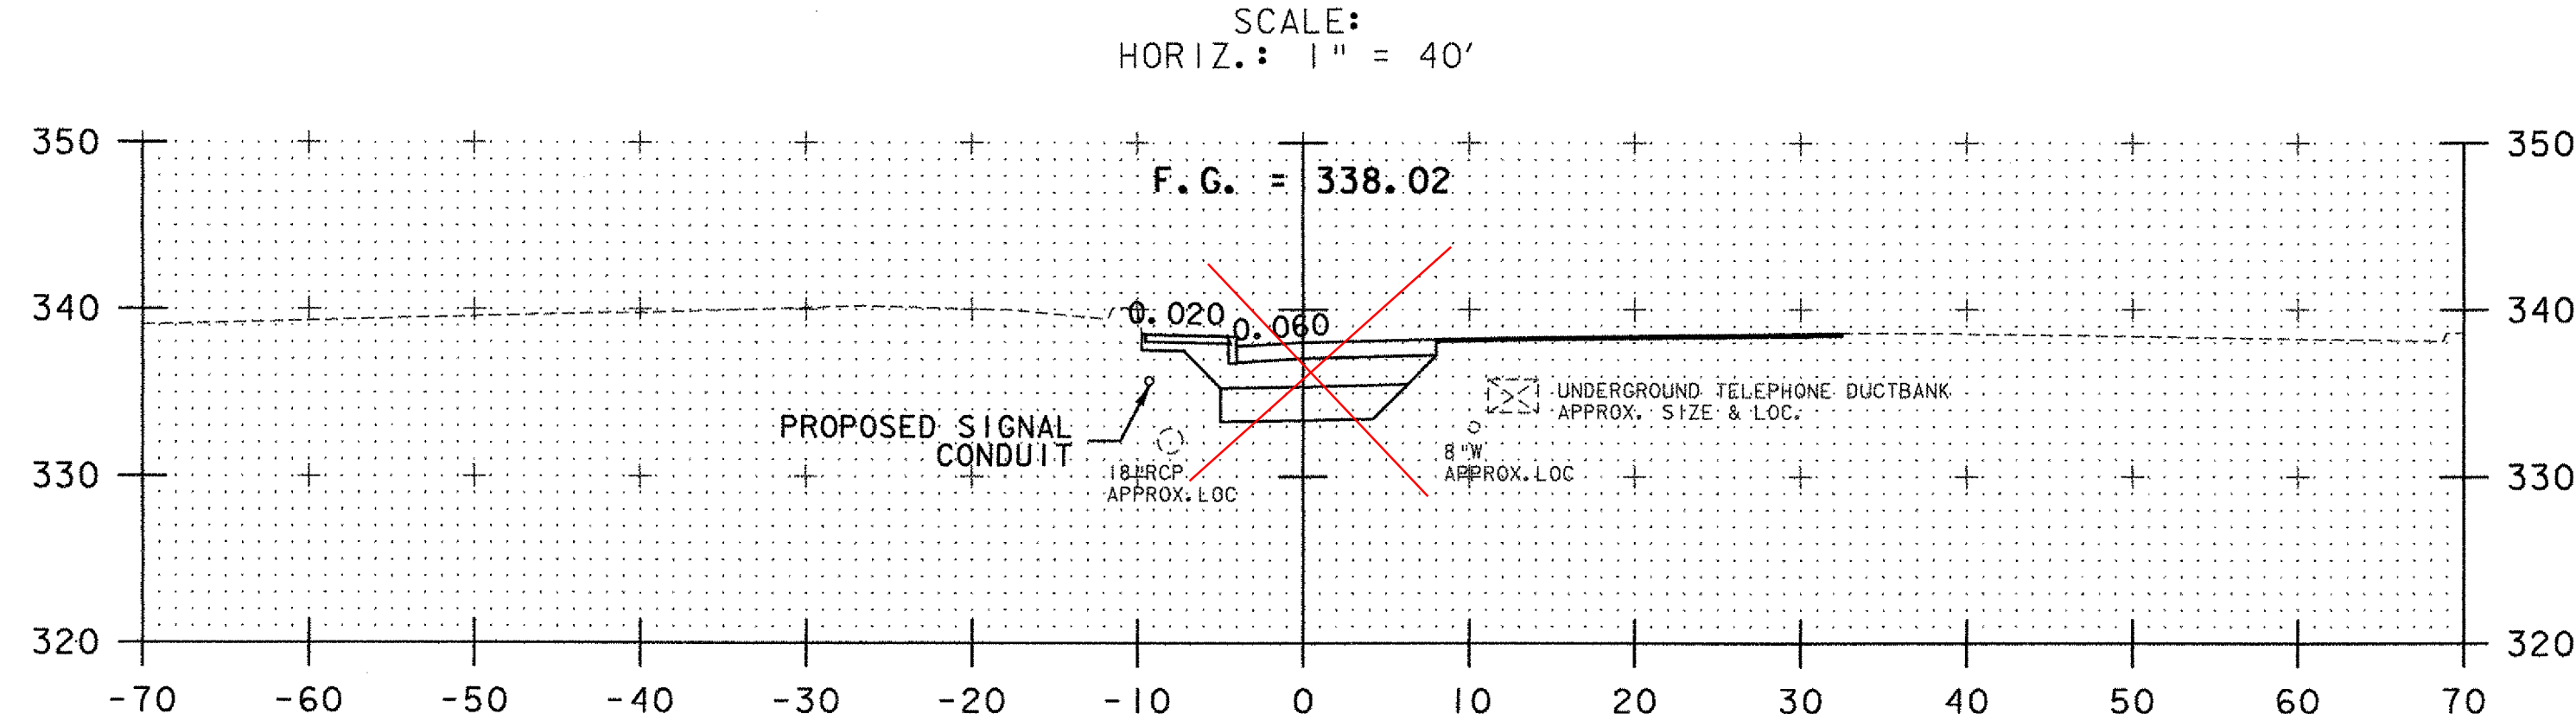


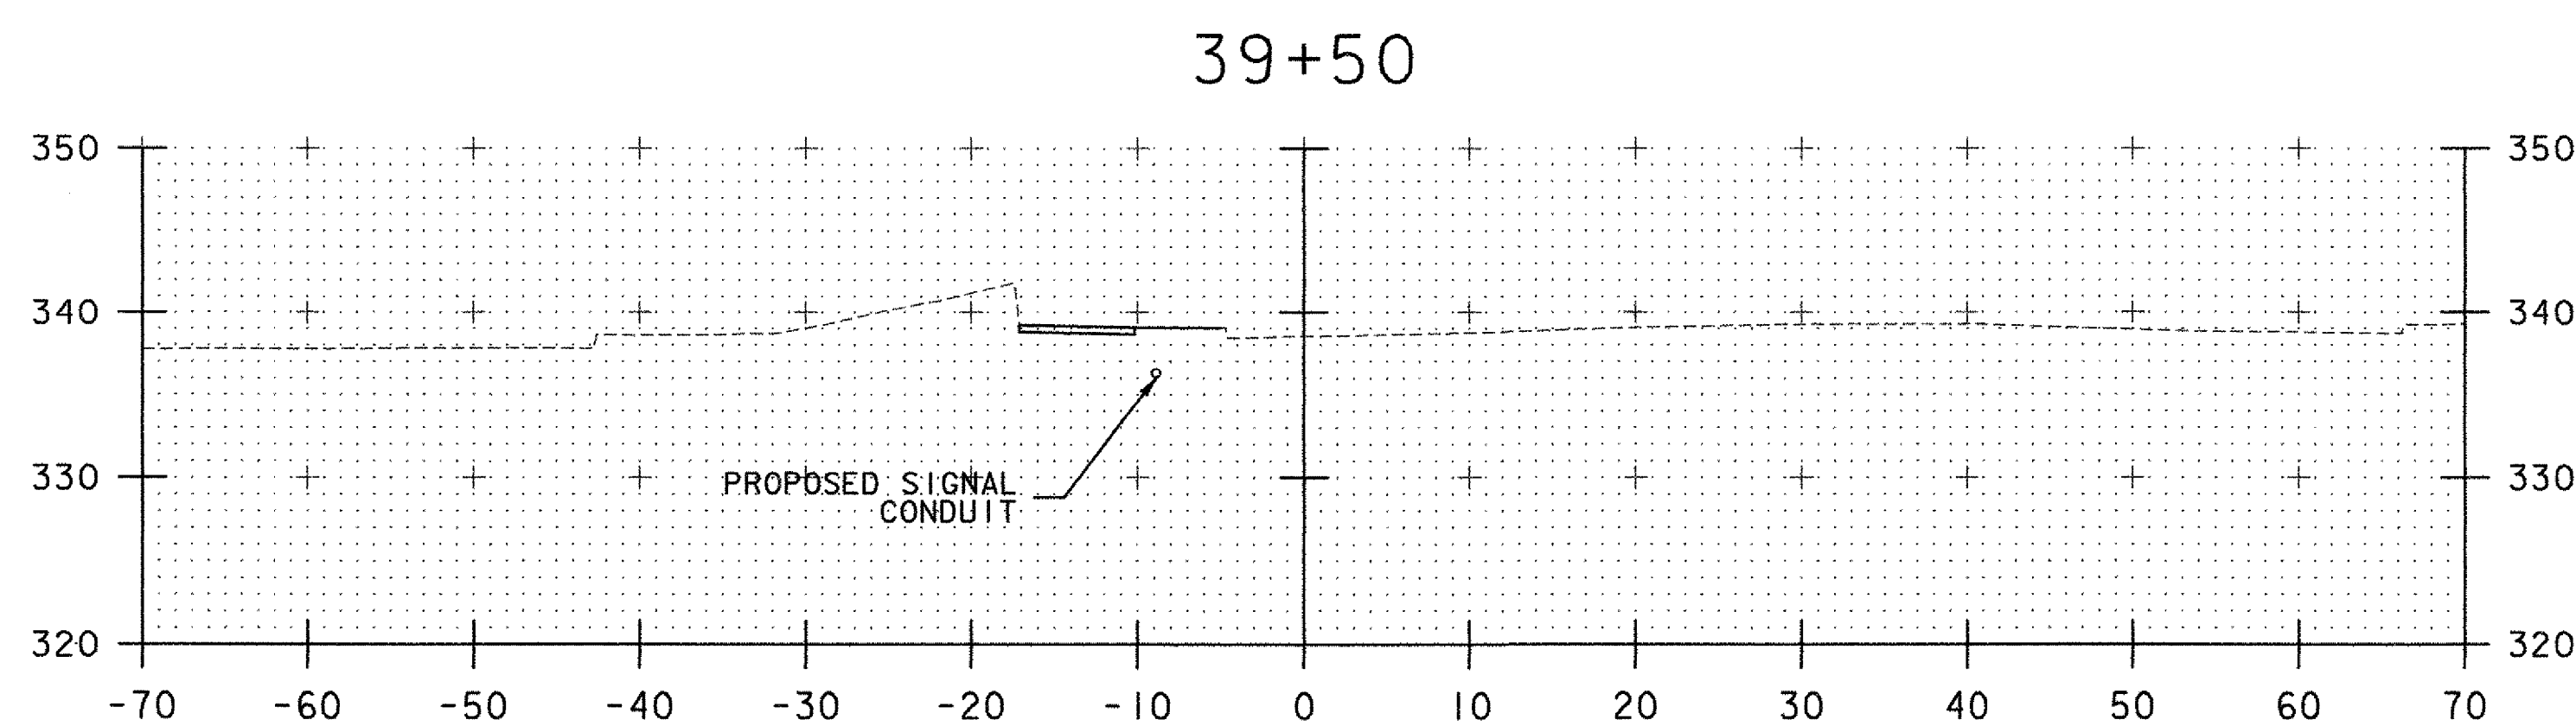

MATERIAL TRANSITION DETAIL
NOT TO SCALE

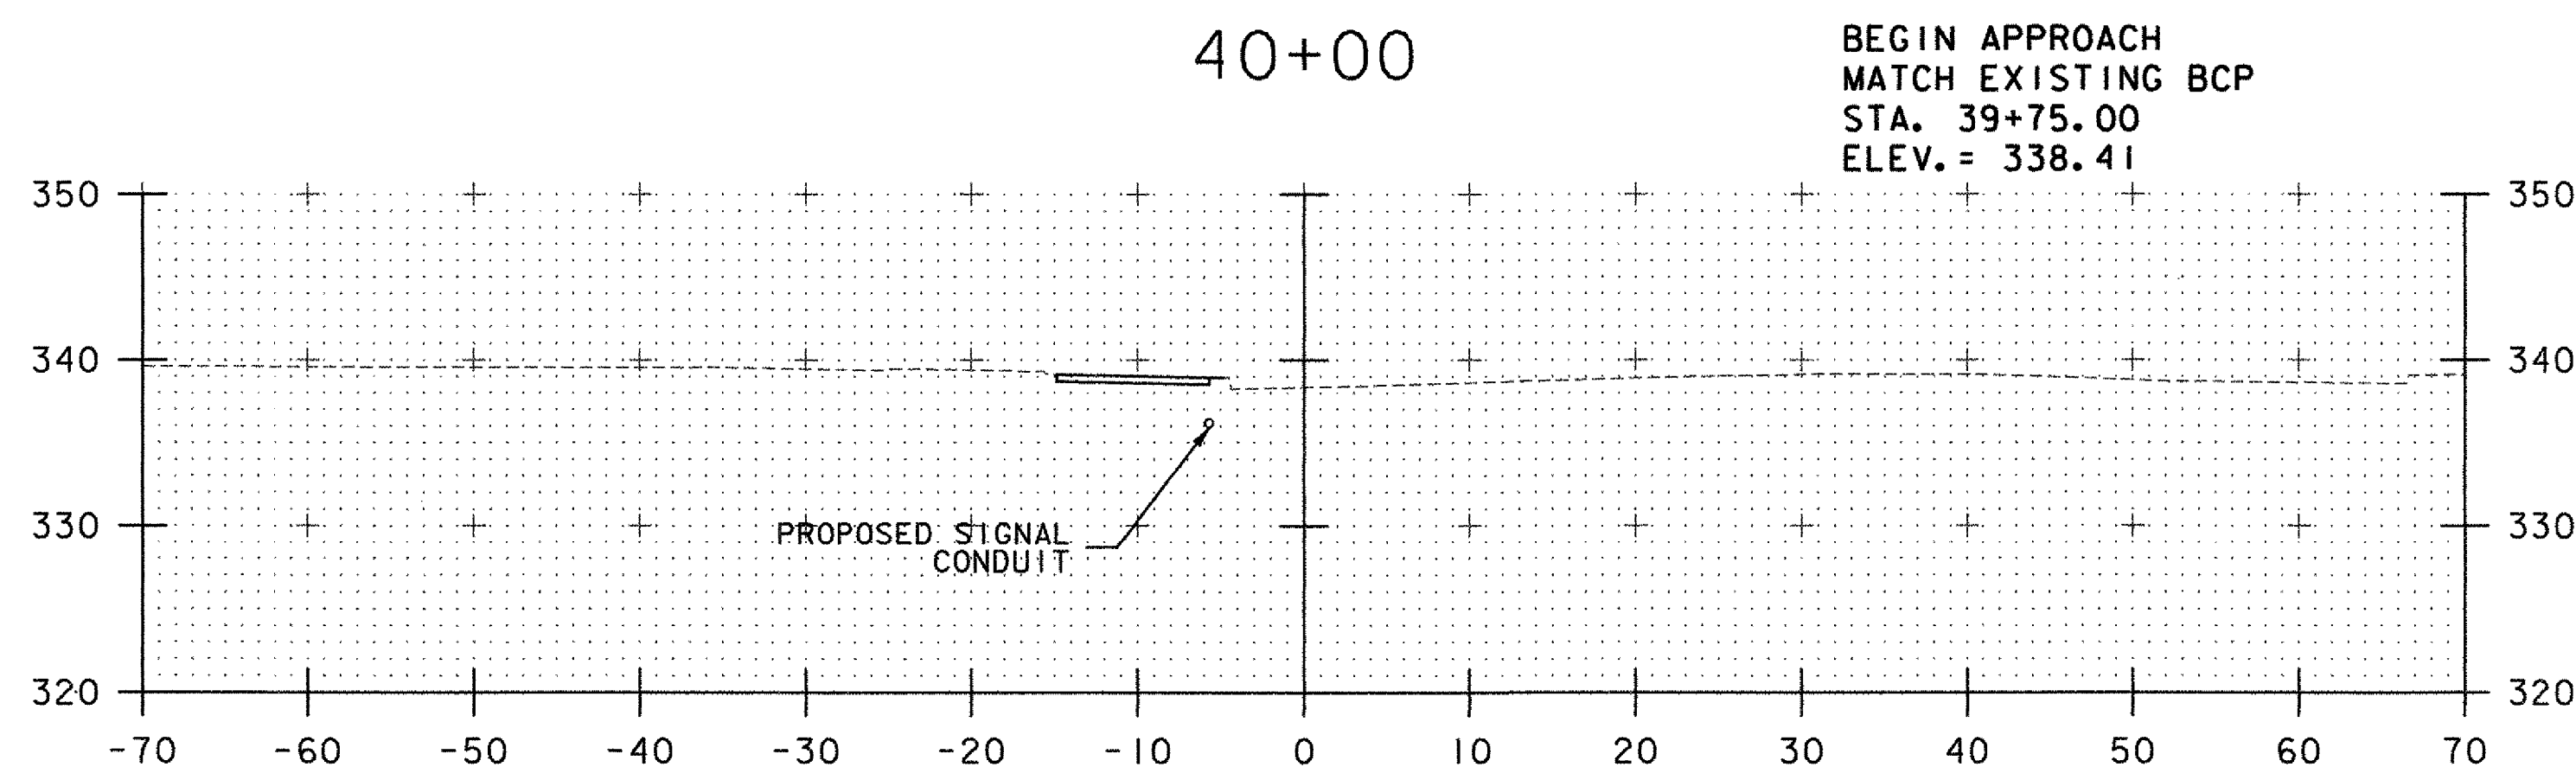

BANKING TRANSITION DETAIL

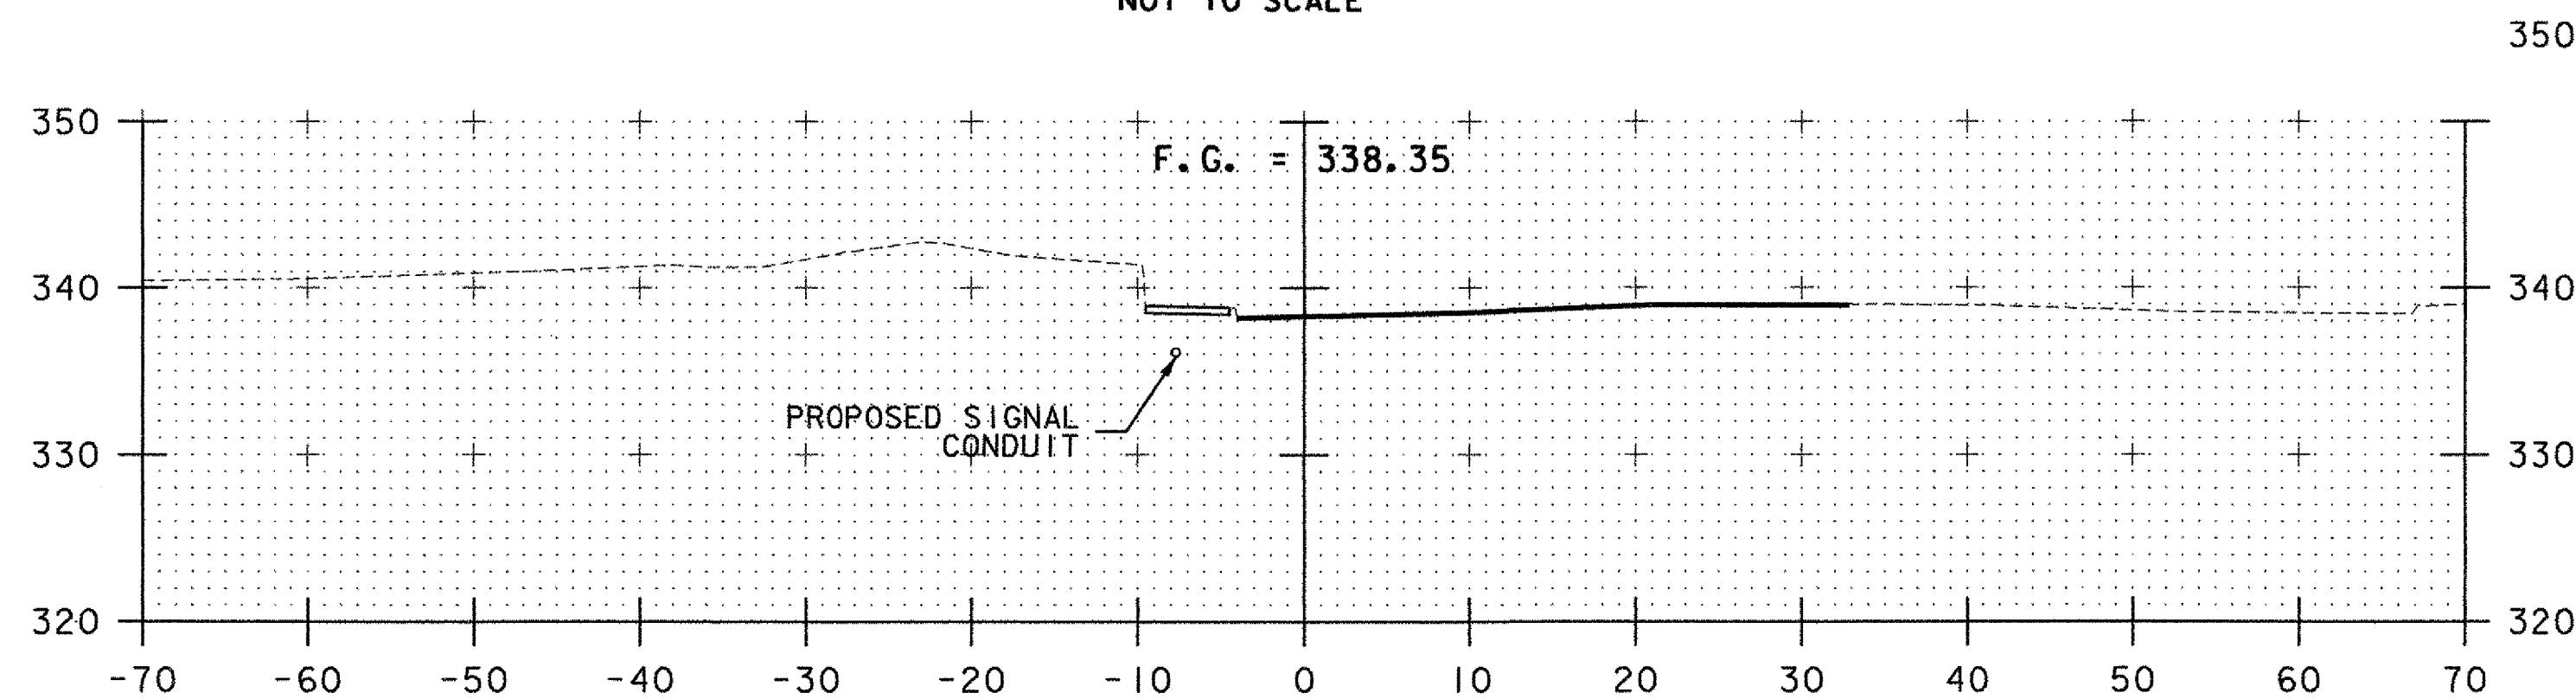


RAMP "C" SECTIONS SHEET 1

PROJECT NAME: SOUTH BURLINGTON
PROJECT NUMBER: IM 089-3(37)

FILE NAME: z03a178xs.dgn
PROJECT LEADER: KEN UPMAL
DESIGNED BY: E. ATKINS

PLOT DATE: 5/5/2006
DRAWN BY: E. ATKINS
CHECKED BY: K. ISHIKURA
SHEET 82 OF 99

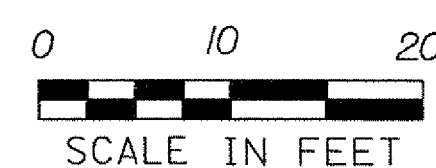

STA. 39+00 TO STA. 41+40.07

DATUM
VERTICAL NAVD 88
HORIZONTAL NAD 83 (1996)