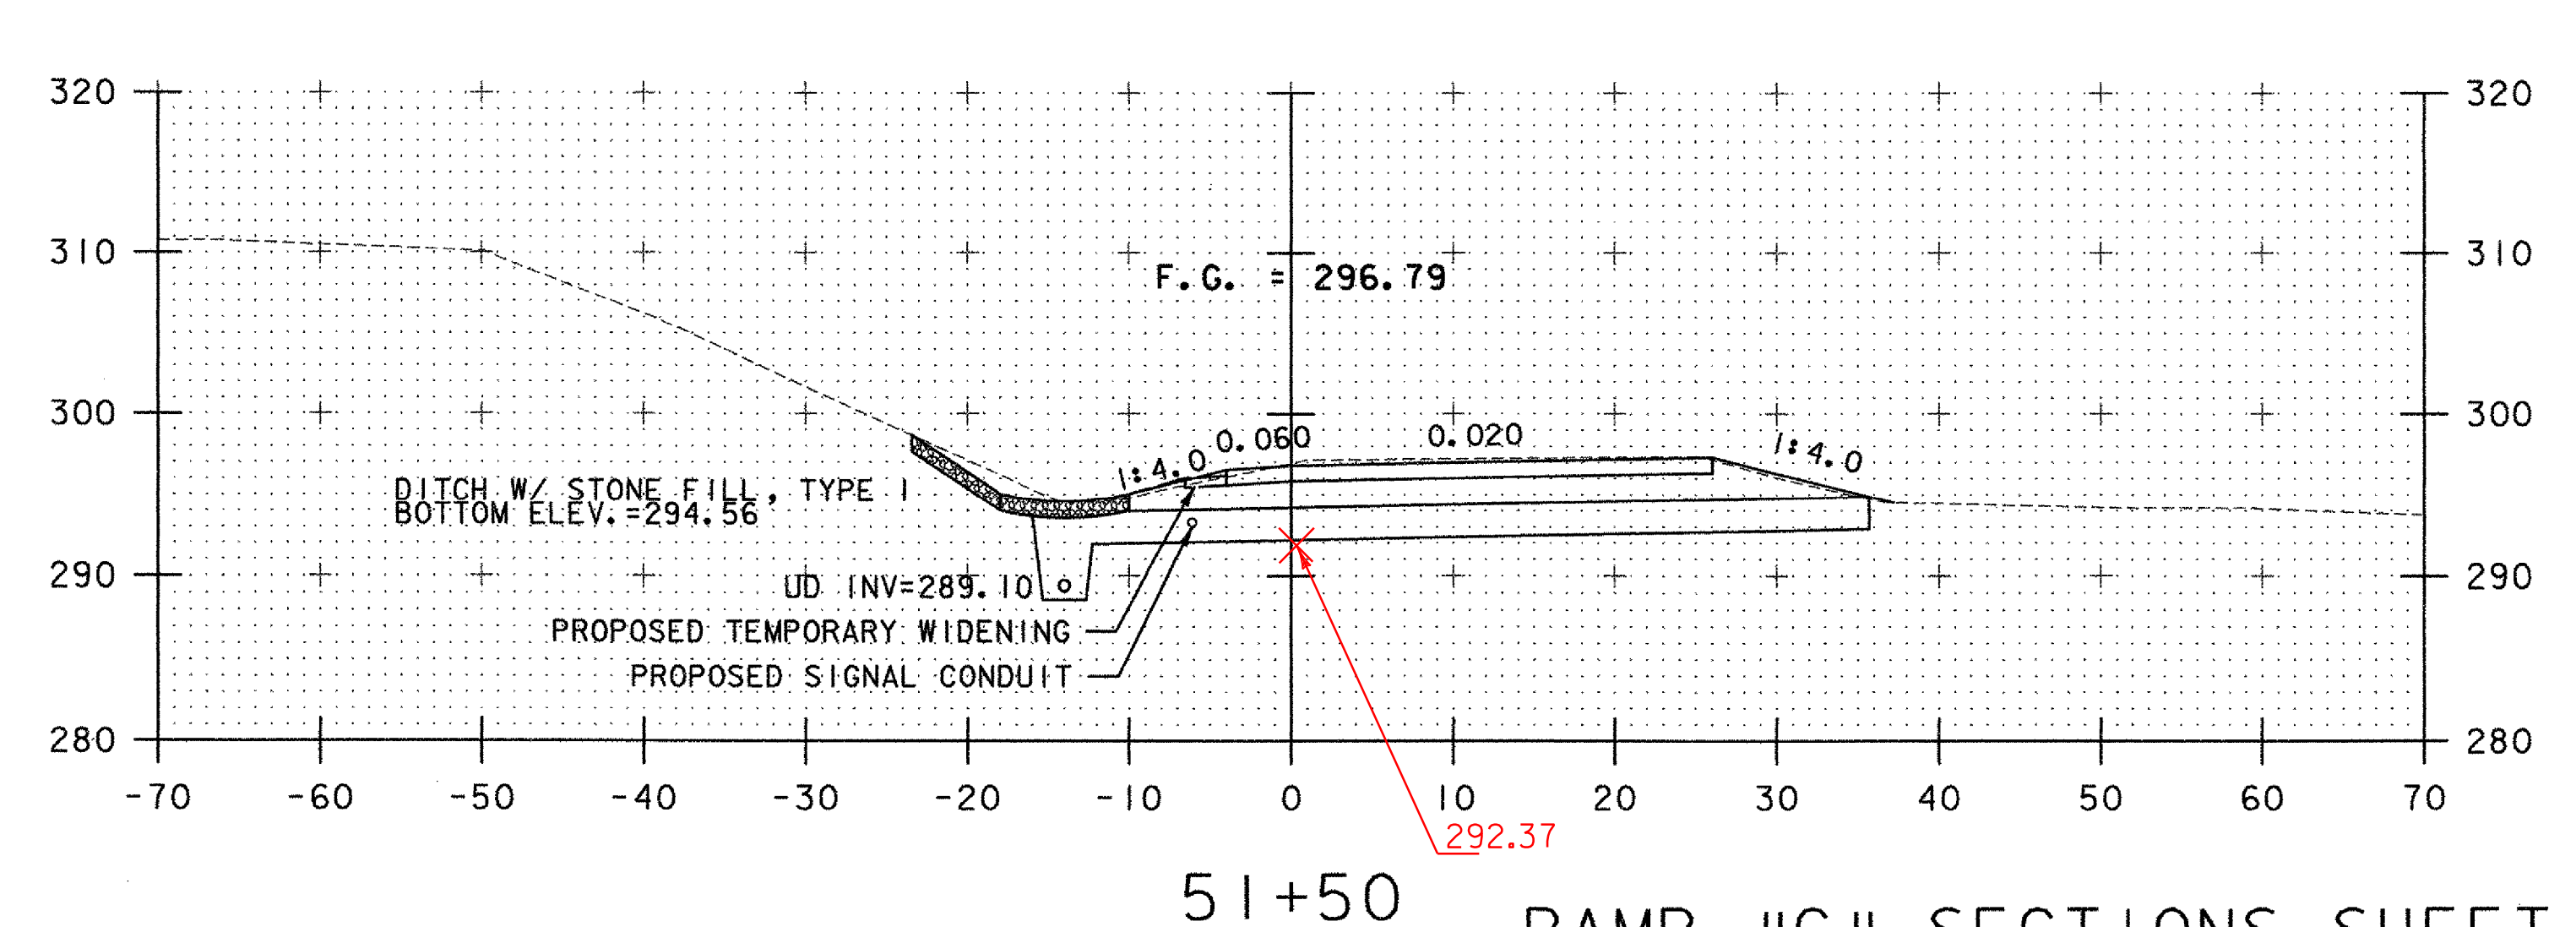
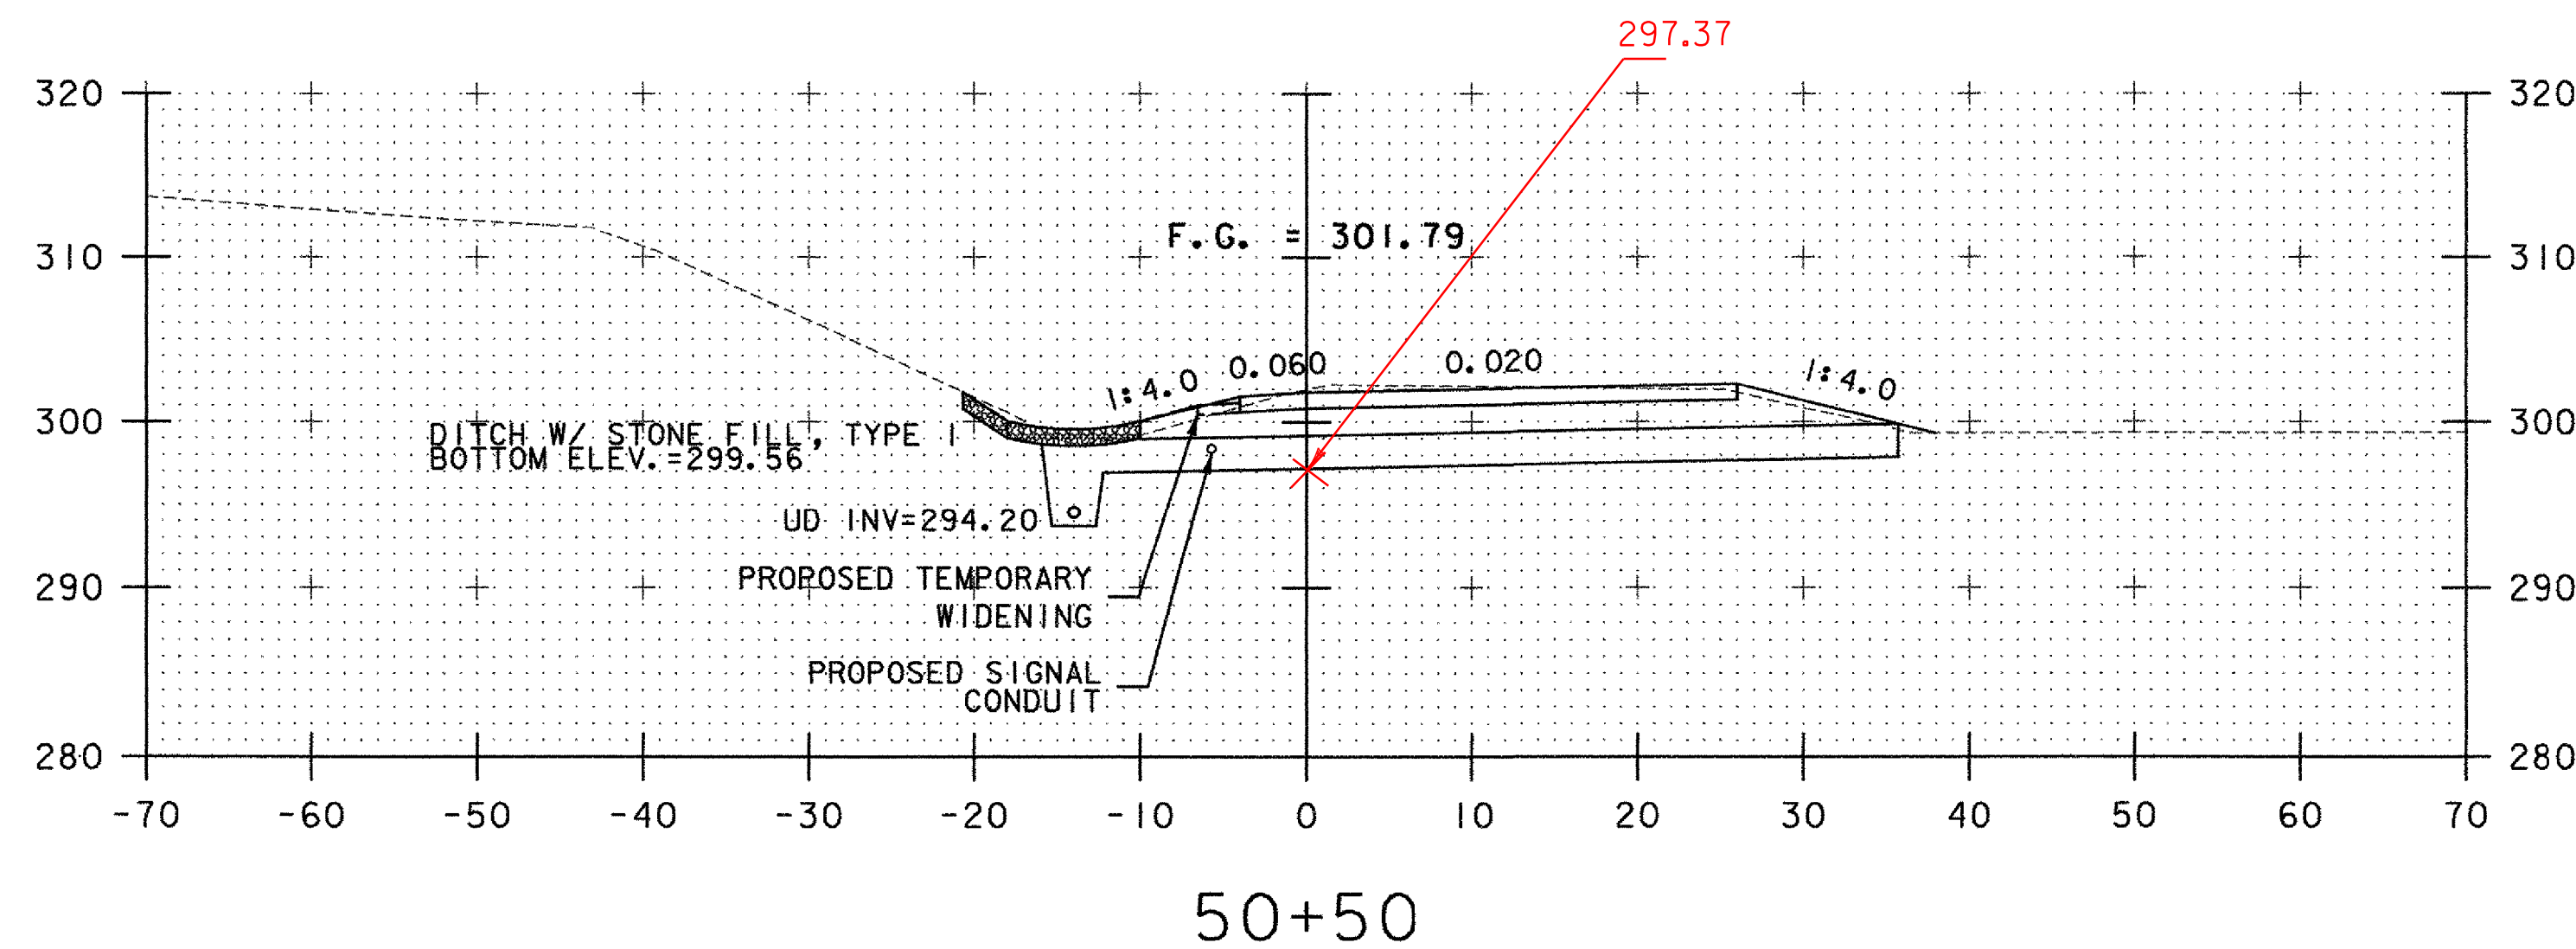
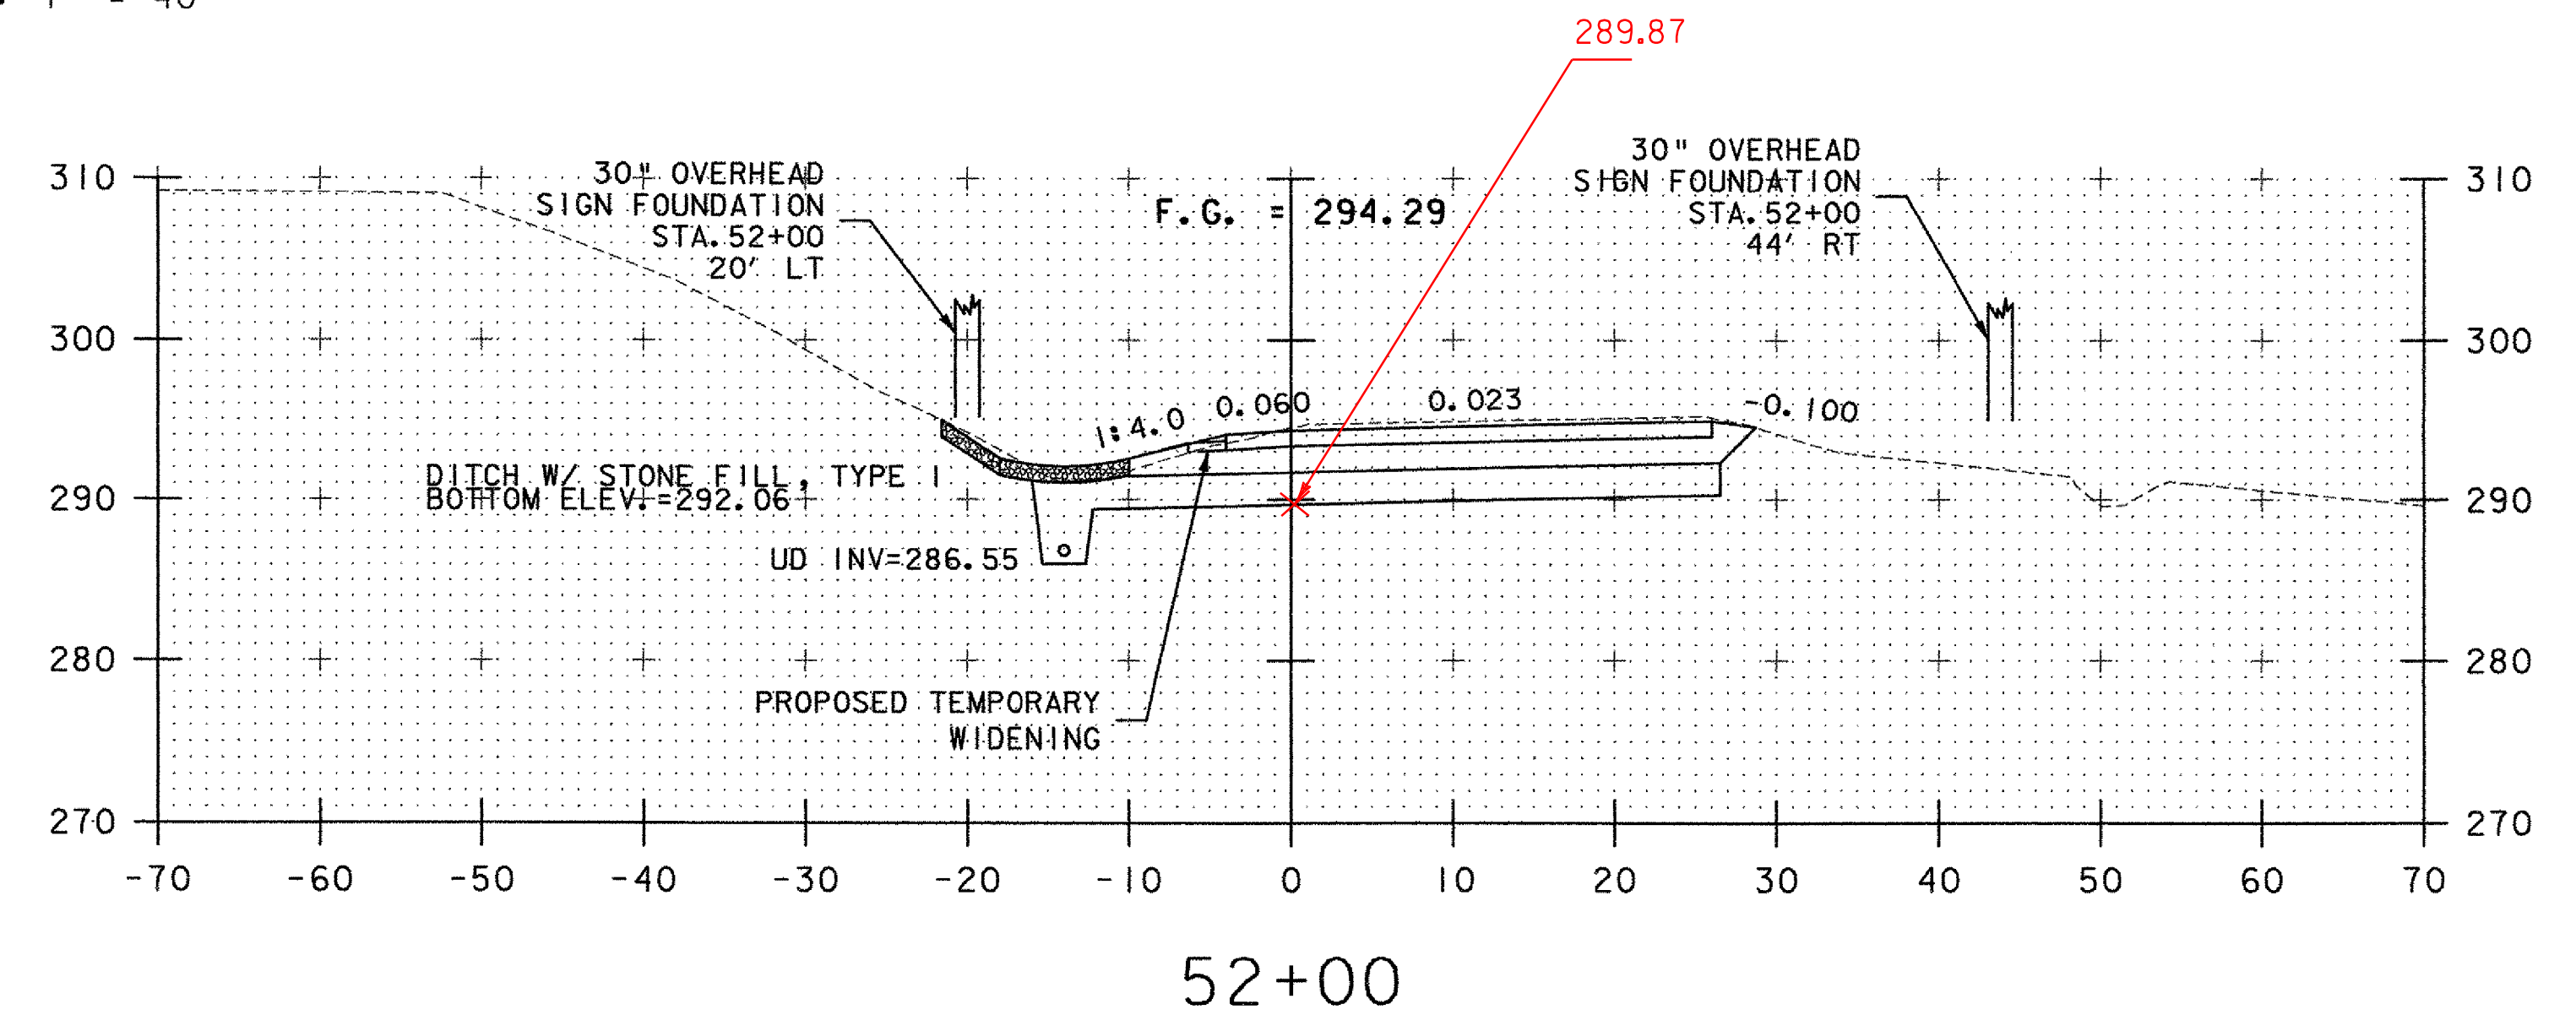
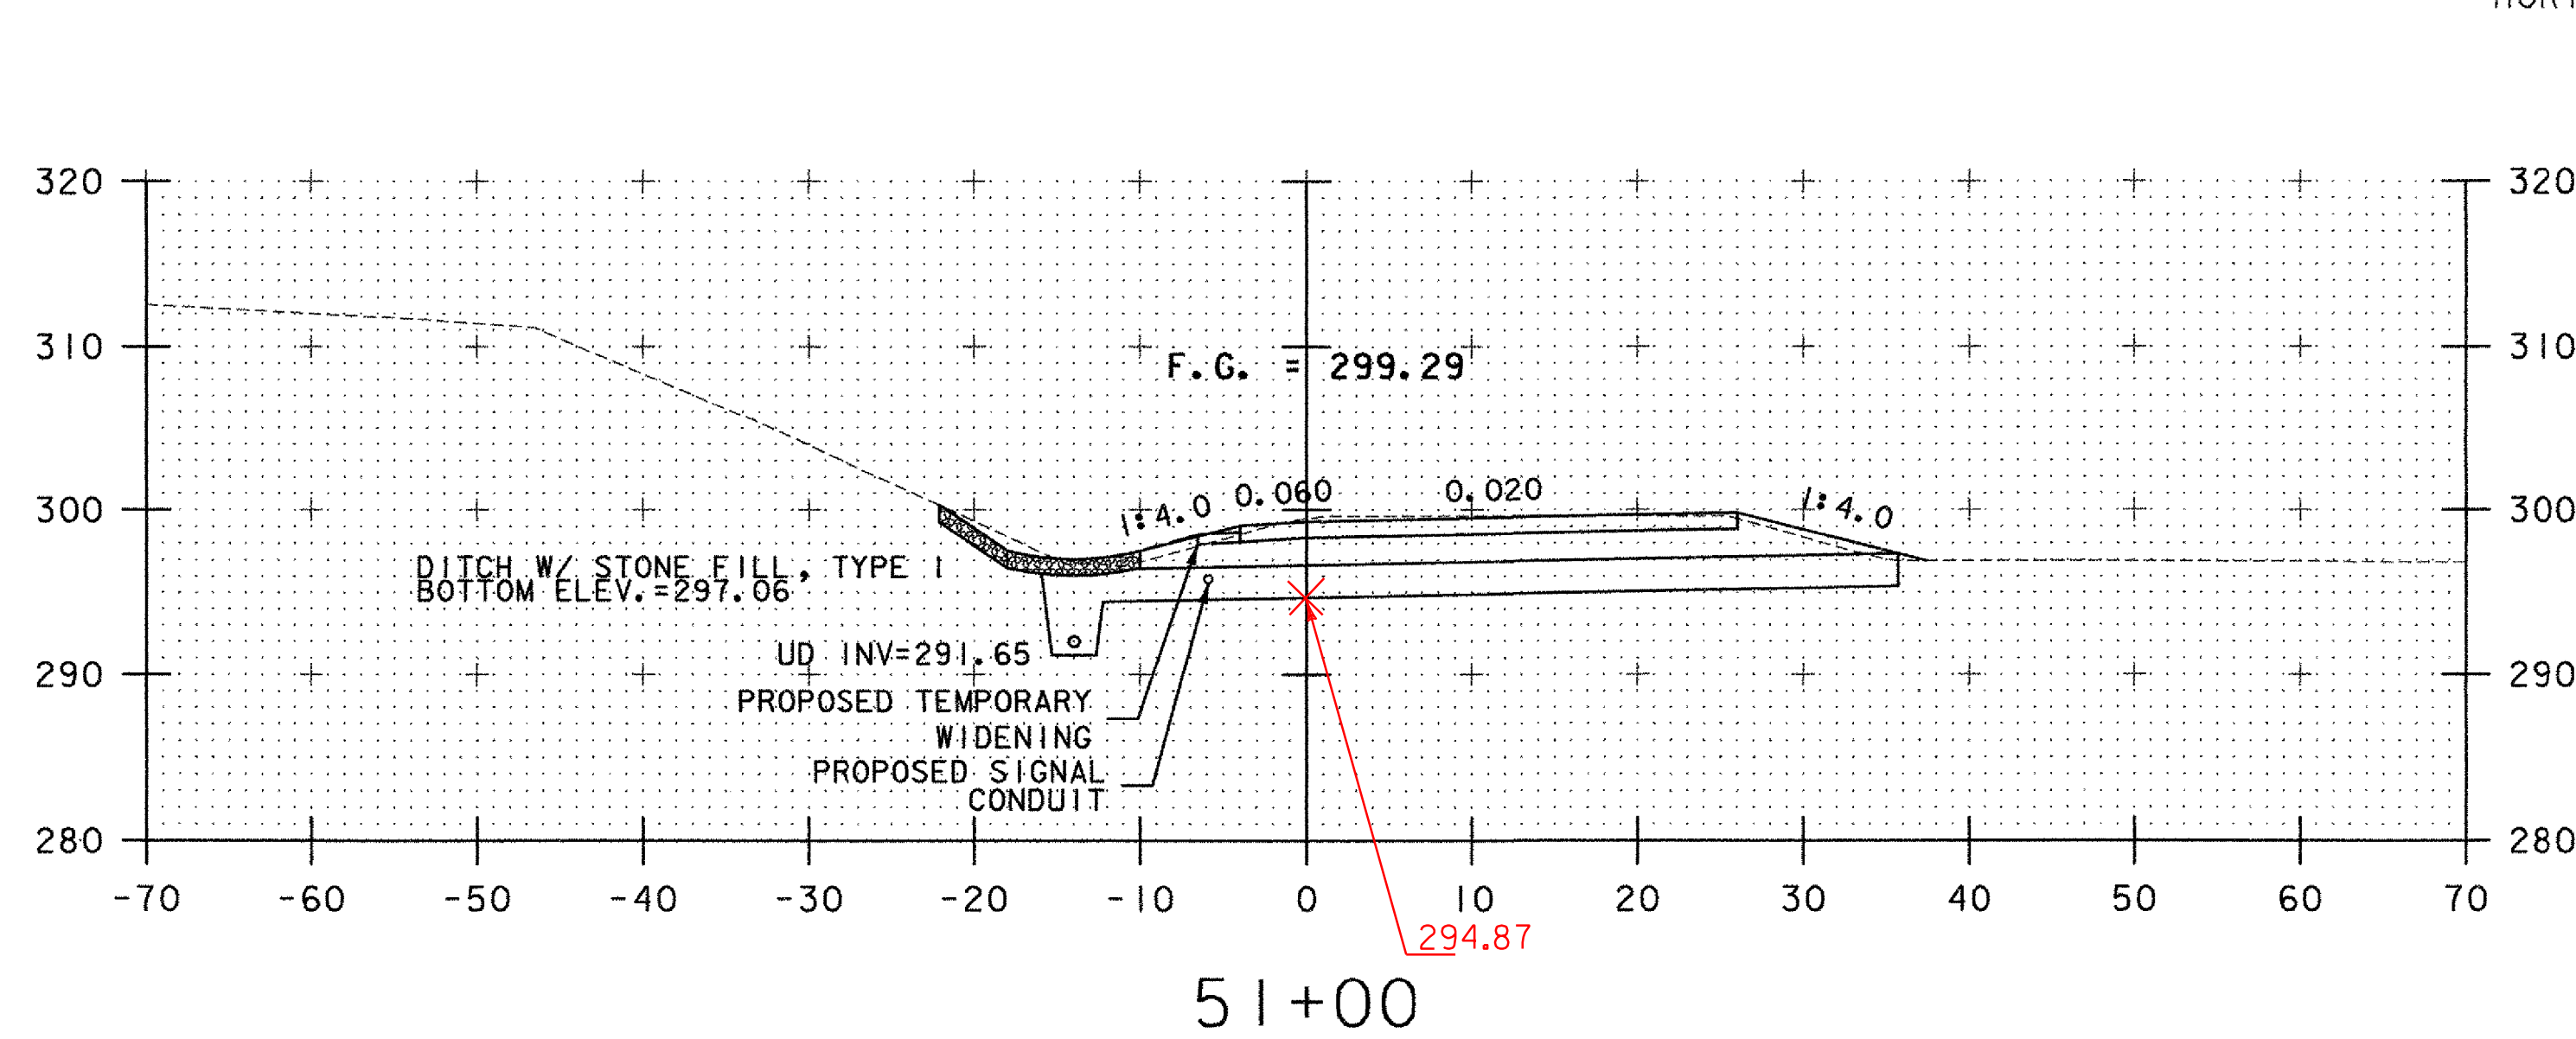
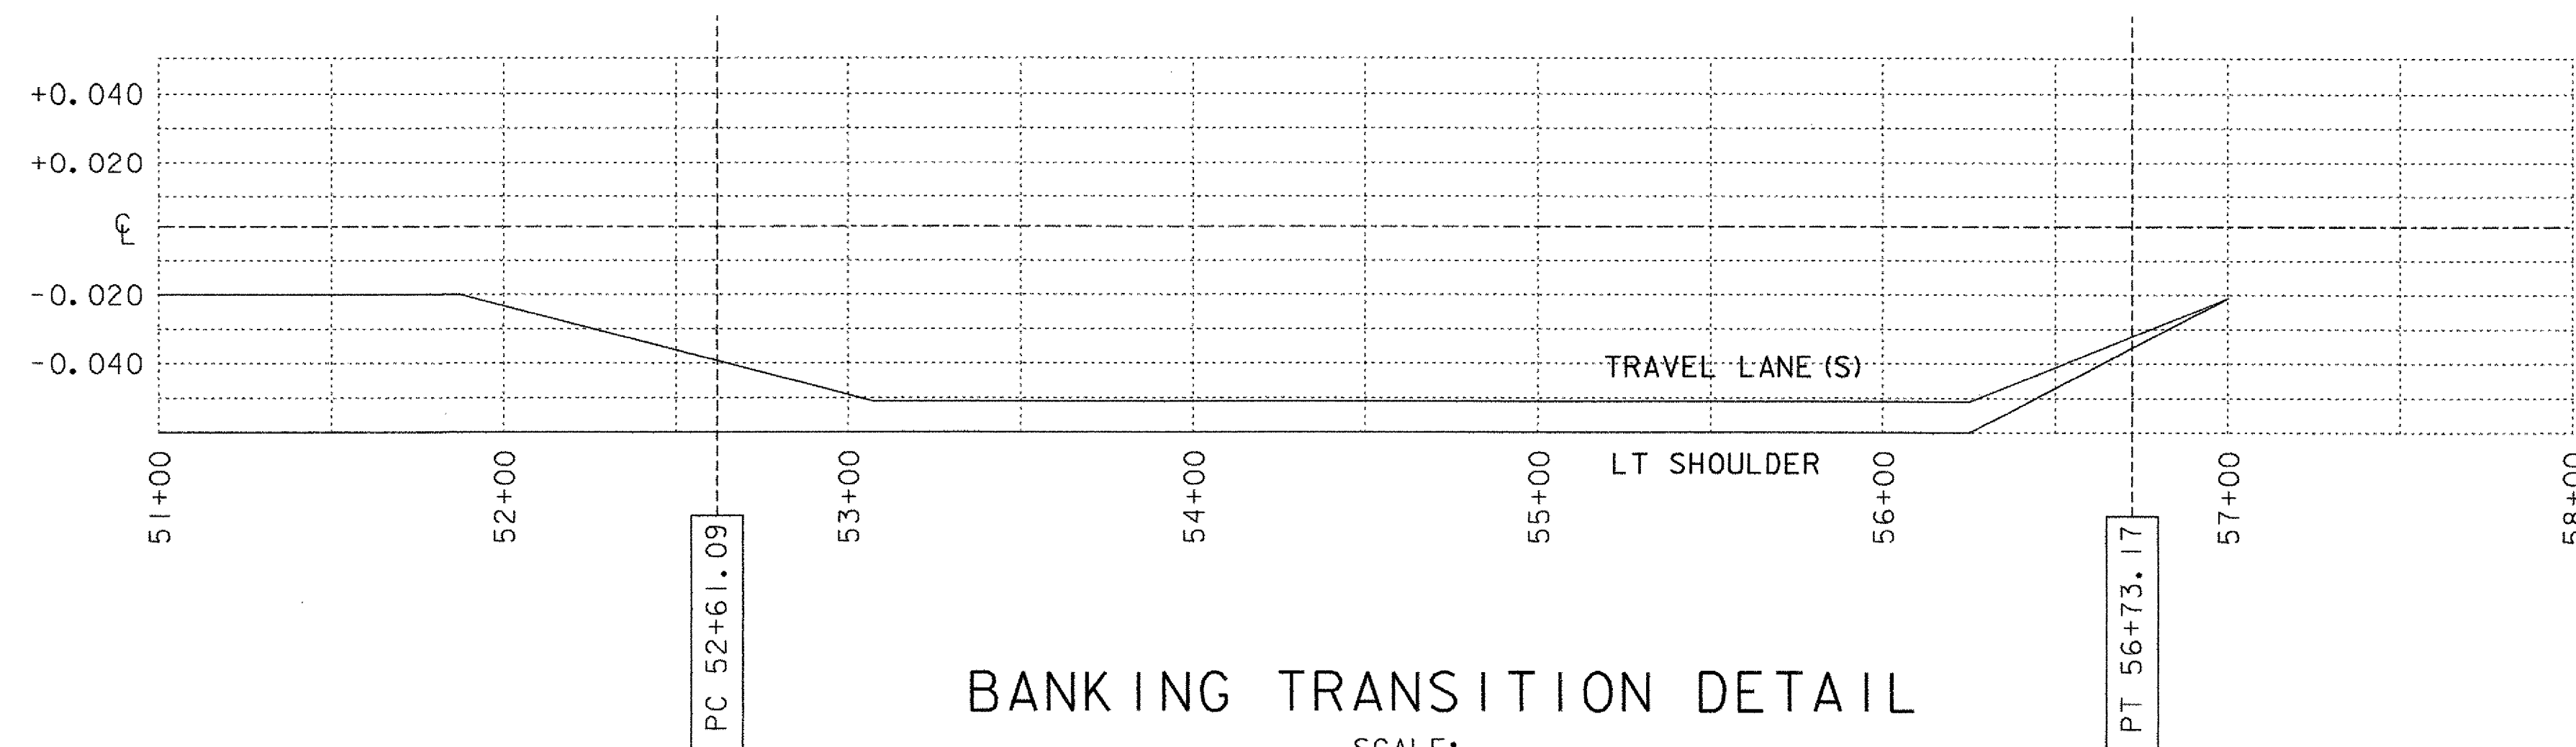


RAMP "C" SECTIONS SHEET 6

PROJECT NAME:	SOUTH BURLINGTON
PROJECT NUMBER:	IM 089-3(37)
FILE NAME:	z03d178xs.dgn
PROJECT LEADER:	KEN UPMAL
DESIGNED BY:	E. ATKINS
PLOT DATE:	5/5/2006
DRAWN BY:	E. ATKINS
CHECKED BY:	K. ISHIKURA
SHEET	87 OF 99

STA. 50+50 TO STA. 52+00

DATUM
VERTICAL NAVD 88
HORIZONTAL NAD 83 (1996)