
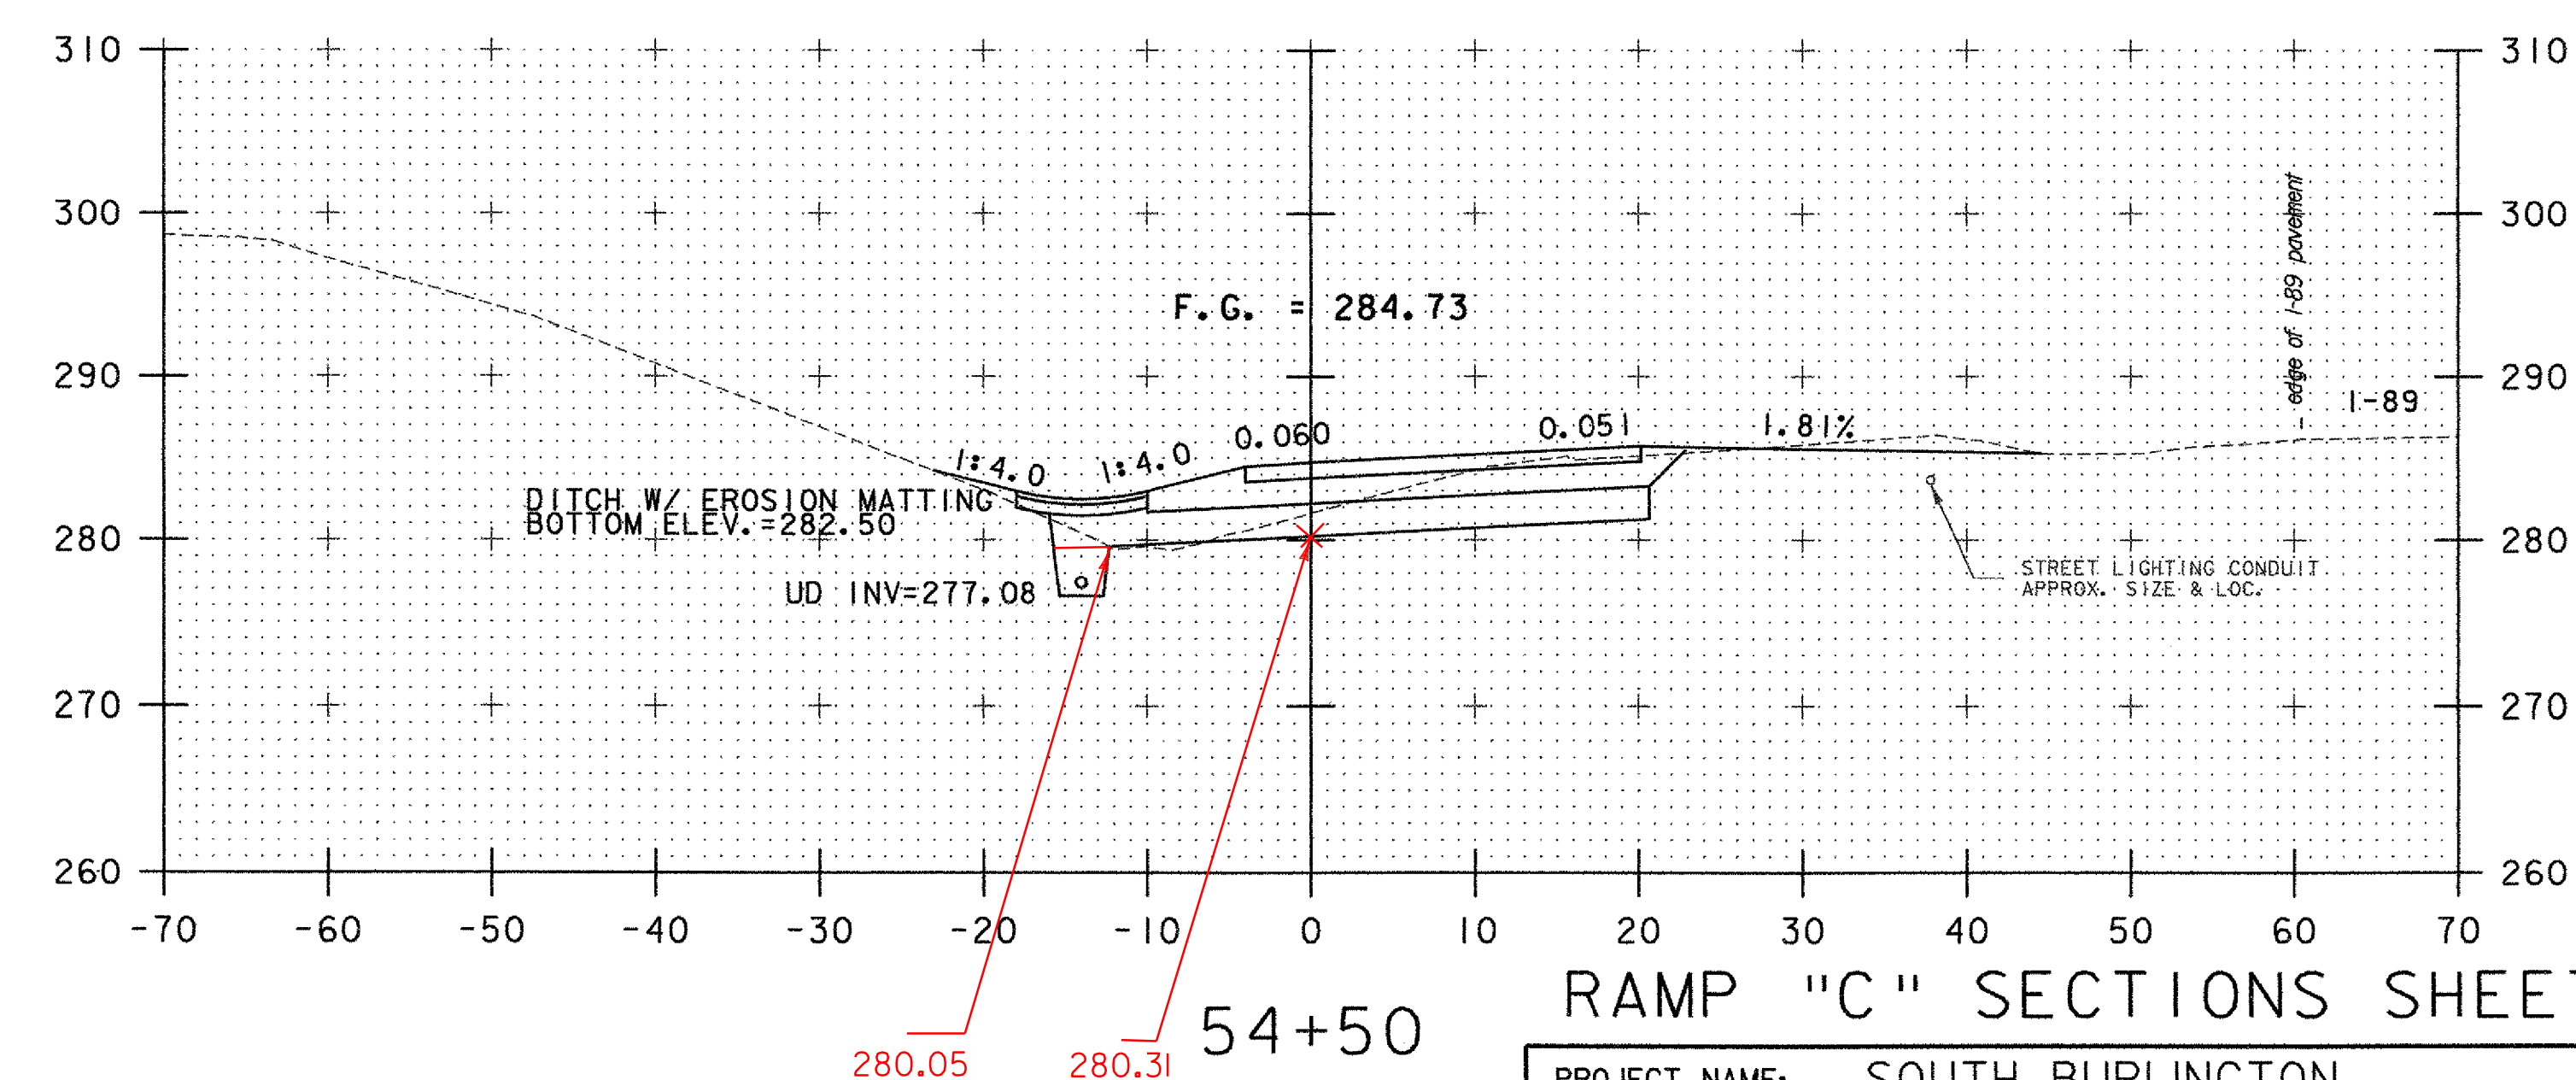
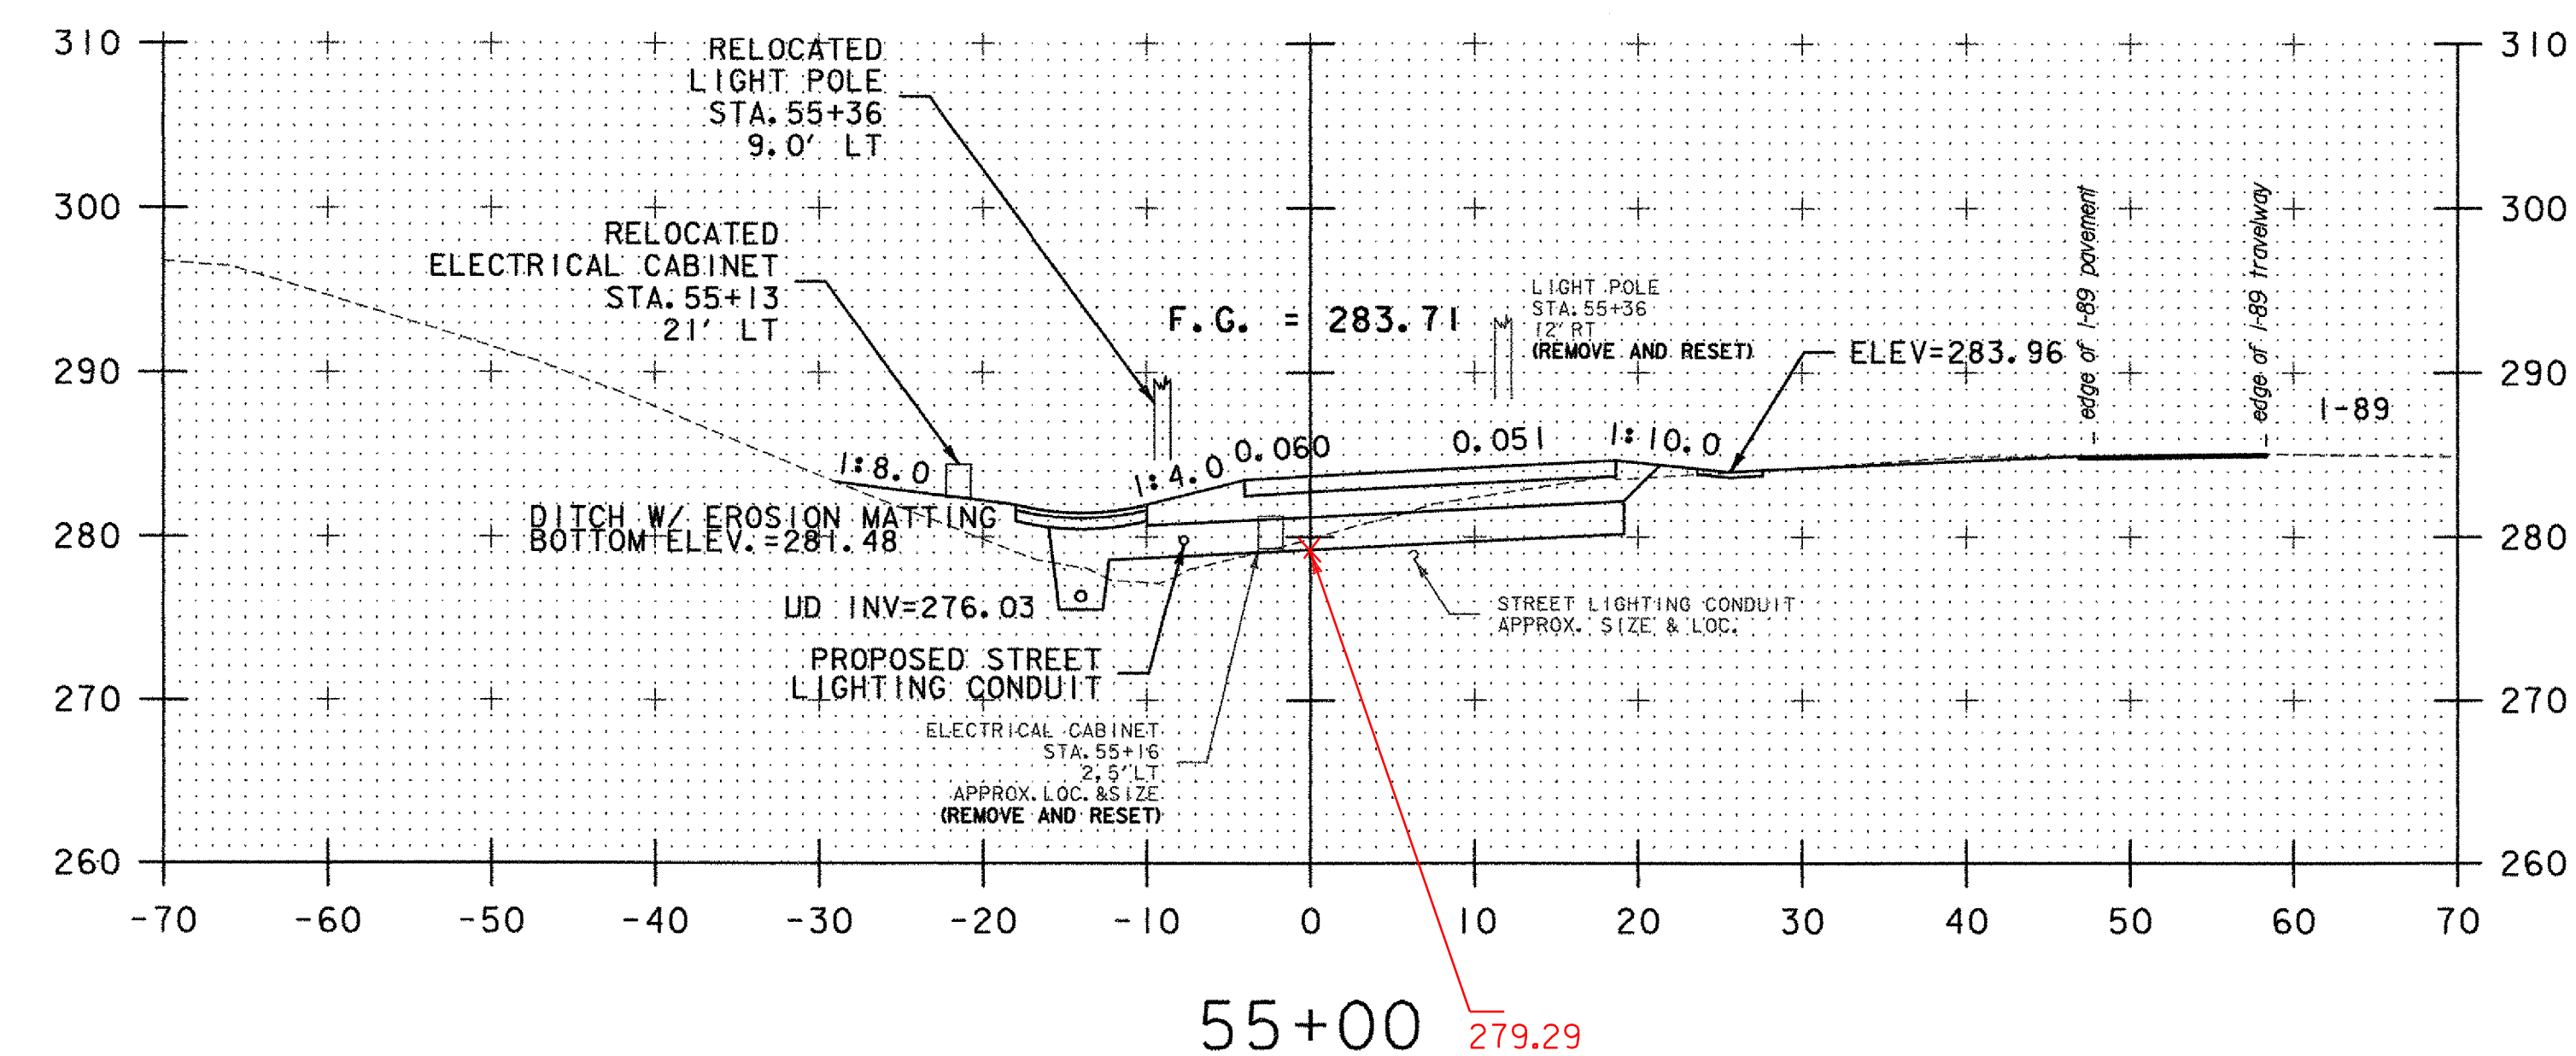
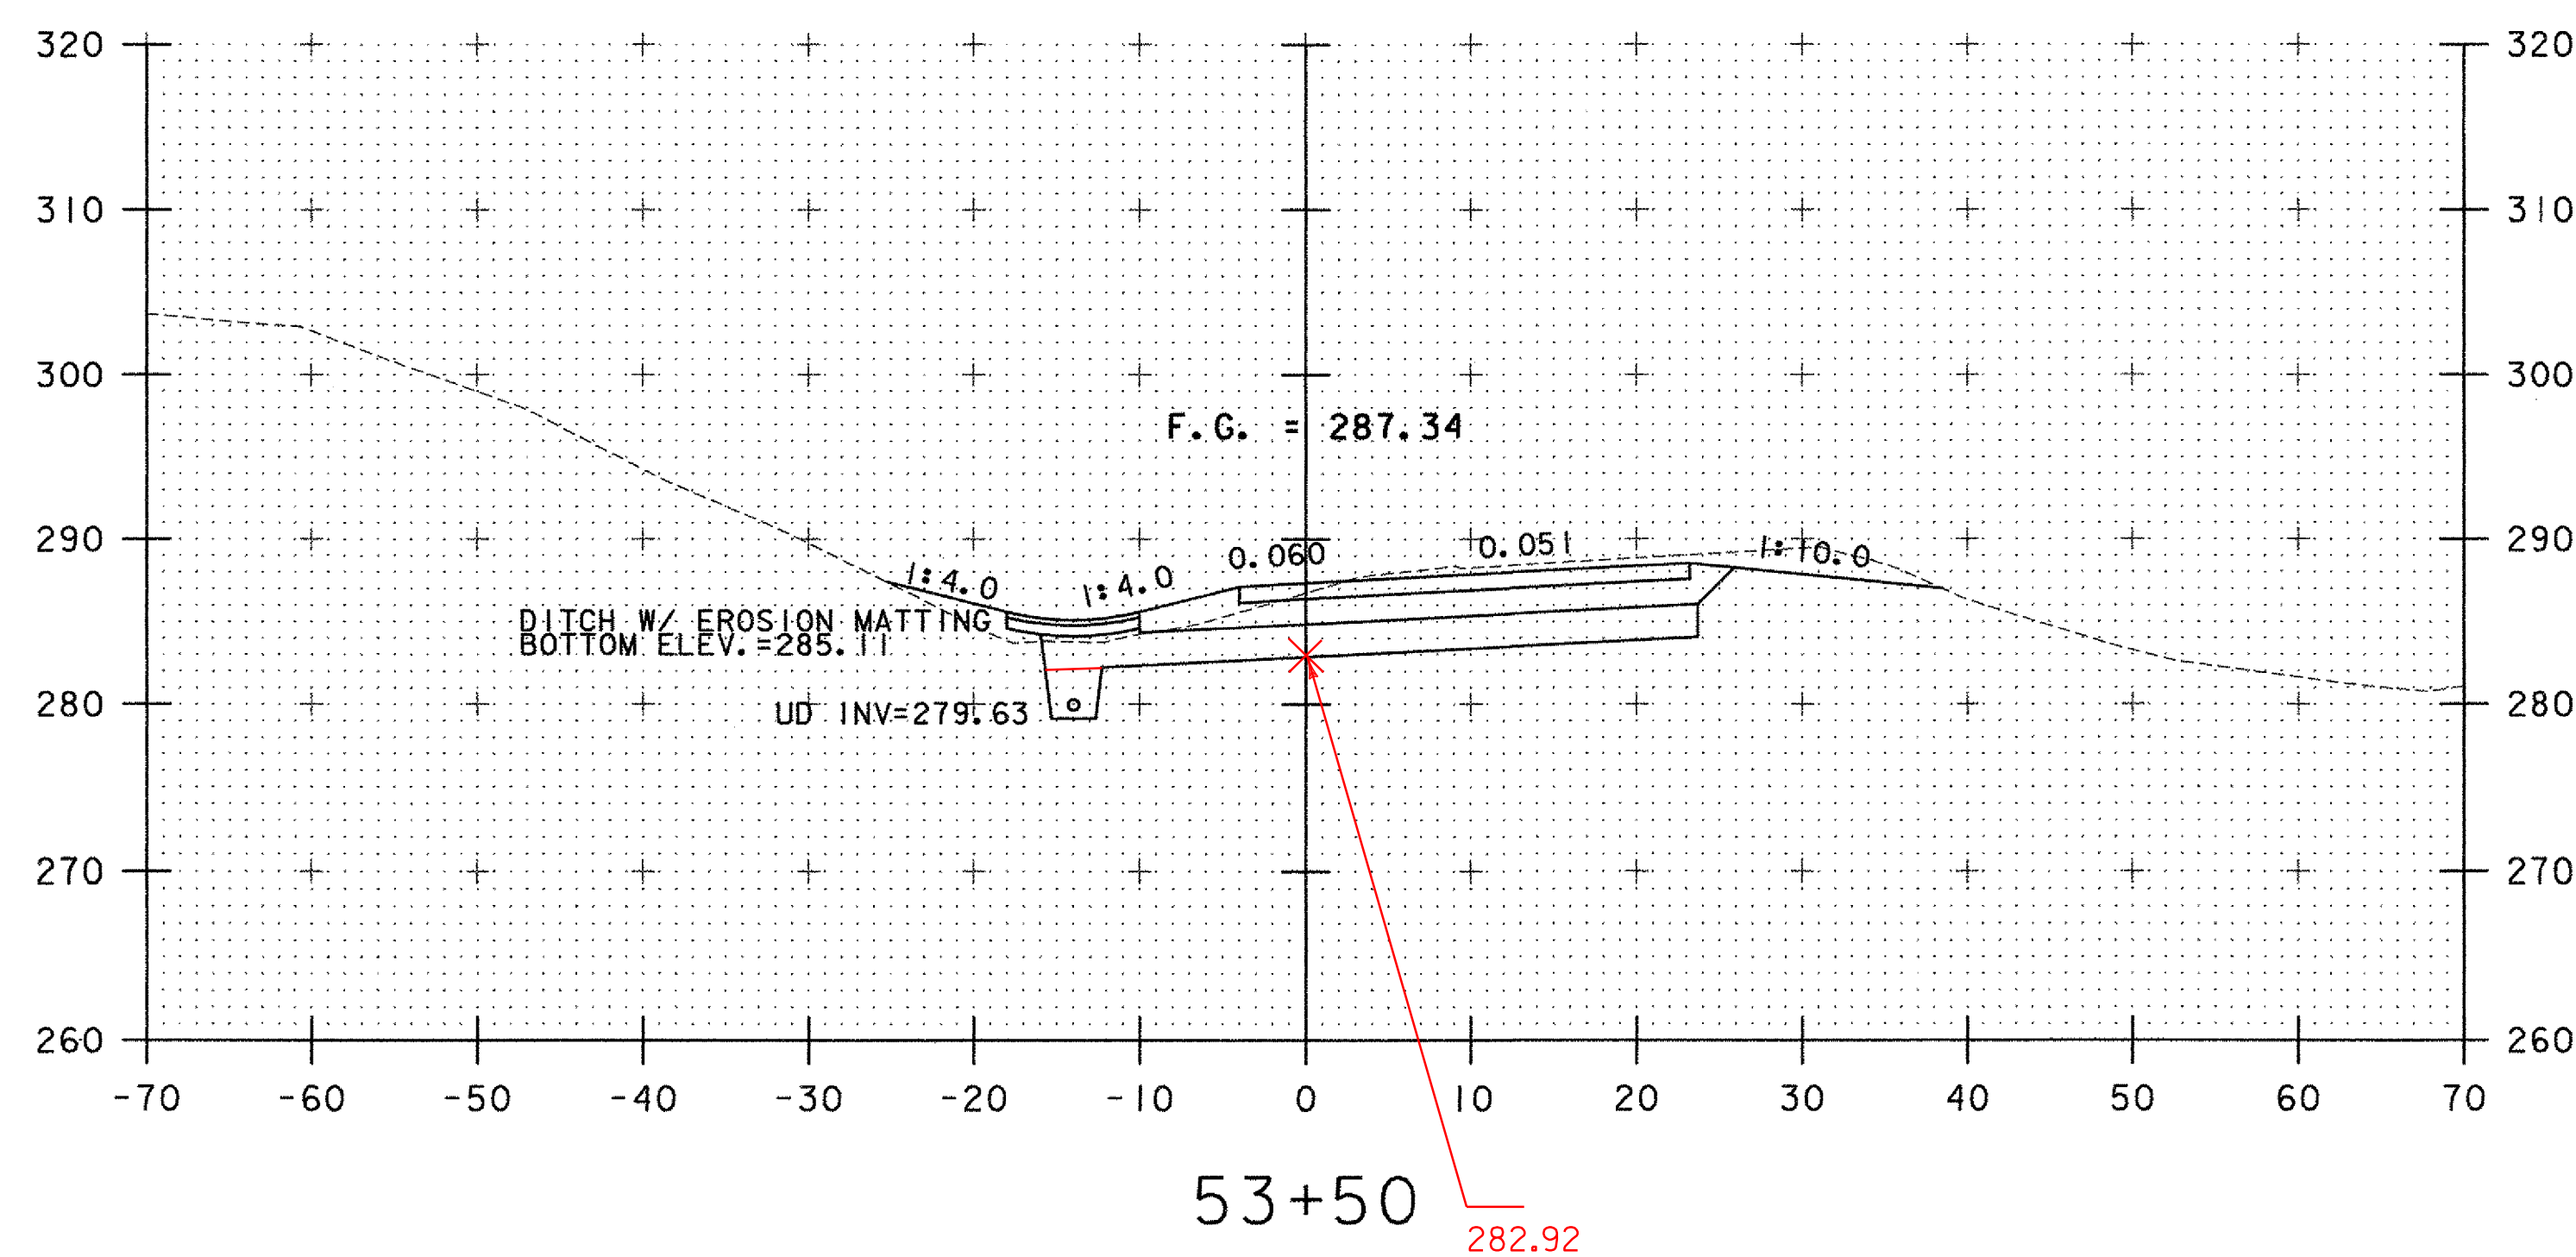


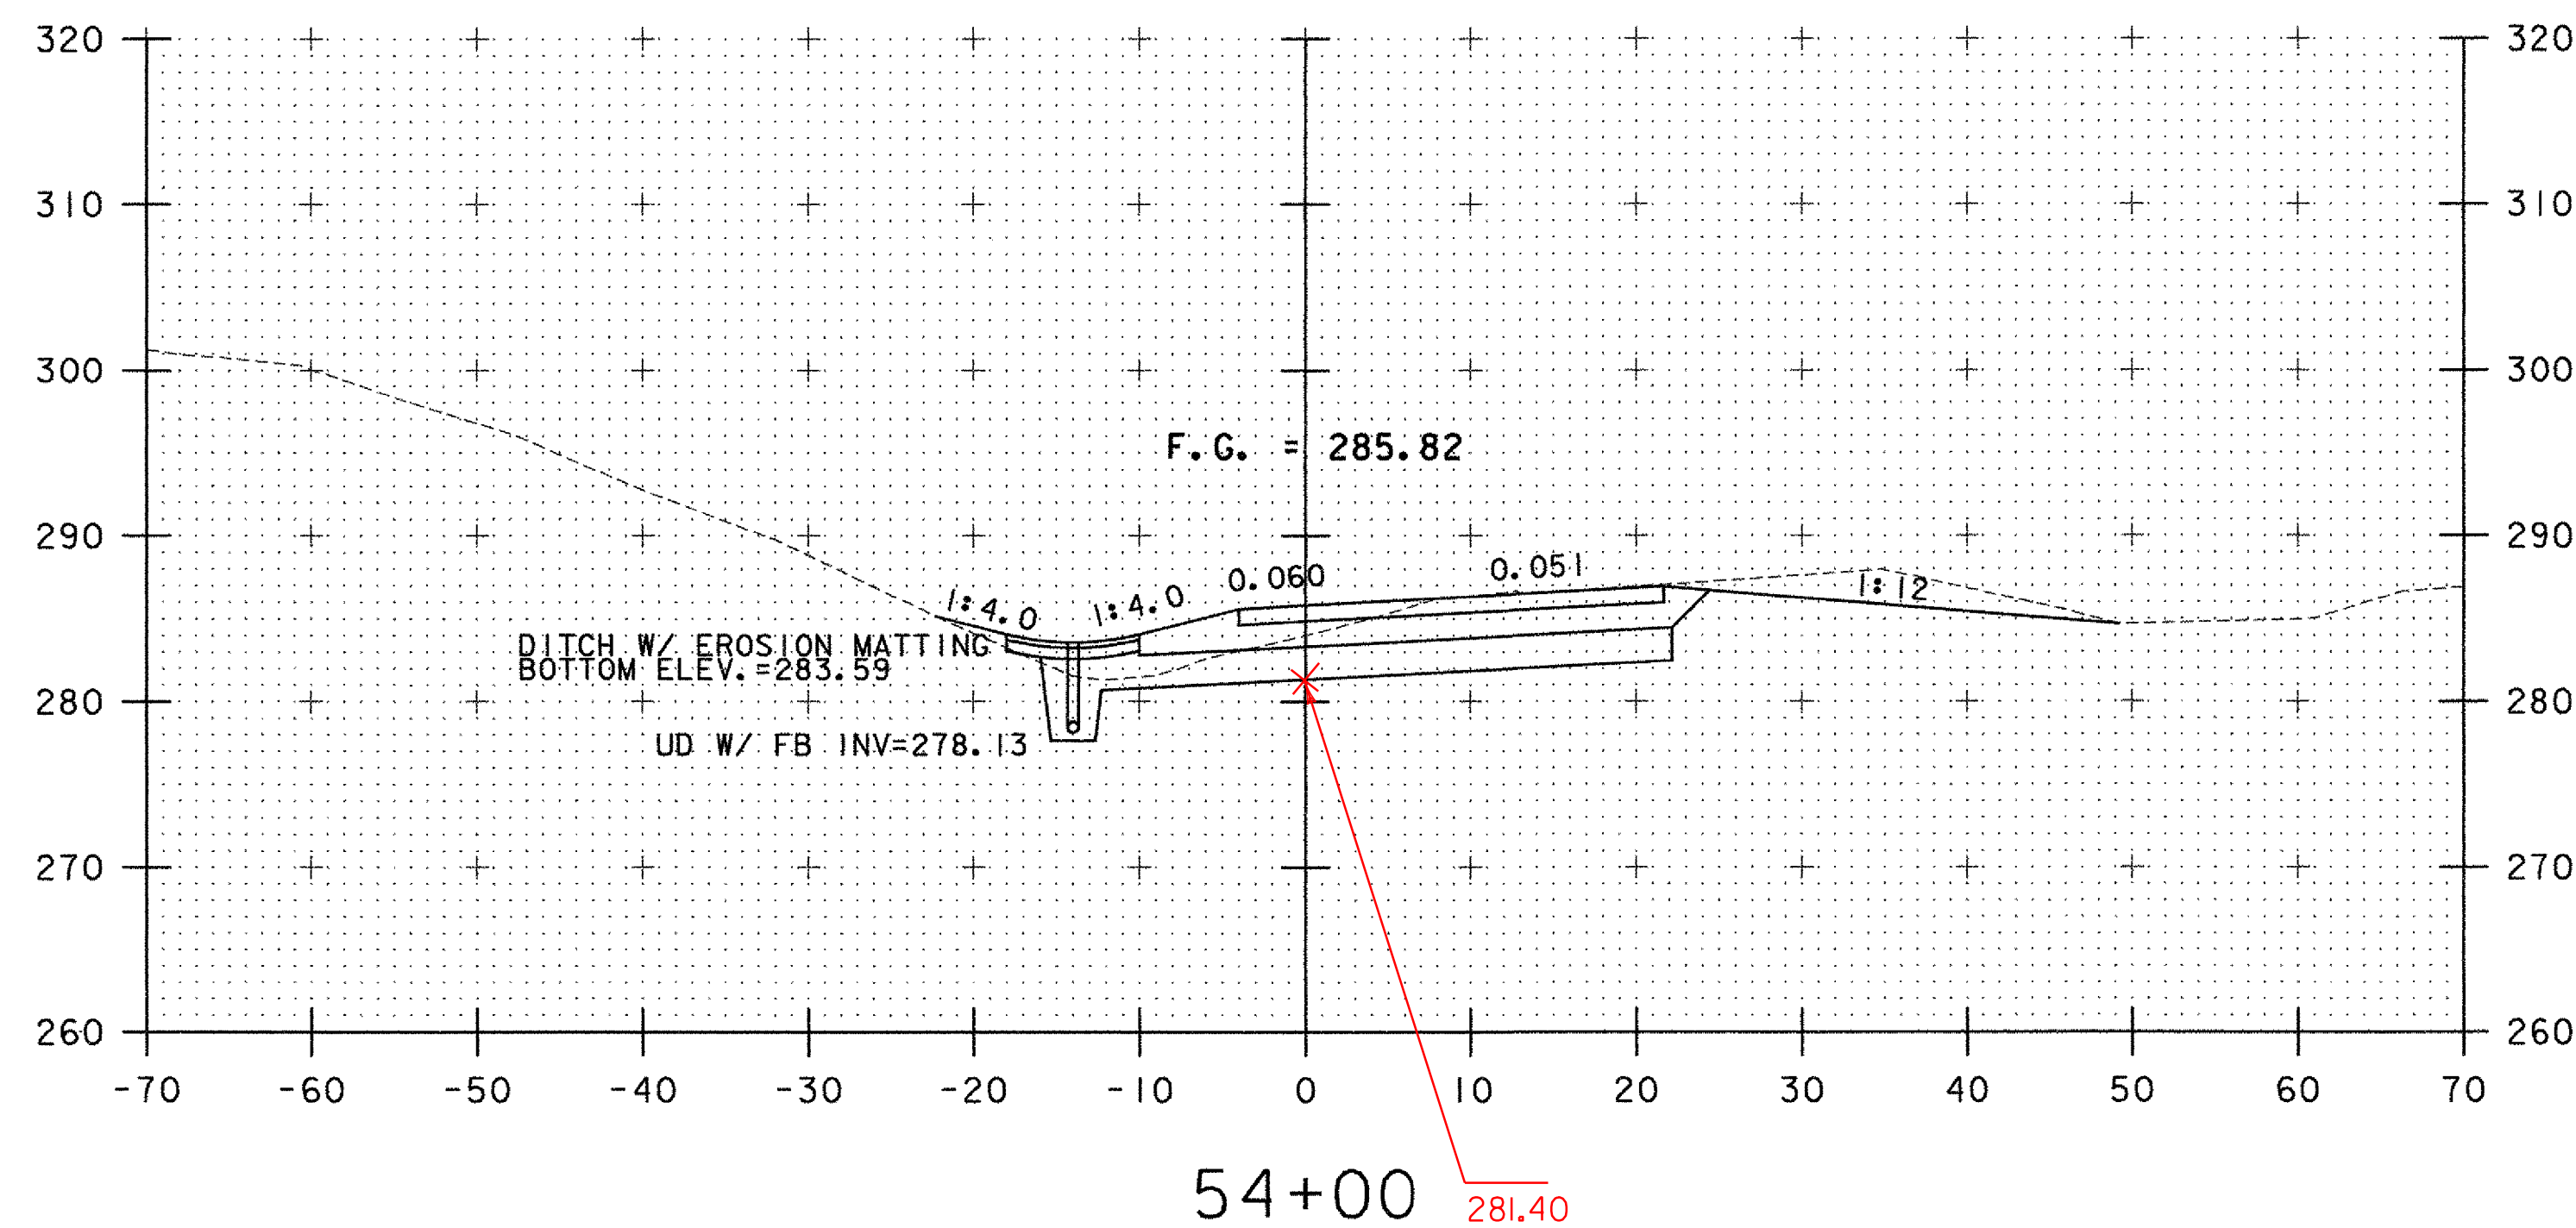

RAMP "C" SECTIONS SHEET 8

PROJECT NAME: SOUTH BURLINGTON

PROJECT NUMBER: IM 089-3(37)

FILE NAME: z03a178xs.dgn

PROJECT LEADER: KEN UPMAL

DESIGNED BY: E. ATKINS

PLOT DATE: 5/5/2006

DRAWN BY: E. ATKINS

CHECKED BY: K. ISHIKURA

SHEET 89 OF 99

0 10 20
SCALE IN FEET

STA. 53+50 TO STA. 55+00

DATUM
VERTICAL NAVD 88
HORIZONTAL NAD 83 (1996)