
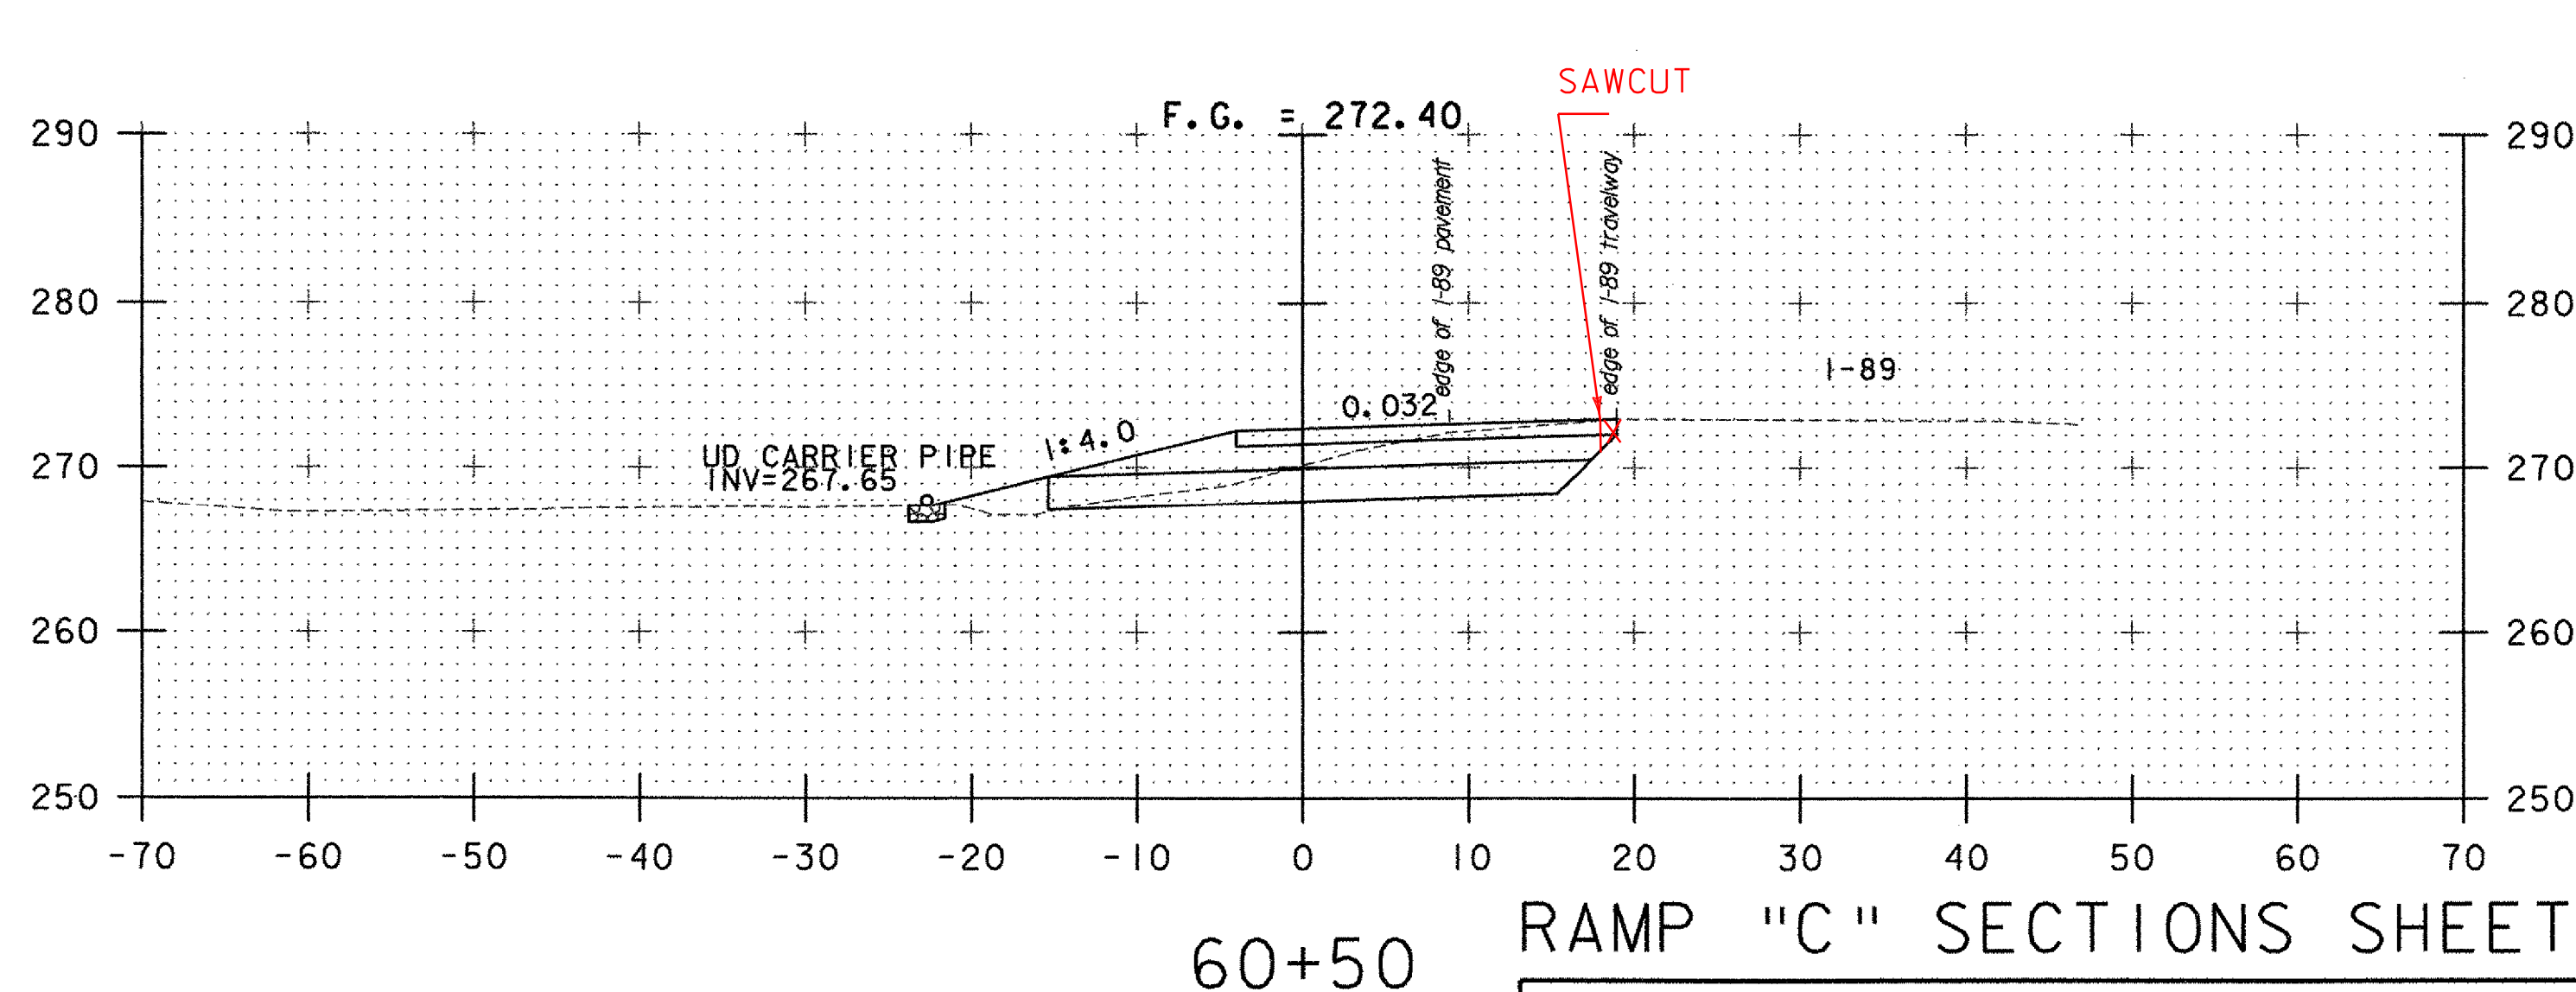
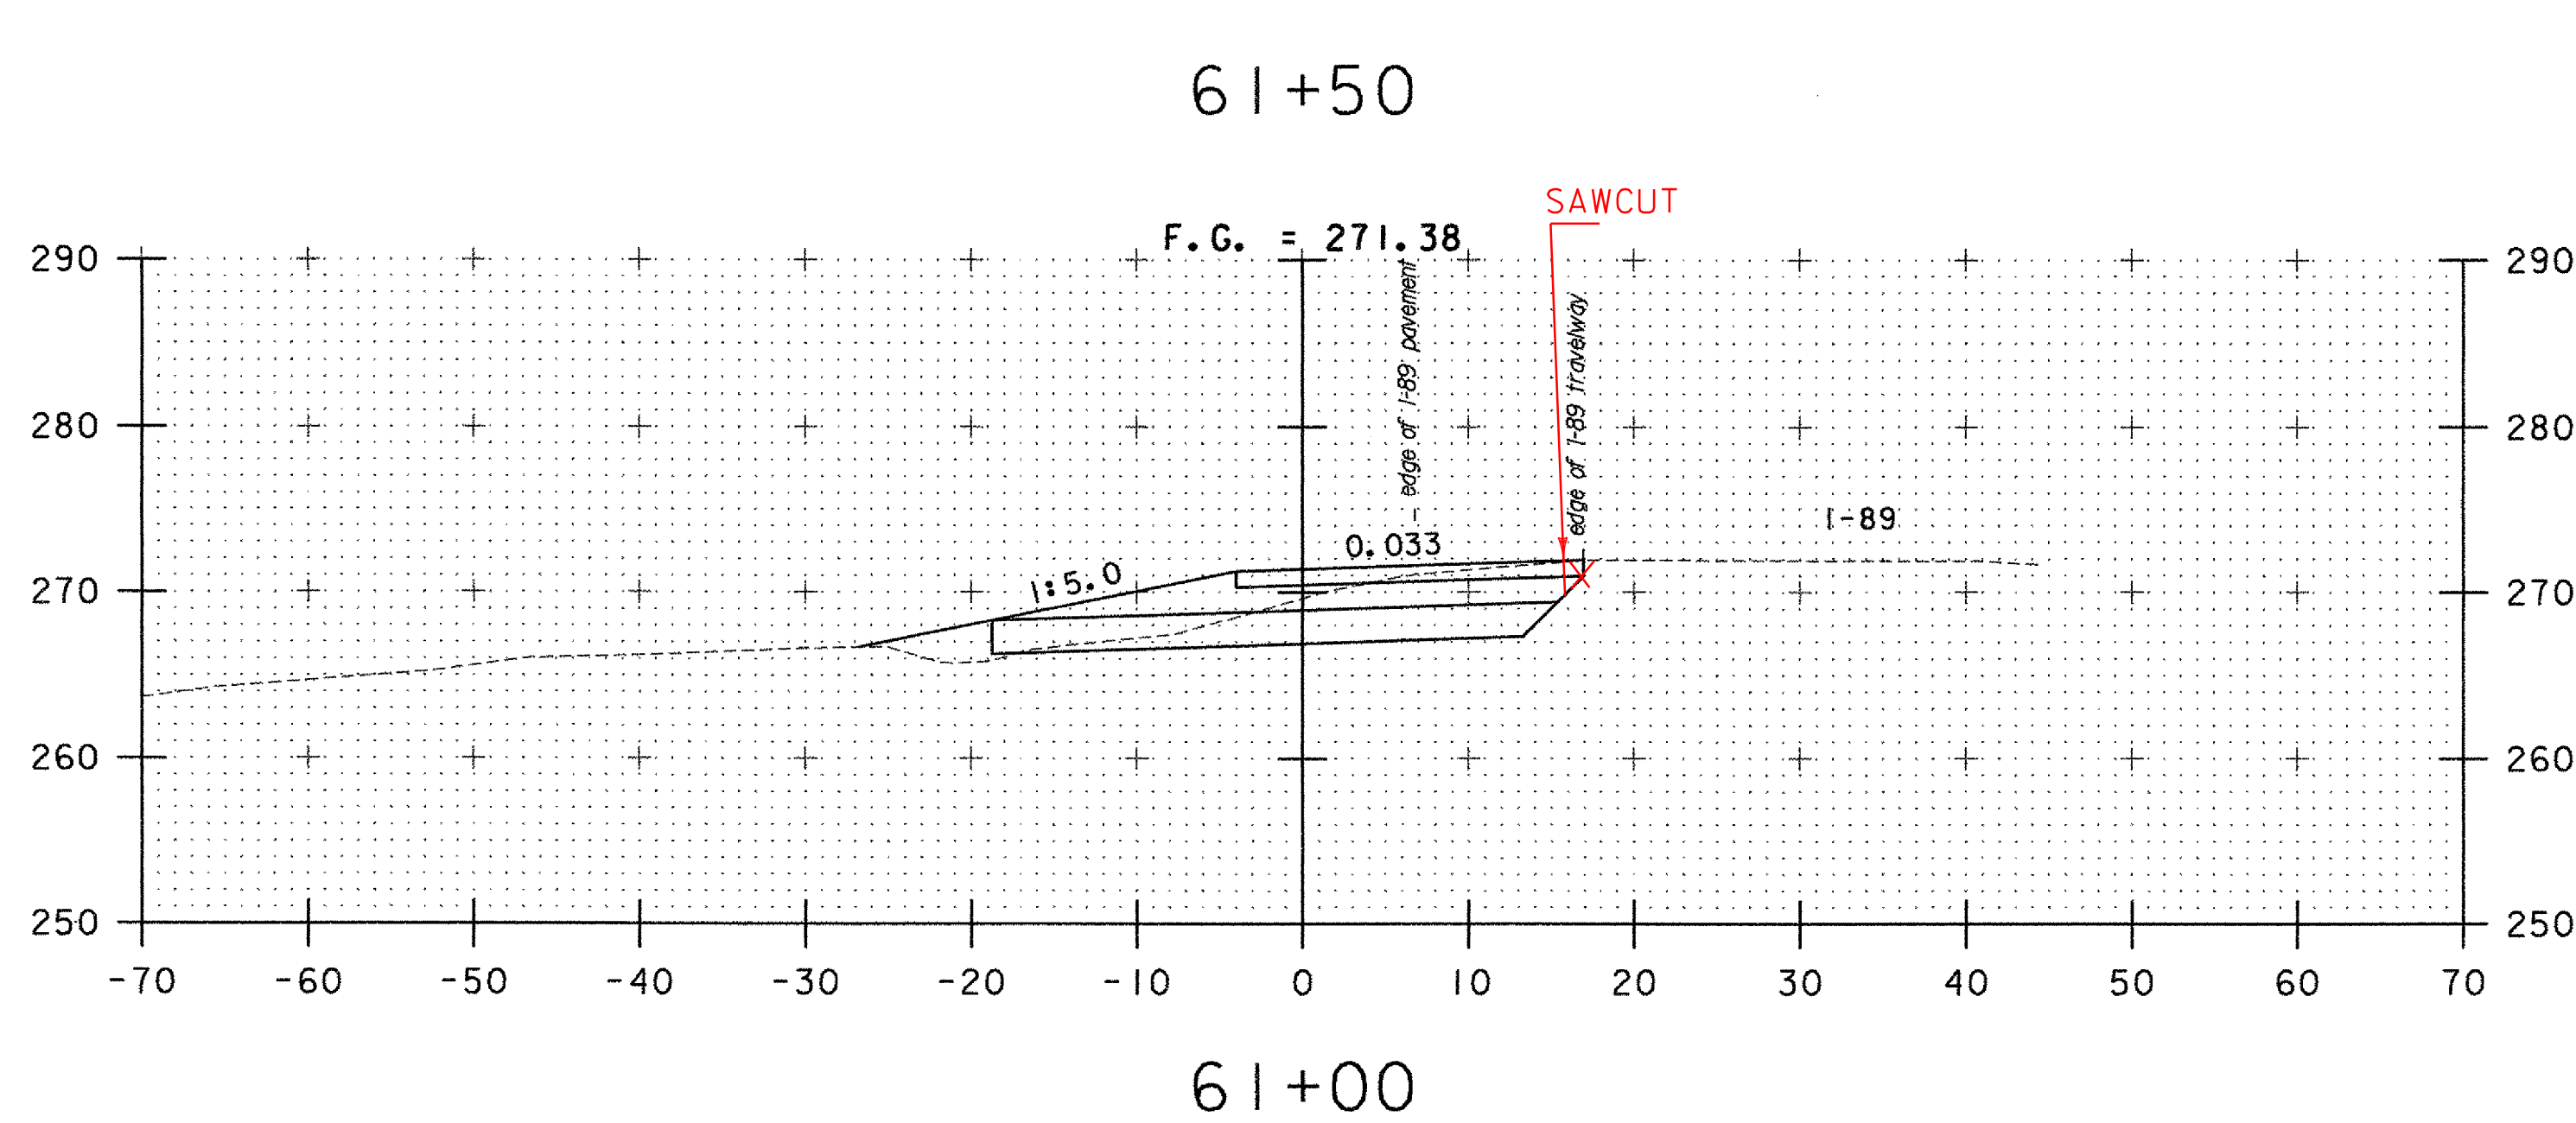
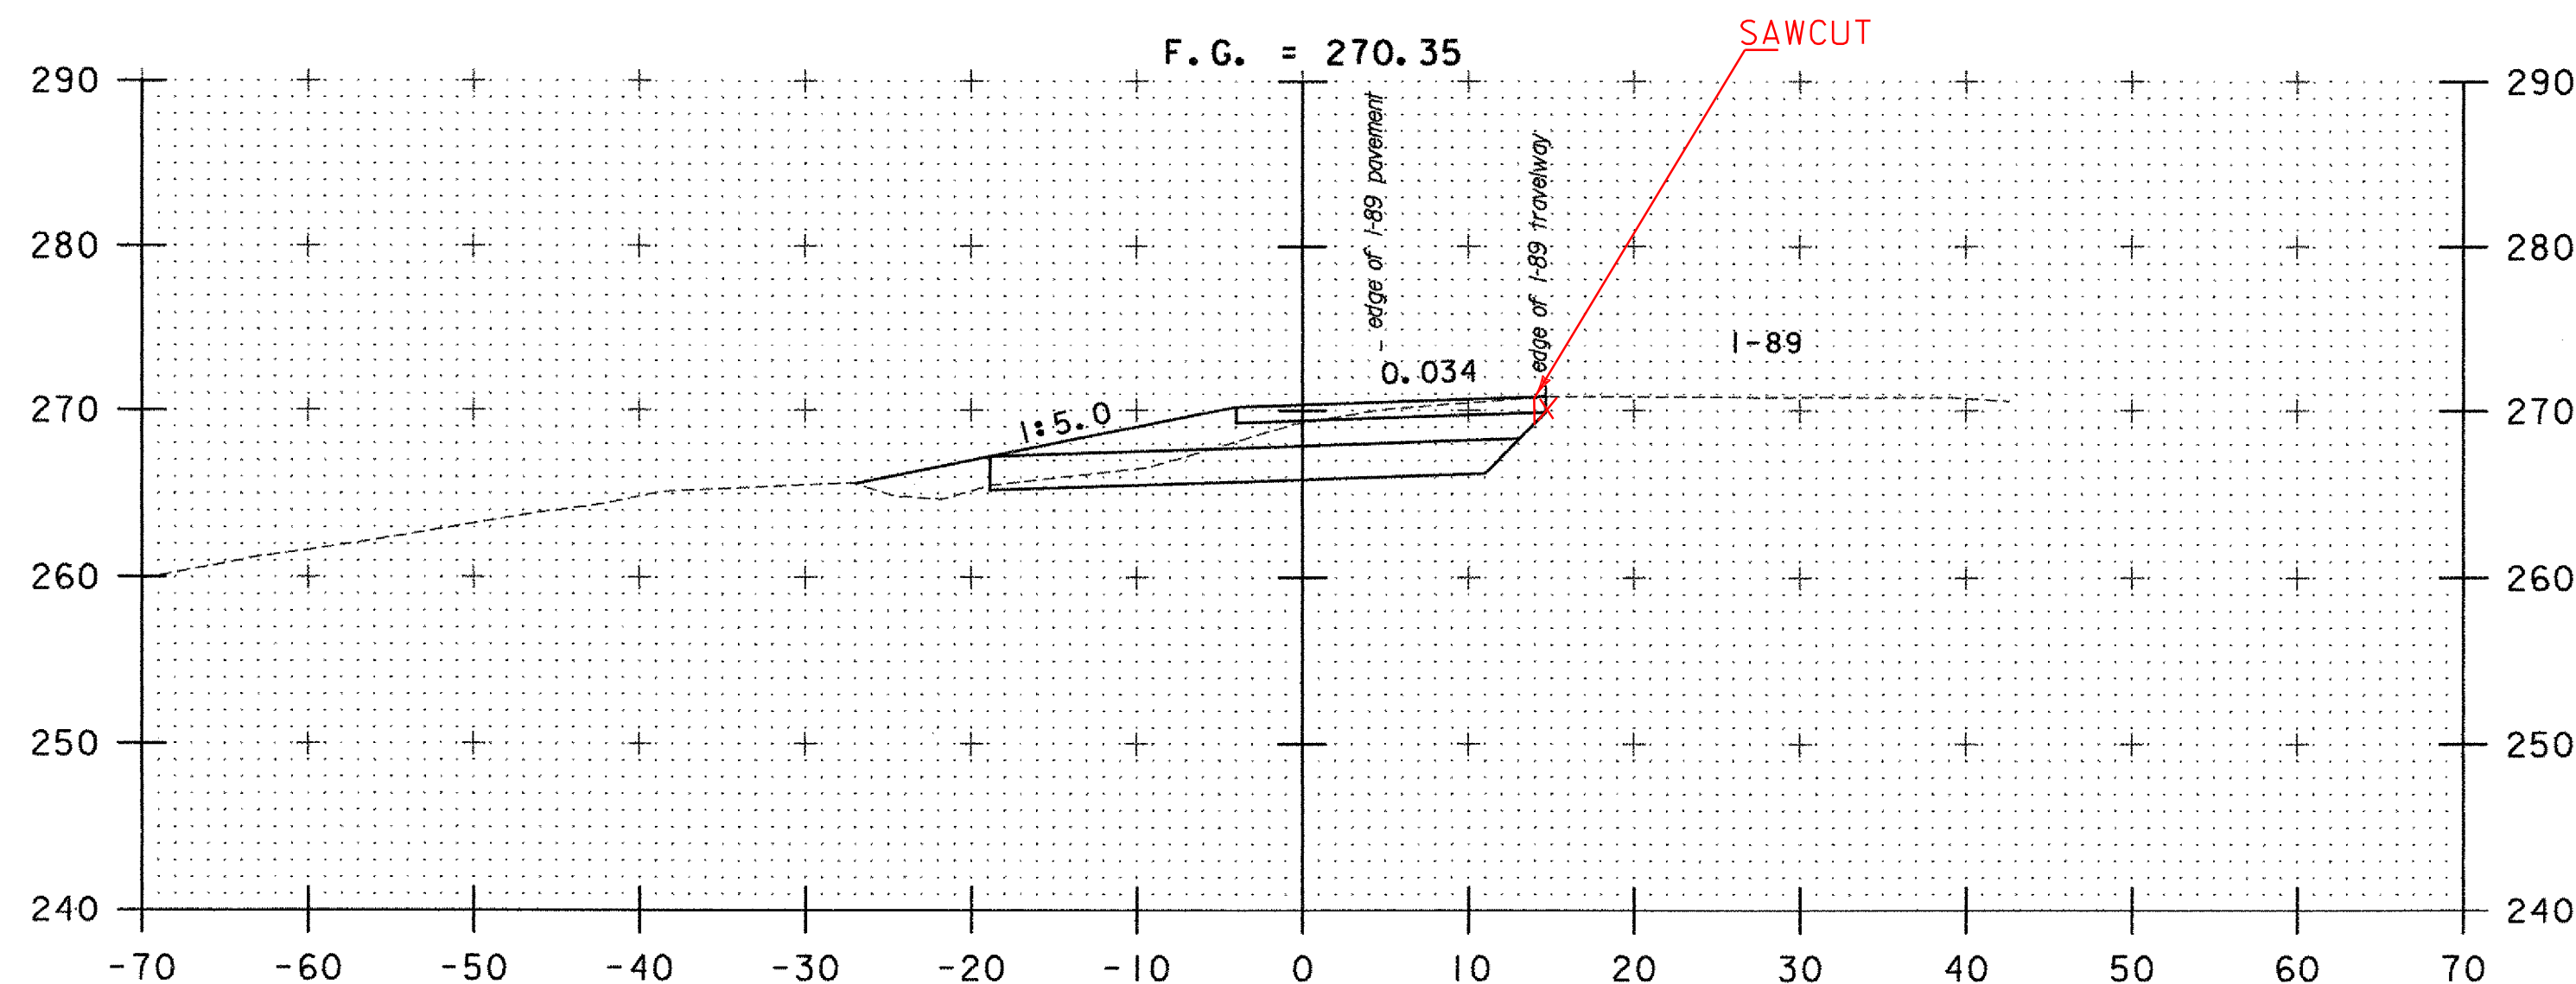
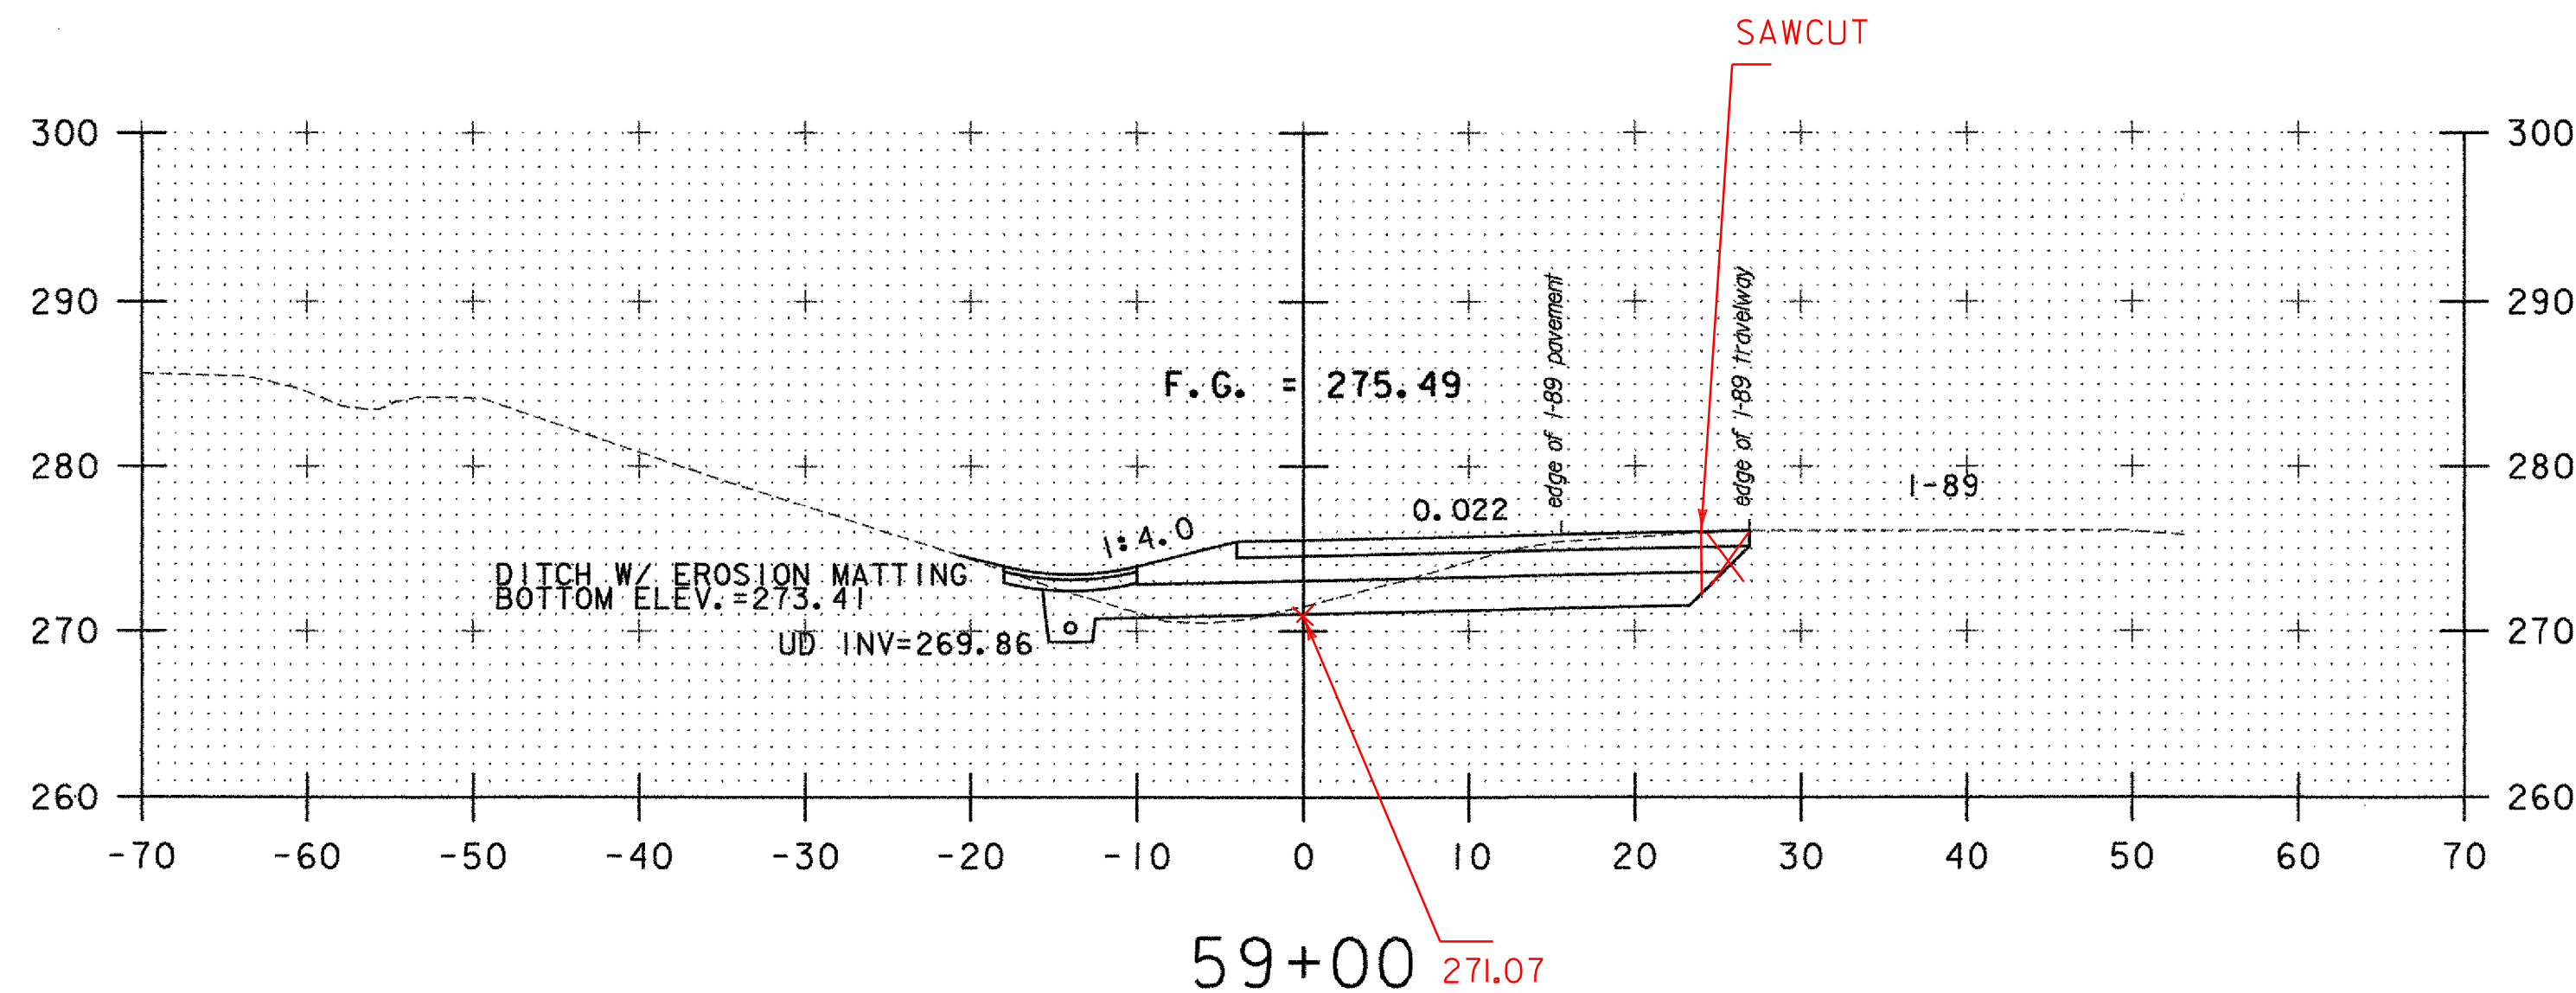
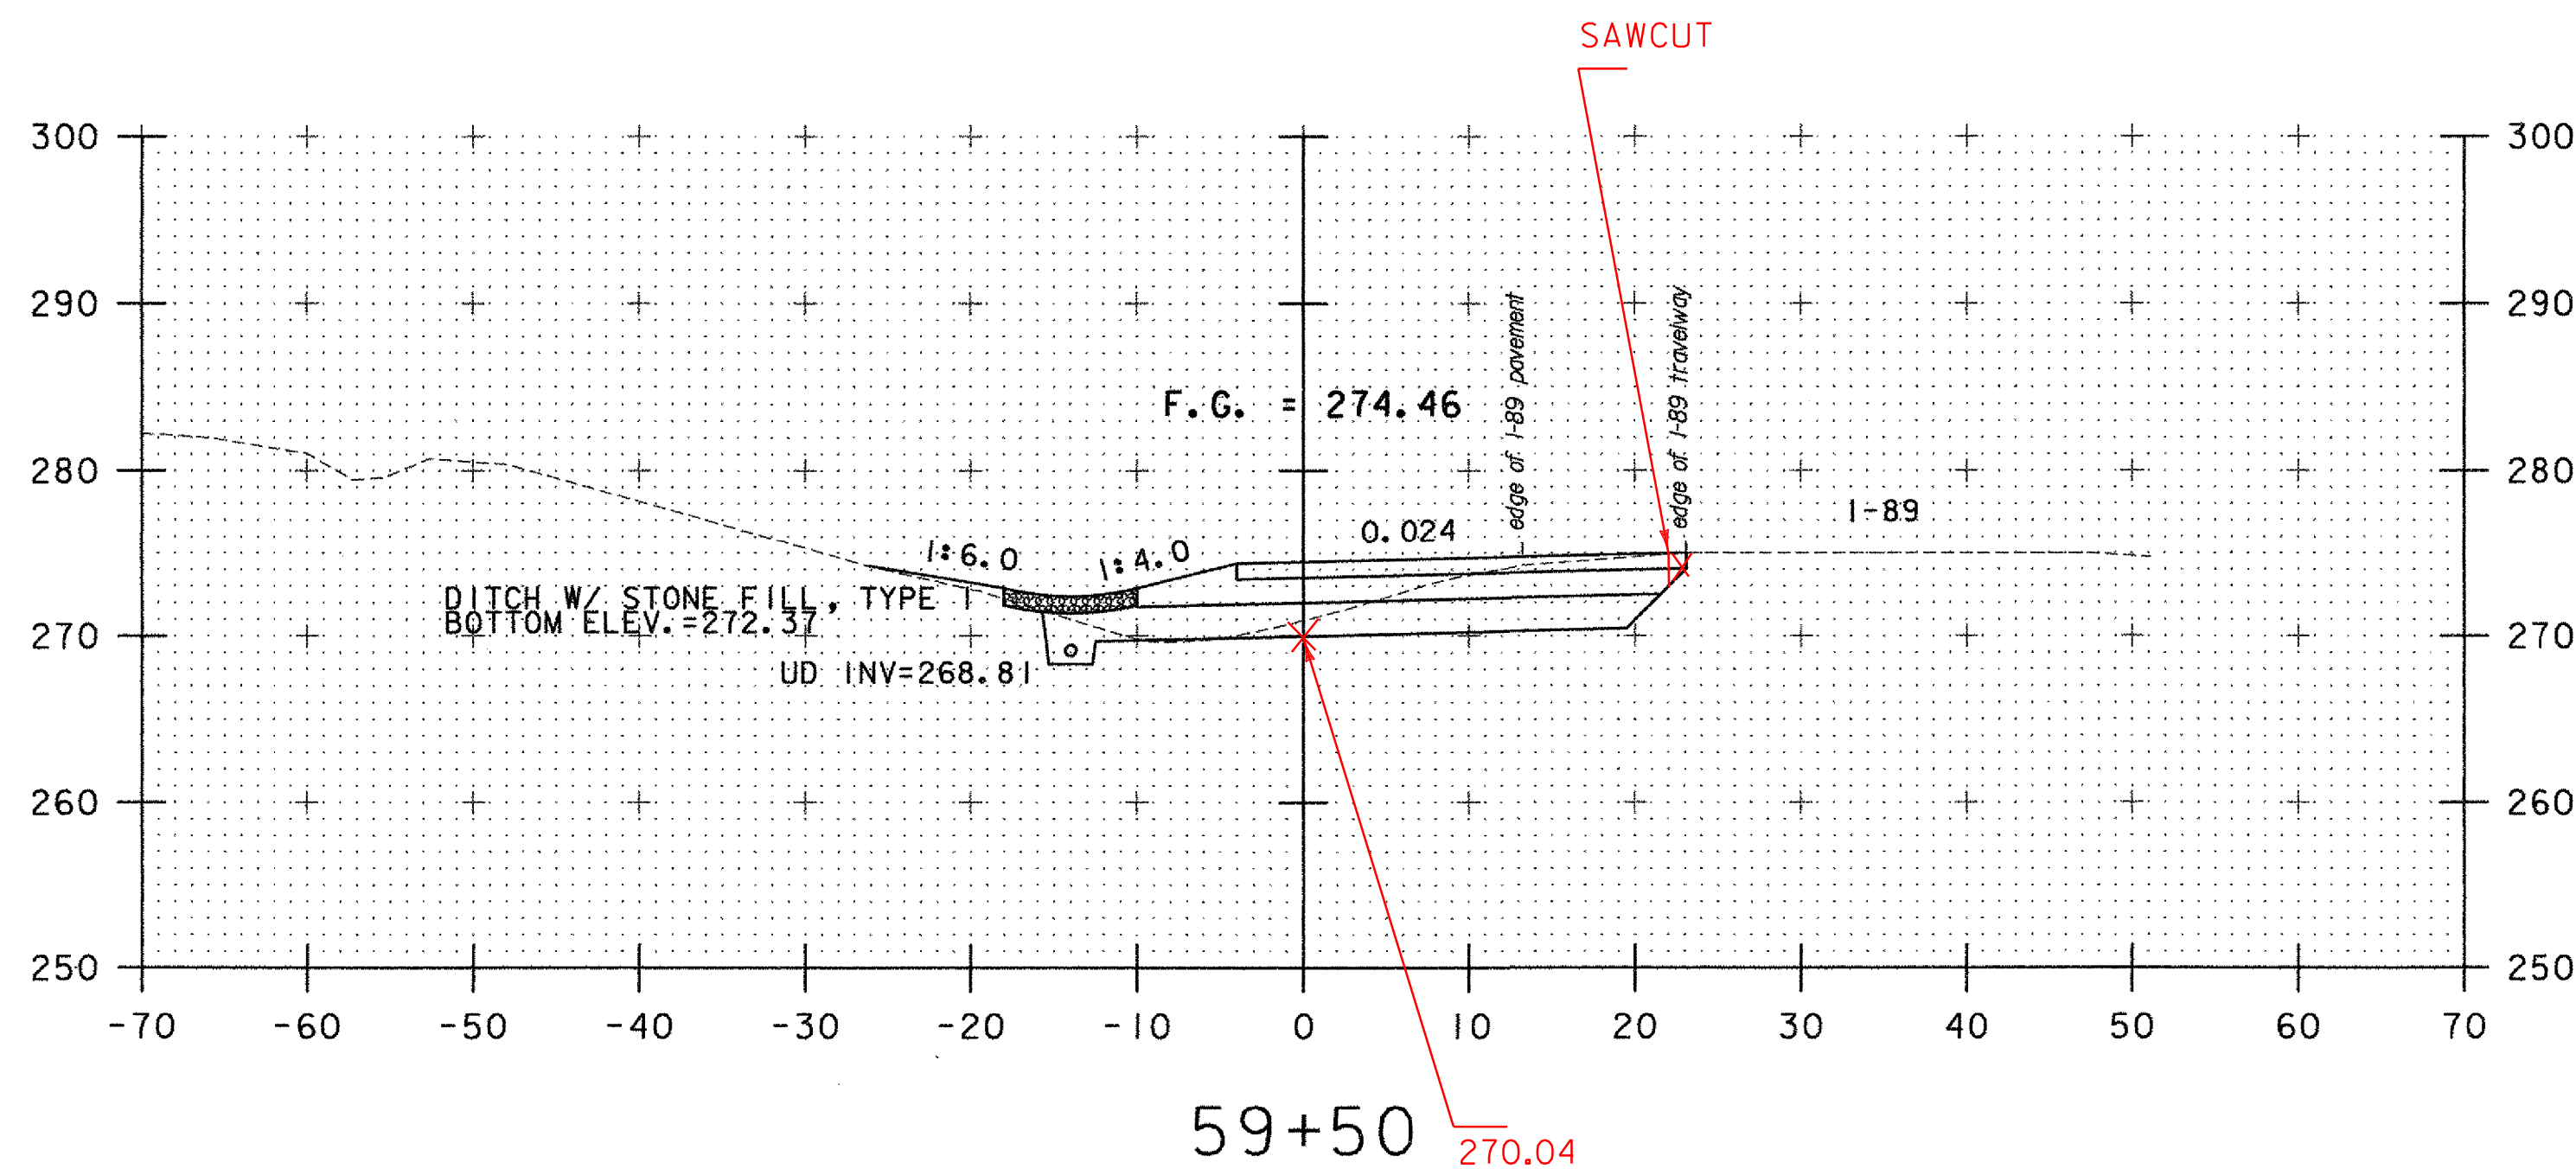


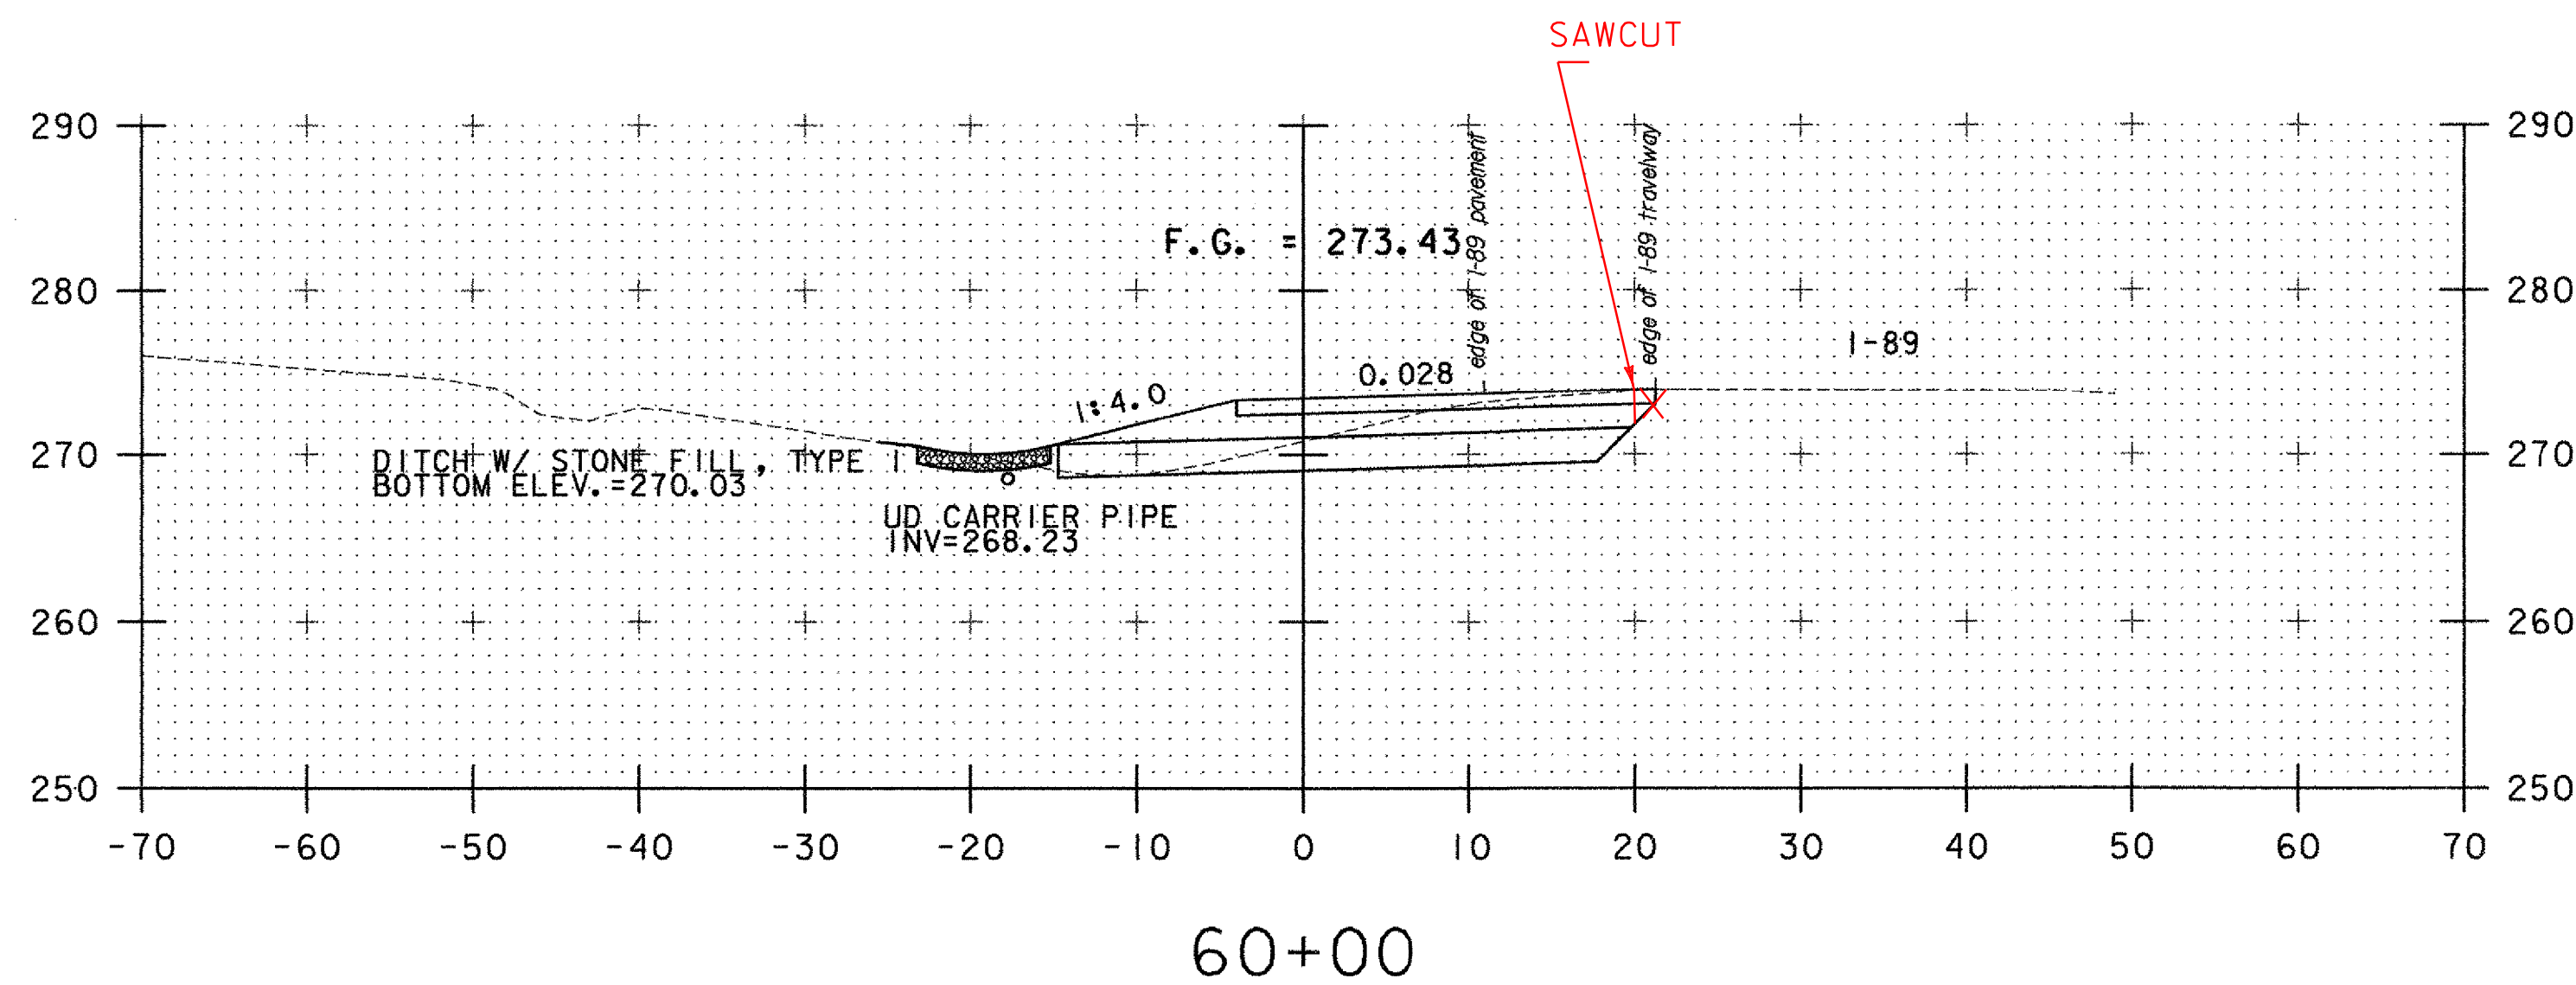

RAMP "C" SECTIONS SHEET 11

PROJECT NAME: SOUTH BURLINGTON
PROJECT NUMBER: IM 089-3(37)

FILE NAME: z03a178xs.dgn
PROJECT LEADER: KEN UPMAL
DESIGNED BY: E. ATKINS

PLOT DATE: 5/5/2006
DRAWN BY: E. ATKINS
CHECKED BY: K. ISHIKURA
SHEET 92 OF 99

0 10 20
SCALE IN FEET

STA. 59+00 TO STA. 61+50

DATUM
VERTICAL NAVD 88
HORIZONTAL NAD 83 (1996)