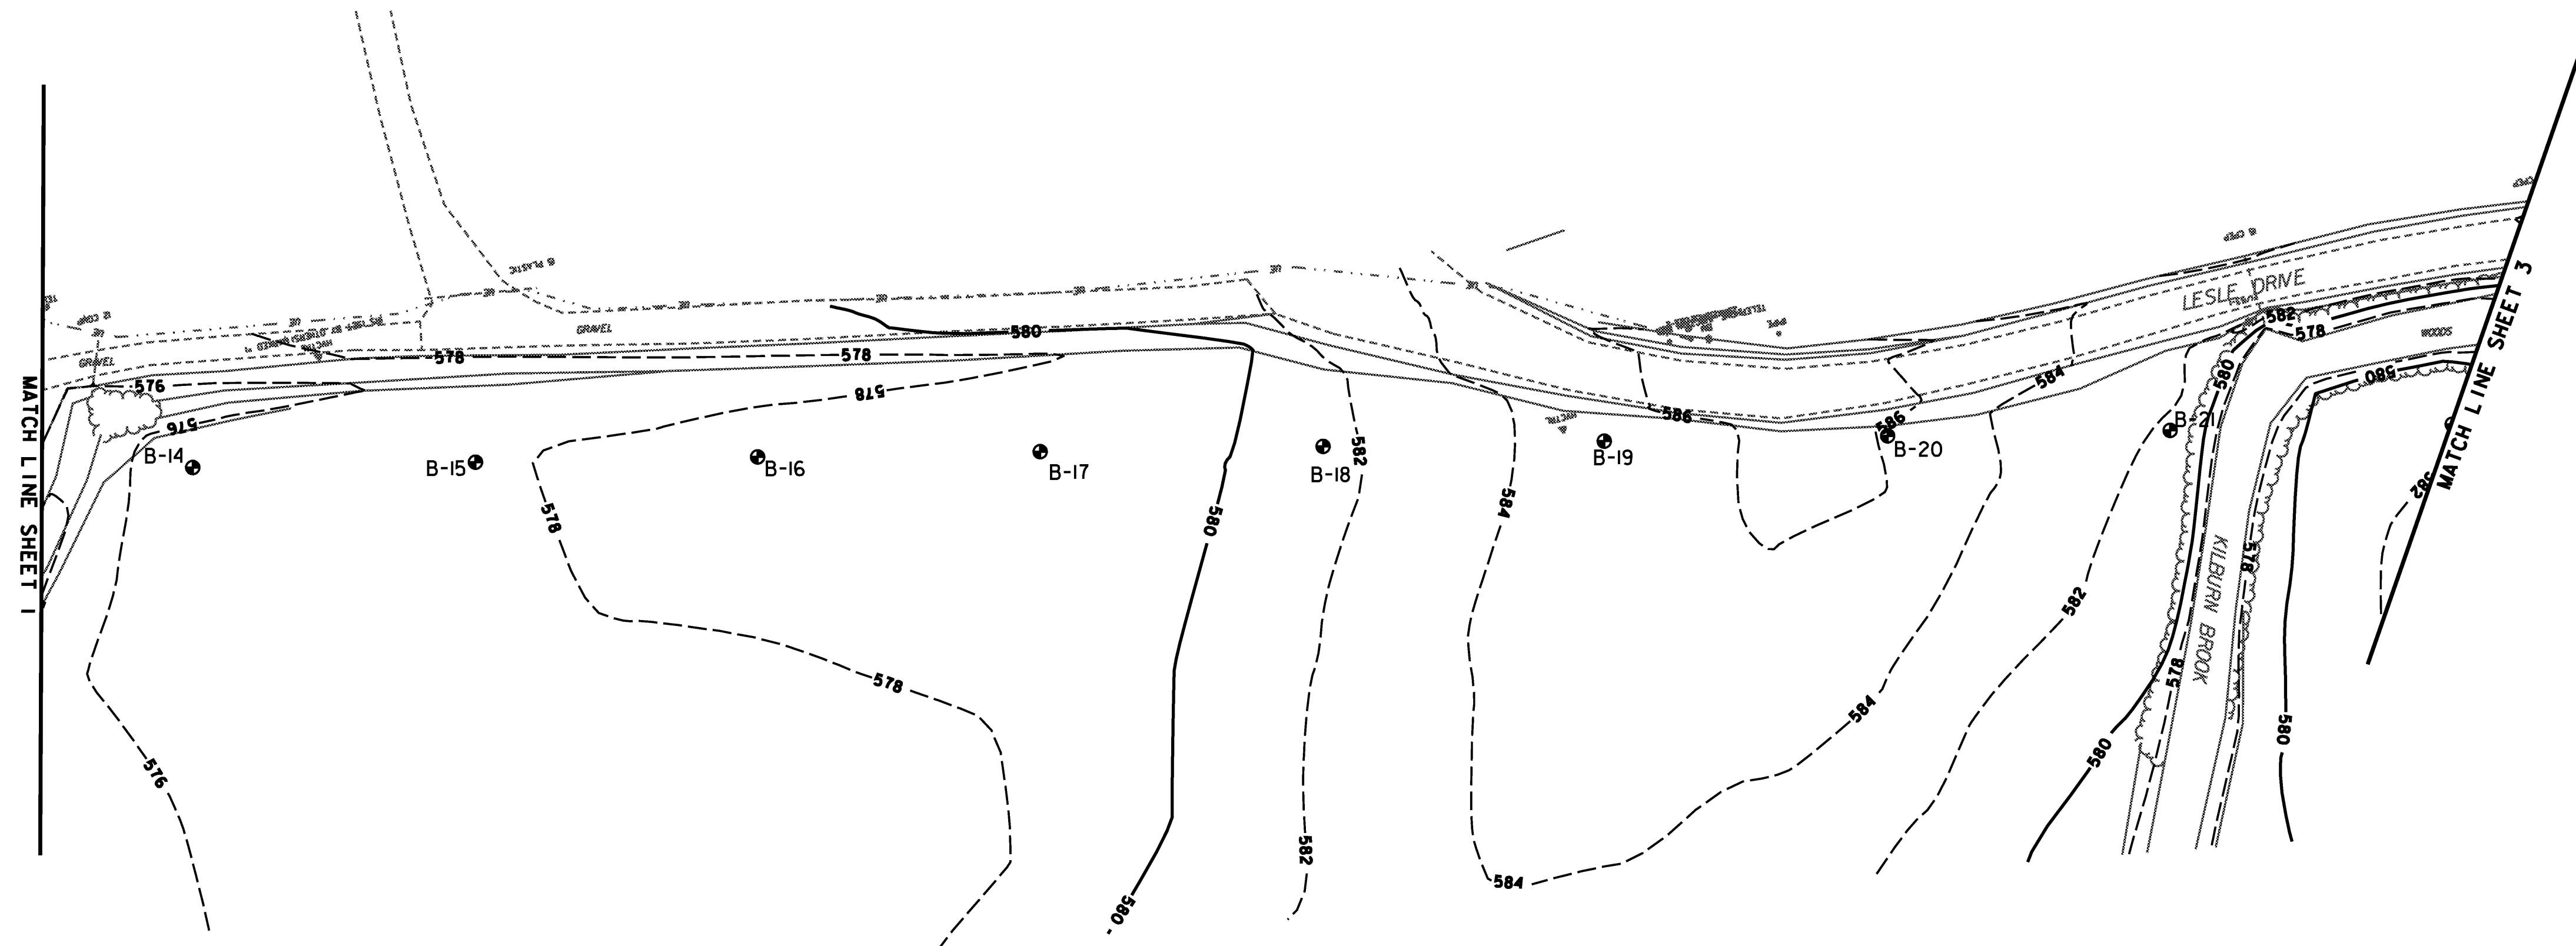
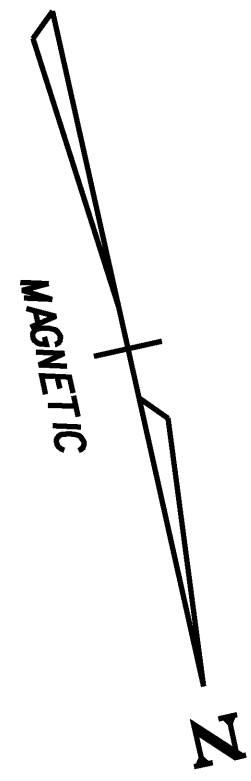


PROJECT NAME: HARTFORD REST AREAS	
PROJECT NUMBER: IM BLDG(10)	
FILE NAME: ...\\u04d026pit-ex1st.dgn	PLOT DATE: 5/19/2008
PROJECT LEADER: JTM	DRAWN BY: PZA
DESIGNED BY: JTM	CHECKED BY: JTM
EXISTING CONDITIONS SHEET 2	SHEET 9 OF 70