
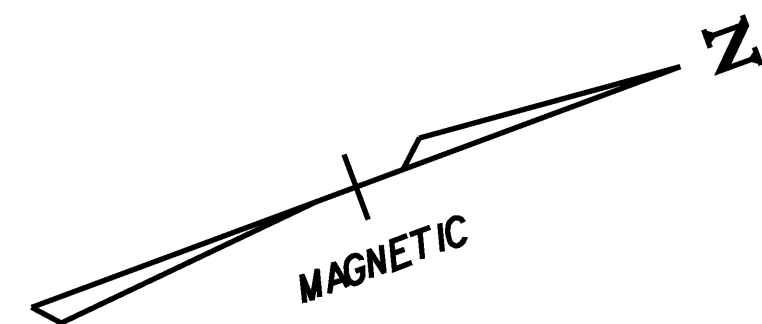


LEGEND	
FILTER FABRIC DROP INLET PROTECTION	
PROJECT DEMARCATION FENCE	
SILT FENCE (LINE STYLE)	
STABILIZED CONSTRUCTION ENTRANCE	
CHECK DAM	
ADAPTED FROM DETAILS PROVIDED BY NEW YORK STATE DEC ORIGINALLY DEVELOPED BY USDA-NRCS VERMONT DEPARTMENT OF ENVIRONMENTAL CONSERVATION	
STANDARD SYMBOLS	

NOTES:
REFER TO THE VERMONT STANDARDS & SPECIFICATIONS FOR EROSION
PREVENTION & SEDIMENT CONTROL - 2004 - FROM THE VT AGENCY OF
NATURAL RESOURCES FOR ADDITIONAL GUIDANCE.

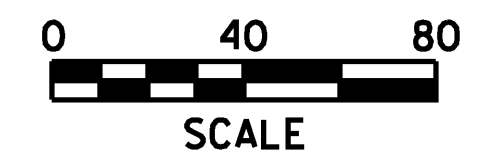

PROJECT NAME: HARTFORD REST AREAS	
PROJECT NUMBER: IM BLDG(10)	
FILE NAME: ...\\plot files\\u04o026pit-ero.dgn	PLOT DATE: 5/19/2008
PROJECT LEADER: JTM	DRAWN BY: PZA
DESIGNED BY:	CHECKED BY: JTM
EROSION CONTROL SHEET 4	SHEET 26 OF 70