



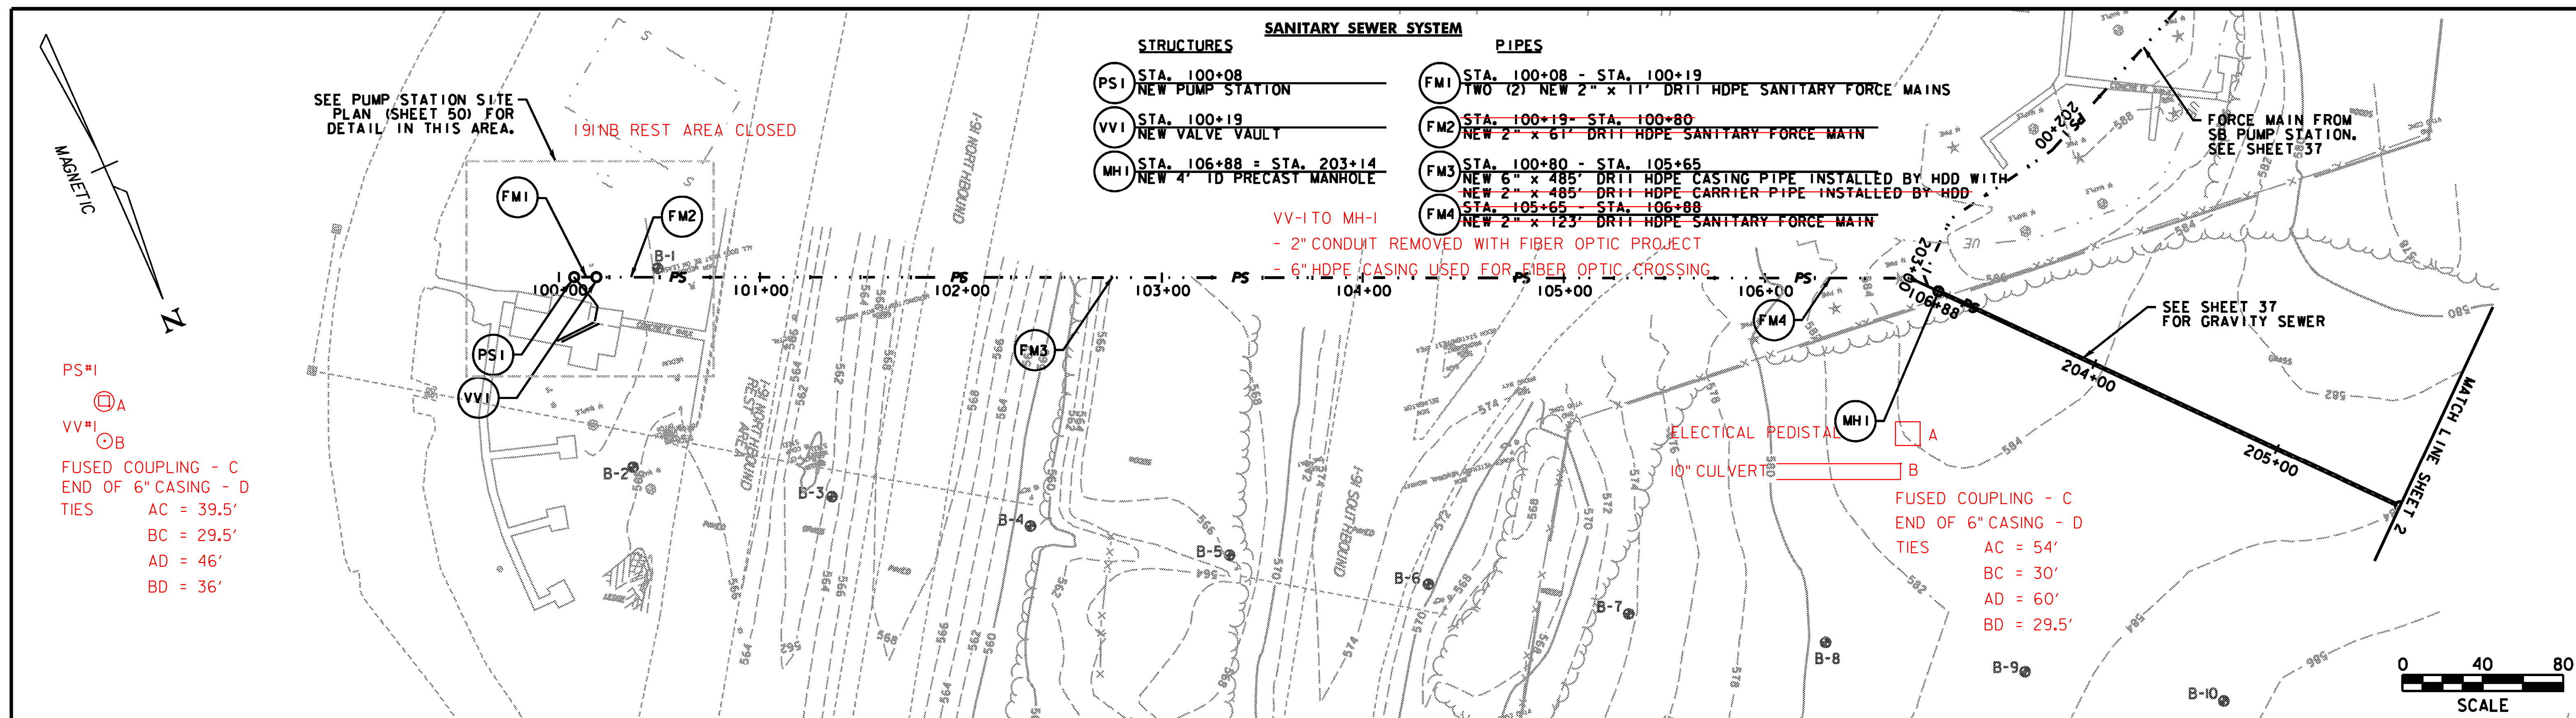

NOTES:
FOR PROFILE FROM MH 1 TO
MH 2 SEE SHEET 37

NOTES:
FOR SOUTHBOUND REST AREA FORCE MAIN
DETAILS SEE PLAN AND PROFILE SHEET 37

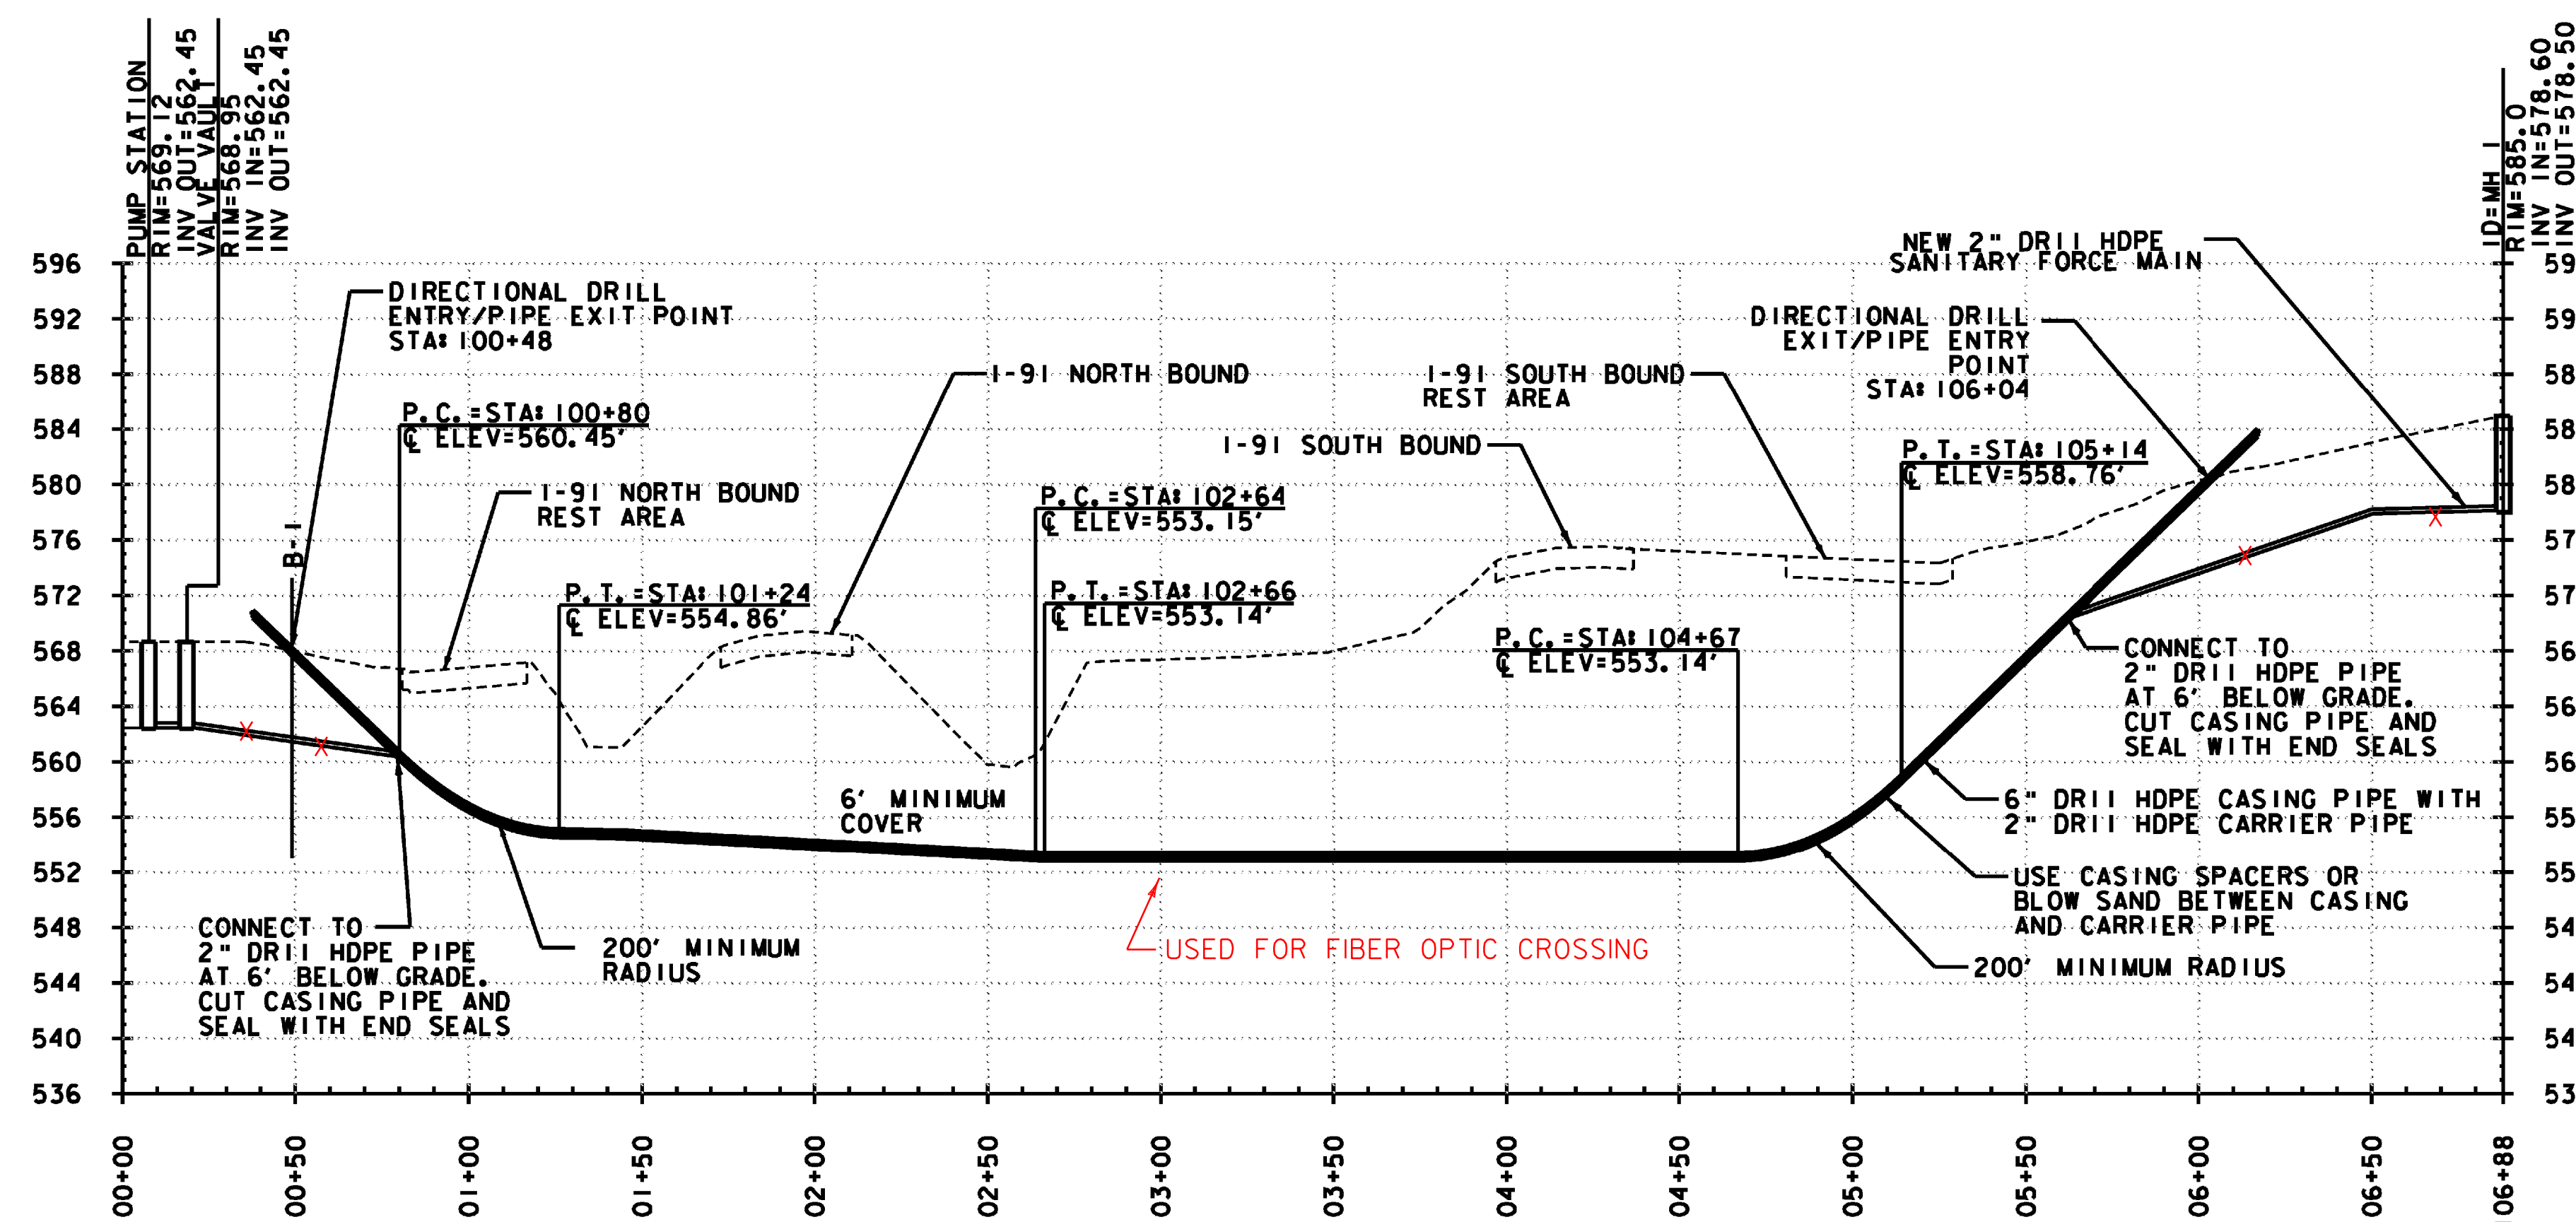

PROJECT NAME: HARTFORD REST AREAS
PROJECT NUMBER: IM BLDG(10)

FILE NAME: \\u04a026plot-utl.dgn PLOT DATE: 5/19/2008
PROJECT LEADER: JTM DRAWN BY: PZA
DESIGNED BY: MEHP CHECKED BY: JTM
PLAN & PROFILE SHEET 1 SHEET 36 OF 70