

SANITARY SEWER SYSTEM

RELOCATE MAILBOX

STA. 341+25, RT.
STA. 345+03, RT.

STRUCTURES

PIPES


C06 STA. 339+00 - 338+99-3.0' RT
NEW 5" ID PRECAST CLEANOUT

C07 STA. 345+00 - 344+90-3.8' RT
NEW 5" ID PRECAST CLEANOUT




FM15 STA. 333+72 - STA. 339+00 338+99
NEW 4" x 528' CL 52 D.I. SANITARY FORCE MAIN

FM16 STA. 339+00 - STA. 345+00 344+90
NEW 4" x 600' CL 52 D.I. SANITARY FORCE MAIN

FM17 STA. 345+00 - STA. 350+00 349+99
NEW 4" x 500' CL 52 D.I. SANITARY FORCE MAIN

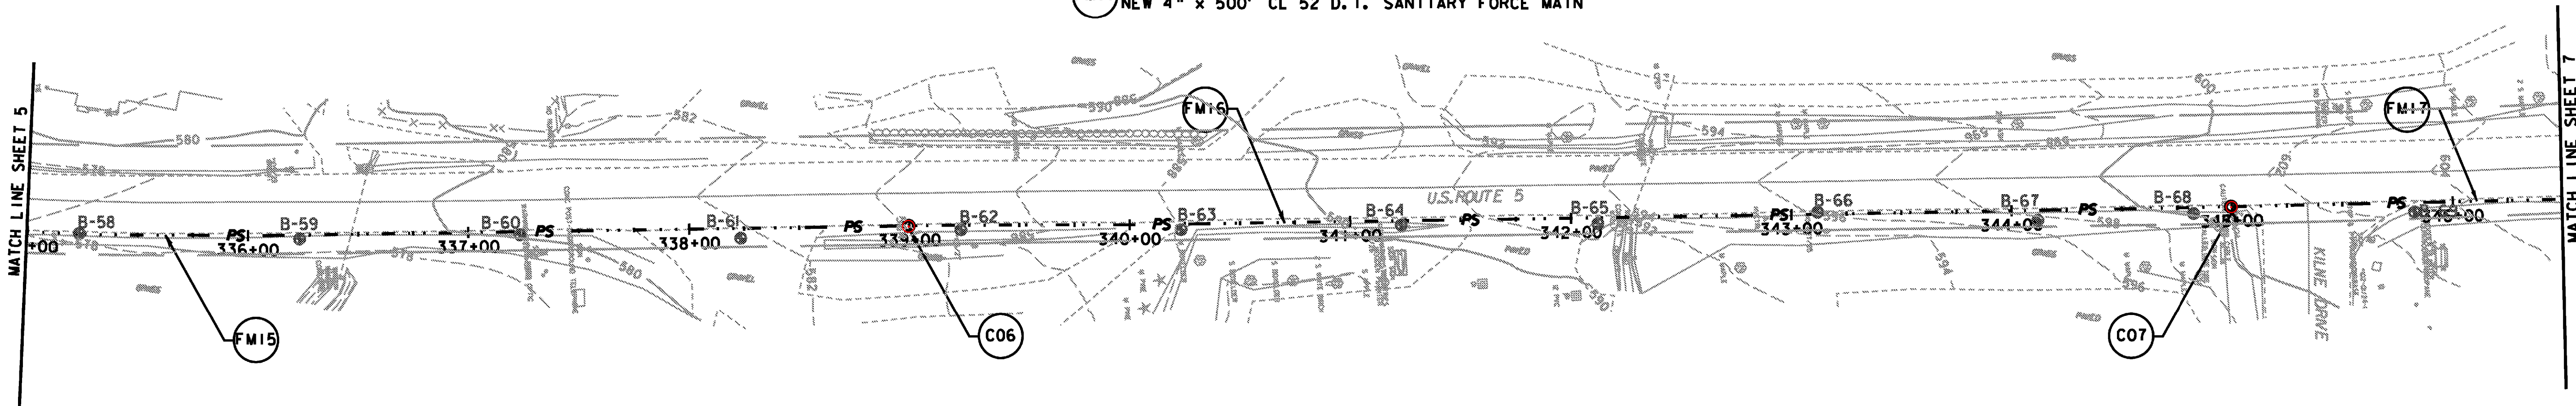

NOTE:
1. MAILBOX RELOCATION PAID FOR AS
ITEM 617.10 - RELOCATE MAILBOX,
SINGLE SUPPORT

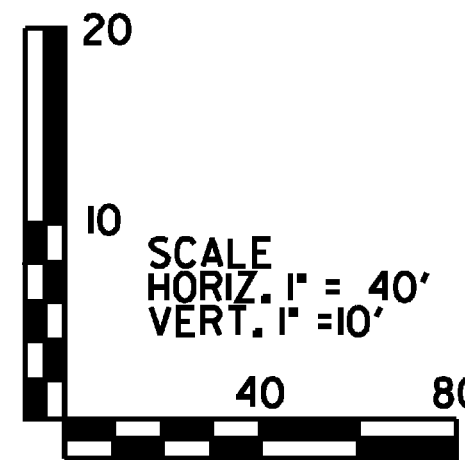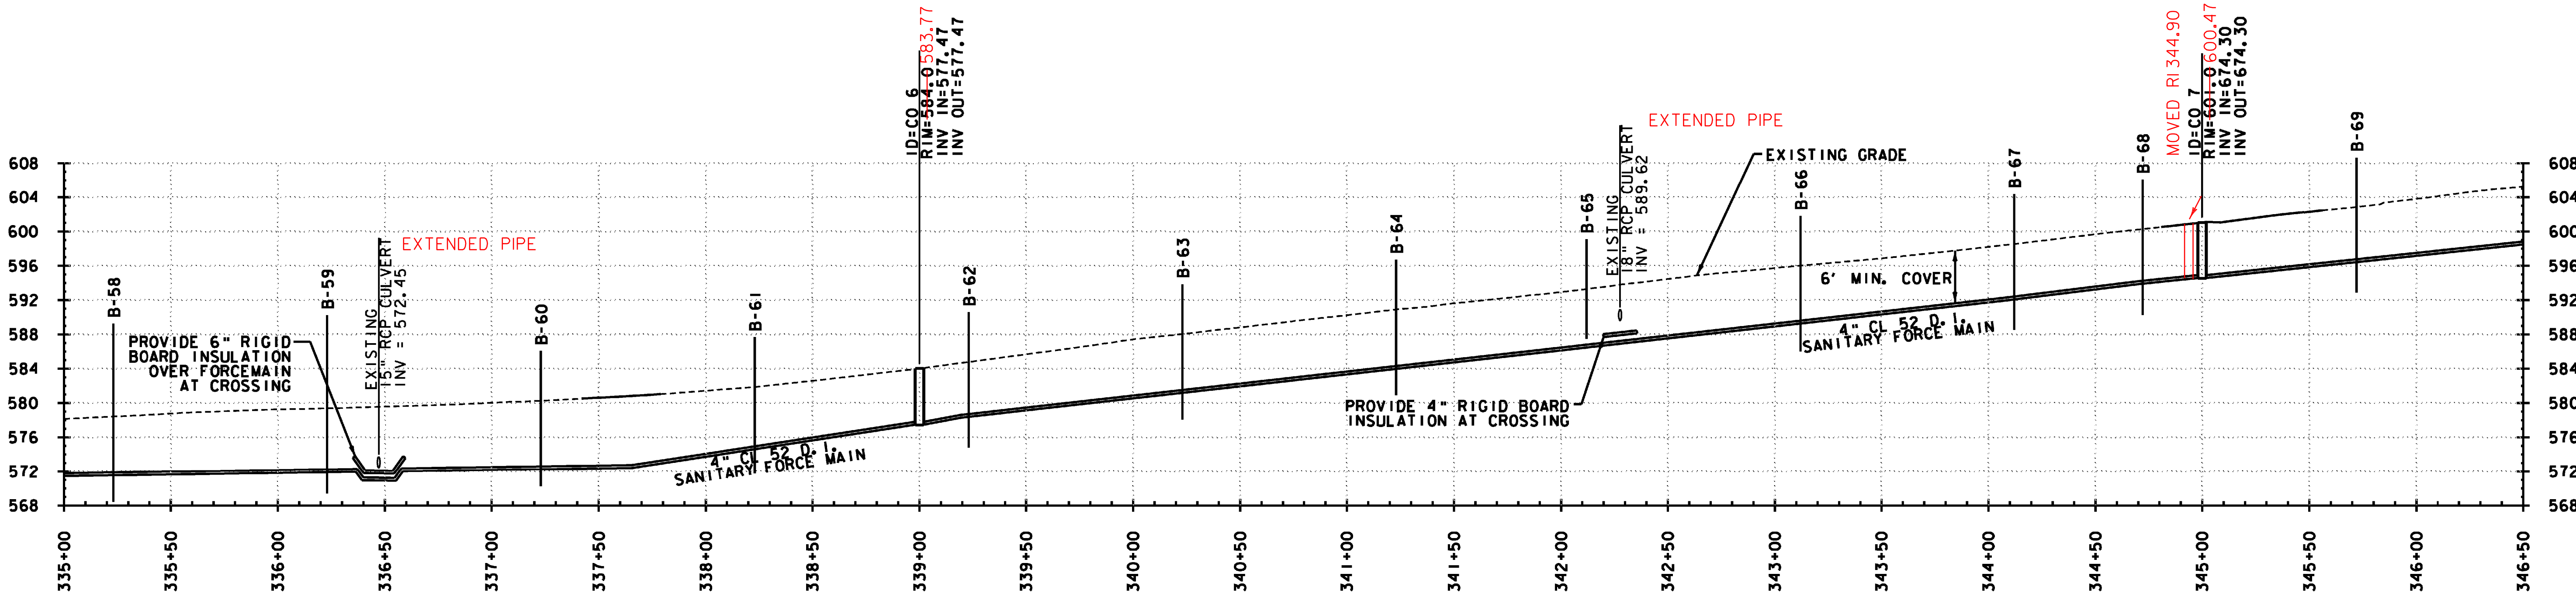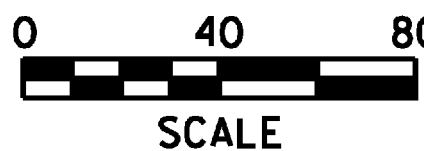

PROJECT NAME:	HARTFORD REST AREAS
PROJECT NUMBER:	IM BLDG(10)
FILE NAME:	...plot files\04a026p1t-utLdgnPLOT DATE: 5/19/2008
PROJECT LEADER:	JTM
DESIGNED BY:	MEHP
PLAN & PROFILE SHEET 6	
DRAWN BY:	PZA
CHECKED BY:	JTM
SHEET 42	OF 70