

RELOCATE MAILBOX
STA. 348+26, RT.
STA. 351+94, RT.


SANITARY SEWER SYSTEM

STRUCTURES




C08 STA. 350+00 - 349.99
NEW 5' ID PRECAST CLEANOUT
MH7 STA. 353+56 = STA. 400+00
NEW 4' ID PRECAST MANHOLE

PIPES

FM17 STA. 345+00 - STA. 350+00 349.99
NEW 4" x 500' CL 52 D.I. SANITARY FORCE MAIN
FM18 STA. 350+00 - STA. 353+56 46
NEW 4" x 356' CL 52 D.I. SANITARY FORCE MAIN

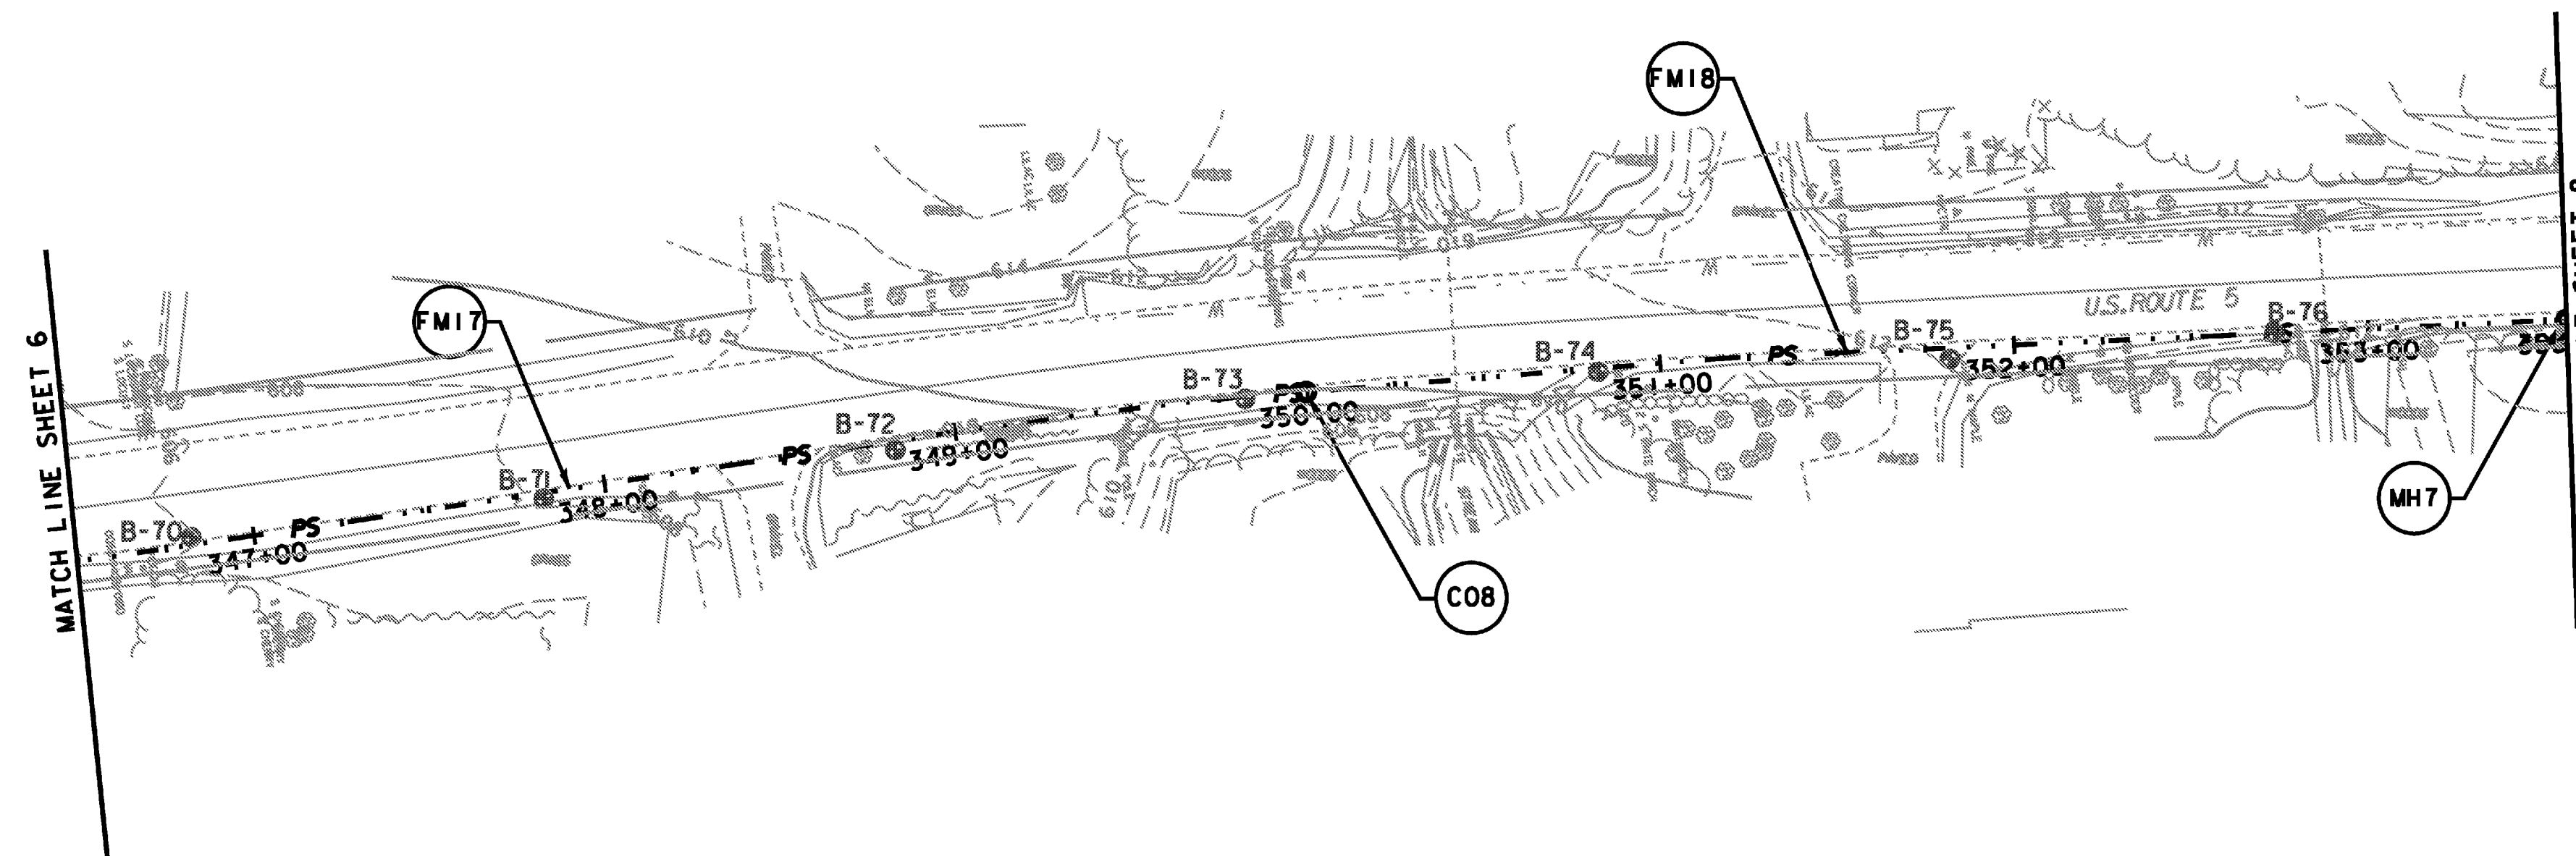

NOTE:
1. MAILBOX RELOCATION PAID FOR AS
ITEM 617.10 - RELOCATE MAILBOX,
SINGLE SUPPORT

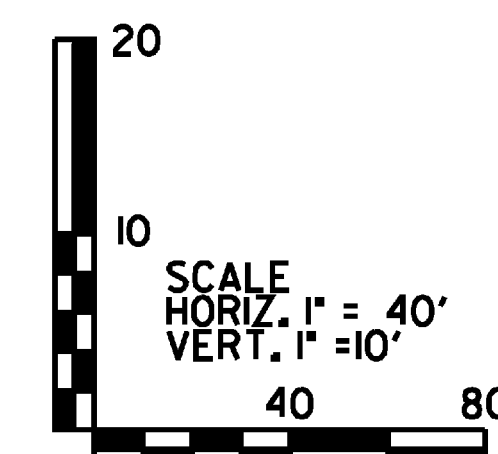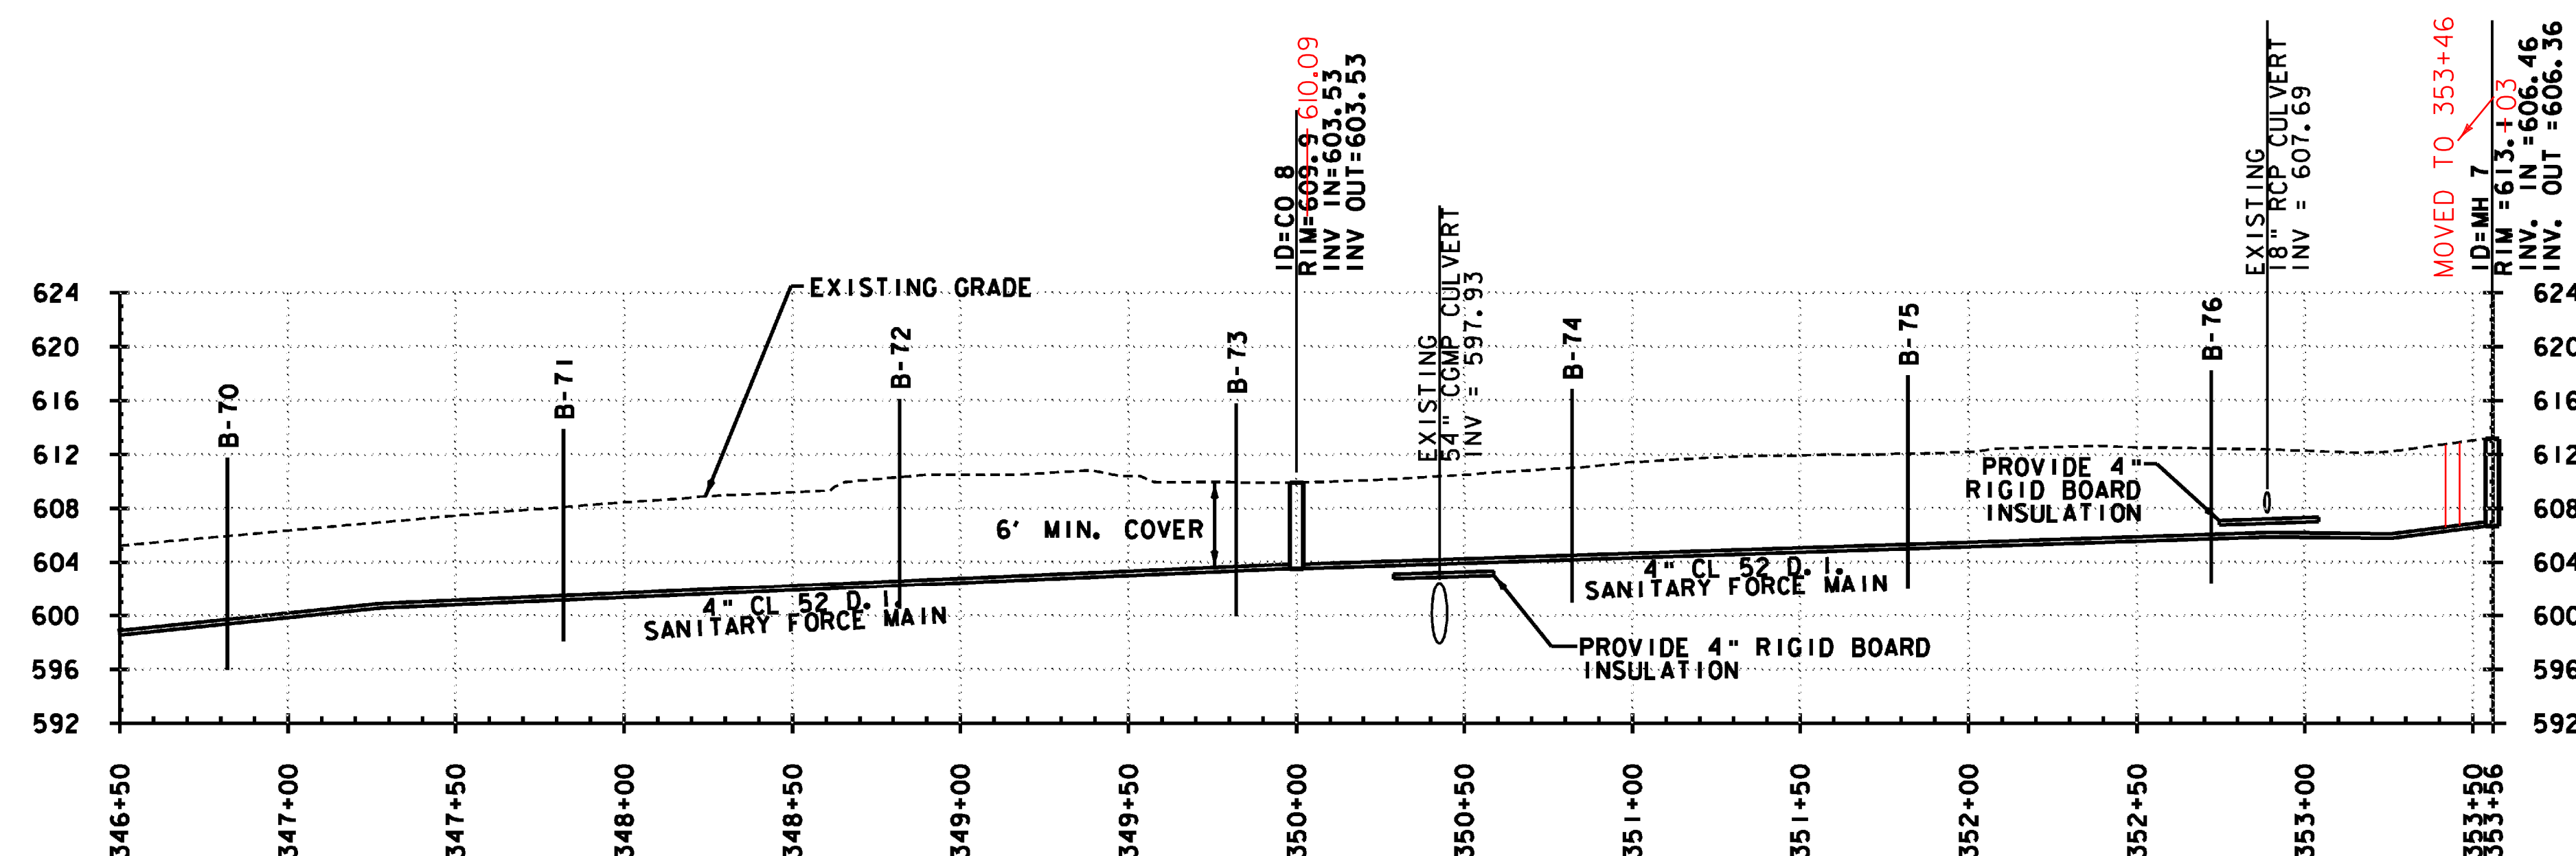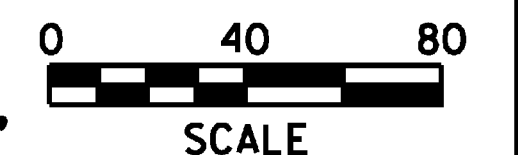

PROJECT NAME: HARTFORD REST AREAS
PROJECT NUMBER: IM BLDG(10)

FILE NAME: ...\\plot files\\u04a026p1t-ut1.dgn PLOT DATE: 5/19/2008
PROJECT LEADER: JTM DRAWN BY: PZA
DESIGNED BY: MEHP CHECKED BY: JTM
PLAN & PROFILE SHEET 7 SHEET 43 OF 70