




- STRUCTURES**
- (MHH1) STA. 0+00
NEW 4' ID PRECAST MANHOLE
 - (MHH2) STA. 0+71.76
NEW 4' ID PRECAST MANHOLE
 - (MHH3) STA. 2+30.21
NEW 4' ID PRECAST MANHOLE
 - (MH8) STA. 3+29.25 = STA. 401+09
NEW 4' ID PRECAST MANHOLE

SANITARY SEWER SYSTEM


- PIPES**
- (PH1) STA. 0+00 - STA. 0+71.76
NEW 8" x 71' SDR 35 PVC SANITARY SEWER WITH
NEW 16" x 65' STEEL SLEEVE
 - (PH2) STA. 0+71.76 - STA. 2+30.21
NEW 8" x 159' SDR 35 PVC SANITARY SEWER
 - (PH3) STA. 2+30.21 - STA. 3+29.25
NEW 8" x 99' SDR 35 PVC SANITARY SEWER

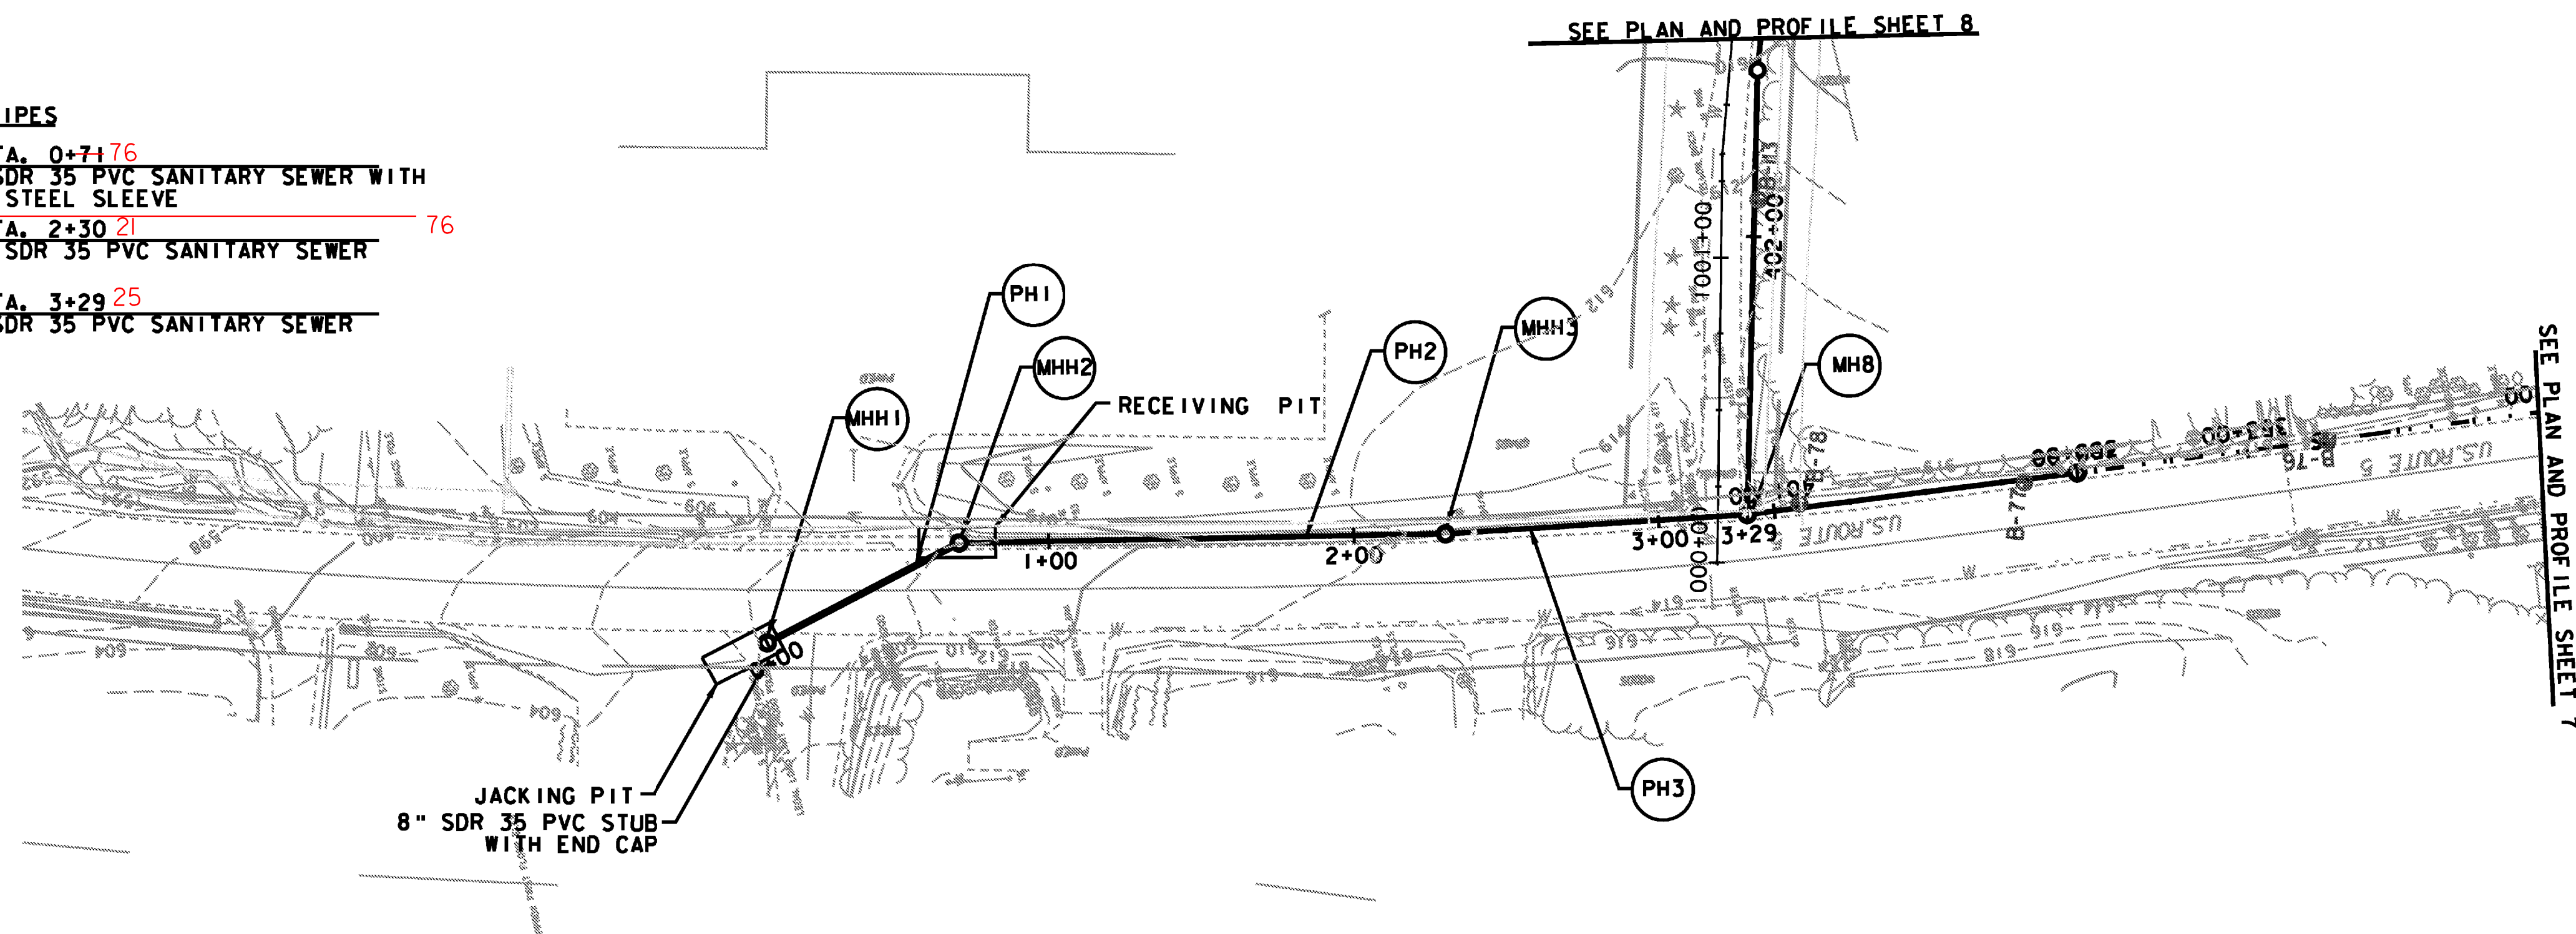

• NON-PARTICIPATORY WORK

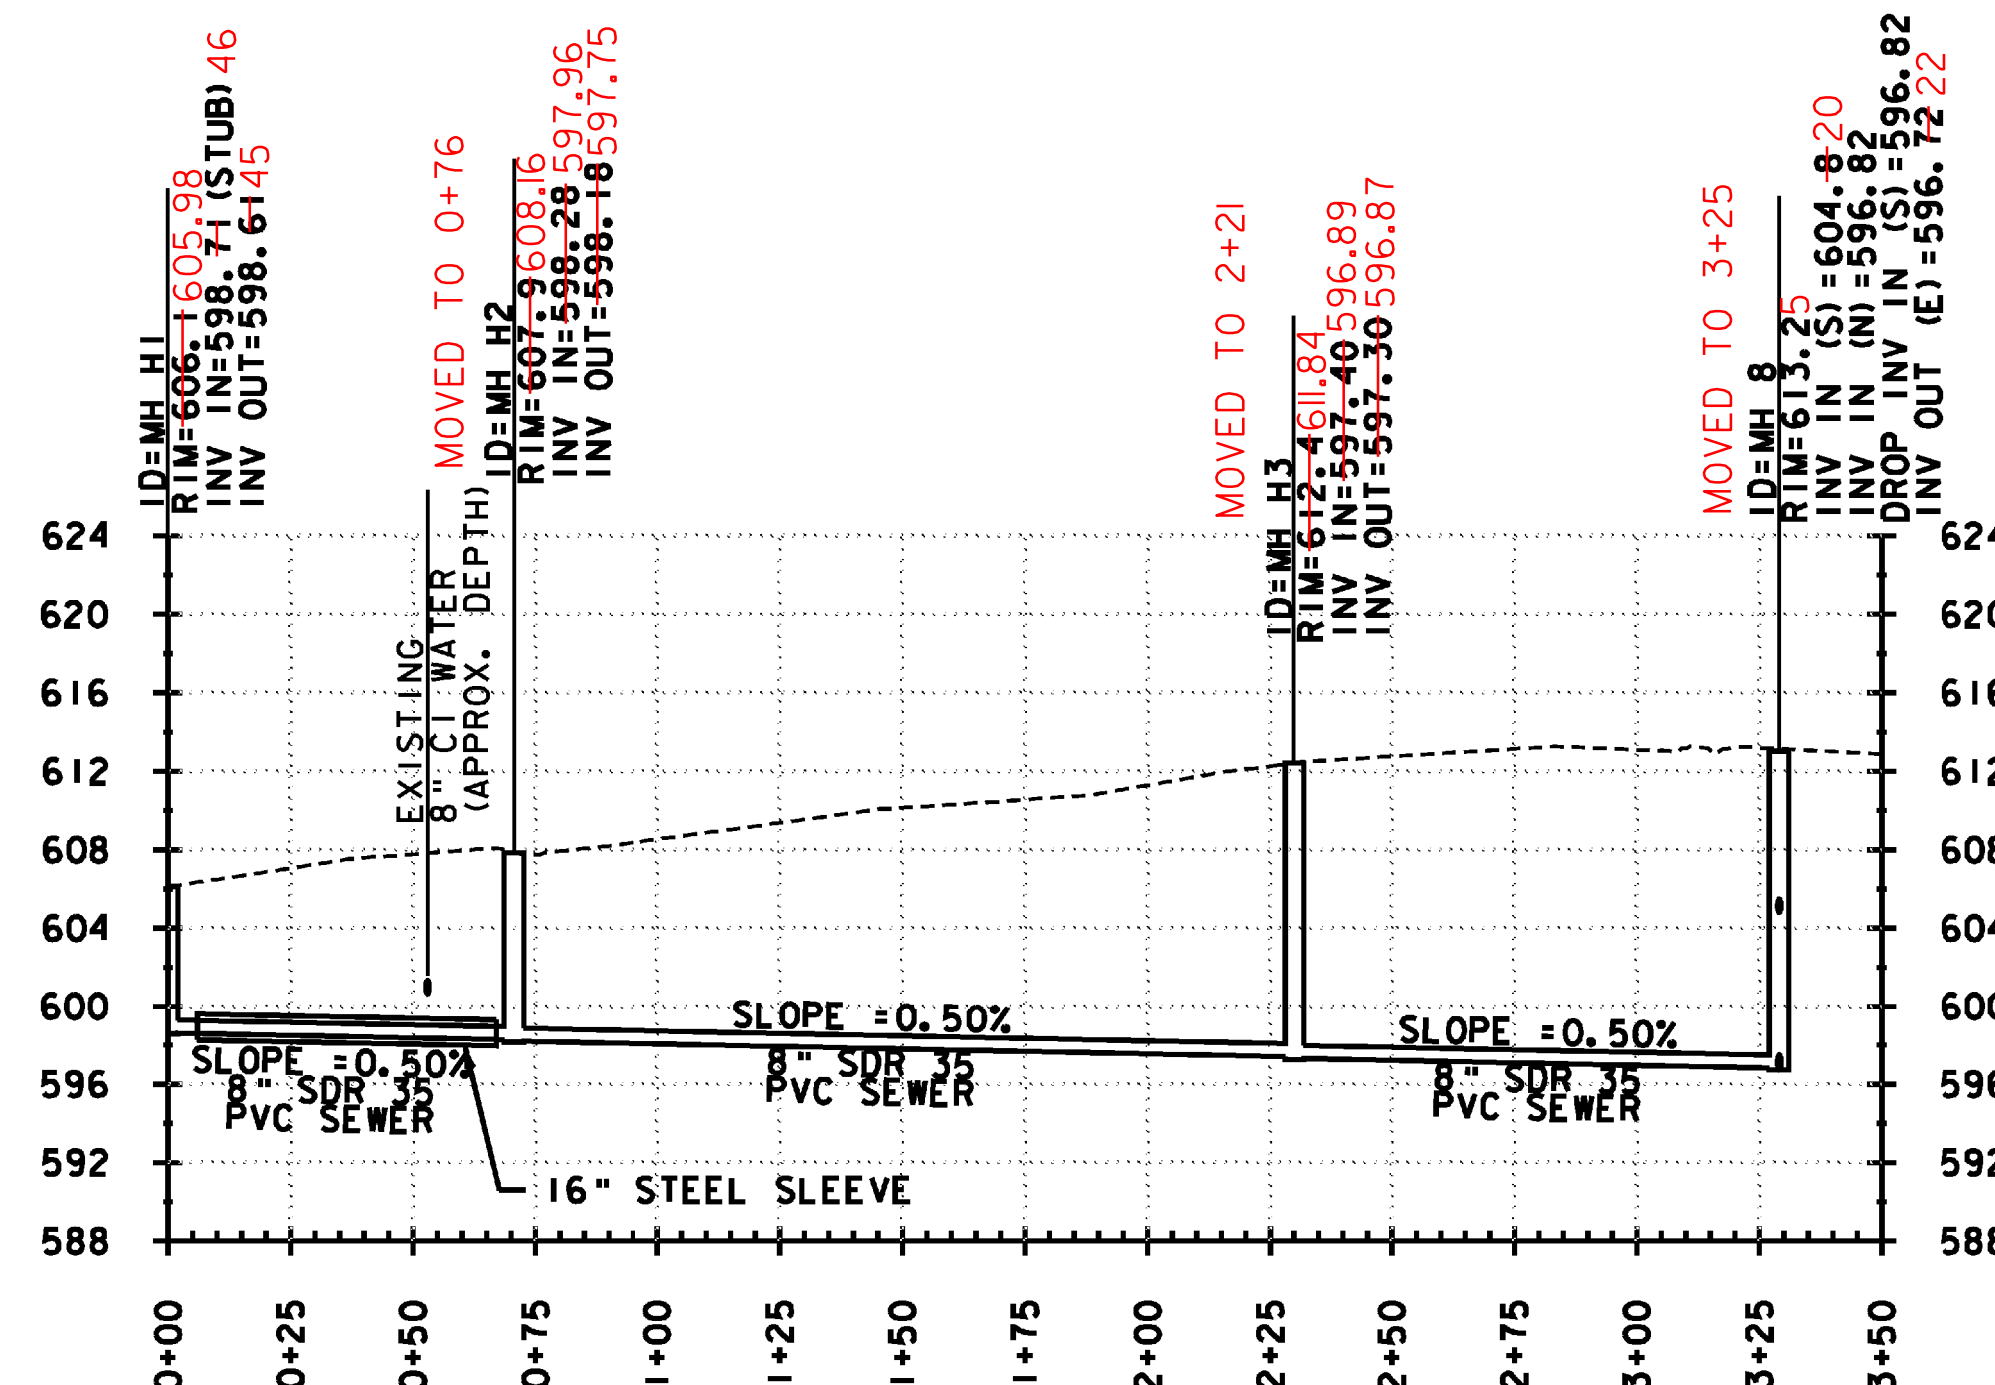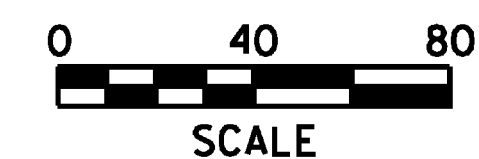

NOTE: PRIOR TO FABRICATION OF MANHOLES MHH1, MHH2, MHH3, MH8, MH9 AND MHH10, CONTRACTOR SHALL TEST PIT ON BOTH SIDES OF ROUTE 5 TO DETERMINE THE DEPTH OF THE EXISTING 8-INCH CI WATER MAIN IN THE VICINITY OF THE JACK AND BORE HIGHWAY CROSSING. IF A CONFLICT IS DISCOVERED, TEST PIT DATA SHALL BE SUBMITTED TO THE ENGINEER SO THE DESIGN CAN BE MODIFIED AS REQUIRED.

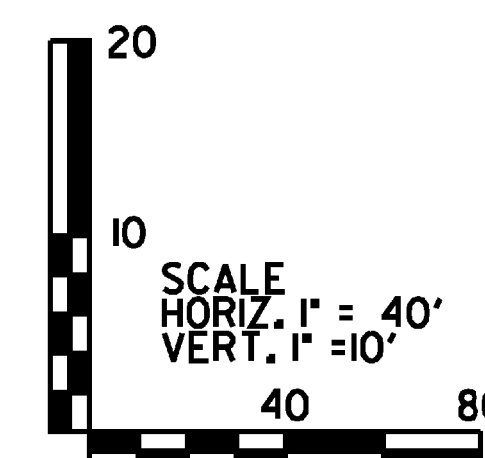

PROJECT NAME: HARTFORD REST AREAS
PROJECT NUMBER: IM BLDG(10)

FILE NAME: ...\\plot_files\\u04a026plt-ut1.dgn PLOT DATE: 5/19/2008
PROJECT LEADER: JTM DRAWN BY: PZA
DESIGNED BY: MEHP CHECKED BY: JTM
PLAN & PROFILE SHEET 7A SHEET 44 OF 70