




SANITARY SEWER SYSTEM

STRUCTURES

- C09 STA. 500+00-11
NEW 6" ID PRECAST CLEANOUT
- C010 STA. 503+20-01
NEW 6" ID PRECAST CLEANOUT
- AR3 STA. 506+50 3.6' RT
NEW 6" ID PRECAST CLEANOUT W/ AIR RELEASE
- MH18 STA. 507+98 - STA. 600+00
NEW 4" ID PRECAST MANHOLE
SEE REDESIGN

PIPES

- FM19 STA. 500+00 - STA. 503+20-01
NEW 6" x 320' CL 52 D.I. SANITARY FORCE MAIN
- FM20 STA. 503+20-01 - STA. 506+50
NEW 6" x 330' CL 52 D.I. SANITARY FORCE MAIN
- FM21 STA. 506+50 - STA. 507+44
NEW 6" x 94' CL 52 D.I. SANITARY FORCE MAIN
- FM22 STA. 507+44 - STA. 507+98
NEW 6" x 54' PRE-INSULATED CL 52 D.I.
SANITARY FORCE MAIN

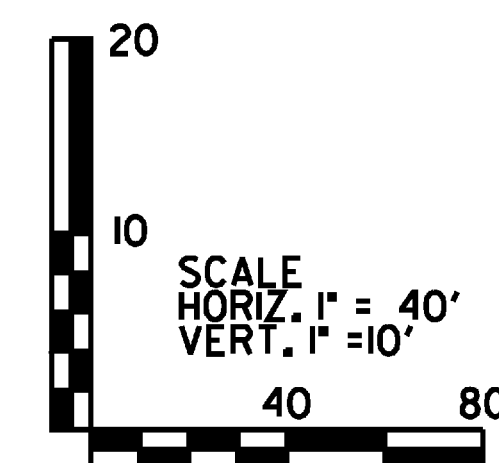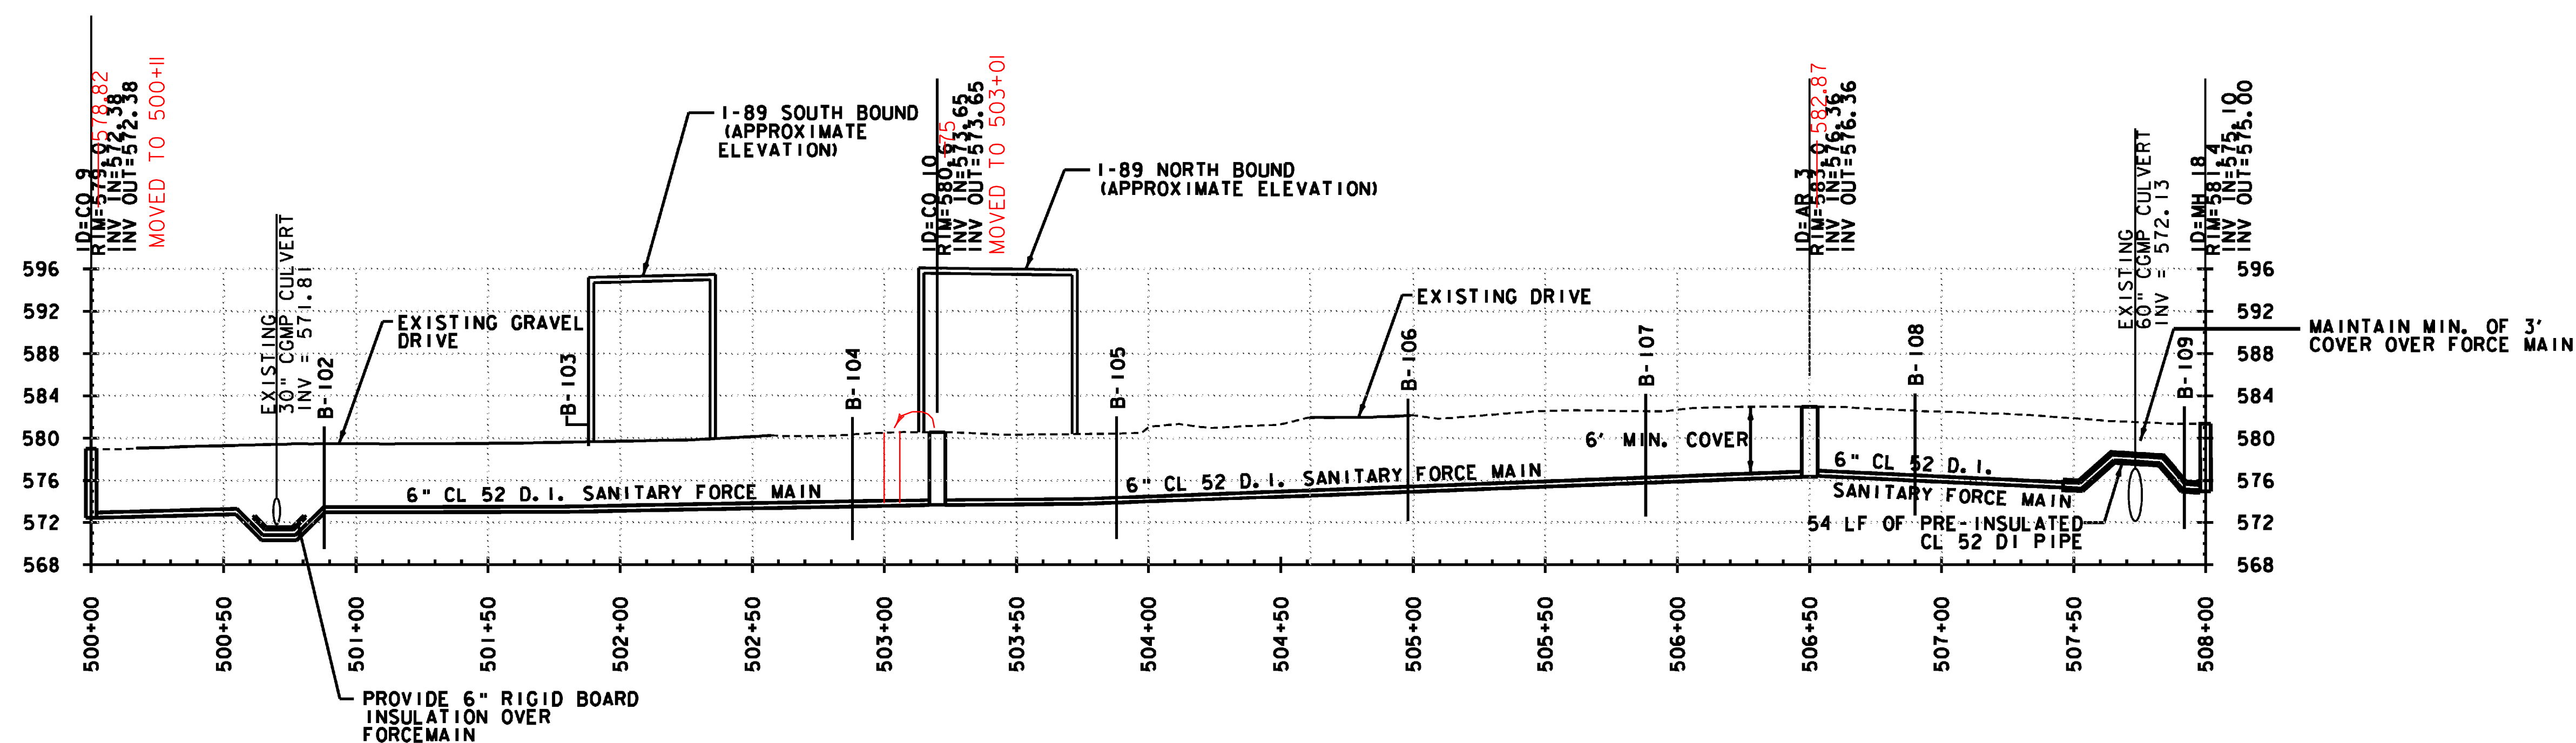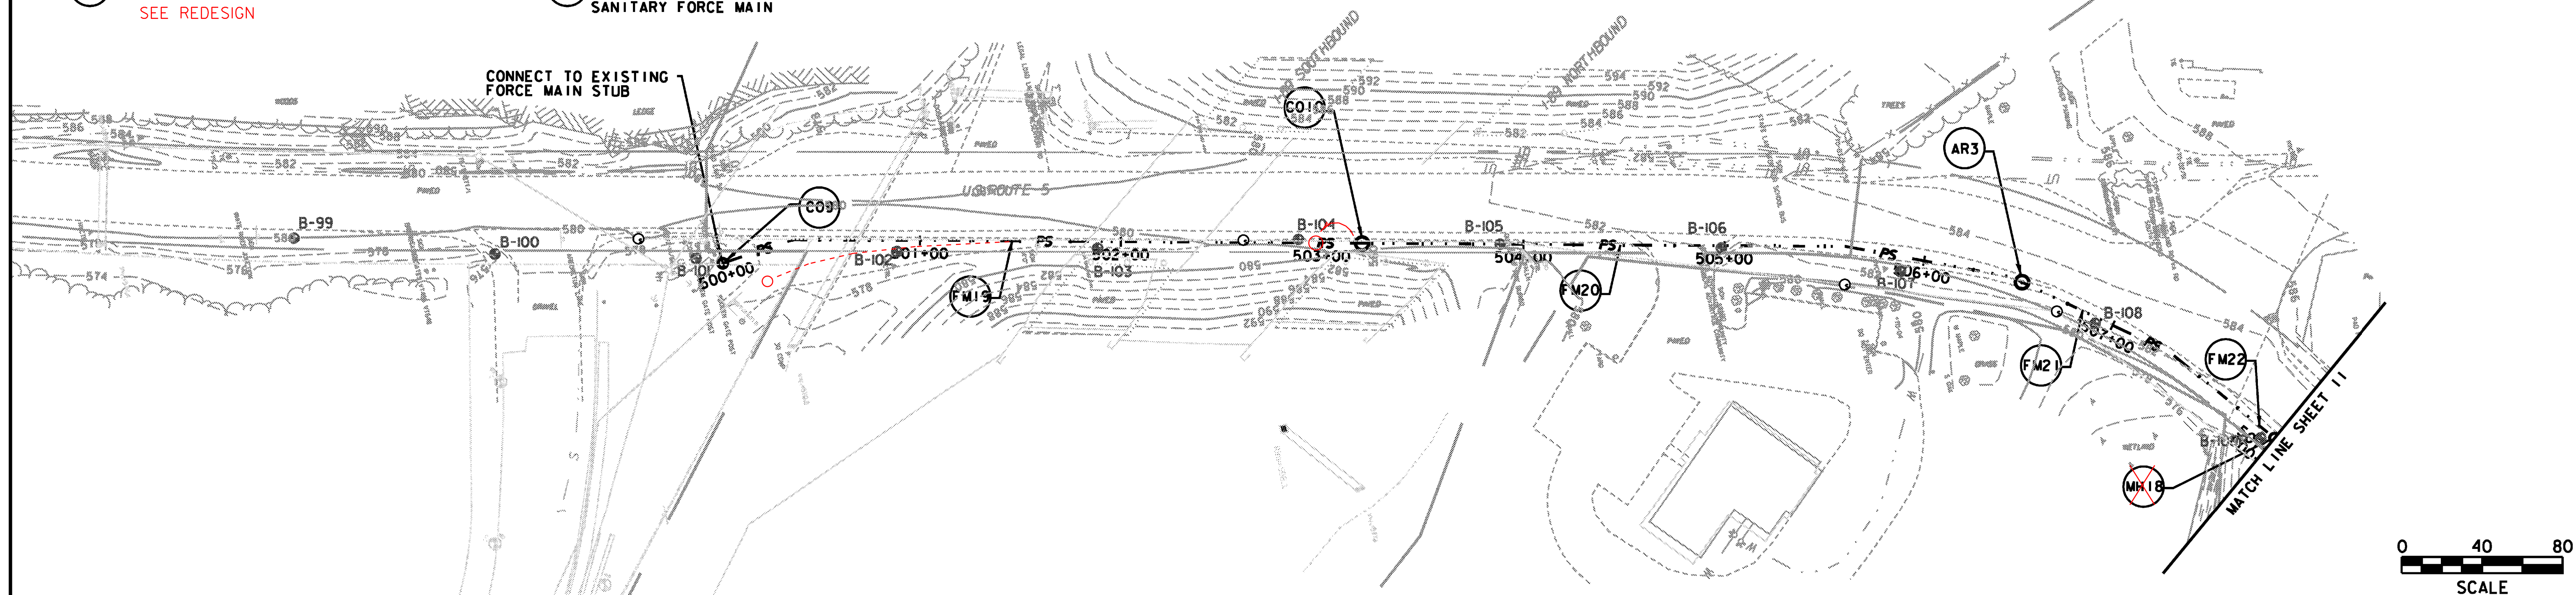

PROJECT NAME: HARTFORD REST AREAS

PROJECT NUMBER: IM BLDG(10)

FILE NAME: ...plot files\04a026p1t-ut1.dgn PLOT DATE: 5/19/2008

PROJECT LEADER: JTM

DRAWN BY: PZA

DESIGNED BY: MEHP

CHECKED BY: JTM

PLAN & PROFILE SHEET 10

SHEET 48 OF 70