

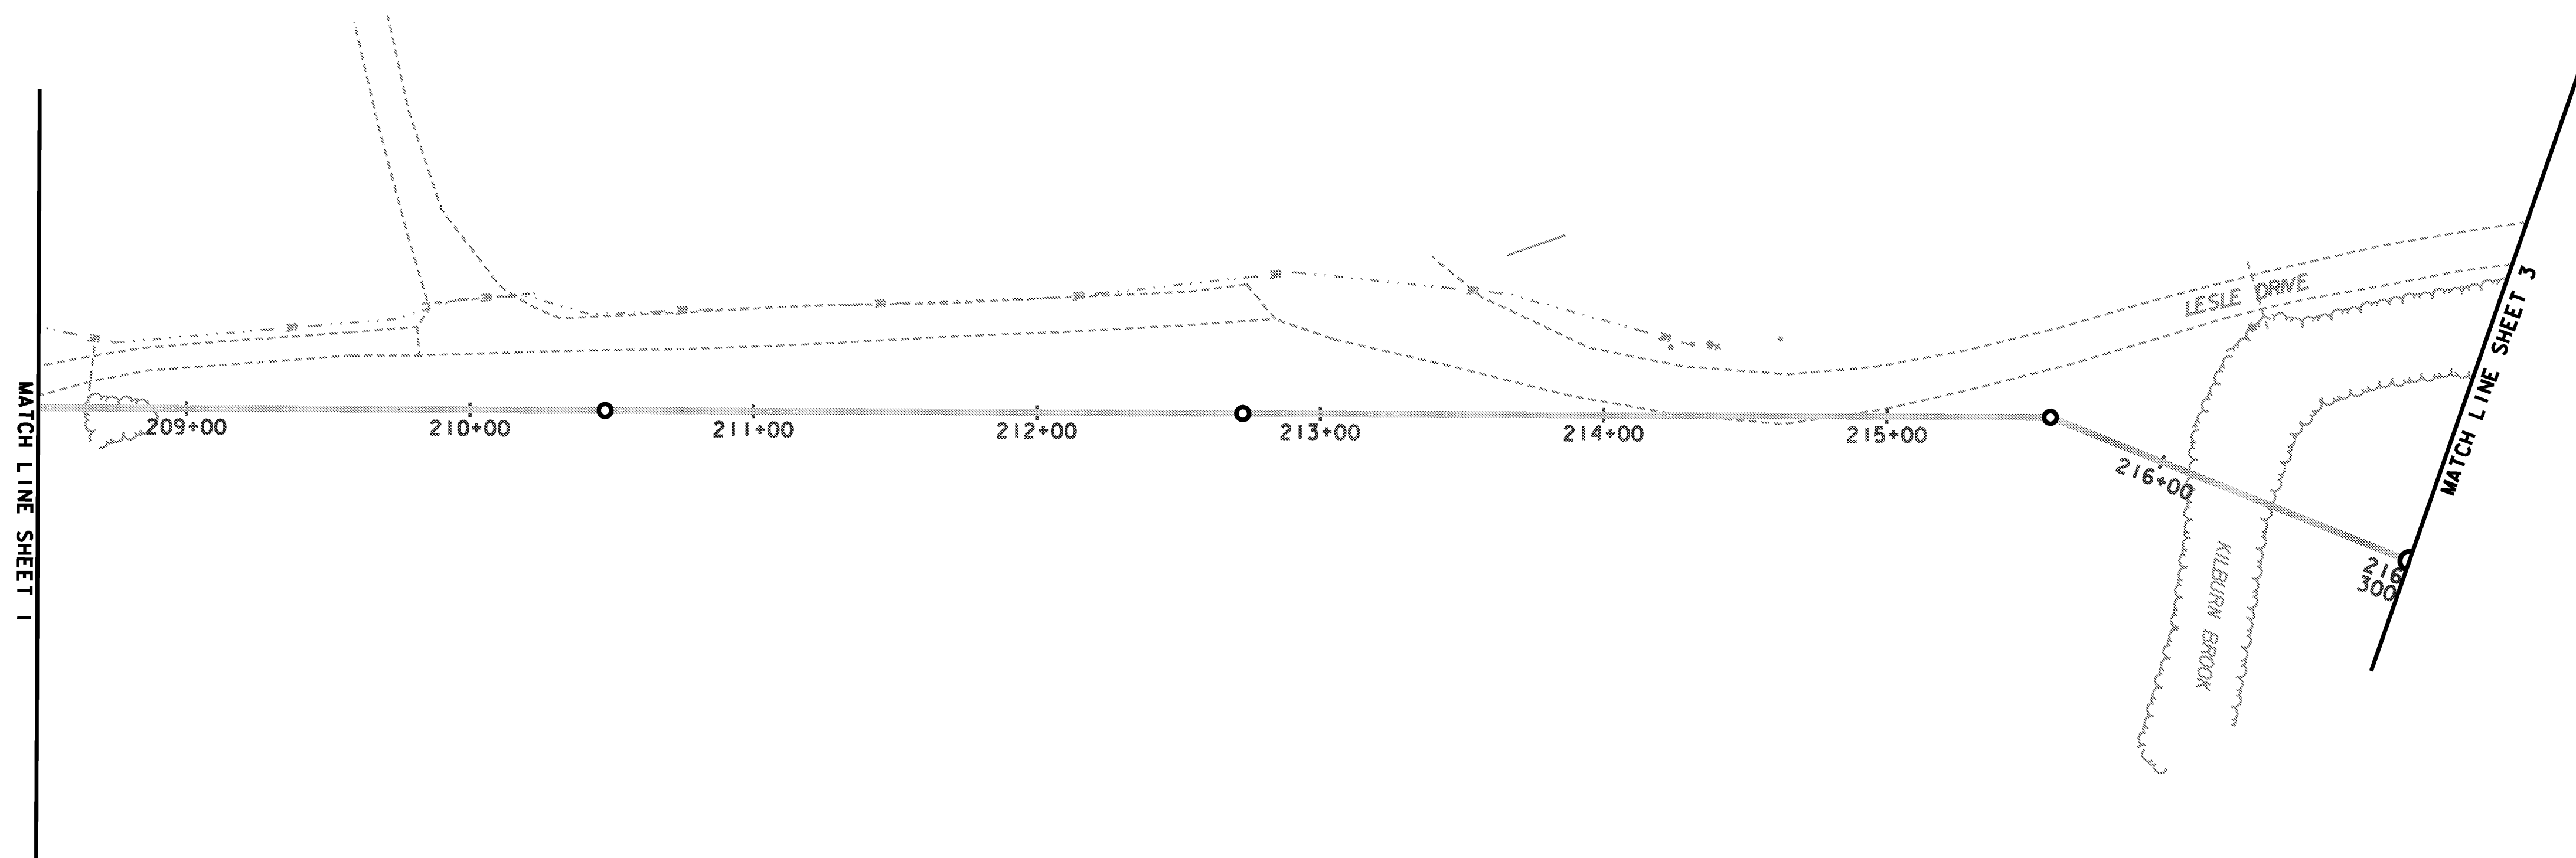


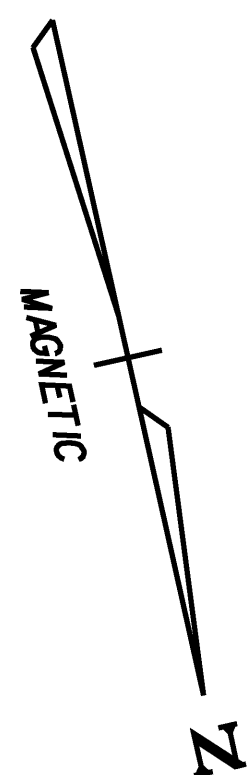

SIGN & DELINEATOR LEGEND

- | | |
|-------|--------------------|
| N | = NEW |
| R | = REMOVE |
| R&S | = REMOVE & SALVAGE |
| S | = SALVAGE SIGN |
| RET | = RETAIN |
| (B-B) | = BACK TO BACK |

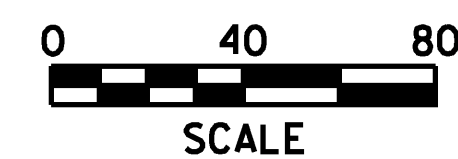

PROJECT NAME: HARTFORD REST AREAS
PROJECT NUMBER: IM BLDG(10)

FILE NAME: ...\\Plot Files\\u04a026plt-sgn.dgn	DATE: 5/19/2008
PROJECT LEADER: JTM	DRAWN BY: PZA
DESIGNED BY:	CHECKED BY: JTM
TRAFFIC SIGNING SHEET 2	SHEET 60 OF 70