
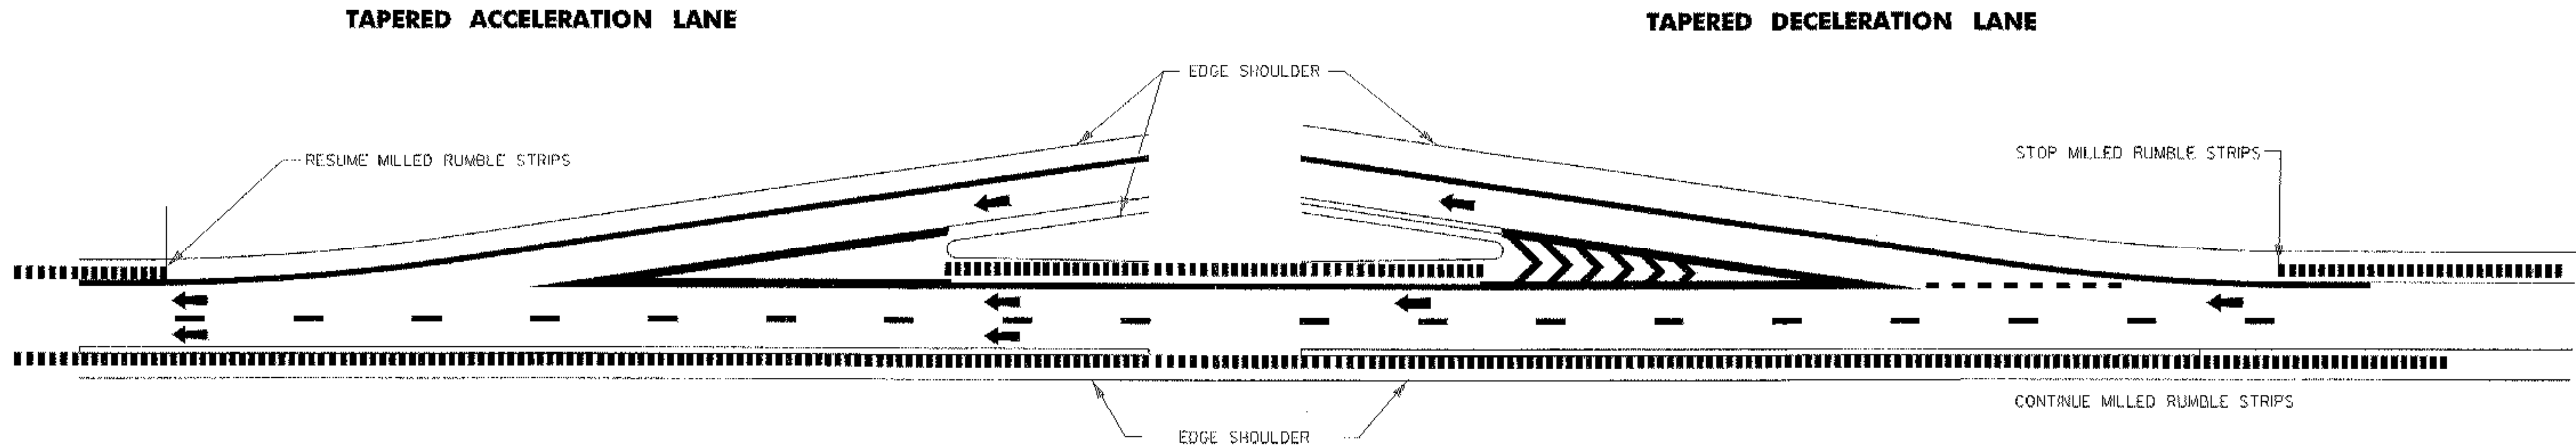


TYPICAL MILLED RUMBLE STRIPS AT INTERCHANGES & REST AREAS

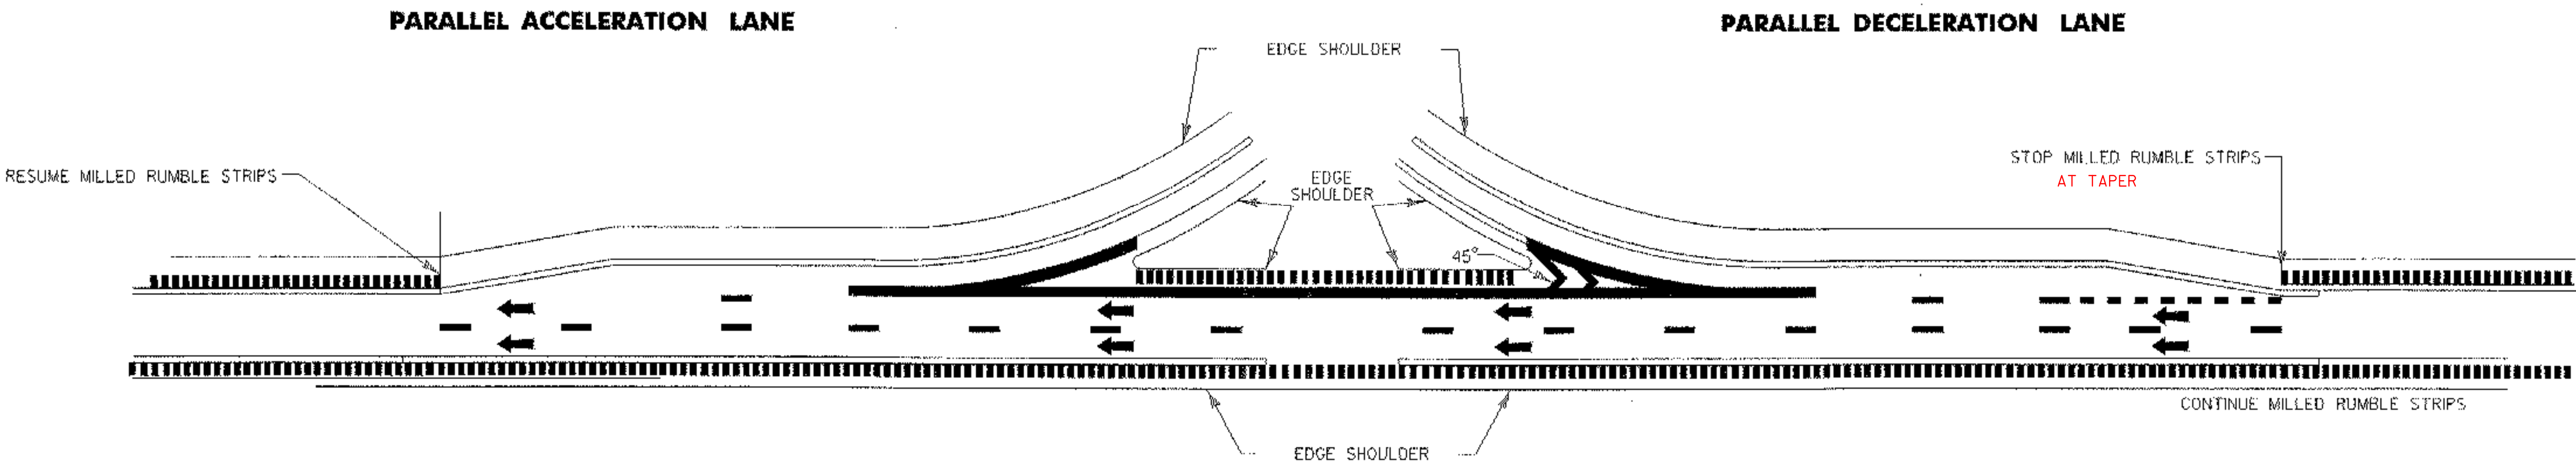

LEGEND

← DIRECTION OF TRAFFIC FLOW

===== MILLED RUMBLE STRIPS

NOT TO SCALE

NOTES:

1) THIS TYPICAL MAYBE MODIFIED AT THE RESIDENT ENGINEER DISCRETION IF THE ACTUAL FIELD CONDITIONS NECESSITATE SUCH ACTIONS.

MILLED RUMBLE STRIPS DETAIL #2

PROJECT NAME: BOLTON -- SO. BURLINGTON
PROJECT NUMBER: AC IM 089-2(36)

FILE NAME: /pave/04all4/p04all4.dgn
PROJECT LEADER:
DESIGNED BY:
IPARM FILE NAME: p04all4mr2.1

PLOT DATE: 17-MAY-2005
DRAWN BY:
CHECKED BY:
SHEET 32 OF 76