



10' - TAPER FINAL LIFT OF PAVEMENT
FROM THIS POINT TO SCUPPER OPENING
(TYPICAL EXCEPT WHERE NOTED)

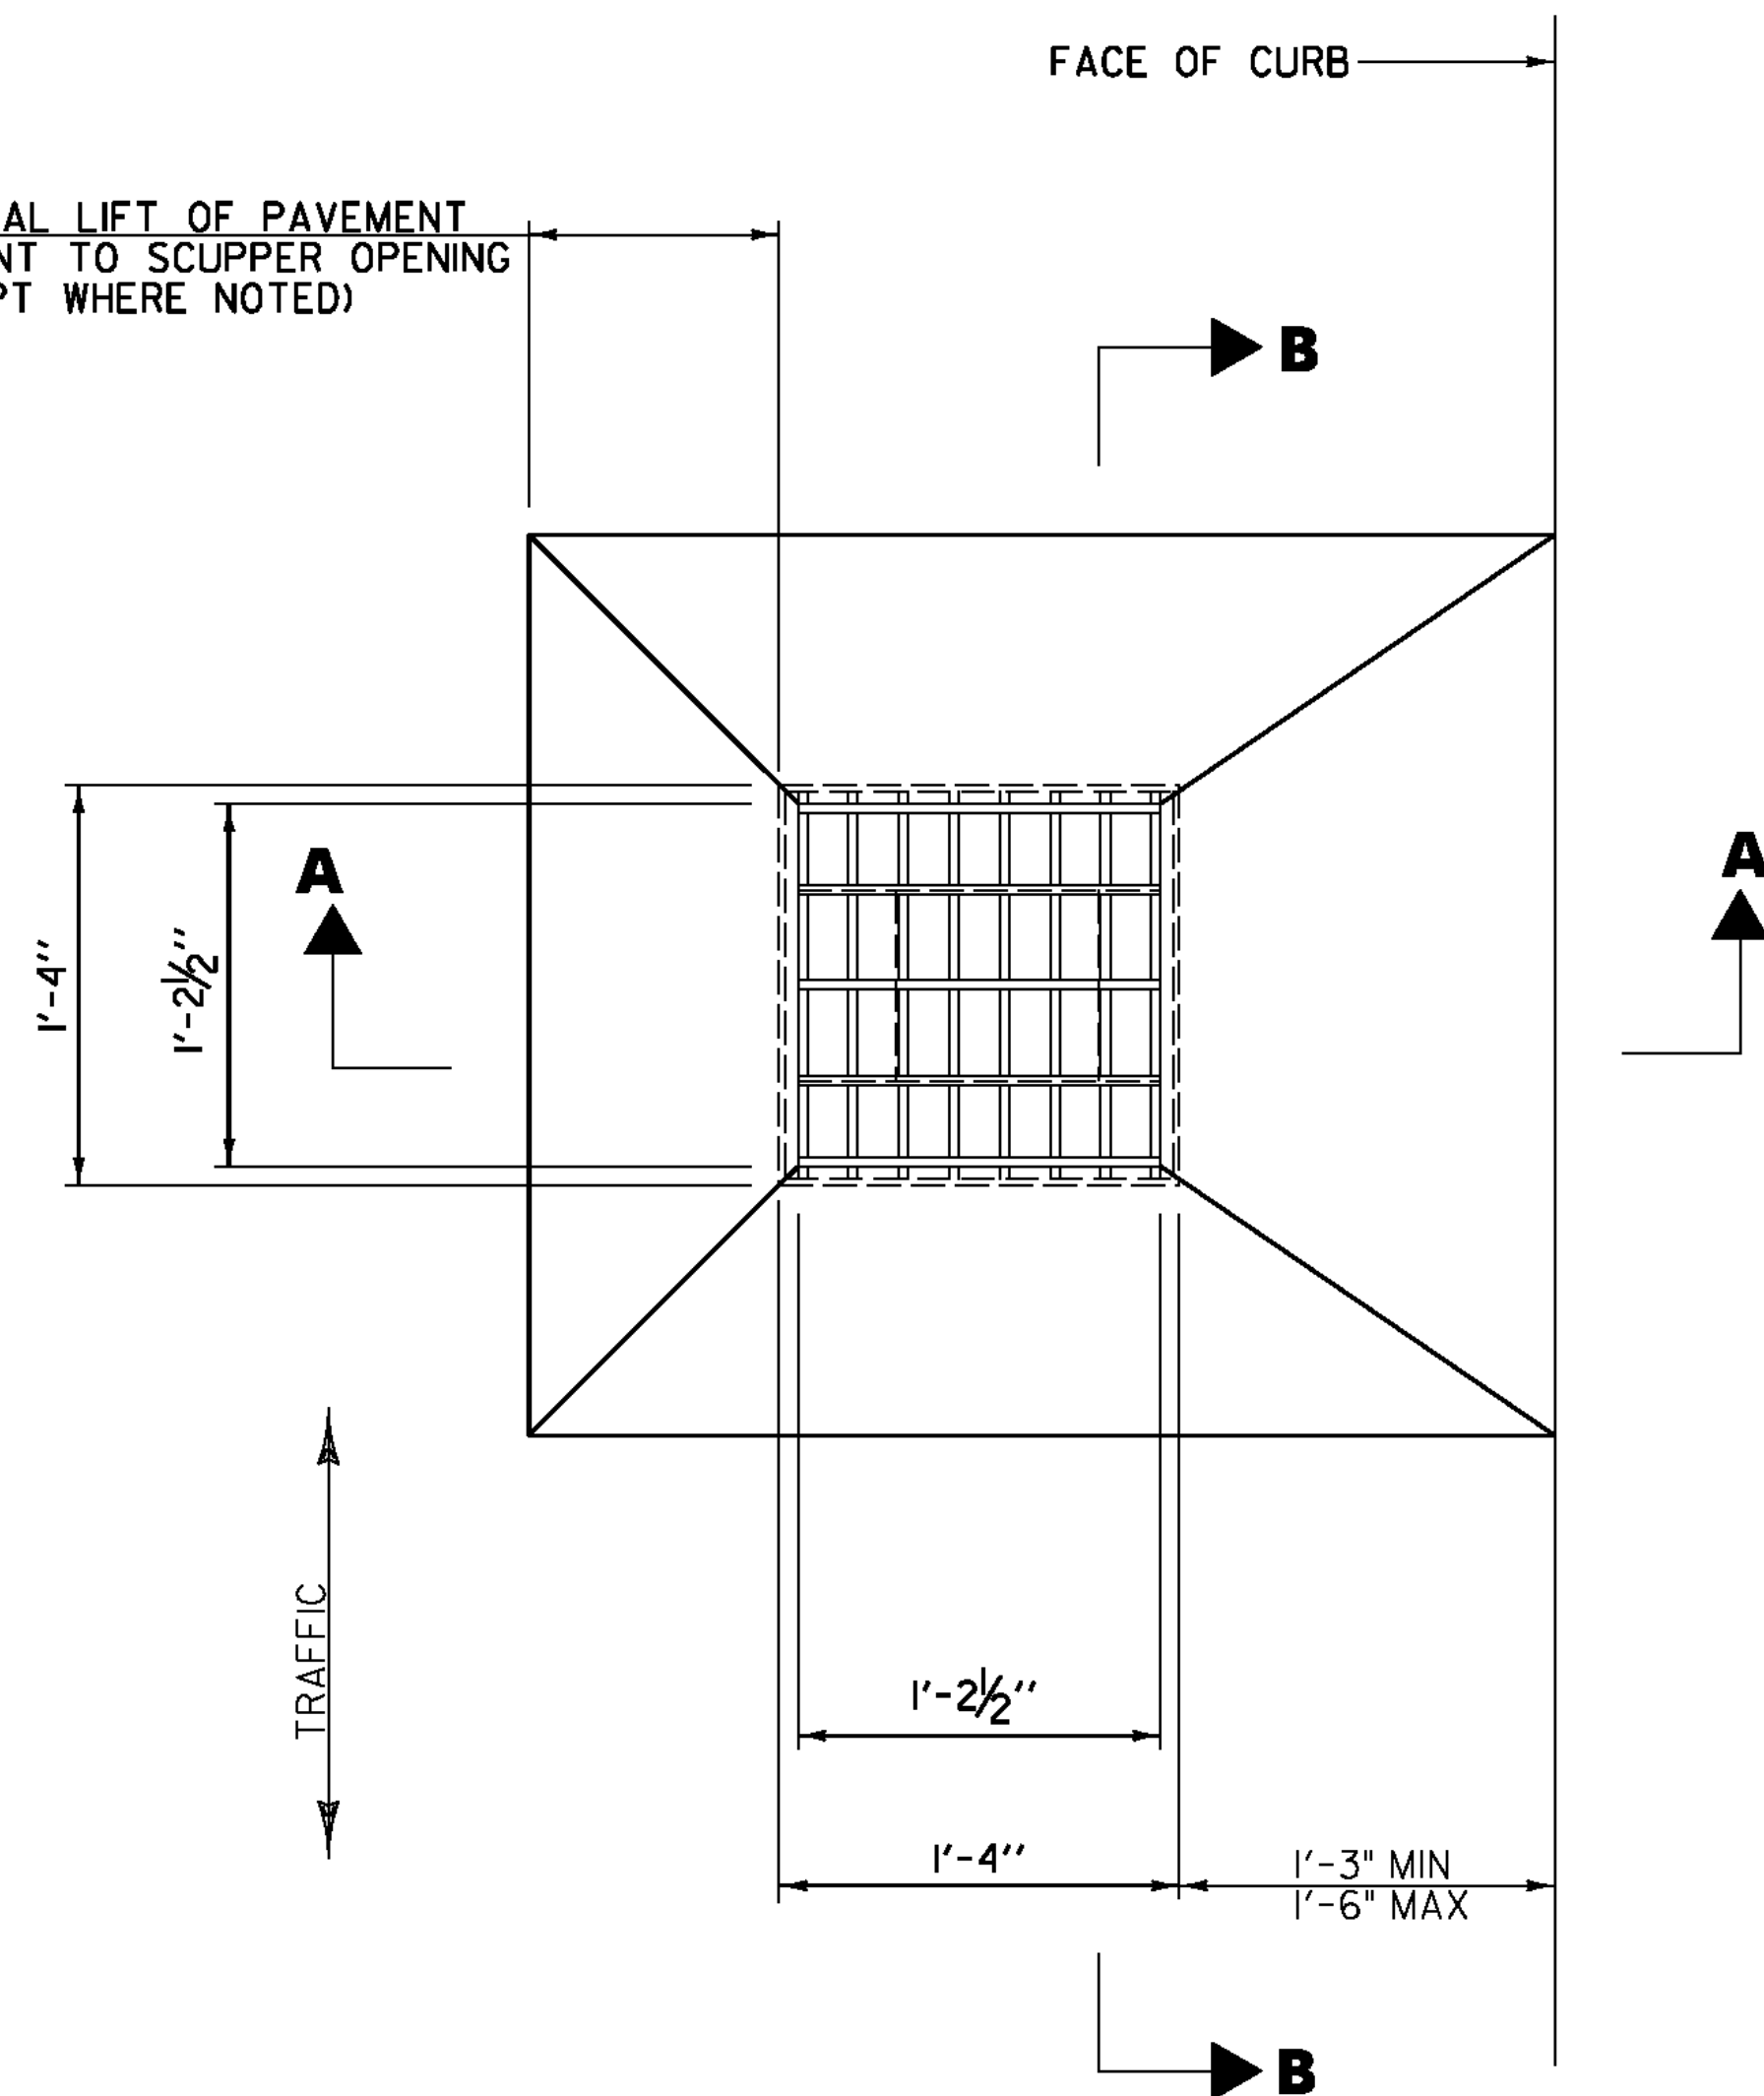


PLAN

1 9 6 3 0
SCALE: 1 1/2" = 1'-0"

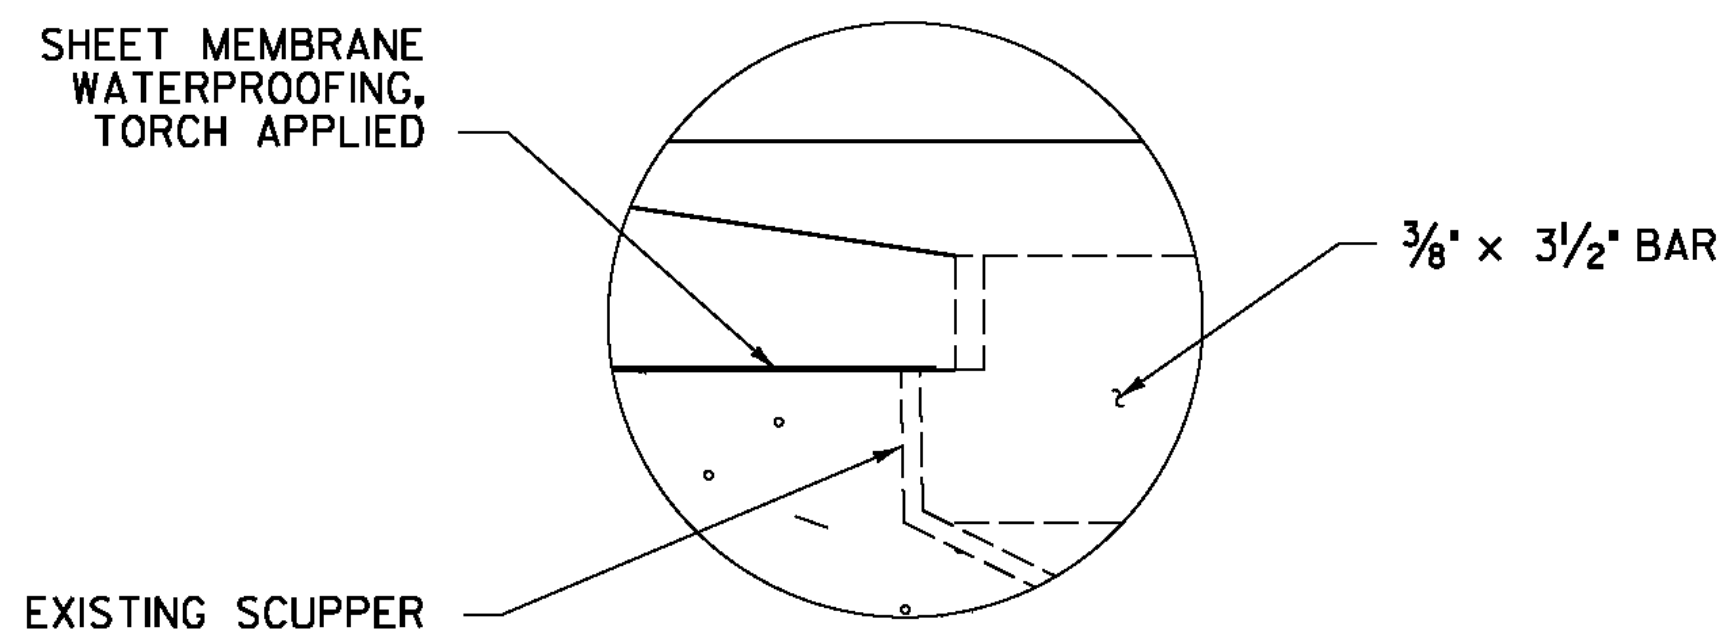


DETAIL "C"

NTS

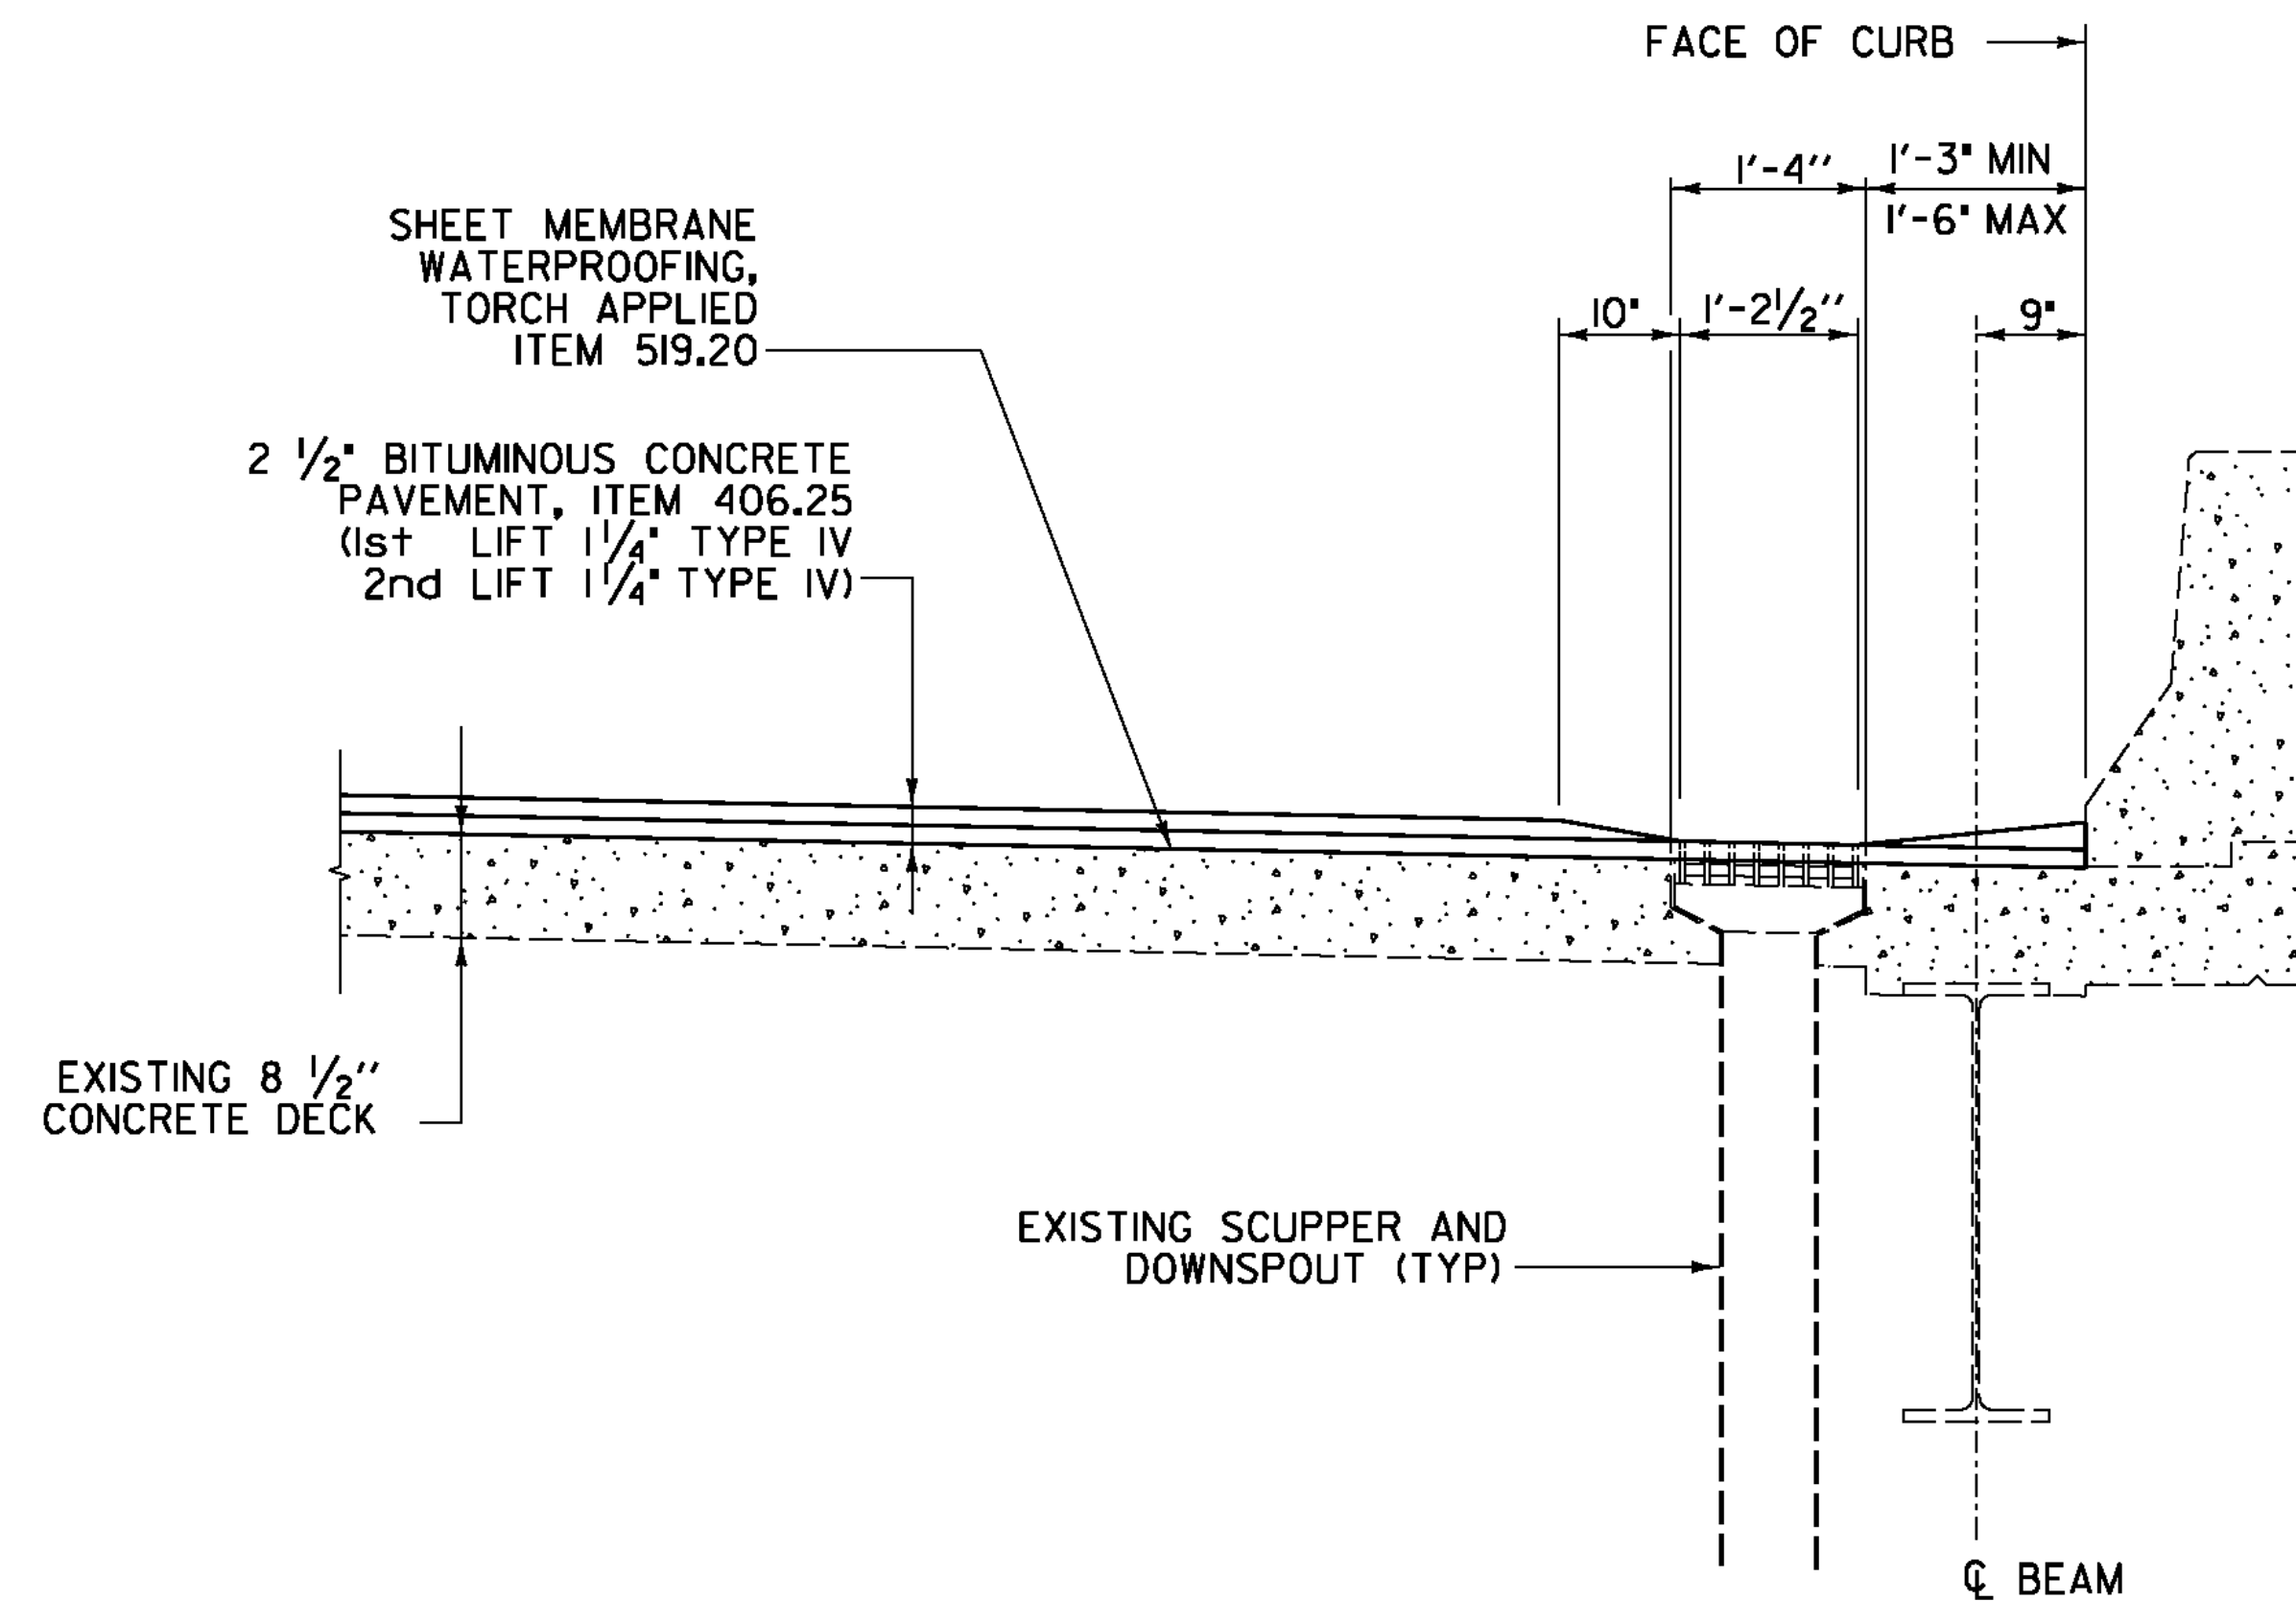

SECTION A-A

1 0 1 2
SCALE 3/4" = 1'-0"

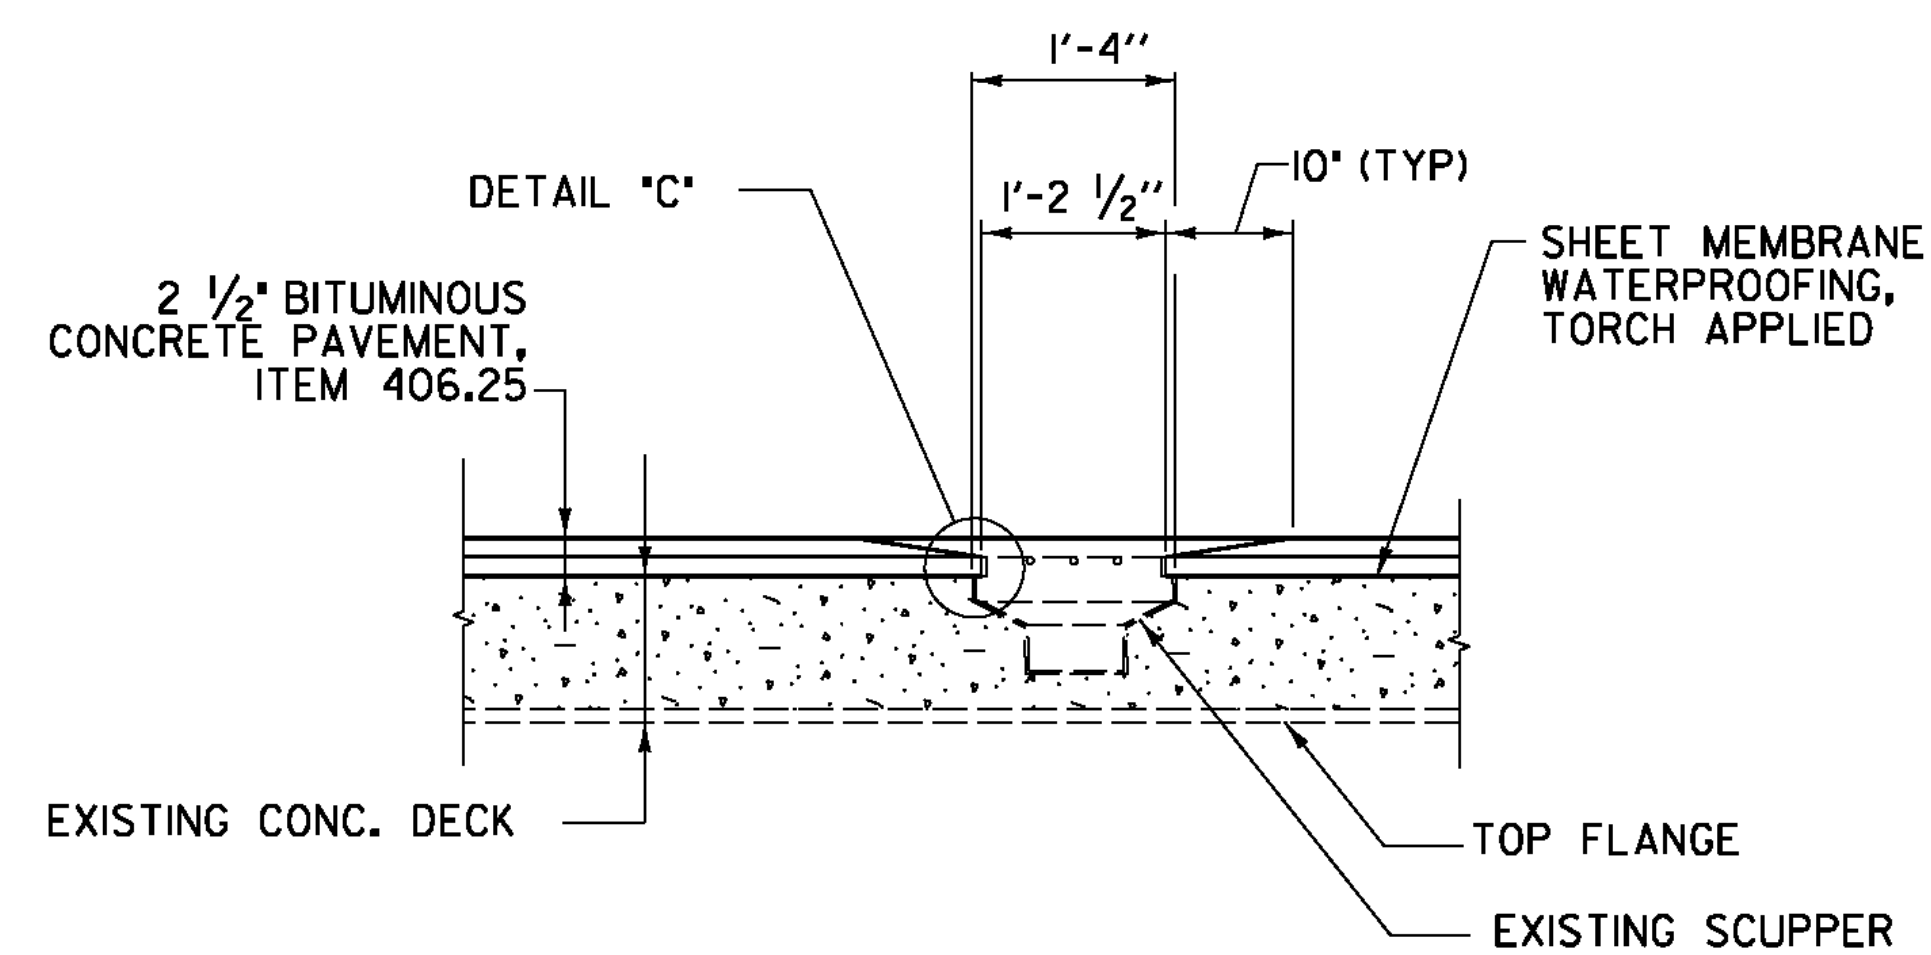

SECTION B-B

1 0 1 2
SCALE 3/4" = 1'-0"

PROJECT NAME: PUTNEY
PROJECT NUMBER: IM 091-K(60)

FILE NAME: ...drawing\z05a288bitconc.dgn PLOT DATE: 7/30/2010
PROJECT LEADER: G. BOGUE DRAWN BY: J. SOTER
DESIGNED BY: T. KNIGHT CHECKED BY: G. GOYETTE
BITUMINOUS CONCRETE DETAILS 2 SHEET 9 OF 45

