


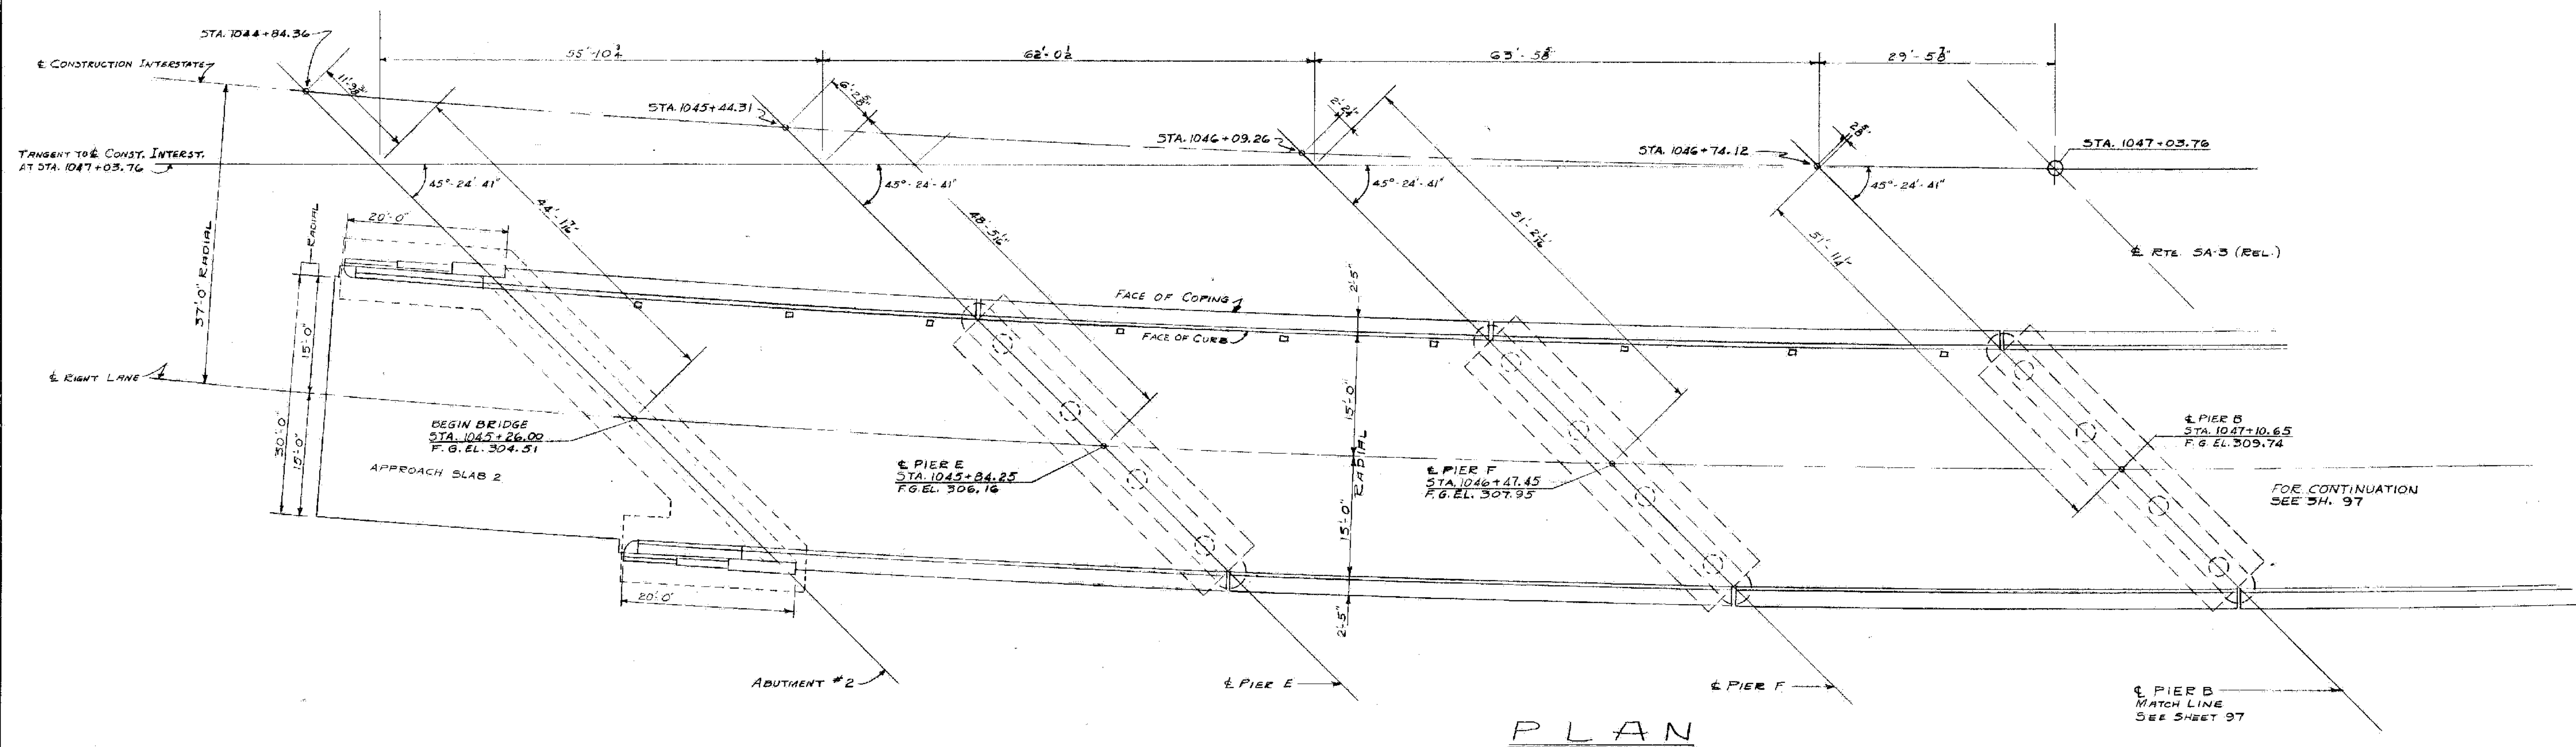

PUTNEY
IM 091-1(60)

SHEET 26 OF 45
BRIDGE 15
FOR REFERENCE ONLY

PLAN

STATE OF VERMONT
DEPARTMENT OF HIGHWAYS

TOWN OF PUTNEY

ROUTE NO. 91 LOG STA. 1047+03.76

PLAN NORTHBOUND LANE

INTERSTATE OVER SA-3 (REL.)

SCALE 1" = 10'-0"

SURVEYED BY

DRAWN BY KENASO CHECKED BY WMS

PROJECT NO. I-91-1(10)

SHEET 27A OF 328

CONTRACT NO. 1