




B.P.R. DIV. NO.	STATE	PROJECT NO.	SHEET NO.	TOTAL SHEETS
1	VT	I 91-1(10)	99	328

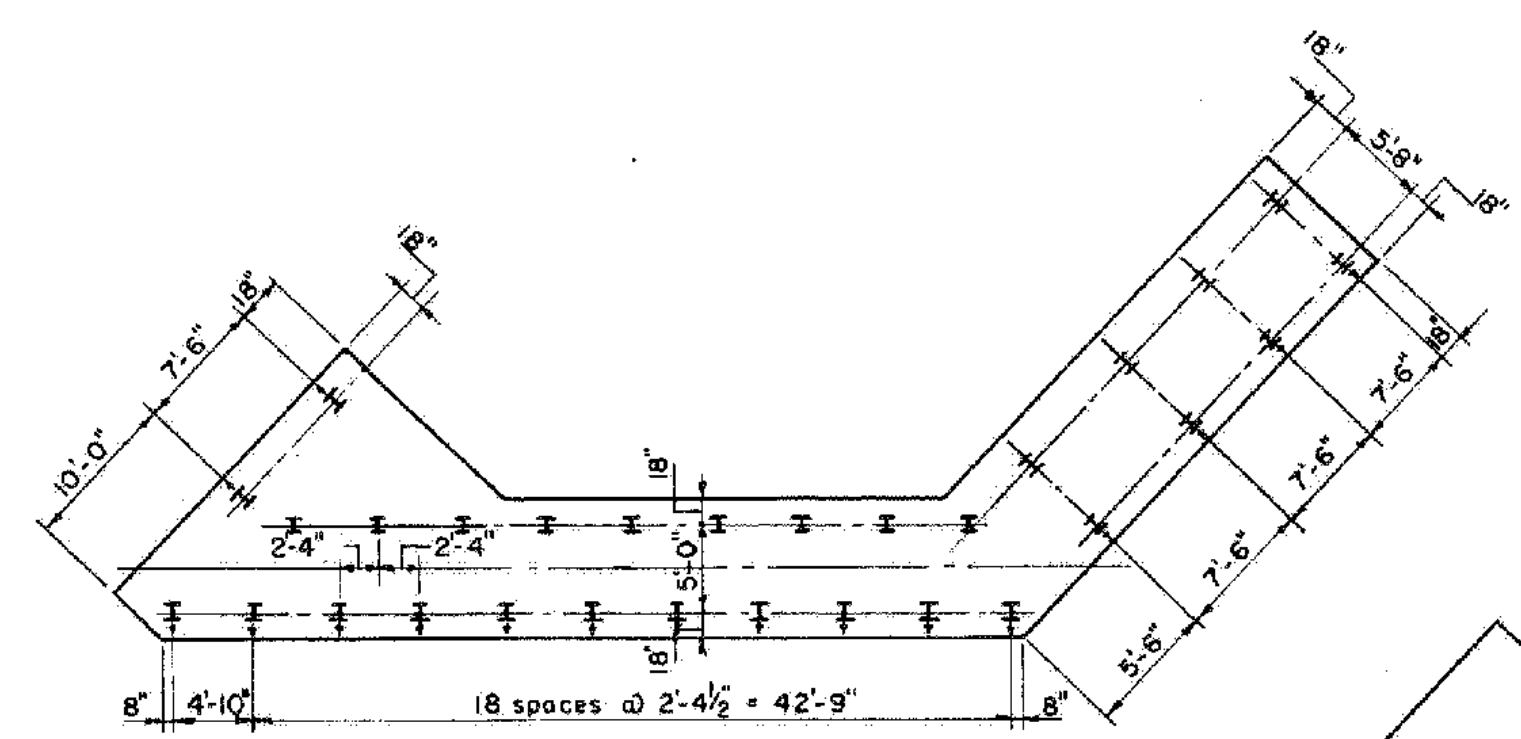


PILE PLAN ABUTMENT NO. 3
No Scale

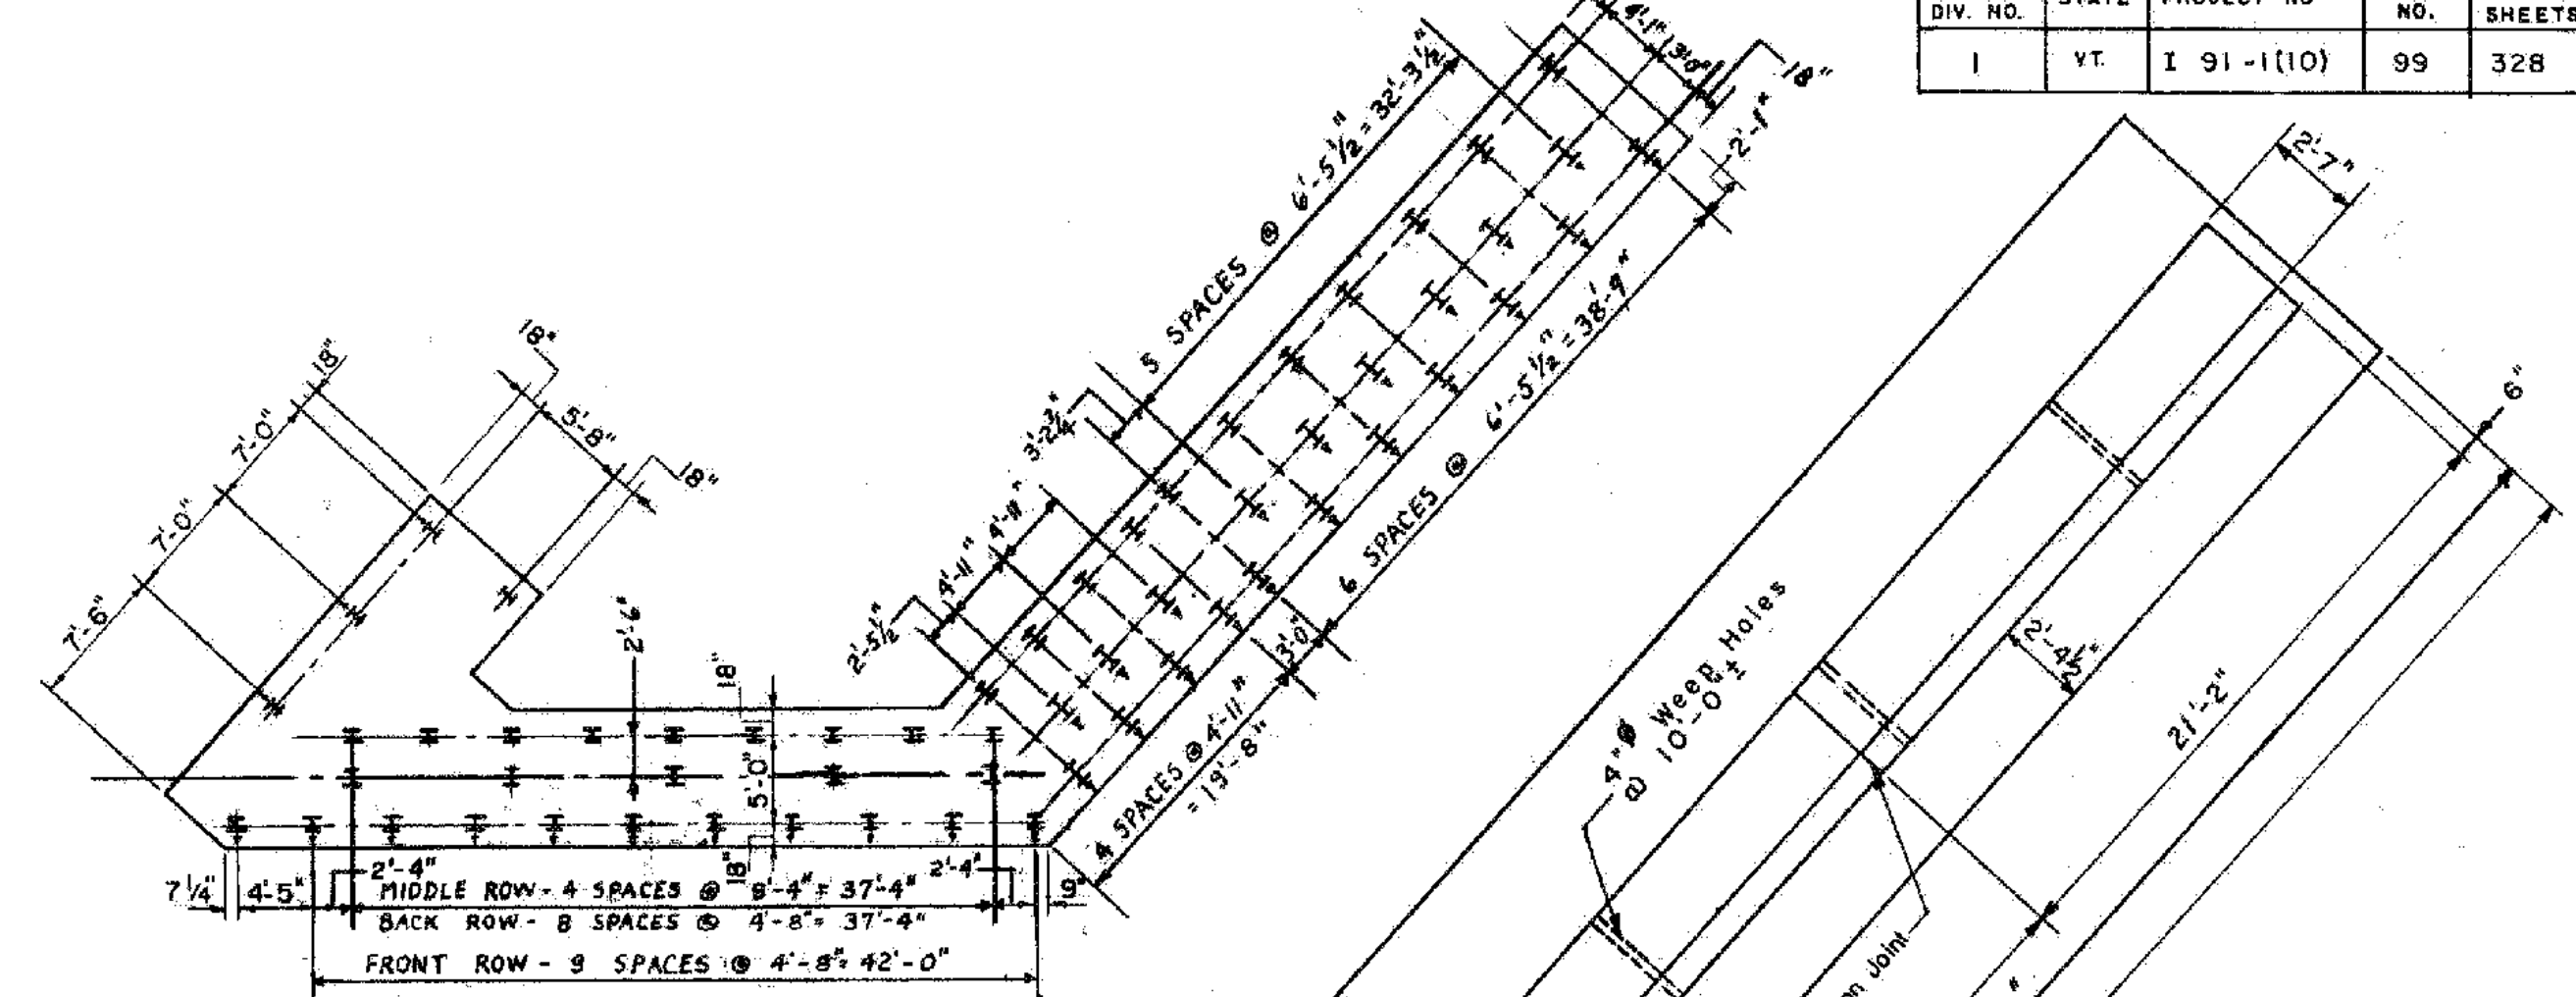


PILE PLAN ABUTMENT NO. 4
No Scale

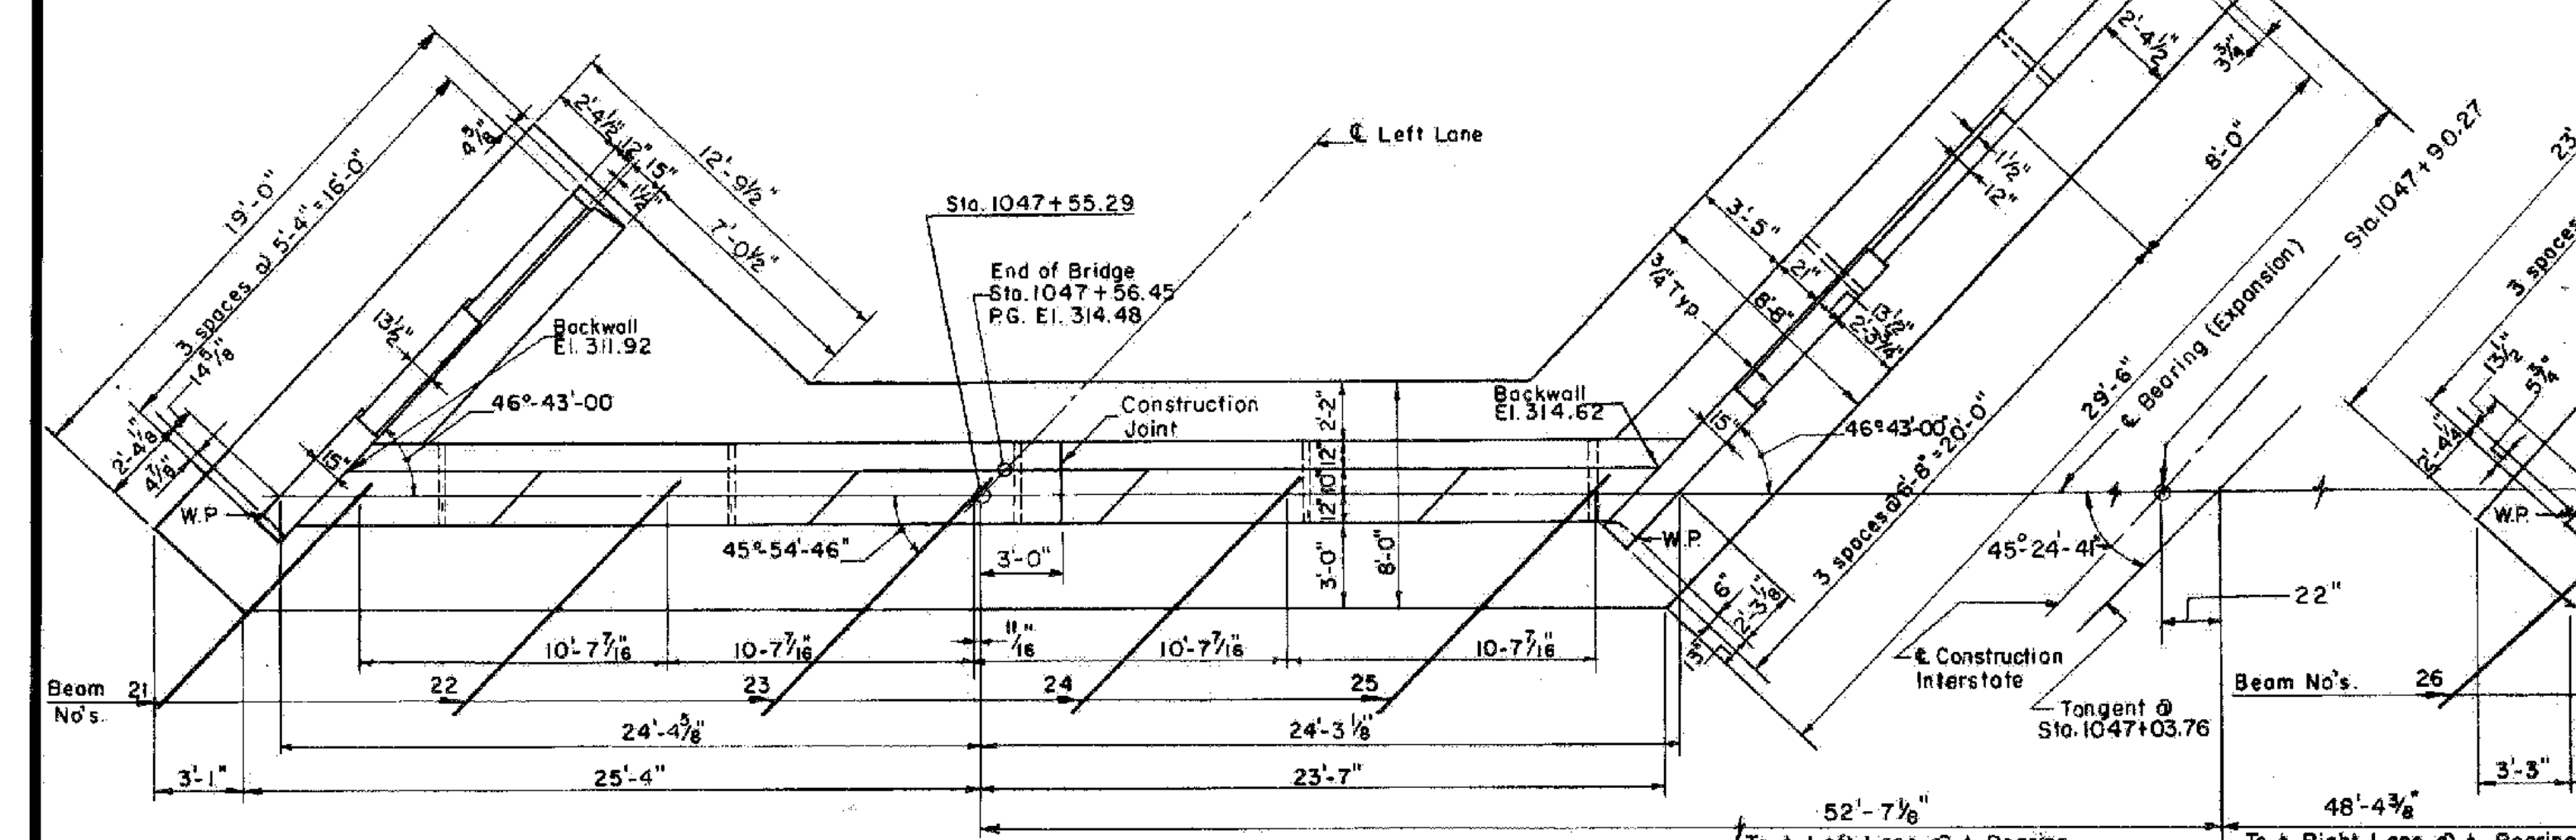


PLAN ABUTMENT NO. 3
SCALE: 3/16" = 1'-0"

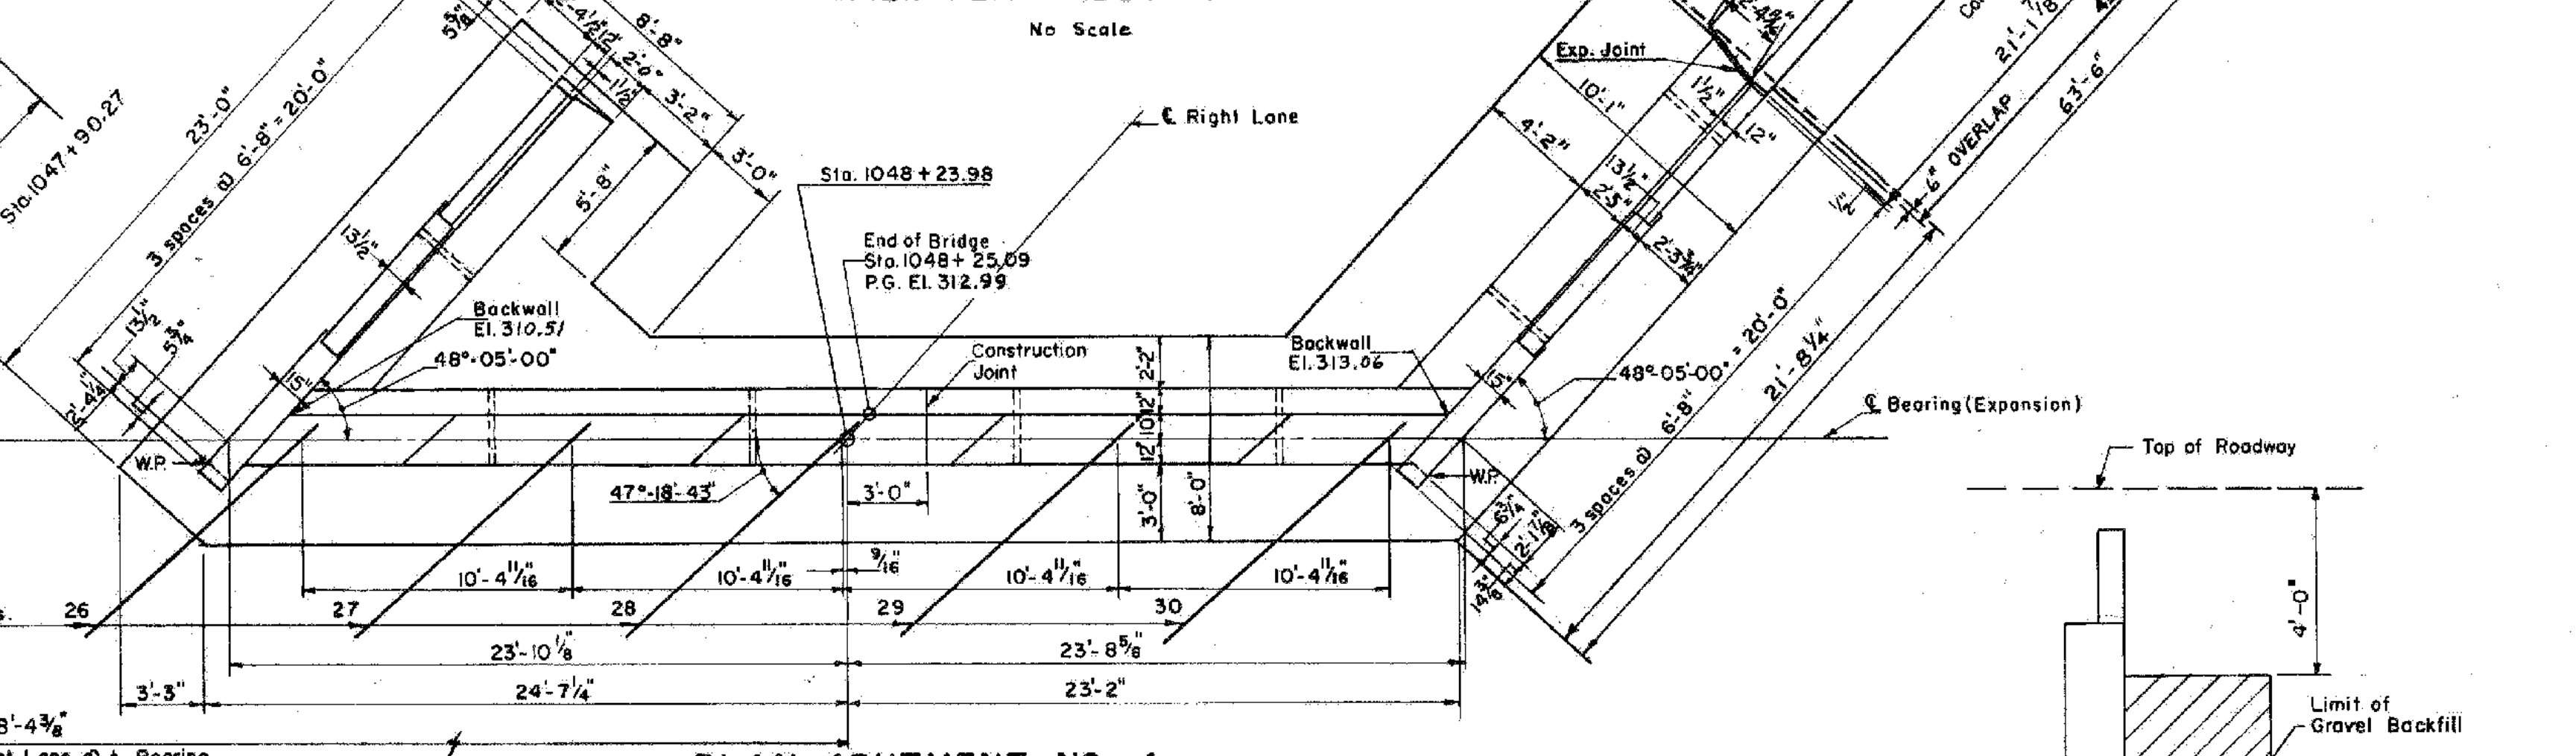


PLAN ABUTMENT NO. 4
SCALE: 3/16" = 1'-0"

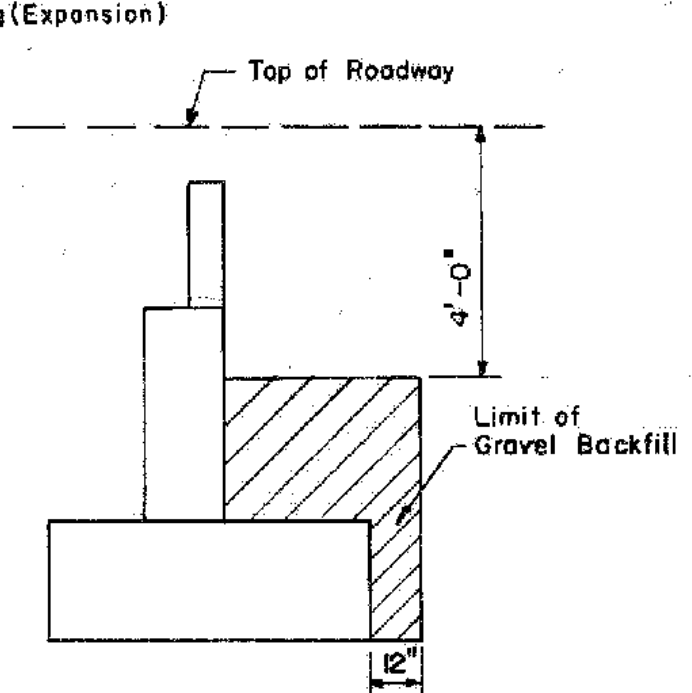

LIMITS OF GRAVEL BACKFILL
No Scale

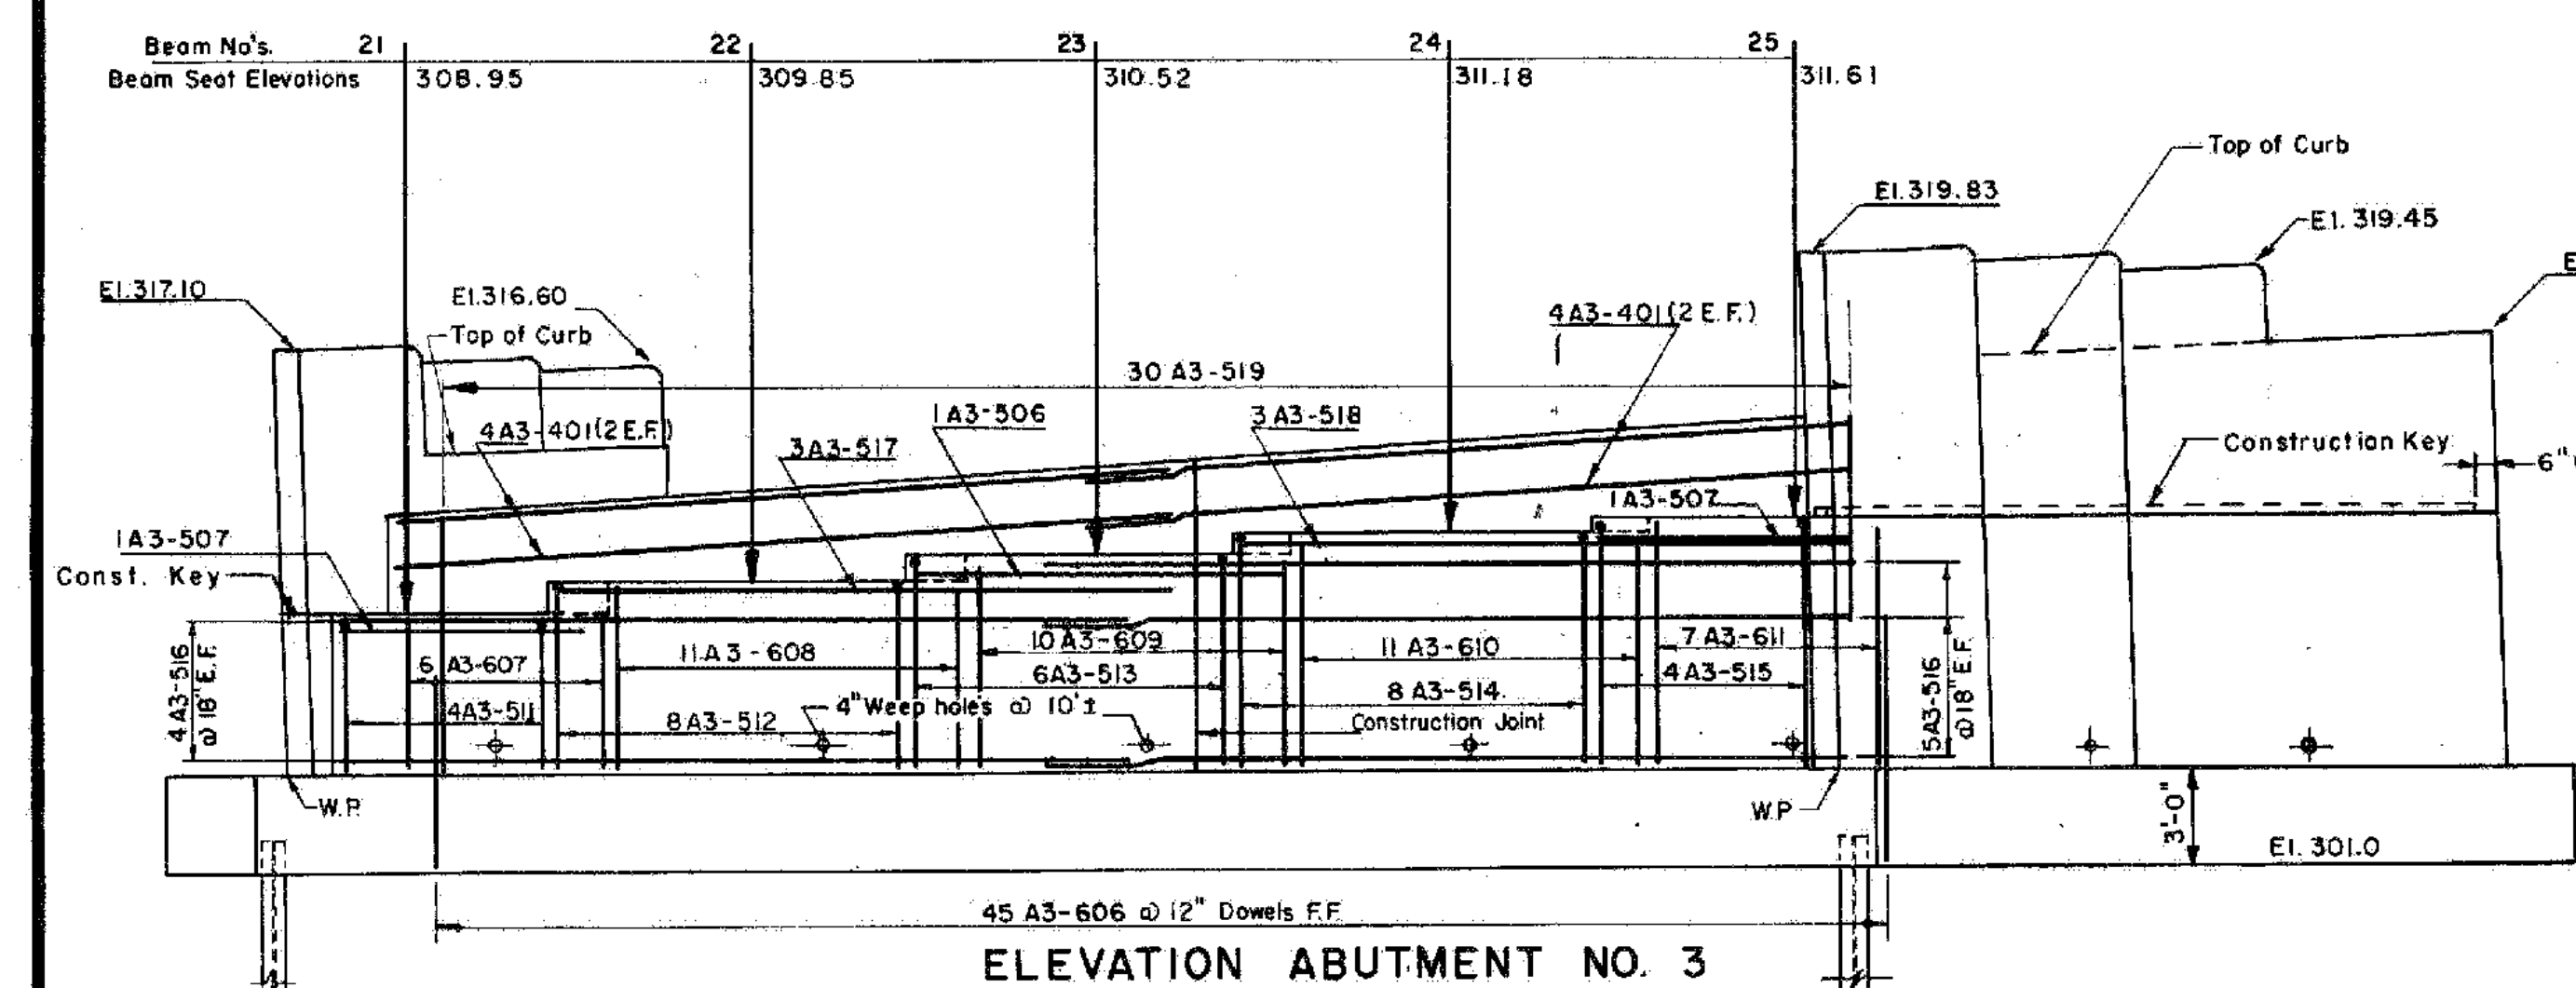

ELEVATION ABUTMENT NO. 3
SCALE: 3/16" = 1'-0"

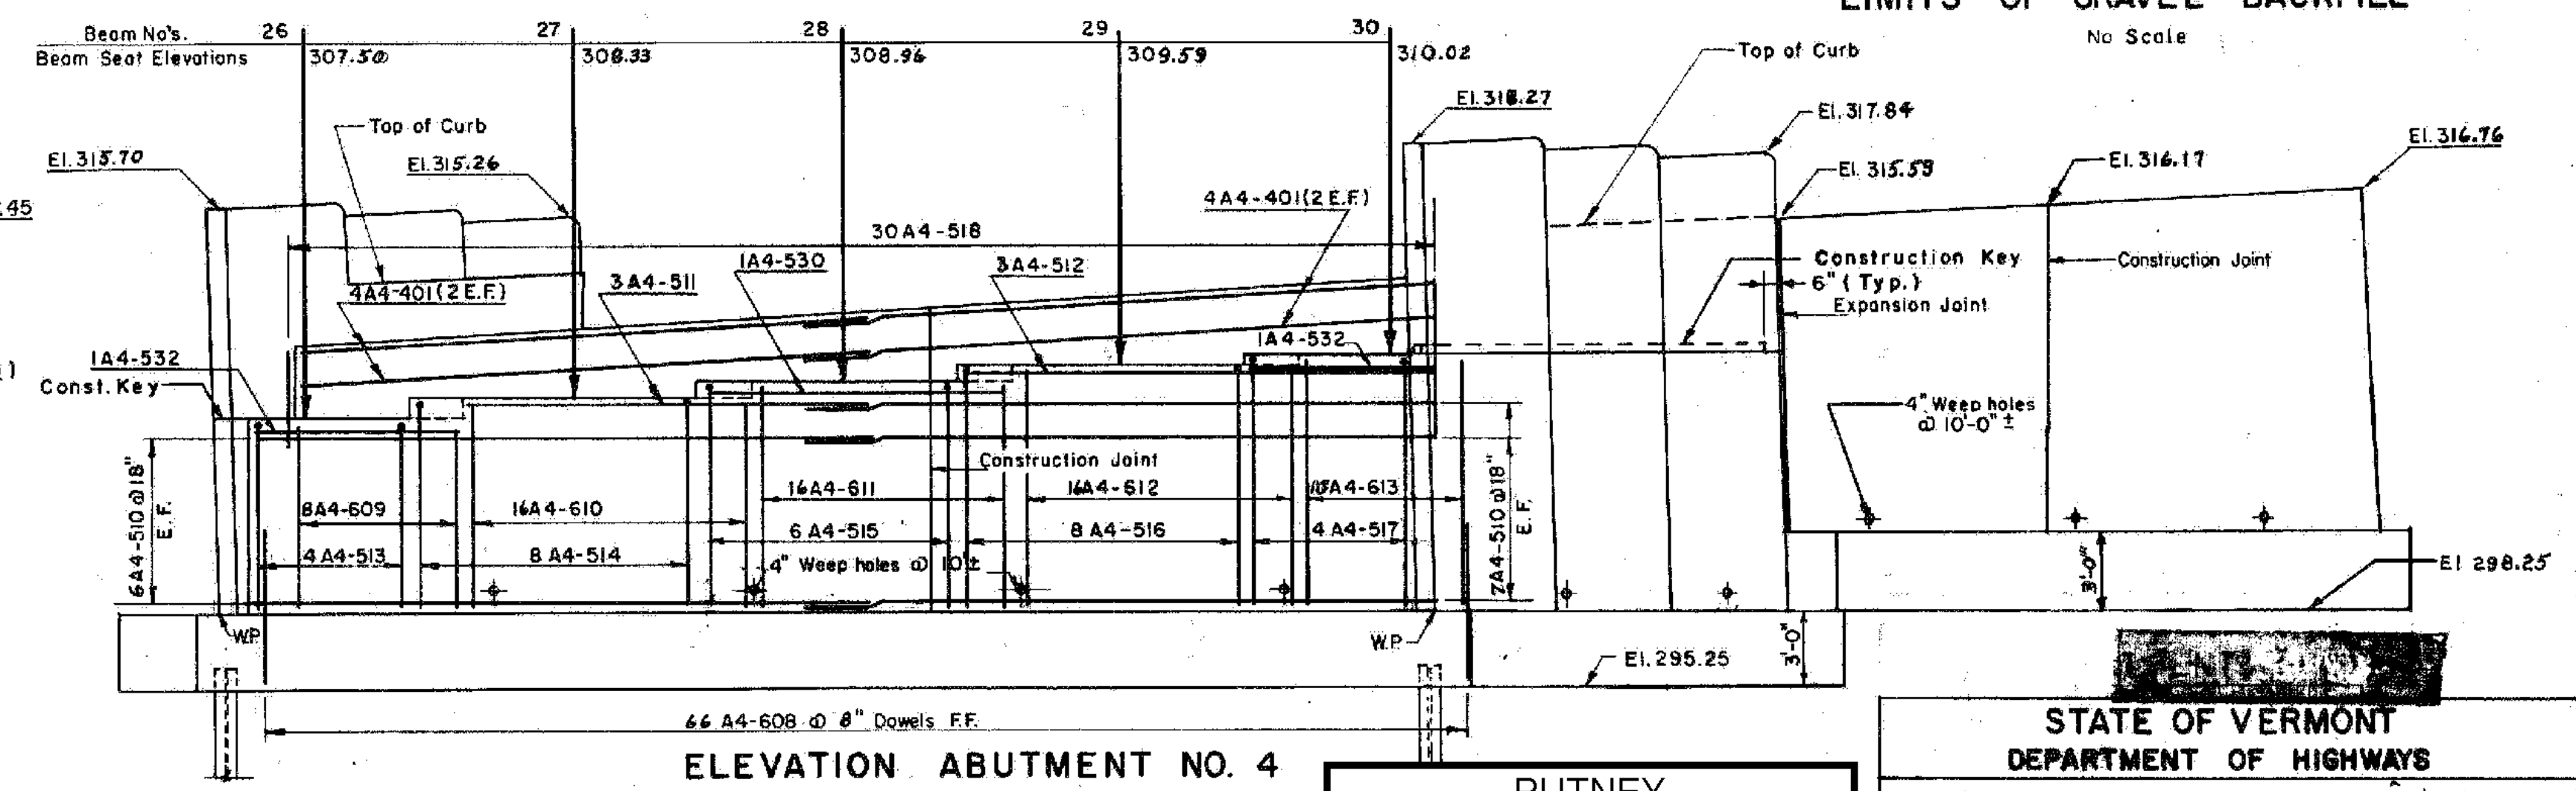

ELEVATION ABUTMENT NO. 4
SCALE: 3/16" = 1'-0"

Note: Bars No. A3-511 thru A3-515 @ 18" N.F.
Bars No. A3-607 thru A3-611 @ 12" F.F.

Note: Bars No. A4-513 thru A4-517 @ 18" N.F.
Bars No. A4-609 thru A4-613 @ 8" F.F.

NOTE: See Sheet 98 for General Notes

PUTNEY
IM 091-1(60)

SHEET 28 OF 45
BRIDGE 15
FOR REFERENCE ONLY

ABUTMENTS NO. 3 AND NO. 4

STATE OF VERMONT DEPARTMENT OF HIGHWAYS			
INTERSTATE PROJECT in the town of PUTNEY			
INTERSTATE SA-3 (REL.)		STA. 1047+03.76 OVER STA. 16+12.51	
THE CLARKE ENGINEERING CO., INC. CONSULTING ENGINEERS			
MASSACHUSETTS		MASSACHUSETTS	
SUBMITTED BY DRAWN BY F.P.D.	CHECKED BY S.J.K. IN CHARGE J.V.B.	SCALE AS NOTED DATE 11/8/97	
PROJECT NO. I 91-1(10)		SHEET 99 OF 328	

CONTRACT NO.1