

646.622 TEMPORARY 6' WHITE LINE, PAINT
646.426 DURABLE 6" WHITE LINE, RECESSED POLYUREA OR
646.428 DURABLE 6" WHITE LINE, RECESSED THERMOPLASTIC OR
646.429 DURABLE 6" WHITE LINE, RECESSED EPOXY PAINT,
D 0.046 TO D 0.248 SOLID LT
120.125 TO 120.210 DOTTED RT


646.632 TEMPORARY 6' YELLOW LINE, PAINT
646.436 DURABLE 6" YELLOW LINE, RECESSED POLYUREA OR
646.438 DURABLE 6" YELLOW LINE, RECESSED THERMOPLASTIC OR
646.439 DURABLE 6" YELLOW LINE, RECESSED EPOXY PAINT,
D 0.046 TO D 0.248 SOLID LT

646.662 TEMPORARY 12' WHITE LINE, PAINT
646.466 DURABLE 12" WHITE LINE, RECESSED POLYUREA OR
646.469 DURABLE 12" WHITE LINE, RECESSED EPOXY PAINT,
D 0.017 TO D 0.046 SOLID LT (GORE STRIPES)
D 0.017 TO D 0.046 SOLID LT
120.210 TO 120.250 SOLID RT

646.692 TEMPORARY LETTER OR SYMBOL, PAINT
646.492 DURABLE LETTER OR SYMBOL, THERMOPLASTIC OR
646.493 DURABLE LETTER OR SYMBOL, EPOXY PAINT,
D 0.109 LT STOP
D 0.117 LT AHEAD
D 0.217 LT WRONG WAY ARROW

604.412, 604.415 REHAB. DROP INLETS,
CATCH BASINS, OR MANHOLES,
CLASS I OR CLASS II
D 0.093 RT (D1)
D 0.160 RT (D1)

616.305 BITUMINOUS CONCRETE CURB, TYPE A
616.41 REMOVAL OF EXISTING CURB
SEE ITEM DETAIL SUMMARY SHEETS

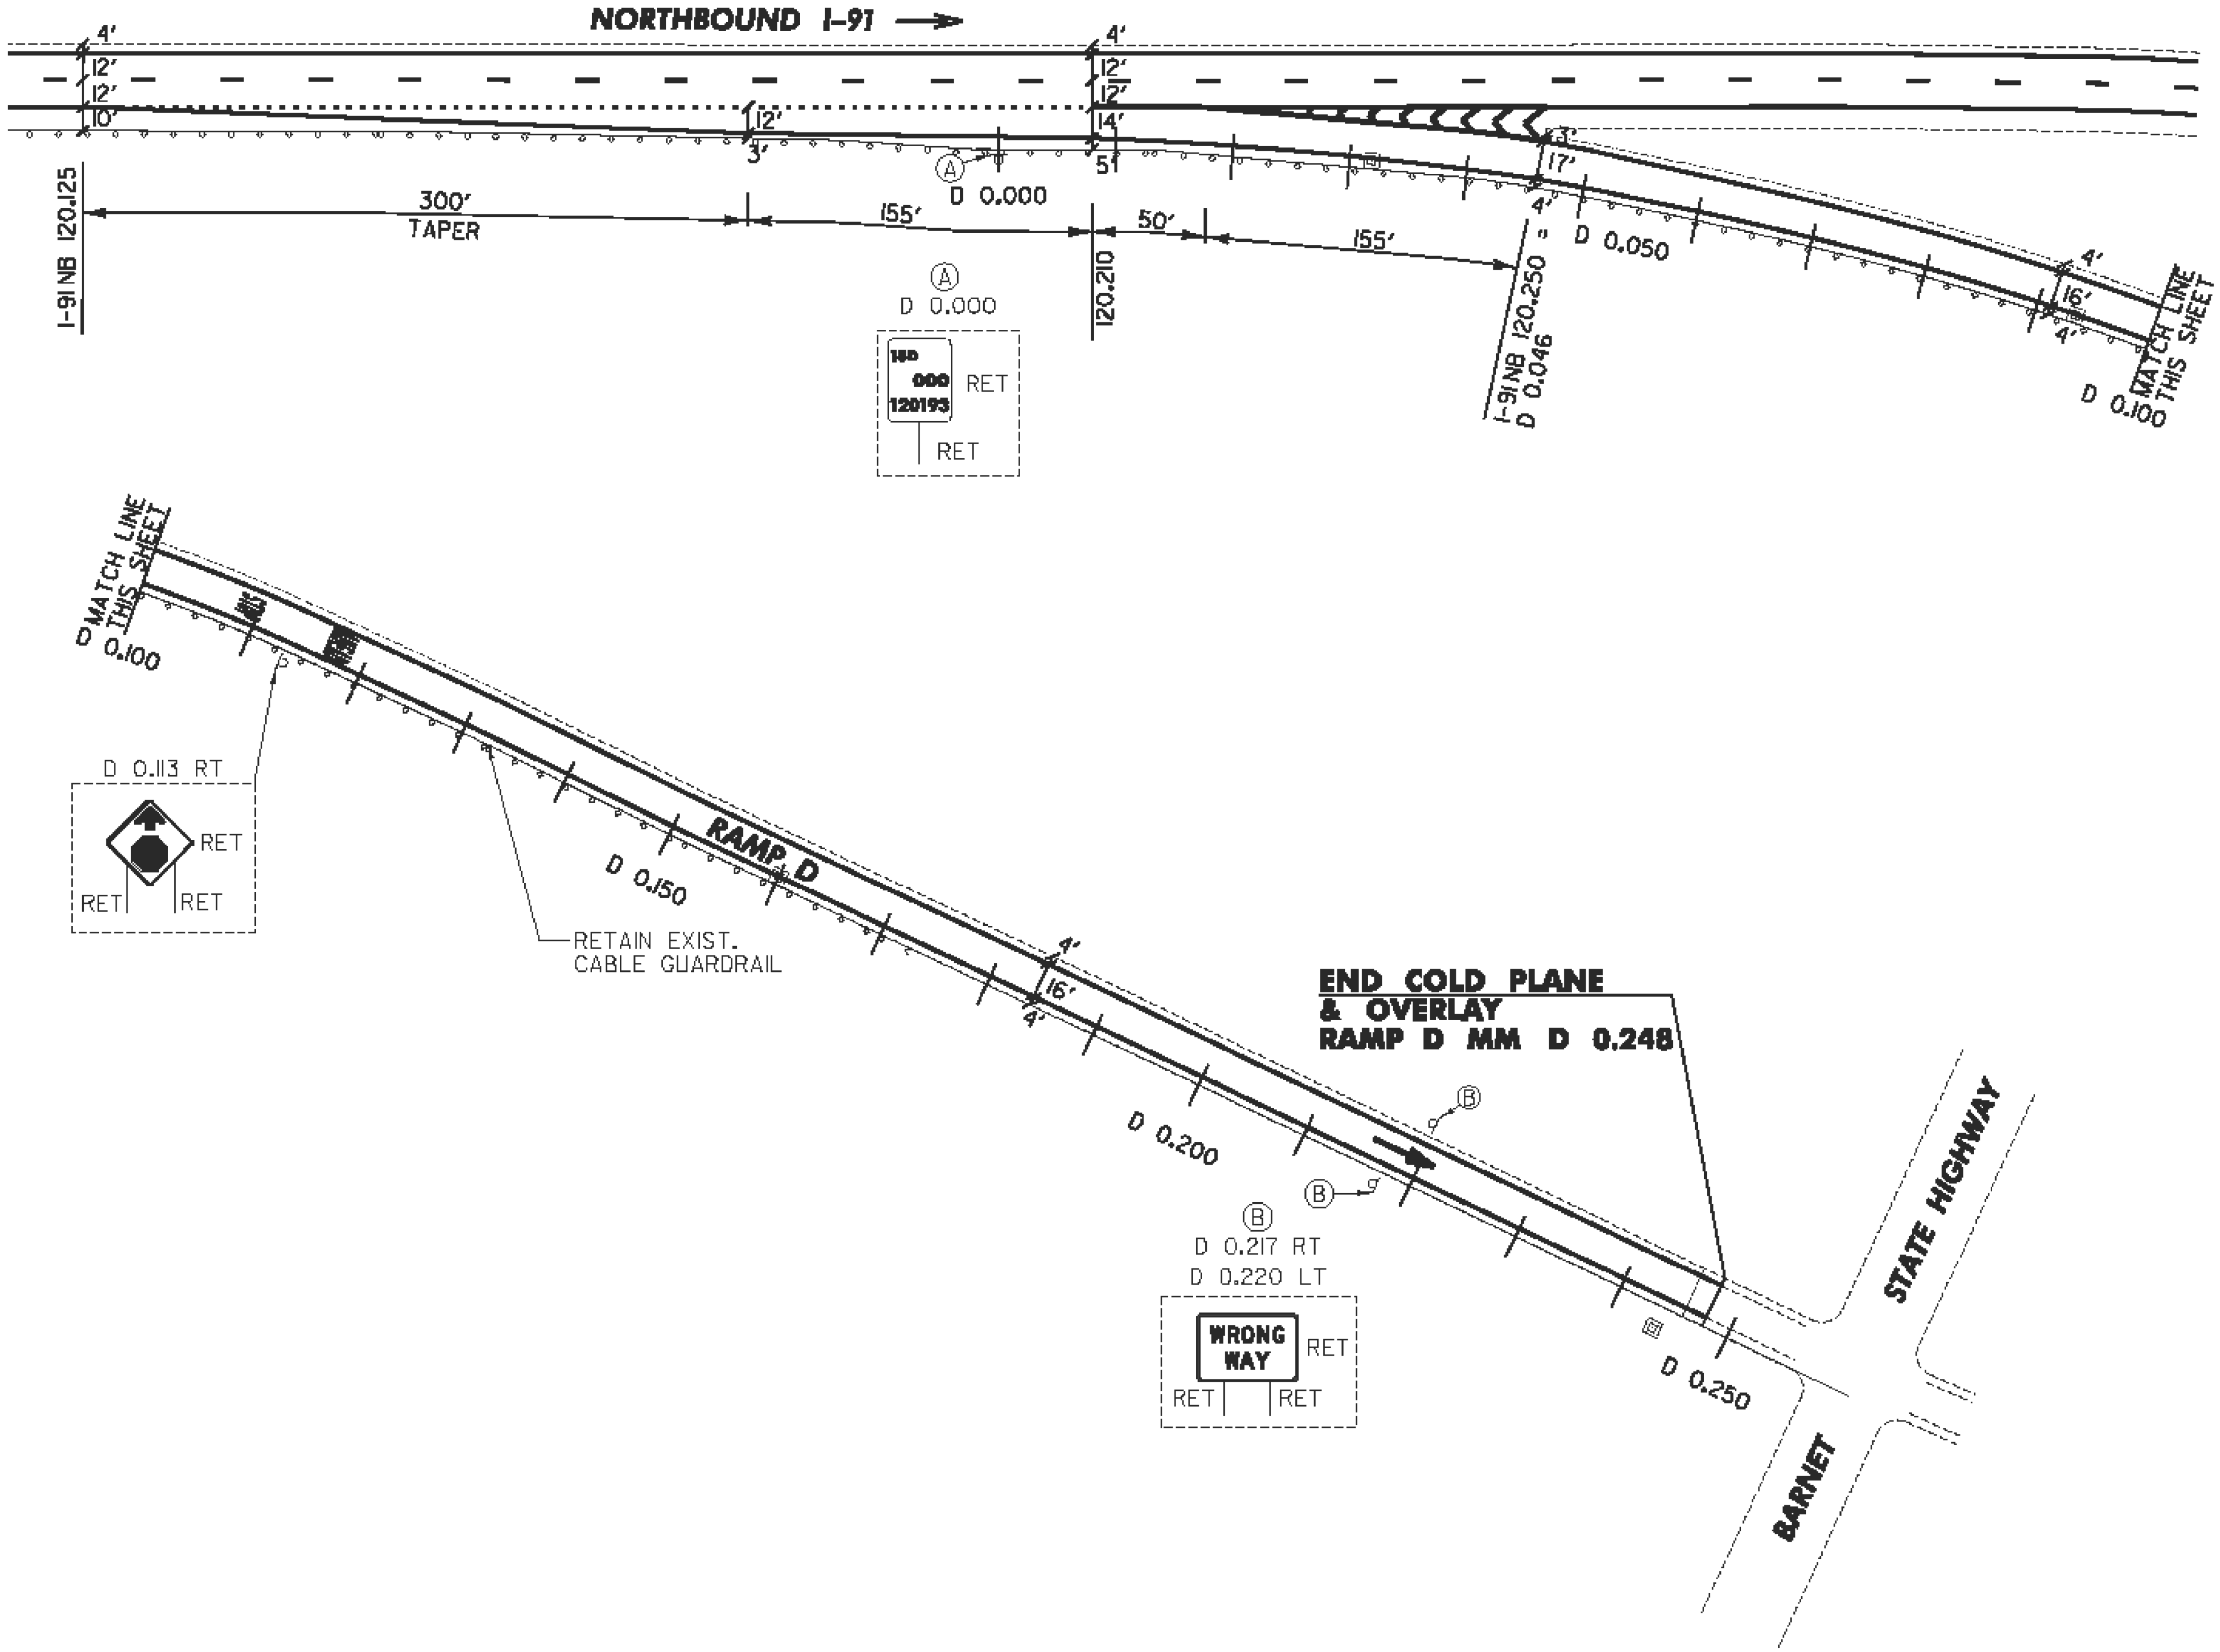

- LEGEND
- RET = RETAIN
 - = EXISTING GUARDRAIL
 - - - = PROPOSED GUARDRAIL
 - YL = YELLOW LINE
 - WL = WHITE LINE
 - = DELINEATOR
 - = D1

NOT TO SCALE

EXIT 18 OFF RAMP DETAIL SHEET

PROJECT NAME: NEWBURY-ST. JOHNSBURY	
PROJECT NUMBER: IM 09I-2(78)	
FILE NAME: /pave/06a044/pa044	PLOT DATE: 8/5/2011
PROJECT LEADER: PTS	DRAWN BY: WWG
DESIGNED BY: NLL	CHECKED BY: PTS
IPARM FILE NAME: 06A044.22	SHEET 22 OF 33