


646.622 TEMPORARY 6" WHITE LINE, PAINT
646.426 DURABLE 6" WHITE LINE, RECESSED POLYUREA OR
646.428 DURABLE 6" WHITE LINE, RECESSED THERMOPLASTIC OR
646.429 DURABLE 6" WHITE LINE, RECESSED EPOXY PAINT,
A 0.038 TO A 0.126 SOLID RT
121.700 TO 121.785 DOTTED RT
121.936 TO 122.021 DOTTED RT

646.632 TEMPORARY 6" YELLOW LINE, PAINT
646.436 DURABLE 6" YELLOW LINE, RECESSED POLYUREA OR
646.438 DURABLE 6" YELLOW LINE, RECESSED THERMOPLASTIC OR
646.439 DURABLE 6" YELLOW LINE, RECESSED EPOXY PAINT,
A 0.038 TO A 0.126 SOLID LT

646.662 TEMPORARY 12" WHITE LINE, PAINT
646.466 DURABLE 12" WHITE LINE, RECESSED POLYUREA OR
646.469 DURABLE 12" WHITE LINE, RECESSED EPOXY PAINT,
A 0.015 TO A 0.038 SOLID LT
A 0.015 TO A 0.038 SOLID LT (GORE STRIPES)
A 0.126 TO 121.927 SOLID LT
121.785 TO 121.816 SOLID RT
121.902 TO 121.936 SOLID RT

646.692 TEMPORARY LETTER OR SYMBOL, PAINT
646.492 DURABLE LETTER OR SYMBOL, THERMOPLASTIC OR
646.493 DURABLE LETTER OR SYMBOL, EPOXY PAINT,
A 0.048 LT WRONG WAY ARROW

621.205 STEEL BEAM GUARDRAIL, GALVANIZED W/8 FEET POSTS
621.80 REMOVAL AND DISPOSAL OF GUARDRAIL
SEE ITEM DETAIL SUMMARY SHEETS

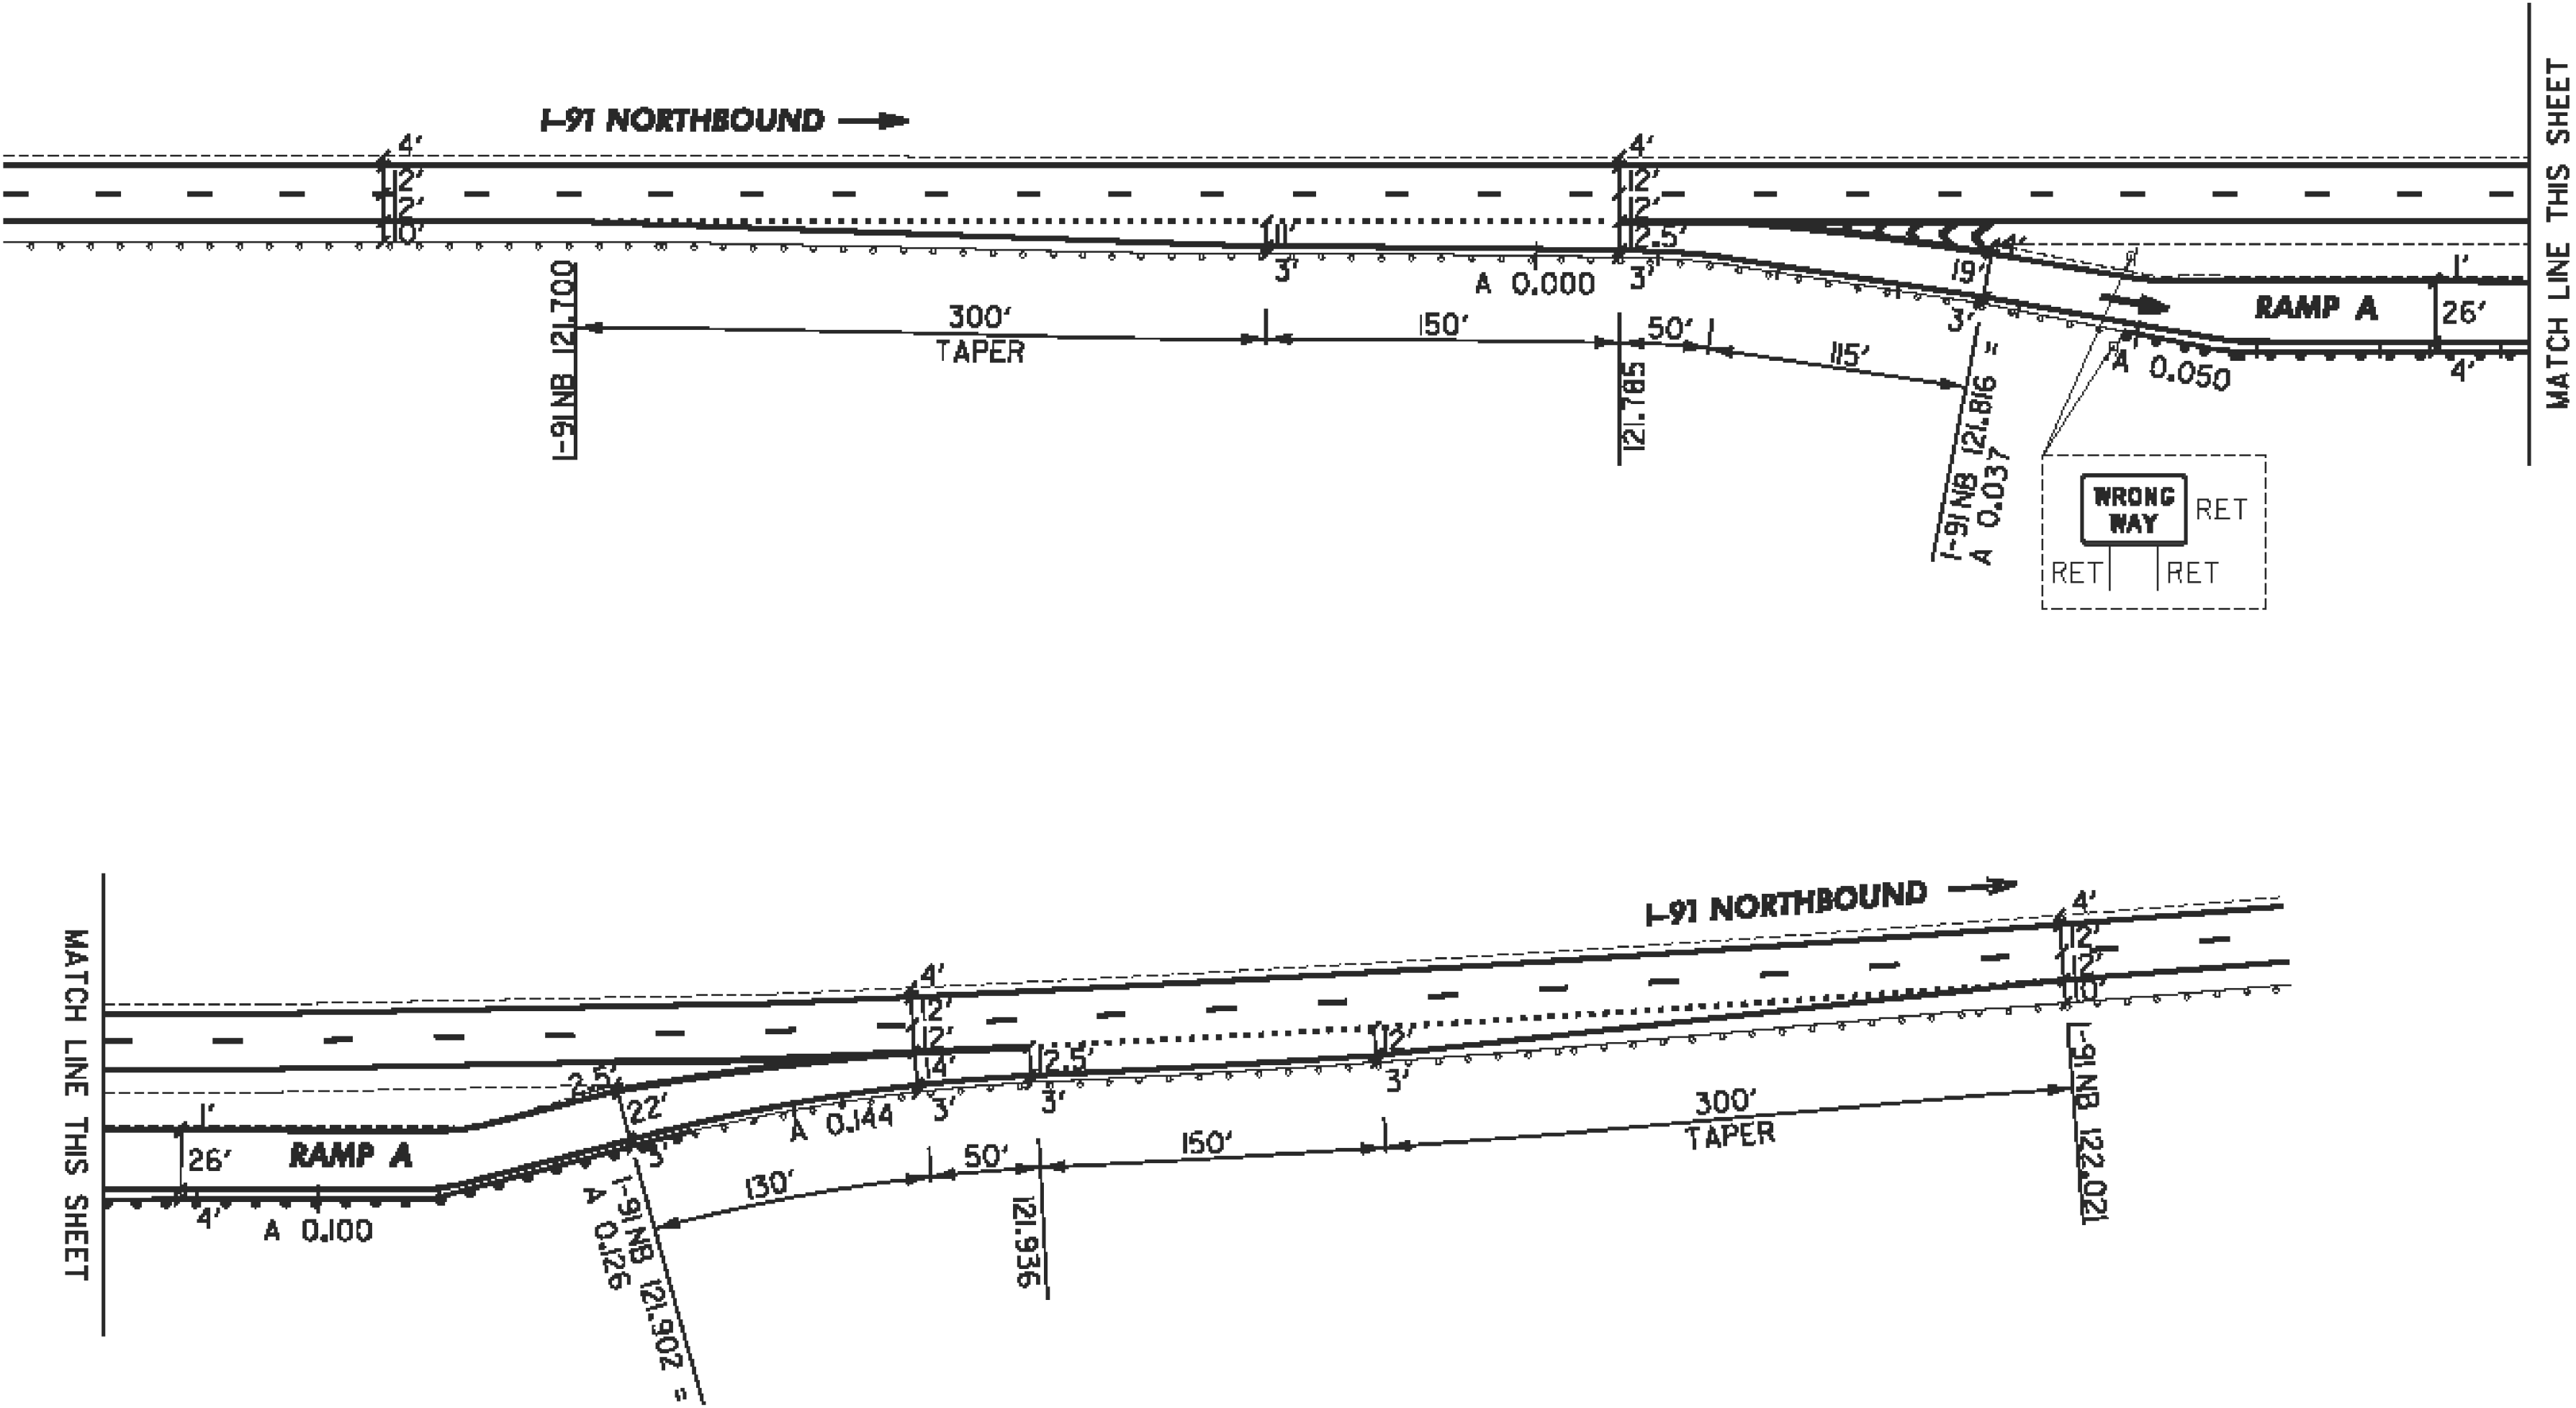

- LEGEND**
- RET = RETAIN
 - = EXISTING GUARDRAIL
 - = PROPOSED GUARDRAIL
 - YL = YELLOW LINE
 - WL = WHITE LINE
 - = DELINEATOR
 - = DI

NOT TO SCALE

SCENIC VIEW DETAIL SHEET			
PROJECT NAME:		NEWBURY-ST. JOHNSBURY	
PROJECT NUMBER:		IM 091-2(78)	
FILE NAME:		/pave/06a044/pa044	
PROJECT LEADER:		PTS	
DESIGNED BY:		NLL	
IPARM FILE NAME:		06A044.24	
PLOT DATE:		8/5/2011	
DRAWN BY:		SNG	
CHECKED BY:		PTS	
SHEET		24 OF 33	