


MATCH TO SHEET 24
STA 209+50.00

DATUM
VERTICAL: NAVD 88
HORIZONTAL: NAD83 (96)

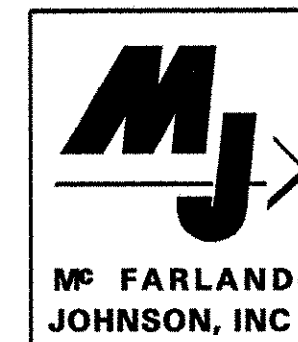

PROJECT NAME: SOUTH BURLINGTON	PLOT DATE: 21-SEP-2007
PROJECT NUMBER: AC IM CULV (9)	DRAWN BY: MAL
FILE NAME: ec07.dgn	CHECKED BY: DMB
PROJECT LEADER: LANDRY	SHEET 23 OF 63
DESIGNED BY: MRP	
FINAL CONDITIONS	