


102+25

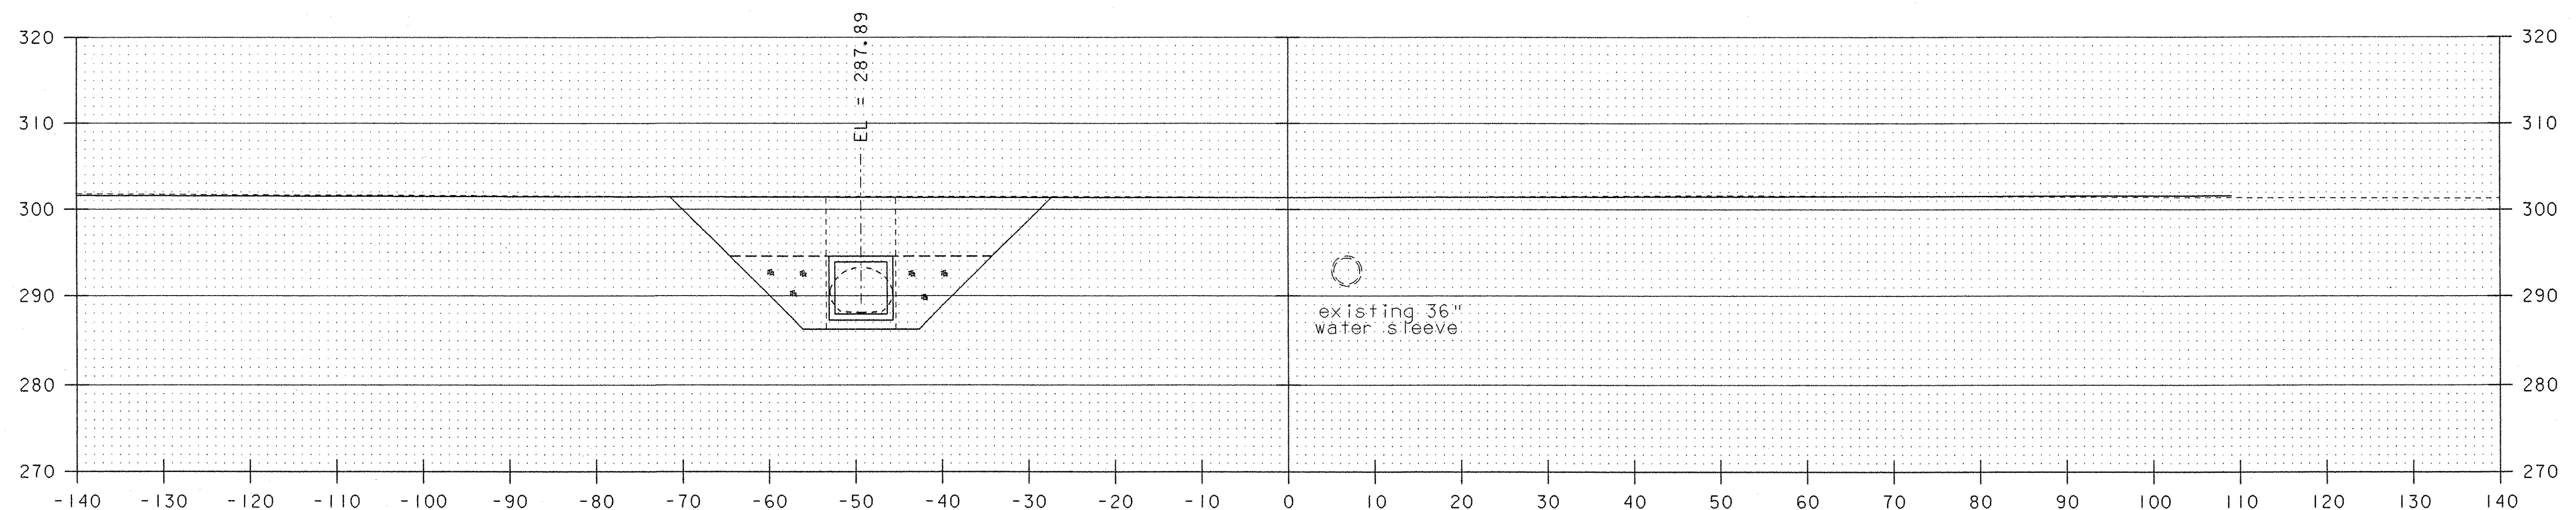

102+00

NOTES:

1. CHANNEL AND TOP OF BOTTOM SLAB ELEVATIONS ARE PROVIDED AT CENTERLINE POTASH BROOK TRIBUTARY AND CENTERLINE BOX CULVERT.

SCALE 1" = 10'-0"



STATE OF VERMONT AGENCY OF TRANSPORTATION			
Town Of <i>S. BURLINGTON</i>		Bridge No. <i>67-1</i>	
Highway No. <i>I-89</i>		Log Sta.	
		Surv. Sta.	
<i>I-89 OVER POTASH BROOK TRIBUTARY</i>			
CHANNEL CROSS SECTIONS (3 OF 5)			
Designed By <i>LKW/MAH</i>		Drawn By <i>MAH</i>	
Checked By <i>Date</i>		Bridge Design Supervisor	
<i>RLJ 09/07</i>		<i>TTK Date 09/07</i>	
PROJECT		PROJECT NO.	
<i>SOUTH BURLINGTON</i>		<i>AC IM CULV (9)</i>	
I.G.C. Info. <i>M:\656310 I-89 Culvert\BRIDGE\2Cadd\4Final-prelim\205k286CXS.dgn</i>			
Bridge Sheet No.		Sheet <i>61</i> of <i>63</i>	