



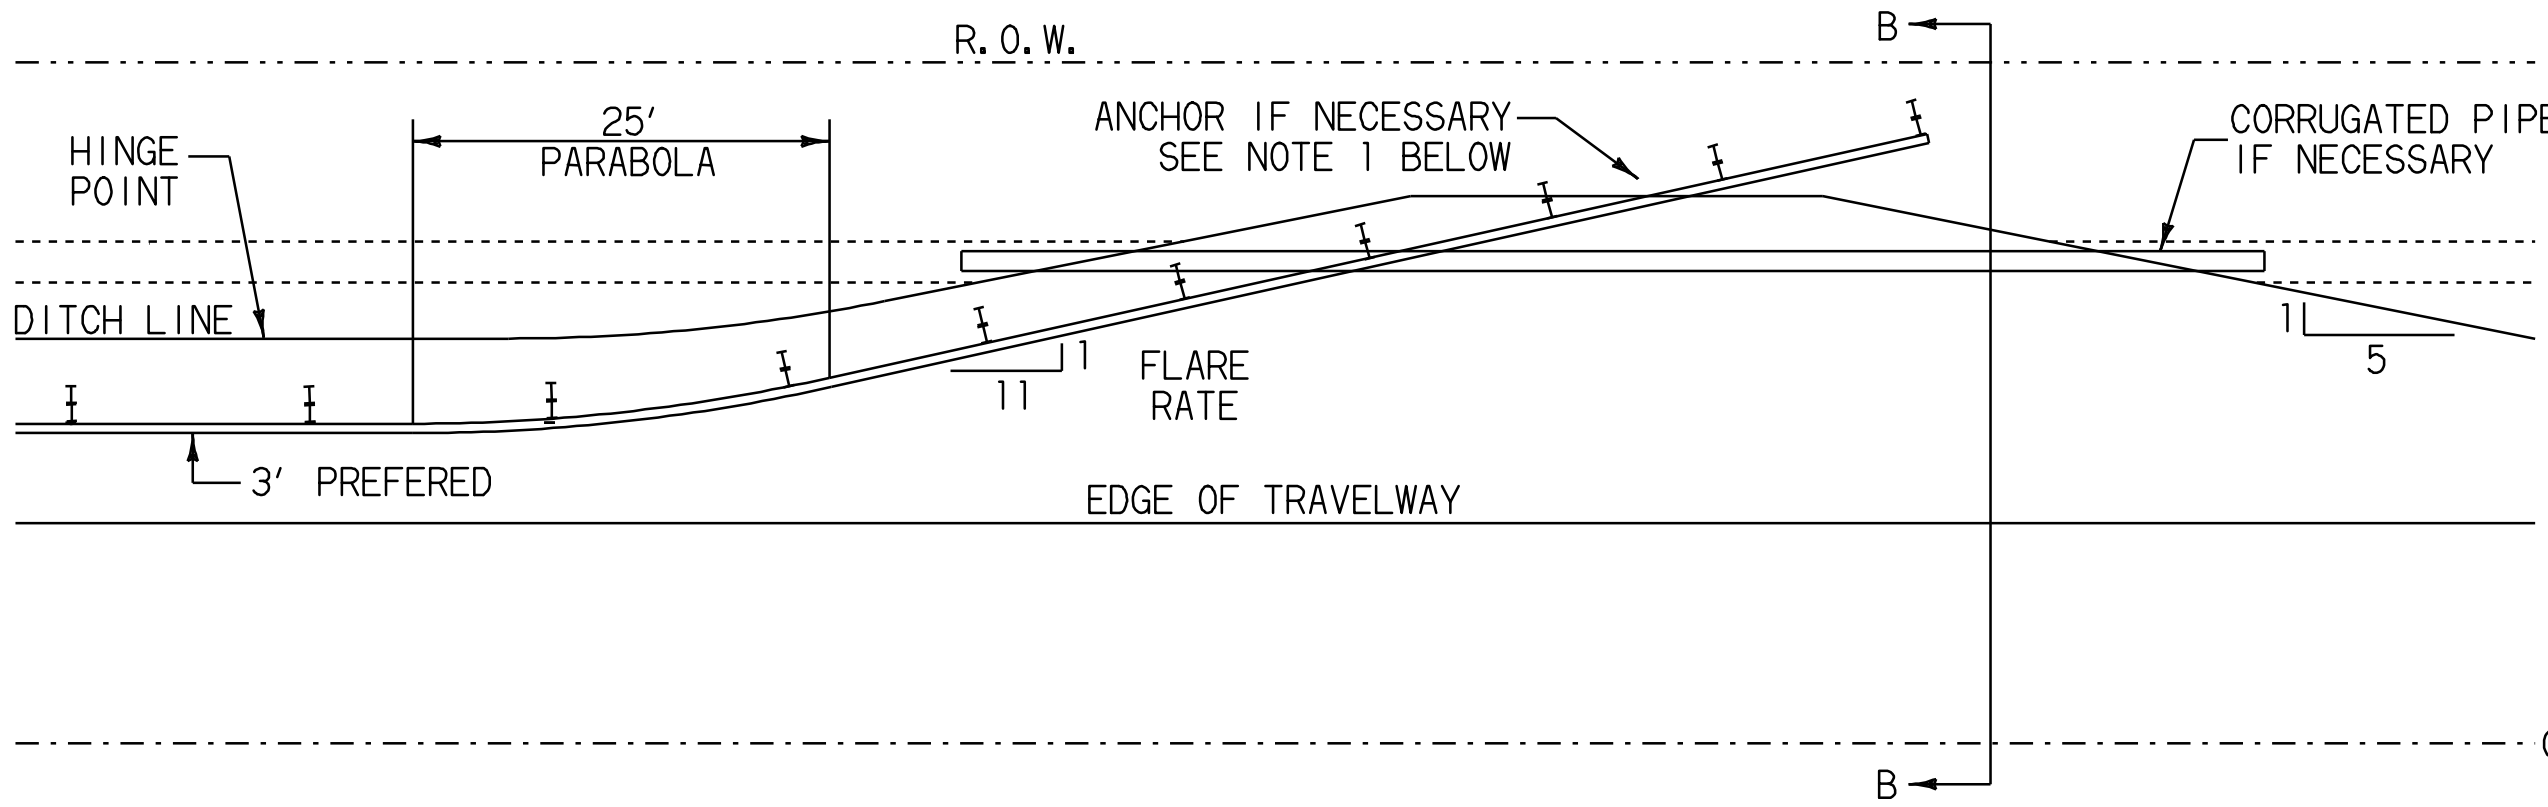

DETAIL FOR BURIED GUARD RAIL ENDS INTO BACKSLOPES

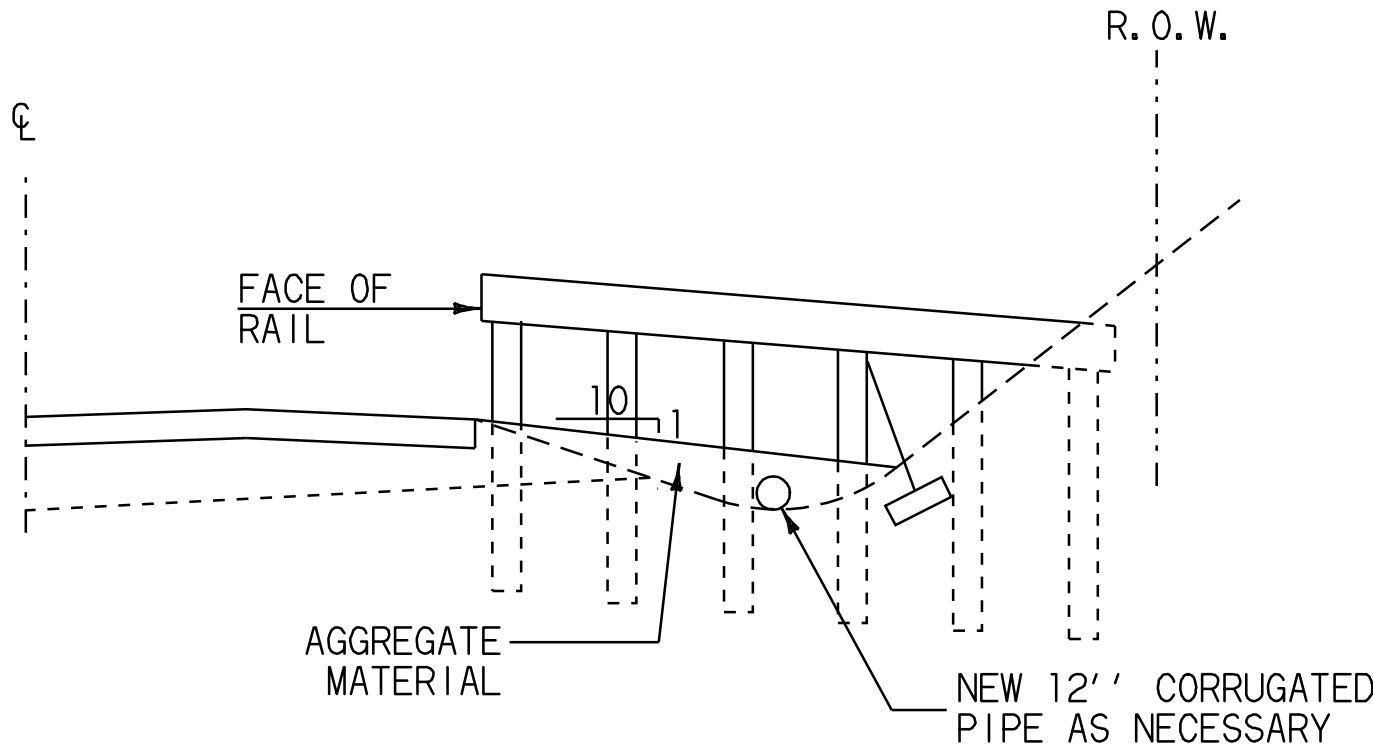


- 1. RAIL TO BE BURIED A DISTANCE OF 12'-6" INTO BACKSLOPE. IF THIS CANNOT BE OBTAINED, AN ANCHOR SHALL BE INSTALLED.

THIS WAS INTENDED FOR SB 22.52 OUT.
A MANUFACTURED TERMINAL SECTION, FLARED
WAS INSTALLED INSTEAD

SECTION B-B

THINNING AND TRIMMING FOR SIGNS DETAIL

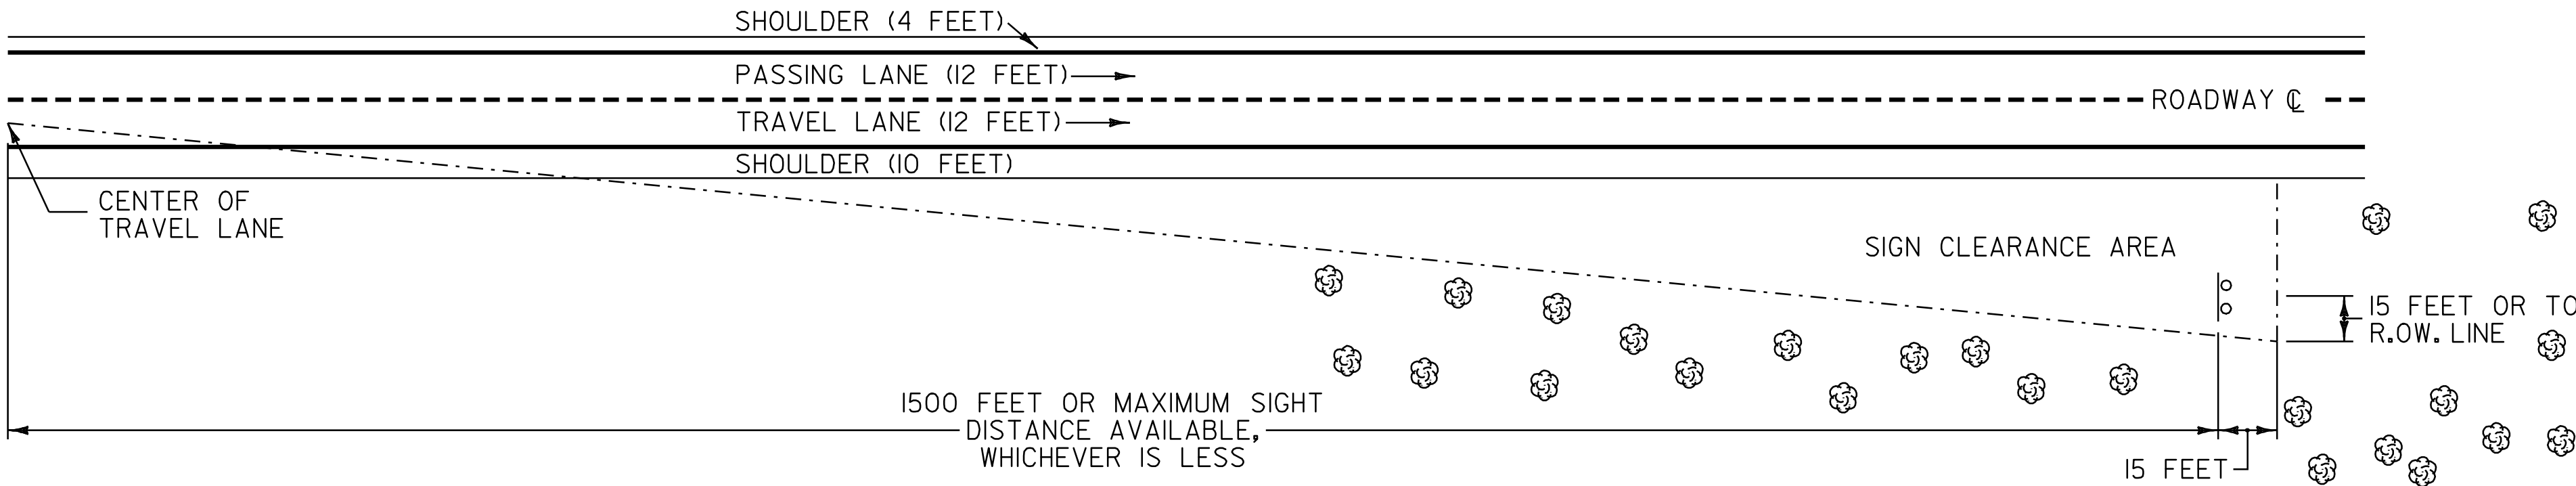

THE CONTRACTOR SHALL REMOVE ALL WOODY STEMMED GROWTH INCLUDING BRUSH, SAPLINGS AND TREE LIMBS GROWING WITHIN OR PROJECTING INTO THE CLEARANCE AREA DOWN TO GROUND LEVEL OR AT LEAST 10 FEET BELOW THE BOTTOM OF THE SIGN, WHICHEVER IS LESS. PAYMENT WILL BE FOR THINNING AND TRIMMING FOR SIGNS, ITEM 201.31, AND PAID FOR PER EACH SIGN. NO CHEMICALS (POISONS OR DEFOLIANTS) WILL BE ALLOWED.

SIGN LOCATION:
1229+39 LT:
SOUTHBOUND:
MM 23.29

NOT TO SCALE

PROJECT TYPICAL SHEET 3	
PROJECT NAME:	ROYALTON-BETHEL
PROJECT NUMBER:	IM 089-1(54)
FILE NAME:	p06a198.dgn
PROJECT LEADER:	PTS
DESIGNED BY:	NLL
IPARM FILE NAME:	p06a198p+3.1
PLOT DATE:	28-JUN-2010 15:12
DRAWN BY:	MRS
CHECKED BY:	PTS
SHEET	5 OF 37