

TEMPORARY 6" WHITE LINE, PAINT
DURABLE 6" WHITE LINE, RECESSED
924+00 TO 1167+99 SOLID RT
924+00 TO 1337+69 DASHED CL
1172+63 TO 1178+48 SOLID RT
1182+78 TO 1337+69 SOLID RT

TEMPORARY 6" YELLOW LINE, PAINT
DURABLE 6" YELLOW LINE, RECESSED
924+00 TO 1337+69 SOLID LT

CHAIN-LINK FENCE, 6'
BRACING ASSEMBLY FOR CHAIN-LINK FENCE, 6'
SNOW BARRIER, GALVANIZED
1210+71 LT - FROM ROW FENCE TO ROW
FENCE ALONG CONCRETE BOX CULVERT

SHOULDER BERM REMOVAL
922+04 TO 927+76 RT
953+51 TO 964+71 RT
972+10 TO 1024+40 RT
1041+12 TO 1045+87 RT
1063+55 TO 1064+13 RT
1076+96 TO 1079+01 RT
1096+11 TO 1099+96 RT
1102+34 TO 1103+18 RT
1113+31 TO 1117+06 RT
1136+74 TO 1144+50 RT
1146+88 TO 1151+36 RT
1204+34 TO 1207+88 RT
1241+97 TO 1248+14 RT
1270+88 TO 1273+16 RT
1277+80 TO 1278+69 RT
1309+78 TO 1328+56 RT

CHANGING ELEVATION OF DROP INLETS,
CATCH BASINS, OR MANHOLES
937+79 RT

DELINEATORS
REFER TO STANDARDS E-197,
E-198 AND E-199 FOR
PLACEMENT GUIDELINES

REMOVAL AND DISPOSAL OF GUARDRAIL
1204+34.0 TO 1204+71.5 RT
1270+88.0 TO 1271+25.5 RT
1309+78.0 TO 1310+15.5 RT

MANUFACTURED TERMINAL SECTION, FLARED
DELINEATOR WITH STEEL POST
1204+34.0 RT
1270+88.0 RT
1309+78.0 RT


REHAB. DROP INLETS, CATCH BASINS,
OR MANHOLES, CLASS I, CLASS II OR CLASS III
931+88 RT 1081+28 RT
933+88 RT 1083+45 RT
940+21 RT 1117+11 RT
942+85 RT 1119+07 RT
944+80 RT 1121+60 RT
946+81 RT 1153+74 RT
948+81 RT 1156+27 RT
968+09 RT 1157+69 RT
970+10 RT 1167+72 RT
972+05 RT 1207+93 RT
1026+72 RT 1214+74 RT
1029+20 RT 1217+22 RT
1031+15 RT 1219+75 RT
1032+79 RT 1222+23 RT
1046+19 RT 1224+71 RT
1048+09 RT 1227+19 RT
1050+46 RT 1229+83 RT
1053+42 RT 1232+31 RT
1055+79 RT 1234+84 RT
1060+65 RT 1237+38 RT
1273+21 RT

TRAFFIC SIGNS, TYPE A
950+40 RT MM PLAQUE (18)
1003+20 RT MM PLAQUE (19)
1077+11 LT NO U-TURN
1108+80 RT MM PLAQUE (21)
1152+13 LT NO U-TURN
1208+30 LT NO U-TURN
1214+40 RT MM PLAQUE (23)
1267+20 RT MM PLAQUE (24)
1320+00 RT MM PLAQUE (25)
1336+00 LT NO U-TURN

REMOVING SIGNS
950+40 RT MM PLAQUE (18)
1003+20 RT MM PLAQUE (19)
1077+11 LT NO U-TURN
1108+80 RT MM PLAQUE (21)
1152+13 LT NO U-TURN
1208+30 LT NO U-TURN
1214+40 RT MM PLAQUE (23)
1267+20 RT MM PLAQUE (24)
1320+00 RT MM PLAQUE (25)
1336+00 LT NO U-TURN

INTERSTATE ROUTE 89 NB
924+00
(MM 17.500)
BEGIN PROJECT
IM 089-1(54)

INTERSTATE ROUTE 89 NB
1337+69
(MM 25.335)
LIMIT OF WORK
IM 089-1(54)

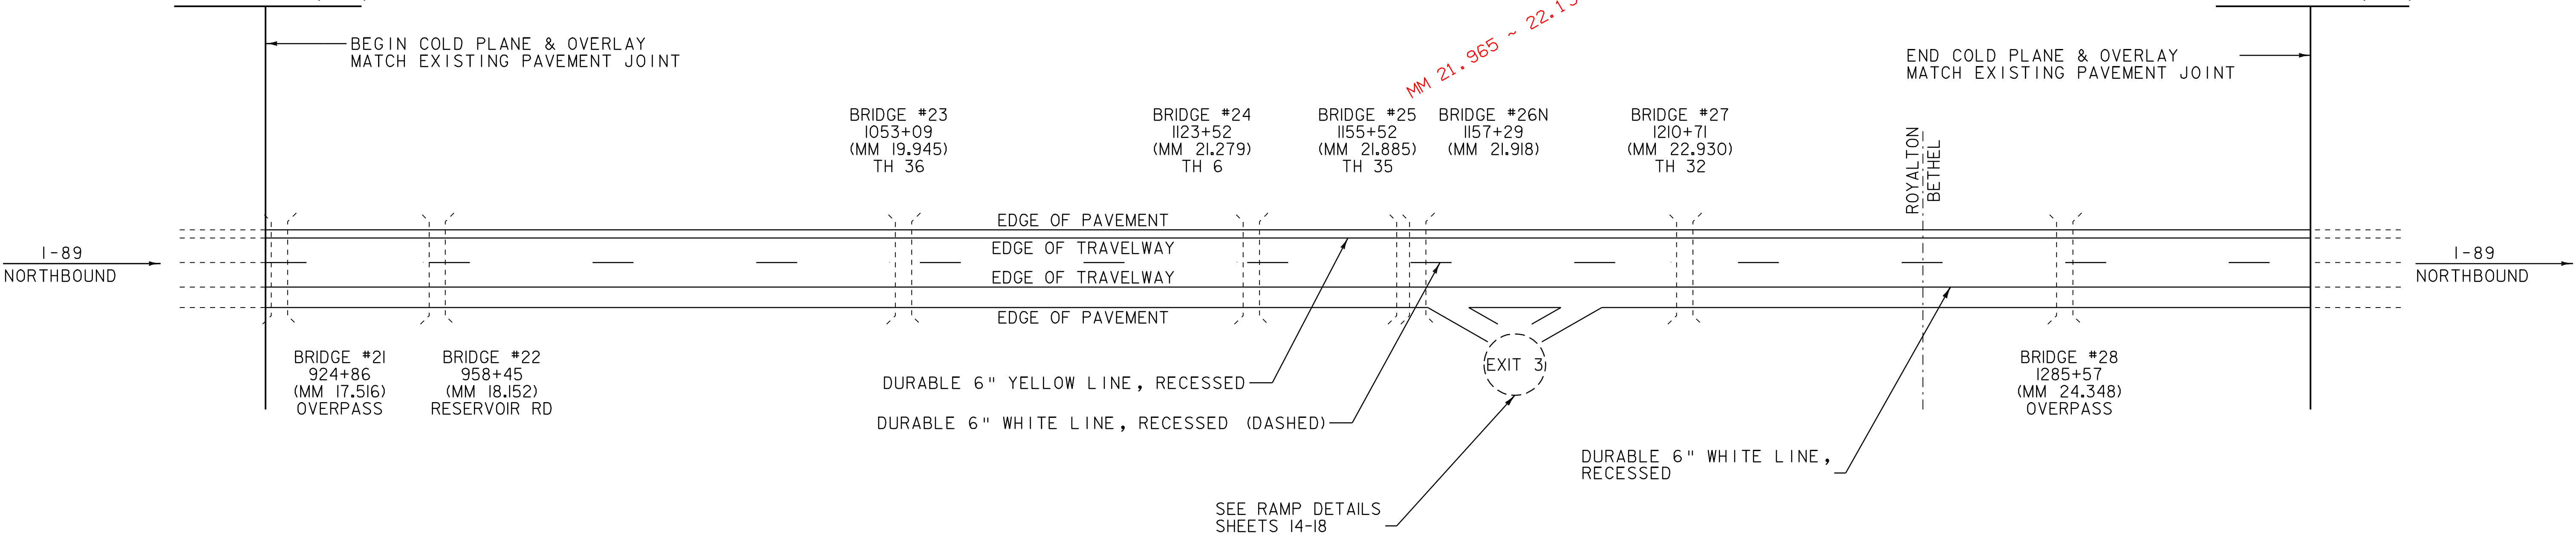

SEE PROJECT PAVING LIMITS TABLE ON
SHEET 3 FOR ROADWAY DIMENSIONS.

NOT TO SCALE

PAVING LAYOUT I			
PROJECT NAME: ROYALTON-BETHEL			
PROJECT NUMBER: IM 089-1(54)			
FILE NAME: p06a198.dgn		PLOT DATE: 28-JUN-2010 15:12	
PROJECT LEADER: PTS		DRAWN BY: MRS	
DESIGNED BY: NULL		CHECKED BY: PTS	
IPARM FILE NAME: p06a198p11.t		SHEET 12 OF 37	