

TEMPORARY 6" WHITE LINE, PAINT
DURABLE 6" WHITE LINE, RECESSED

924+00 TO 1173+23 SOLID LT
924+00 TO 1341+38 DASHED CL
1174+53 TO 1181+39 SOLID LT
1183+52 TO 1341+38 SOLID LT

TEMPORARY 6" YELLOW LINE, PAINT
DURABLE 6" YELLOW LINE, RECESSED

924+00 TO 1341+38 SOLID RT

CHAIN-LINK FENCE, 6'
BRACING ASSEMBLY FOR CHAIN-LINK FENCE, 6'
SNOW BARRIER, GALVANIZED

1210+71 LT - FROM ROW FENCE TO ROW
FENCE ALONG CONCRETE BOX CULVERT

SHOULDER BERM REMOVAL

923+99	TO	928+05	LT
936+54	TO	936+97	LT
947+75	TO	950+16	LT
957+55	TO	965+04	LT
968+52	TO	969+00	LT
973+32	TO	977+02	LT
974+28	TO	1022+99	RT
1022+67	TO	1049+68	LT
1051+95	TO	1065+46	LT
1062+26	TO	1066+15	RT
1079+92	TO	1080+82	LT
1088+47	TO	1091+90	LT
1103+72	TO	1109+57	LT
1115+43	TO	1116+22	LT
1123+29	TO	1131+74	LT
1152+51	TO	1157+80	LT
1207+35	TO	1217+38	LT
1244+29	TO	1276+00	RT
1264+55	TO	1267+24	LT
1313+94	TO	1318+80	LT
1324+39	TO	1325+04	LT
1330+73	TO	1333+15	LT

REHAB. DROP INLETS, CATCH BASINS,
OR MANHOLES, CLASS I, CLASS II OR CLASS III

938+50	LT	1118+33	LT
940+87	LT	1120+81	LT
943+53	LT	1123+29	LT
945+43	LT	1159+34	LT
970+90	LT	1183+87	LT
1080+82	LT	1325+03	LT
1088+35	LT	1327+56	LT

STONE FILL, TYPE I

1033+02	RT	(PAVE 6' x30')
1034+31	RT	(PAVE 6' x30')
1038+21	RT	(PAVE 6' x30')

DELINEATORS

REFER TO STANDARDS E-197,
E-198 AND E-199 FOR
PLACEMENT GUIDELINES

REMOVAL AND DISPOSAL OF GUARDRAIL

1217+00.5	TO	1217+38.0	LT
1266+86.5	TO	1267+24.0	LT
1275+62.5	TO	1276+00.0	RT
1318+42.5	TO	1318+80.0	LT
1332+77.5	TO	1333+15.0	LT

MANUFACTURED TERMINAL SECTION, FLARED
DELINEATOR WITH STEEL POST

1217+38.0	LT
1267+24.0	LT
1276+00.0	RT
1318+80.0	LT
1333+15.0	LT

TRAFFIC SIGNS, TYPE A


950+40	LT	MM	PLAQUE	(18)
1003+20	LT	MM	PLAQUE	(19)
1056+00	LT	MM	PLAQUE	(20)
1077+85	RT	NO	U-TURN	
1108+80	LT	MM	PLAQUE	(21)
1152+75	RT	NO	U-TURN	
1209+14	RT	NO	U-TURN	
1214+40	LT	MM	PLAQUE	(23)
1267+20	LT	MM	PLAQUE	(24)
1320+00	LT	MM	PLAQUE	(25)
1336+82	RT	NO	U-TURN	

REMOVING SIGNS

950+40	LT	MM	PLAQUE	(18)
1003+20	LT	MM	PLAQUE	(19)
1056+00	LT	MM	PLAQUE	(20)
1077+85	RT	NO	U-TURN	
1108+80	LT	MM	PLAQUE	(21)
1152+75	RT	NO	U-TURN	
1209+14	RT	NO	U-TURN	
1214+40	LT	MM	PLAQUE	(23)
1267+20	LT	MM	PLAQUE	(24)
1320+00	LT	MM	PLAQUE	(25)
1336+82	RT	NO	U-TURN	

INTERSTATE ROUTE 89 SB
924 + 00
(MM 17.500)
BEGIN PROJECT
IM 089-1(54)

INTERSTATE ROUTE I-89 SB
1341 + 38
(MM 25.405)
END PROJECT
IM 089-1(54)

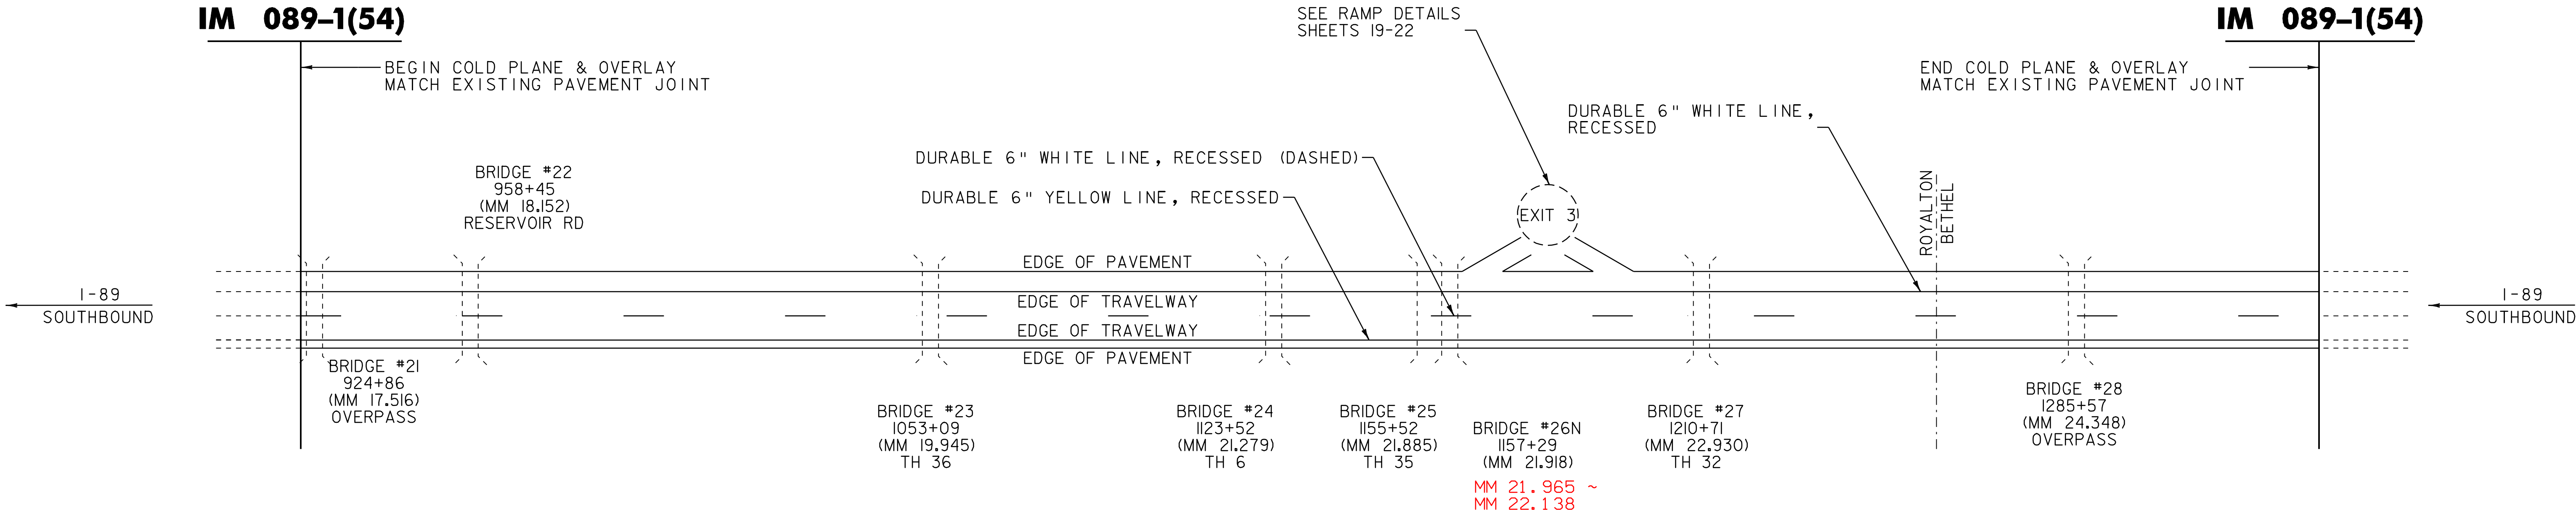

SEE PROJECT PAVING LIMITS TABLE ON
SHEET 3 FOR ROADWAY DIMENSIONS.

PAVING LAYOUT 2

PROJECT NAME: ROYALTON-BETHEL	
PROJECT NUMBER: IM 089-1(54)	
FILE NAME: p06a198.dgn	PLOT DATE: 28-JUN-2010 15:12
PROJECT LEADER: PTS	DRAWN BY: MRS
DESIGNED BY: NULL	CHECKED BY: PTS
IPARM FILE NAME: p06a198pl2.1	SHEET 13 OF 37

NOT TO SCALE