

EXIT 3 – RAMP A
NORTHBOUND ON RAMP


SEE STANDARDS E-191, E-192 AND E-193
FOR PAVEMENT MARKING GUIDELINES

TEMPORARY 6" WHITE LINE, PAINT
DURABLE 6" WHITE LINE, RECESSED

1183+50 TO 1188+88 DASHED RT 720' DASH

DELINEATORS

REFER TO STANDARDS E-197 AND
E-198 FOR PLACEMENT GUIDELINES

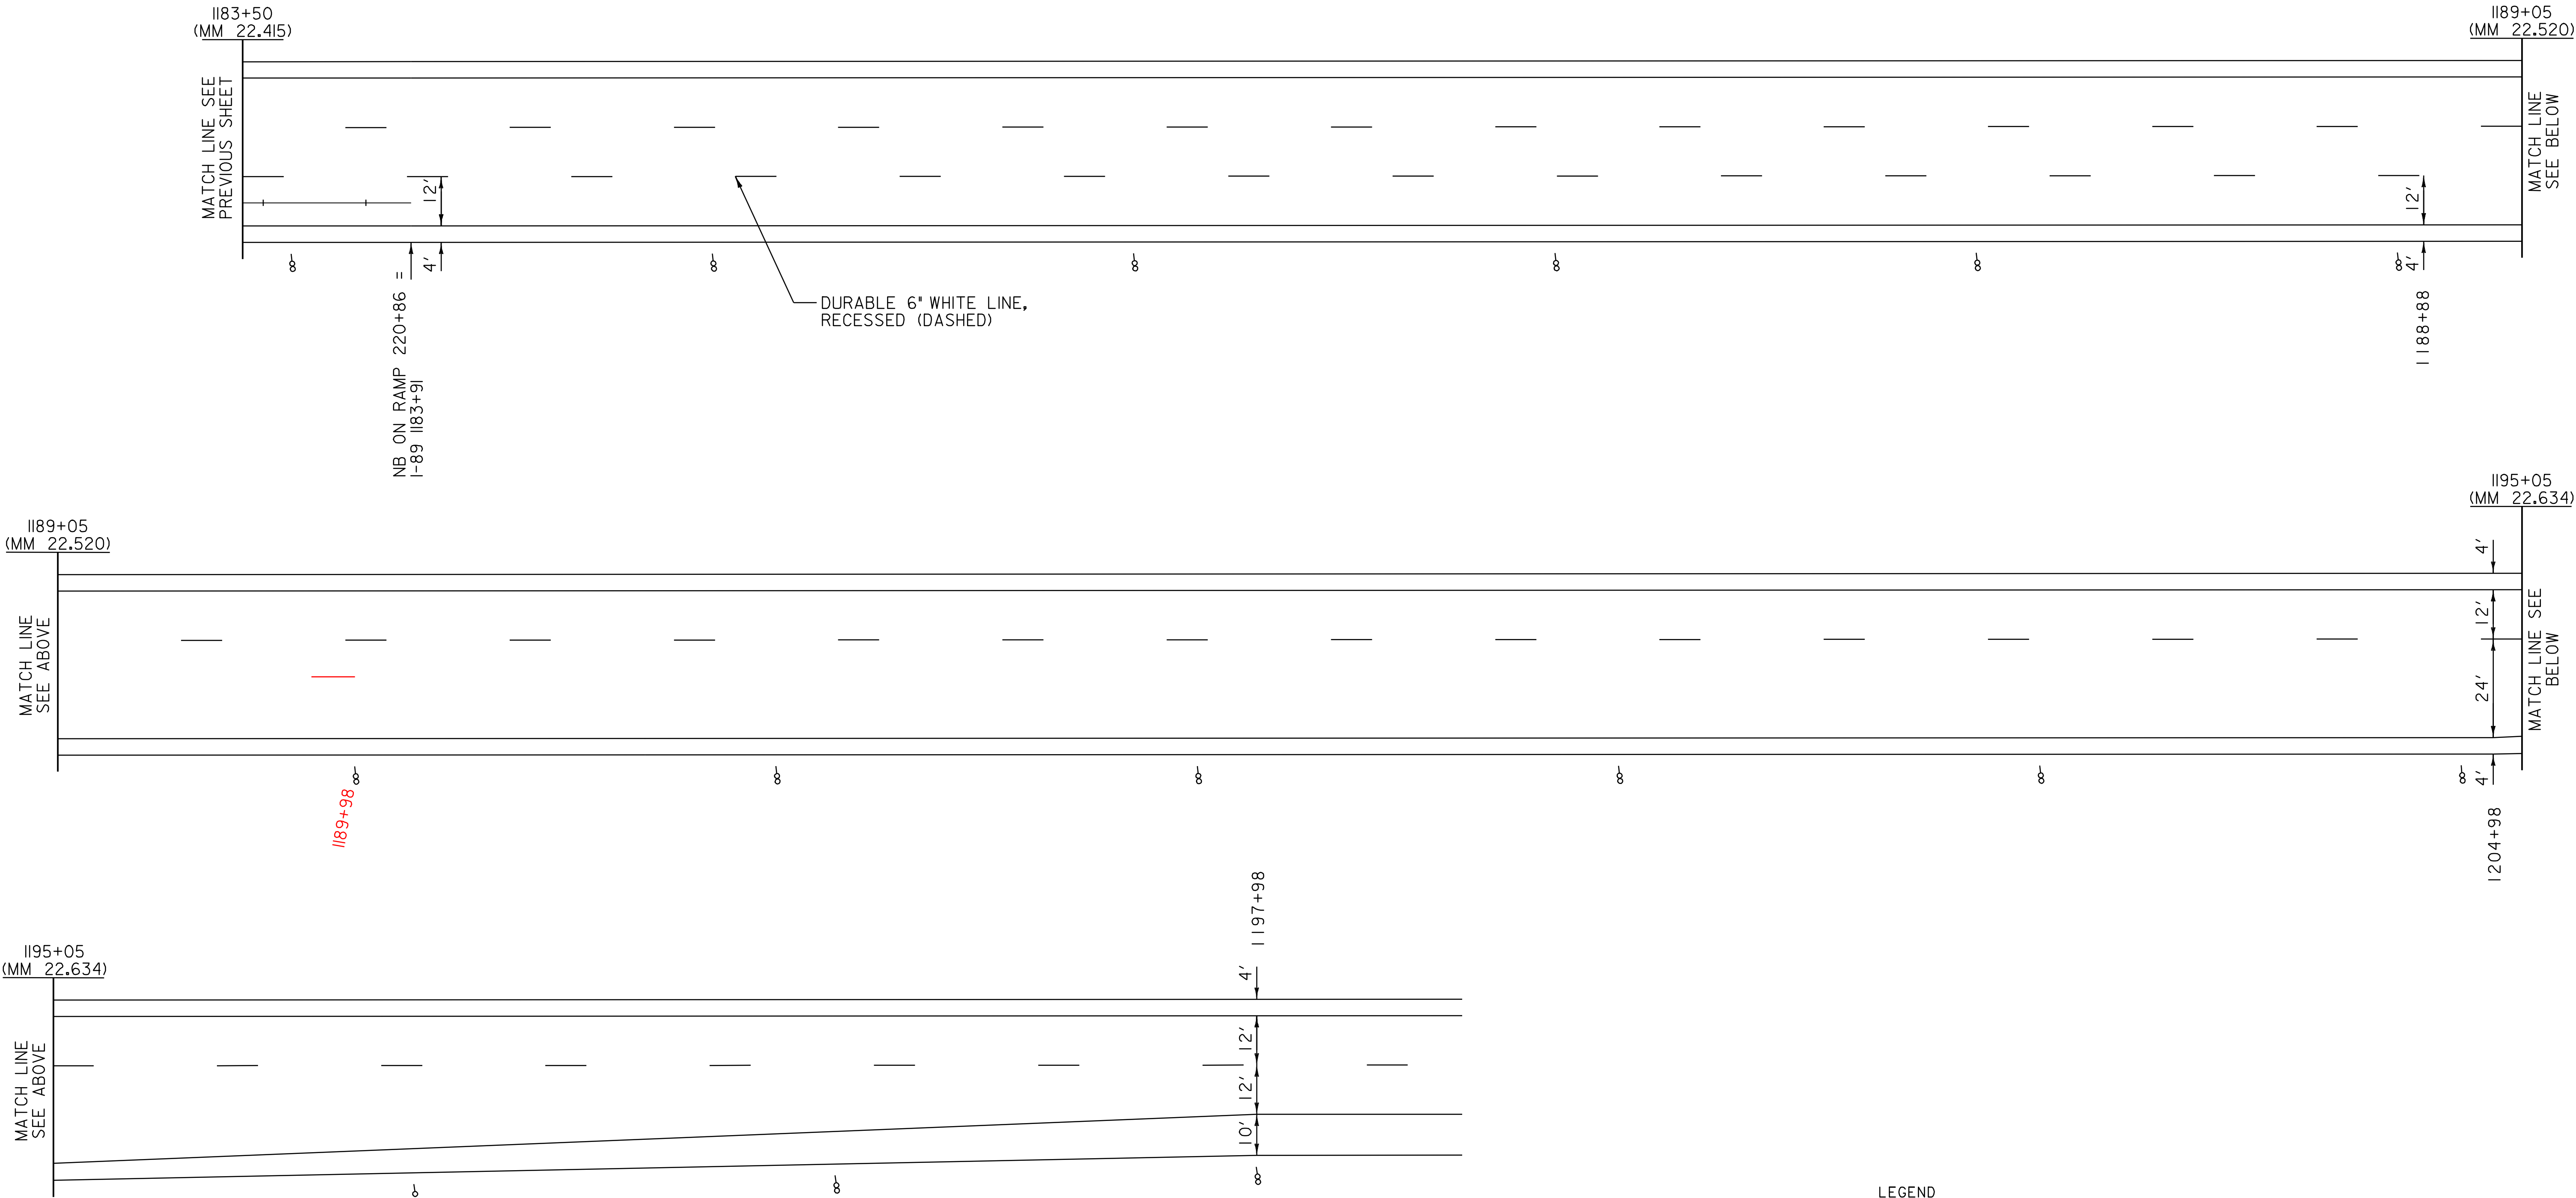

LEGEND		
R	=	REMOVE EXISTING
S	=	SALVAGE
R&S	=	REMOVE AND SALVAGE
N	=	NEW
RET	=	RETAIN
B-B	=	BACK TO BACK
---	=	EXISTING GUARDRAIL
---	=	PROPOSED GUARDRAIL
○	=	TYPE I DELINEATOR, WHITE
●	=	TYPE I DELINEATOR, AMBER
○	=	TYPE II DELINEATOR, WHITE
●	=	TYPE III DELINEATOR, RIGHT
●	=	TYPE III DELINEATOR, LEFT

RAMP DETAIL #5

PROJECT NAME: ROYALTON-BETHEL
PROJECT NUMBER: IM 089-1(54)

FILE NAME: p06a198.dgn
PROJECT LEADER: PTS
DESIGNED BY: NLL
IPARM FILE NAME: p06a198rd5.1
PLOT DATE: 28-JUN-2010 15:12
DRAWN BY: MRS
CHECKED BY: PTS
SHEET 18 OF 37

NOT TO SCALE