




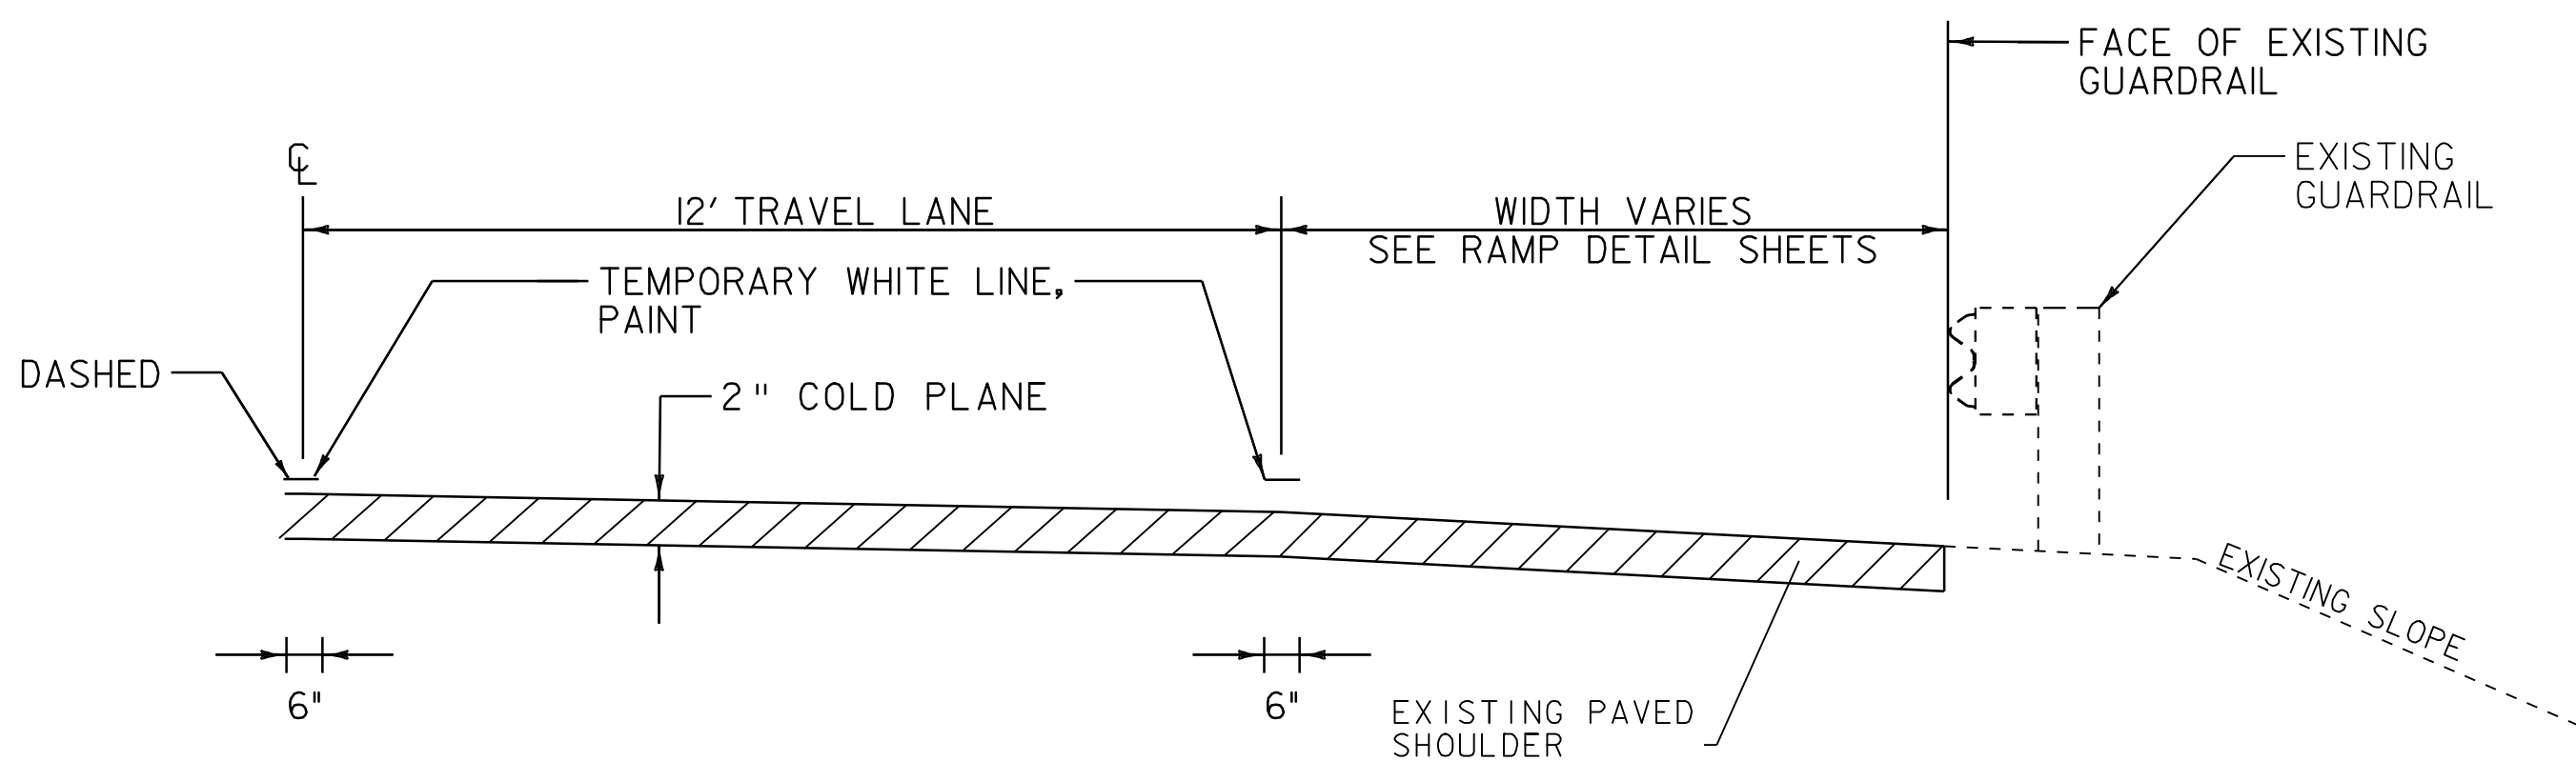


PHASE I

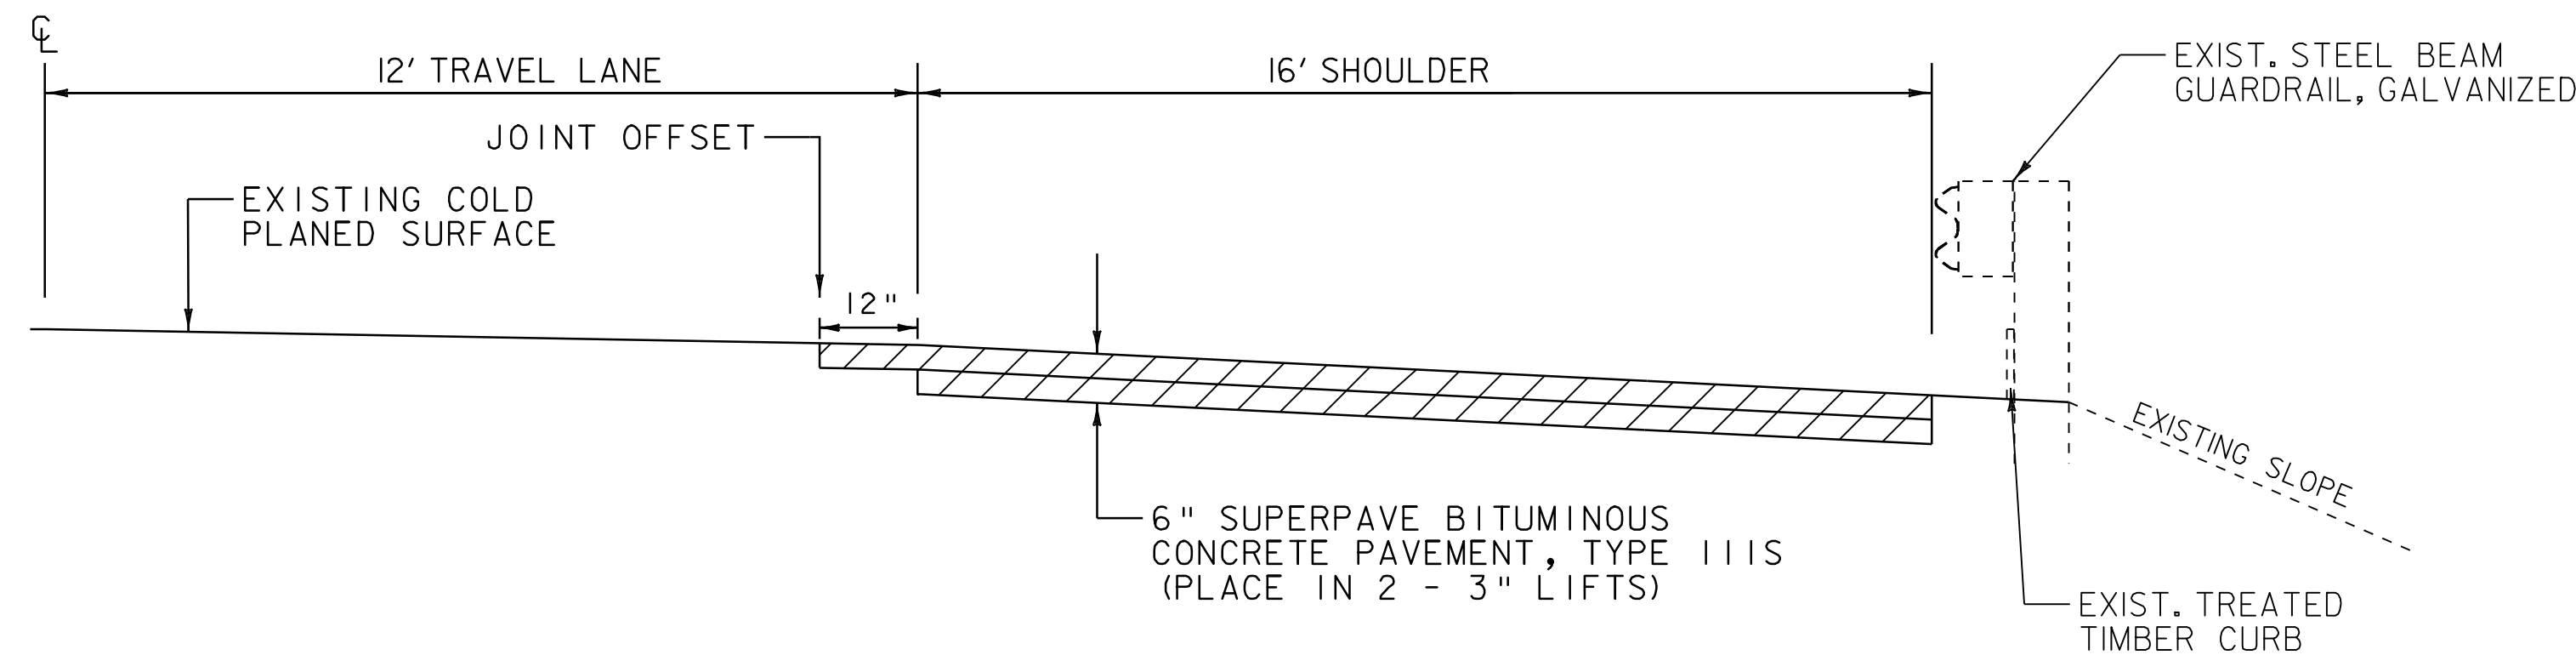

PHASE III

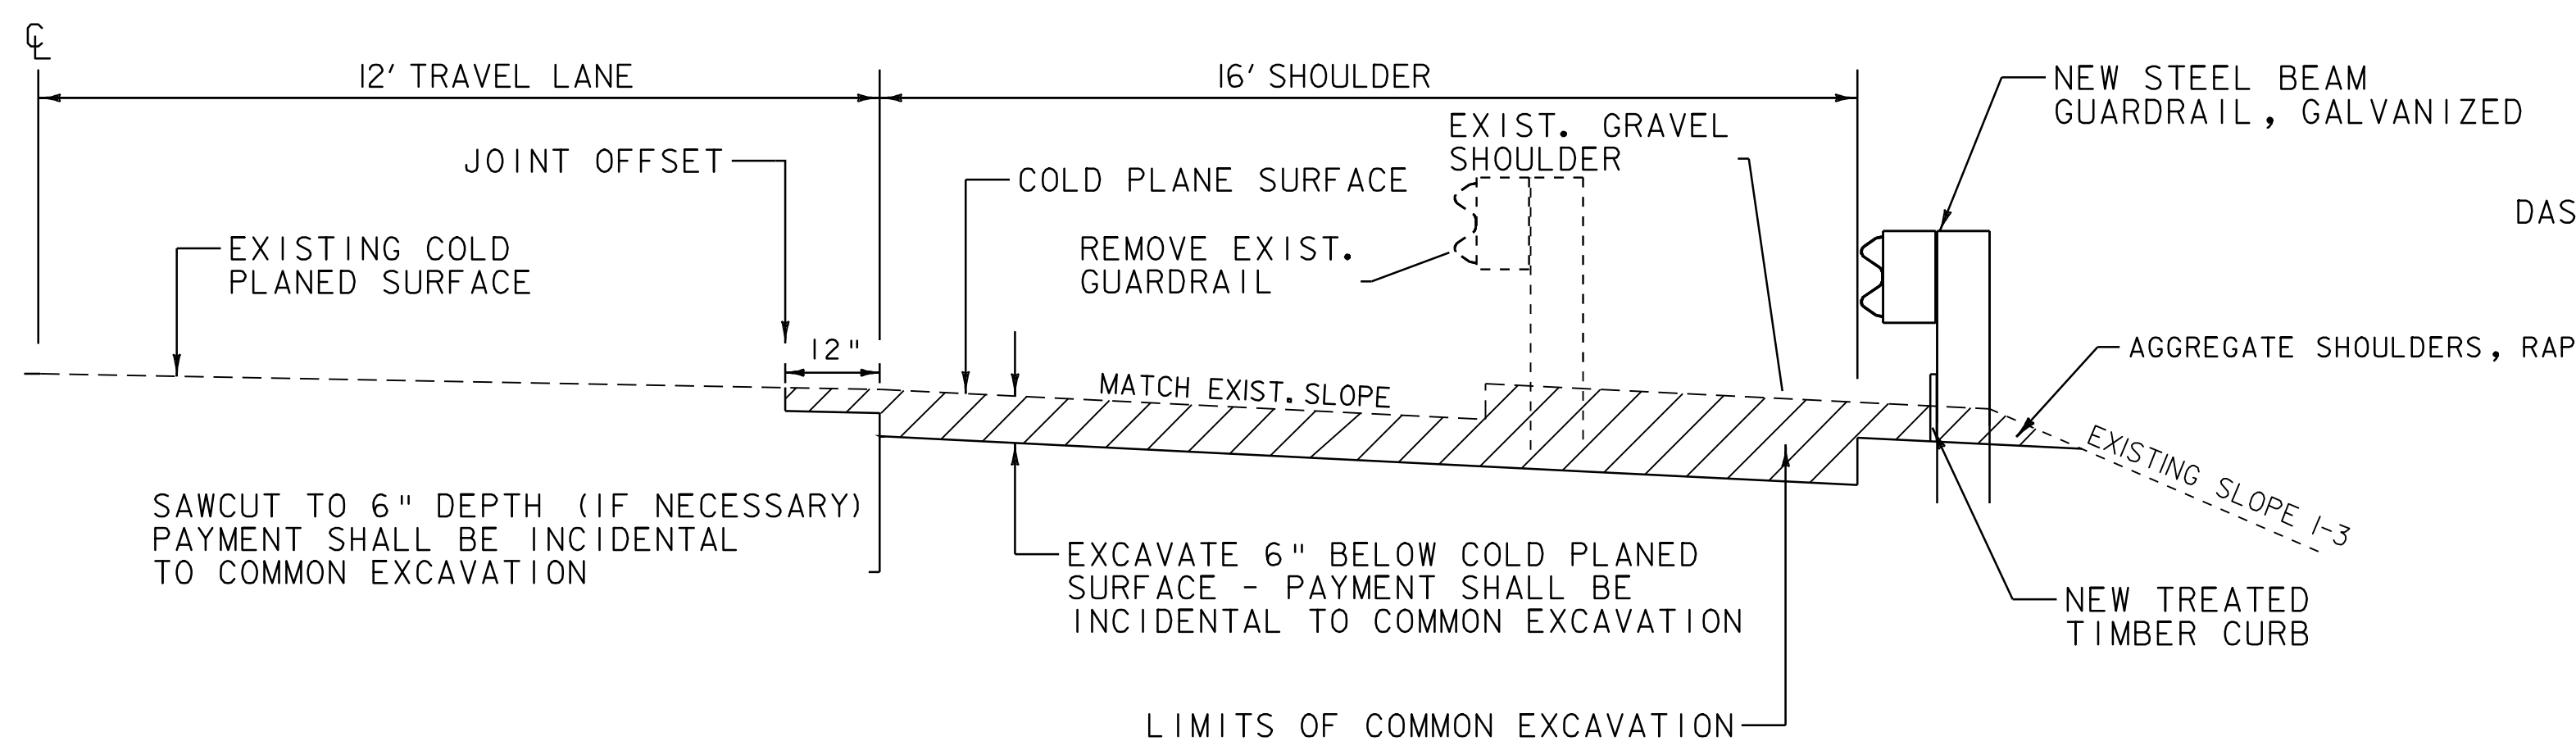

PHASE II

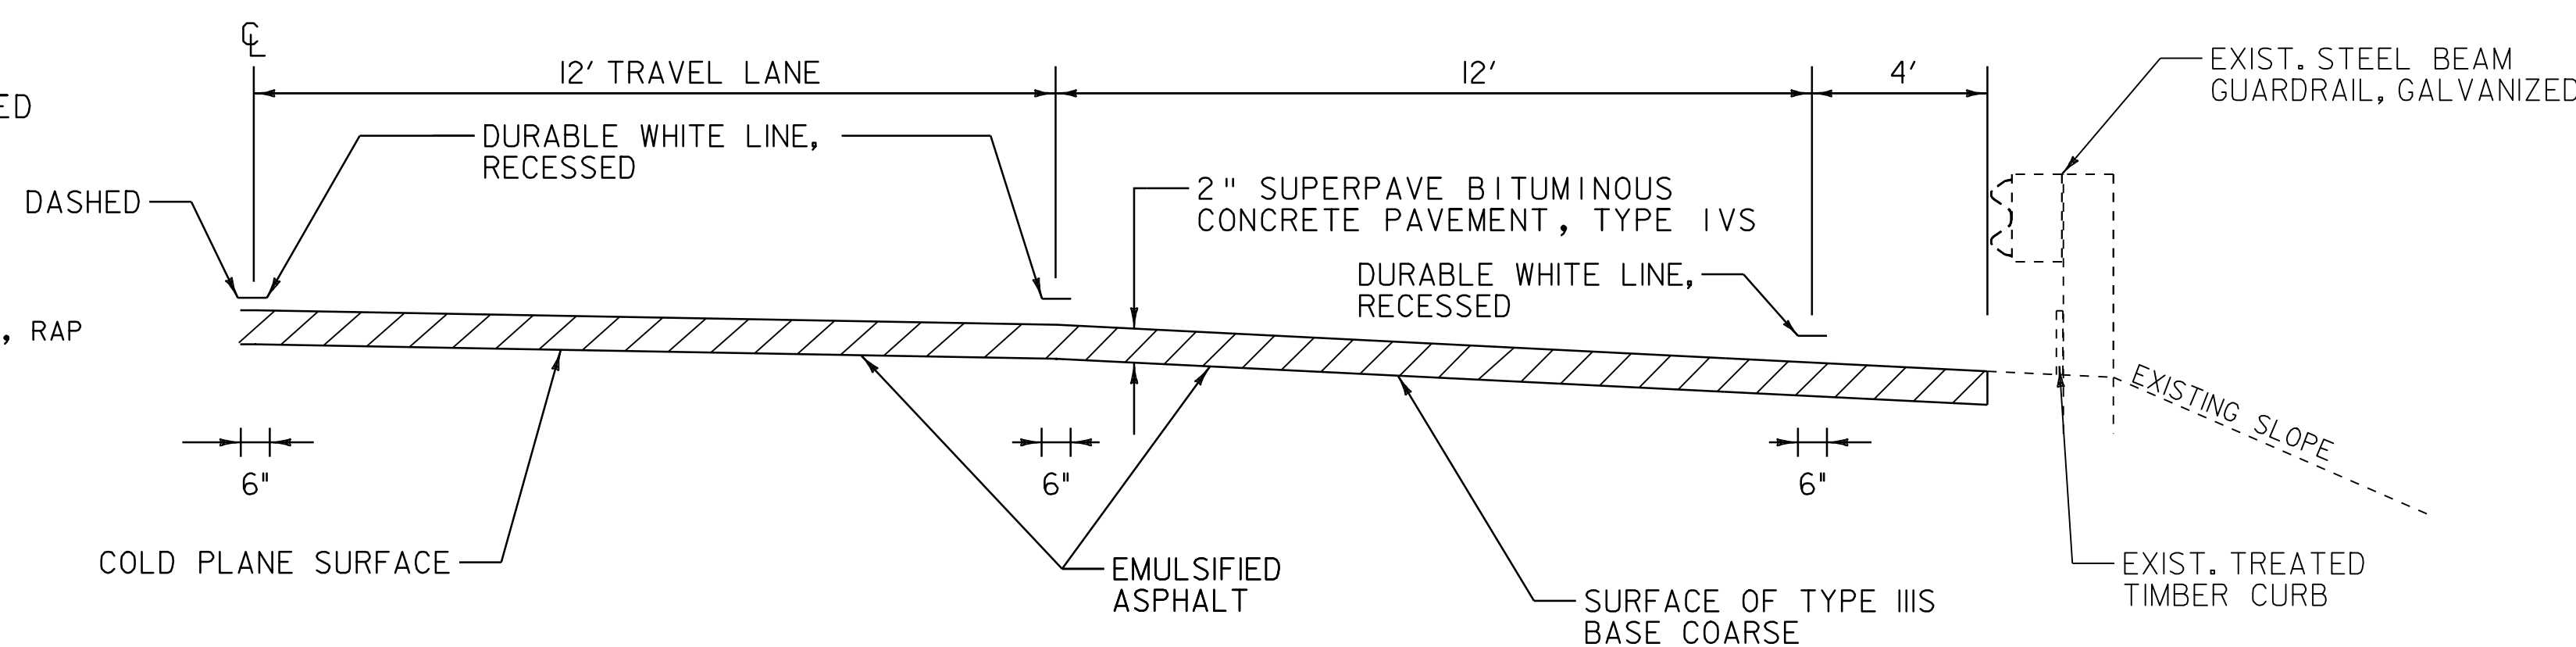

PHASE IV

NOTE:

- I. THE CONTRACTOR SHALL NOT LEAVE THE UNPROTECTED 6" DROP OFF EXPOSED TO VEHICULAR TRAFFIC. THE CONTRACTOR SHALL EXCAVATE TO A 6" DEPTH AND OVERLAY WITH 6" OF SUPERPAVE BITUMINOUS CONCRETE PAVEMENT, TYPE IIIS IN THE SAME WORKDAY, UNLESS OTHERWISE DIRECTED BY THE RESIDENT ENGINEER.

NOT TO SCALE

STA 1185+70 TO 1190+00
DECEL LANE WIDENING DETAILS

PROJECT NAME:	ROYALTON-BETHEL
PROJECT NUMBER:	IM 089-1(54)
FILE NAME:	p06a198.dgn
PROJECT LEADER:	PTS
DESIGNED BY:	NLL
IPARM FILE NAME:	p06a198d1wd.1
PLOT DATE:	28-JUN-2010 15:12
DRAWN BY:	MRS
CHECKED BY:	PTS
SHEET	30 OF 37