

604.412, 604.415 OR 604.418 REHAB. DIS, CBS OR MHS, CLASS I, II OR III
STA. 13+75, LT

646.426 DURABLE 6 INCH WHITE LINE, RECESSED POLYUREA
STA. 12+50 TO 14+79, SOLID C



646.436 DURABLE 6 INCH YELLOW LINE, RECESSED POLYUREA
STA. 12+50 TO 14+79, SOLID LT

646.466 DURABLE 12 INCH WHITE LINE, RECESSED POLYUREA
RAMP B CORE - TO BE INSTALLED PER
THE LATEST EDITION OF THE MUTCD

646.622 TEMPORARY 6 INCH WHITE LINE, PAINT
STA. 12+50 TO 14+79, SOLID C

646.632 TEMPORARY 6 INCH YELLOW LINE, PAINT
STA. 12+50 TO 14+79, SOLID LT

646.662 TEMPORARY 12 INCH WHITE LINE, PAINT
RAMP B CORE - TO BE INSTALLED PER
THE LATEST EDITION OF THE MUTCD

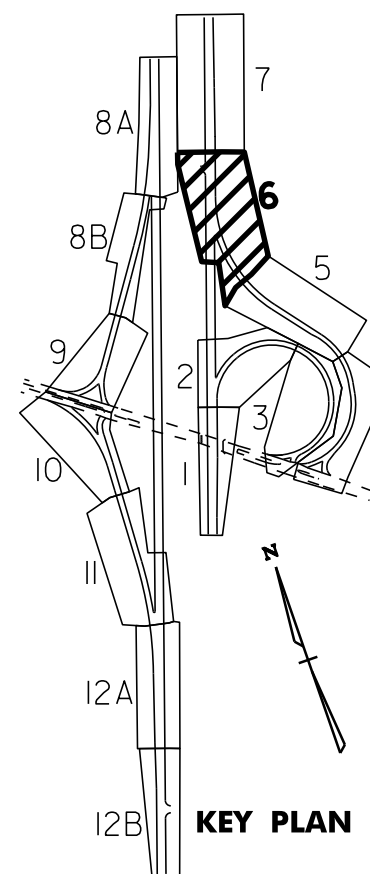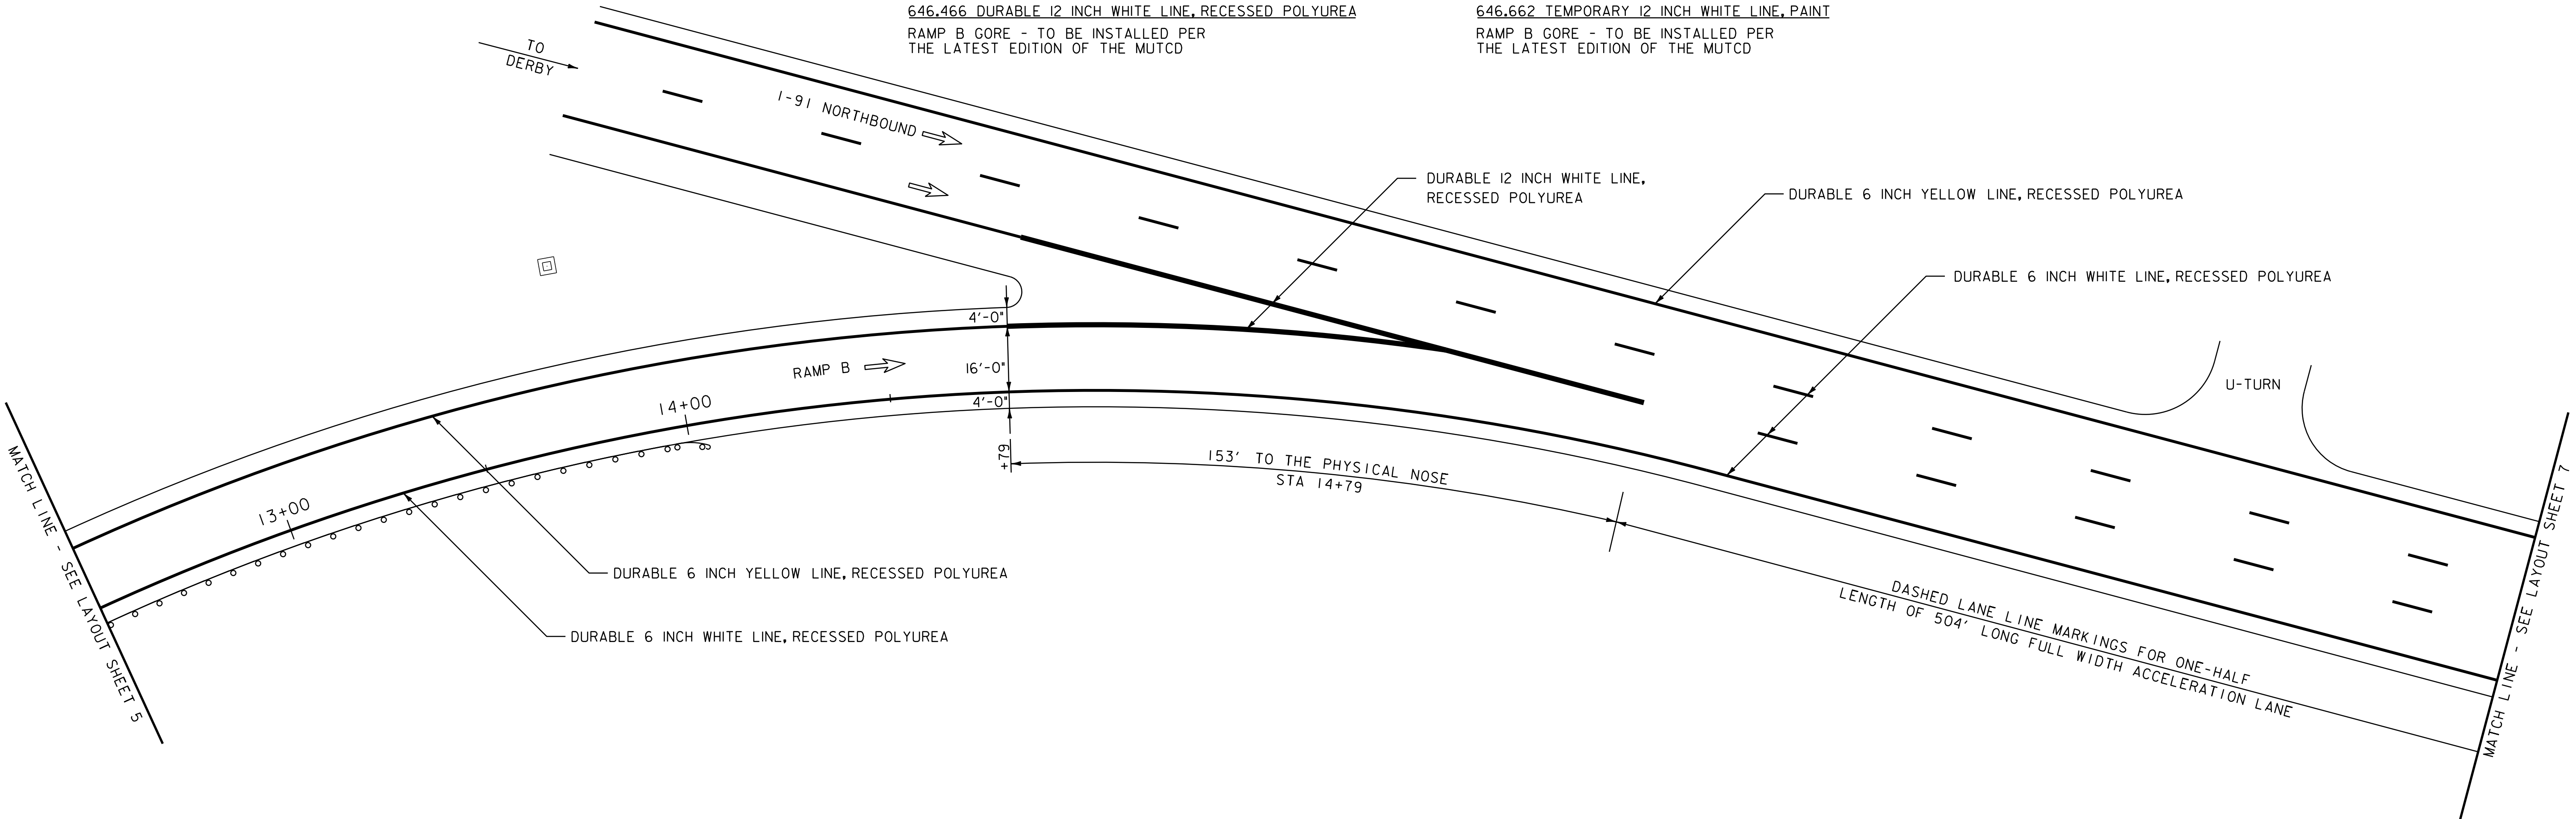

NOTES: 1. FOR STRIPING DETAILS AT GORES,
SEE THE PAVEMENT MARKINGS
DETAIL SHEET AND THE LATEST
EDITION OF THE MUTCD.

2. DIRECTION OF TRAVEL ARROW



NOT TO SCALE

**INTERCHANGE
27 LAYOUT
SHEET #6**

PROJECT NAME: DERBY
PROJECT NUMBER: IM 091-3(46)

FILE NAME: p06a200.dgn
PROJECT LEADER: JLL
DESIGNED BY: STANTEC
IPARM FILE: p06a200i06

PLOT DATE: 07-SEP-2011 10:24
DRAWN BY: STANTEC
CHECKED BY: JLL
SHEET 26 OF 63