

646.426 DURABLE 6 INCH WHITE LINE, RECESSED POLYUREA
RAMP A STA. 7+50 TO I2+25, SOLID RT
RAMP A STA. 7+50 TO I2+25, SOLID LT

646.436 DURABLE 6 INCH YELLOW LINE, RECESSED POLYUREA
RAMP A STA. 7+50 TO I2+25, DOUBLE SOLID C



646.492 DURABLE LETTER OR SYMBOL, THERMOPLASTIC
RAMP A STA. 9+II, RT - "STOP"
RAMP A STA. 9+5I, RT - "AHEAD"

646.622 TEMPORARY 6 INCH WHITE LINE, PAINT
RAMP A STA. 7+50 TO I2+25, SOLID RT
RAMP A STA. 7+50 TO I2+25, SOLID LT

646.632 TEMPORARY 6 INCH YELLOW LINE, PAINT
RAMP A STA. 7+50 TO I2+25, DOUBLE SOLID C

646.692 TEMPORARY LETTER OR SYMBOL, PAINT
RAMP A STA. 9+II, RT - "STOP"
RAMP A STA. 9+5I, RT - "AHEAD"

675.50 REMOVING SIGNS
AS SHOWN - I

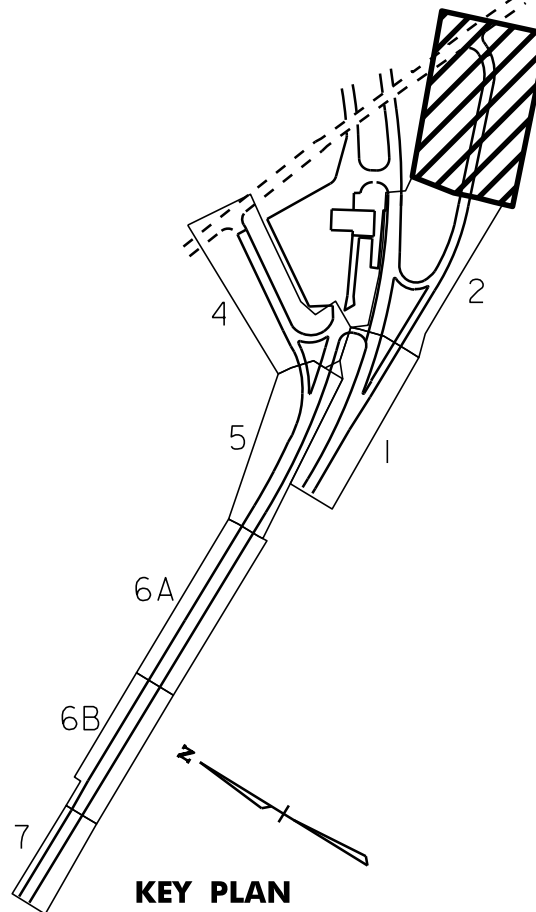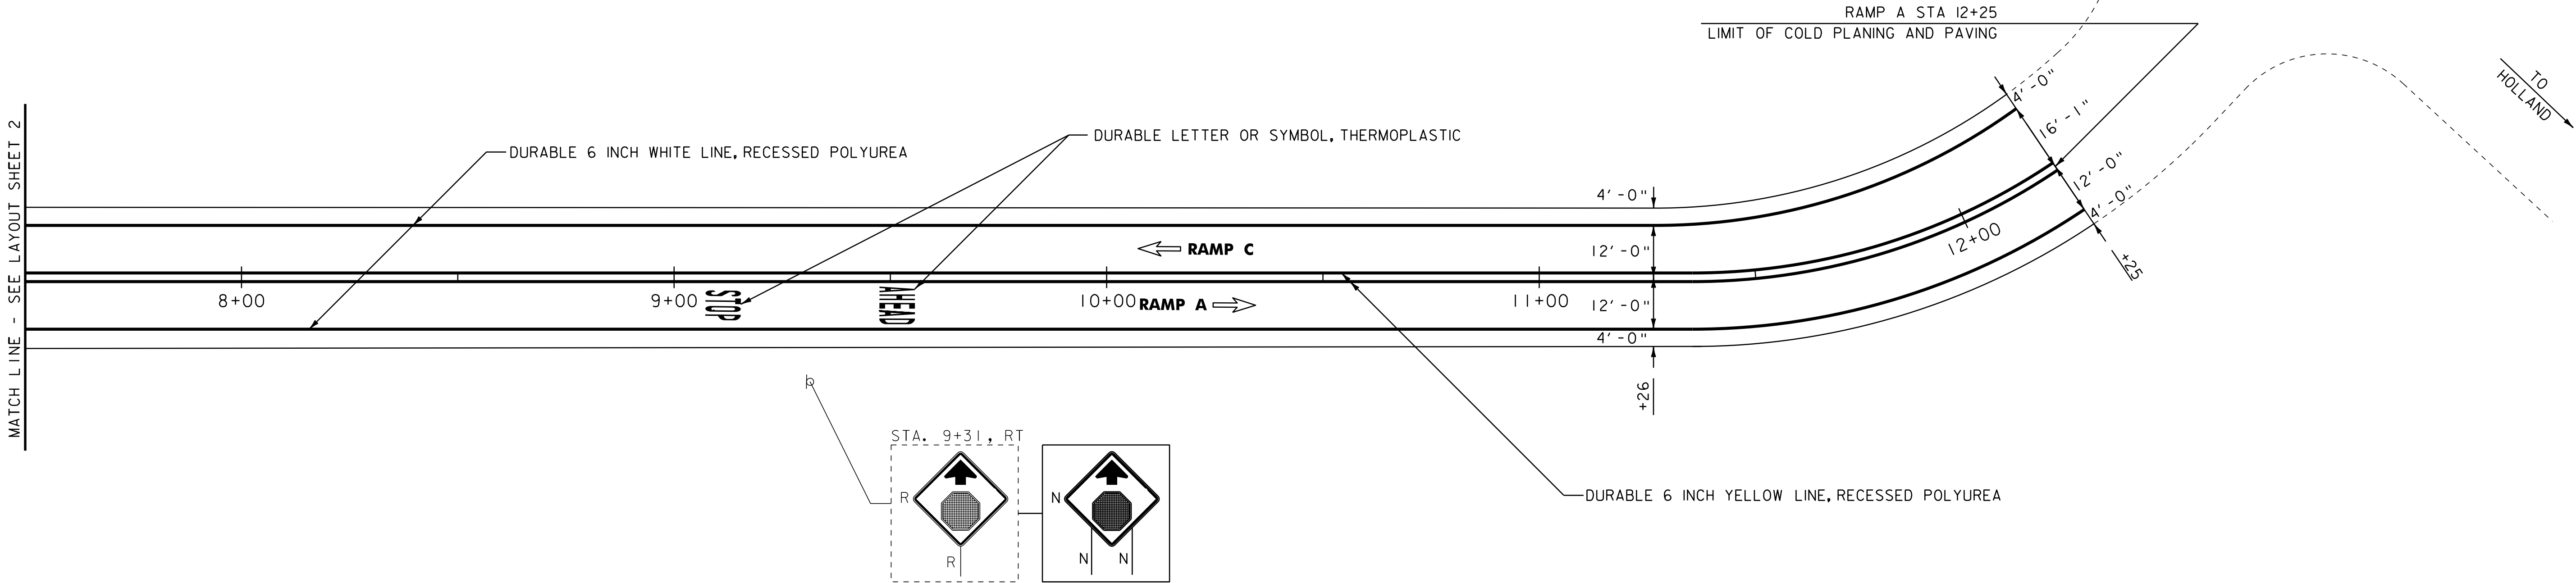

NOTES: 1. FOR STRIPING DETAILS AT GORES,
SEE THE PAVEMENT MARKINGS
DETAIL SHEET AND THE LATEST
EDITION OF THE MUTCD.

2. DIRECTION OF TRAVEL ARROW ➡



NOT TO SCALE

INTERCHANGE 29 LAYOUT SHEET #3

PROJECT NAME: DERBY
PROJECT NUMBER: IM 09I-3(46)

FILE NAME: p06a200.dgn
PROJECT LEADER: JLL
DESIGNED BY: STANTEC
IPARM FILE: p06a200I03.i

PLOT DATE: 07-SEP-20II 10:27
DRAWN BY: STANTEC
CHECKED BY: JLL
SHEET 44 OF 63