



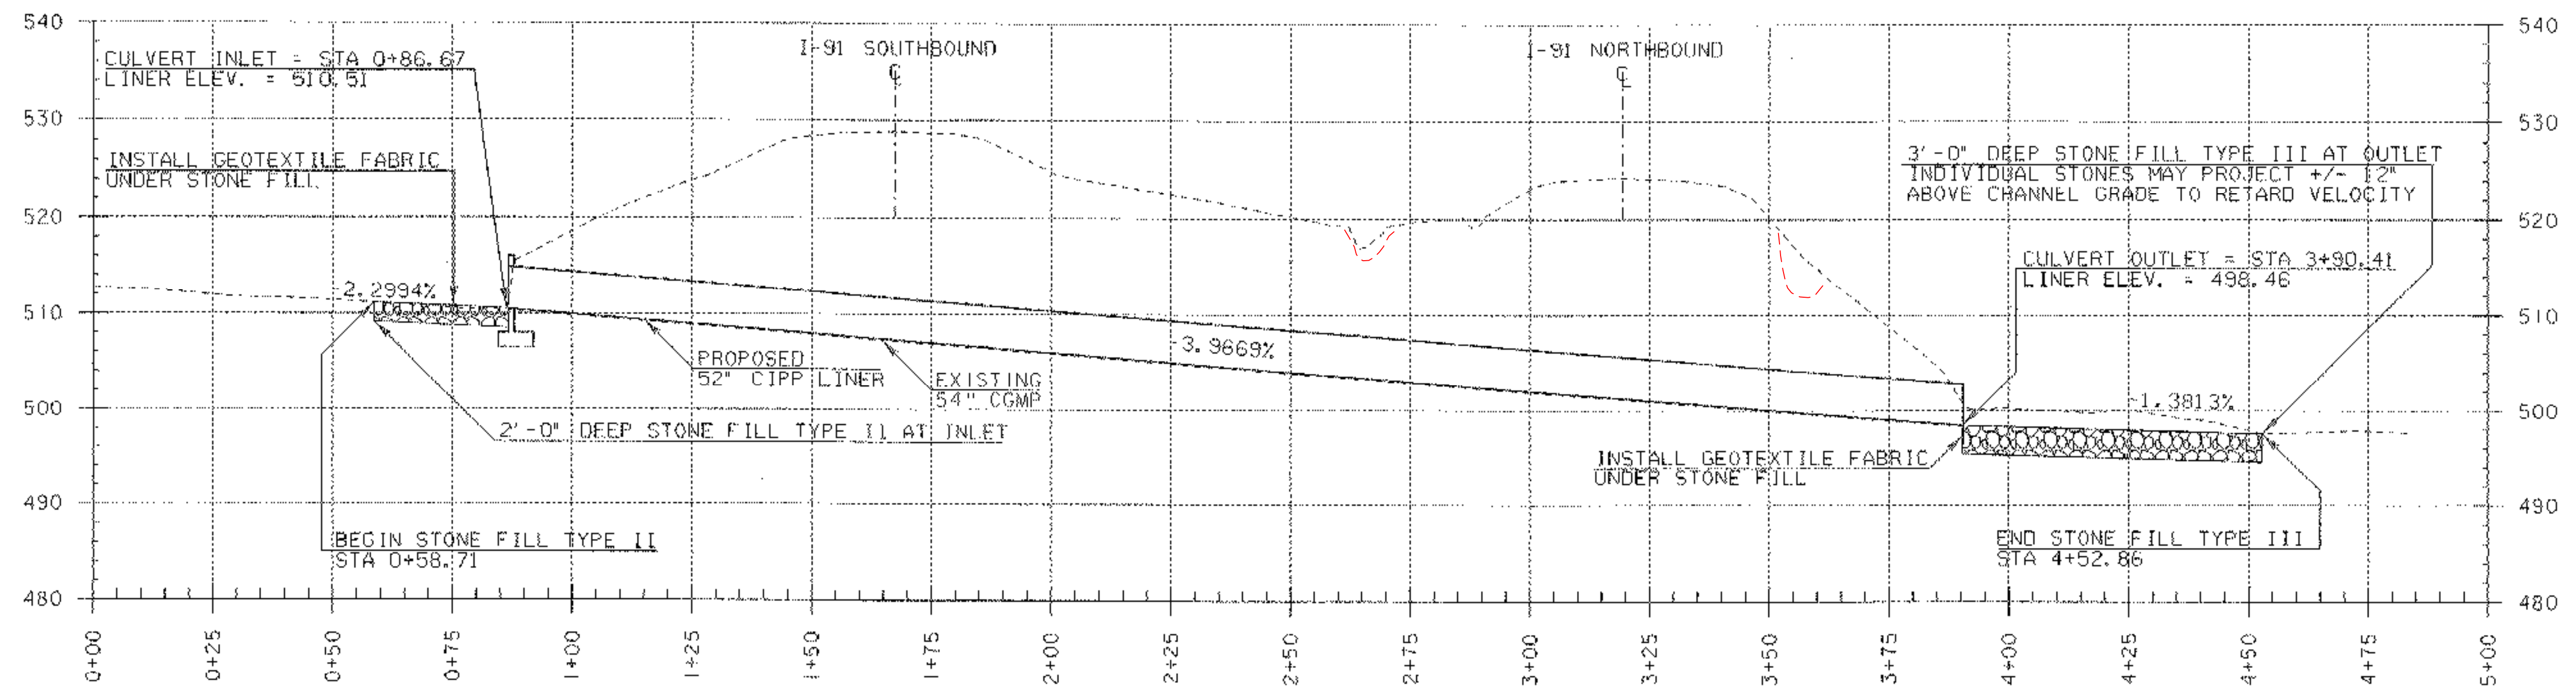


MM 117.96
CULVERT CENTERLINE
PROFILE

PROJECT NOTES

- ① THE CONTRACT ITEM 900.645 "SPECIAL PROVISION (CURED-IN-PLACE PIPE LINER) (54")" IS INTENDED TO BE USED FOR THE INSTALLATION OF A RESIN-IMPREGNATED FLEXIBLE TUBE, WHICH SHALL BE TIGHTLY FORMED TO THE ORIGINAL CONDUIT. THE RESIN IS TO BE CURED USING EITHER HOT WATER UNDER HYDROSTATIC PRESSURE OR STEAM PRESSURE WITHIN THE TUBE. THE CURED-IN-PLACE PIPE (CIPP) SHALL BE CONTINUOUS AND TIGHT FITTING.
- ② THE CONTRACTOR WILL BE RESPONSIBLE FOR PREPARATION OF THE EXISTING PIPE TO THE SATISFACTION OF THE MANUFACTURER OF THE CIPP LINER. IT IS ANTICIPATED THAT IT WILL BE NECESSARY FOR THE CONTRACTOR TO REMOVE SEDIMENT, LARGE STONES, AND/OR DEBRIS FROM INSIDE THE EXISTING CULVERT PRIOR TO INSTALLING THE CIPP LINER.
- ③ ALL WORK DIRECTLY ASSOCIATED WITH THE REPAIR OF THE CULVERT SHALL BE DONE IN DRY CONDITIONS WITH NO STANDING OR FLOWING WATER PRESENT INSIDE THE CULVERT. REFER TO PROJECT SPECIAL PROVISIONS FOR ADDITIONAL REQUIREMENTS.
- ④ THE CONTRACTOR SHALL ESTABLISH TURF ON ANY AREAS DISTURBED AS A RESULT OF WORK ON THIS PROJECT ACCORDING TO THE RURAL SEEDING FORMULA ON SHEET 18 OR AS DIRECTED BY THE RESIDENT ENGINEER.

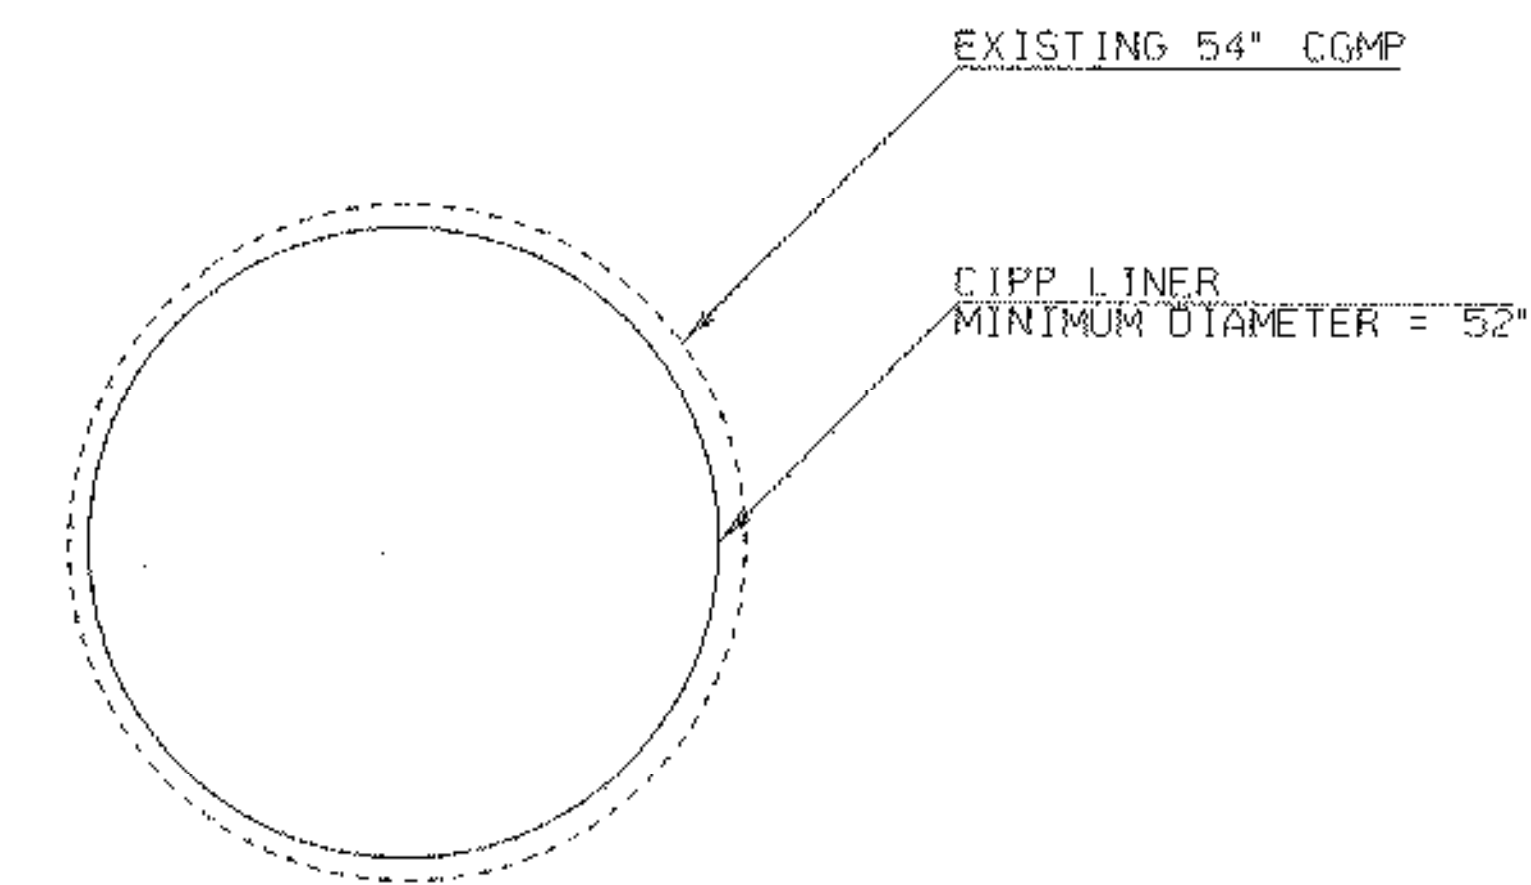

MM 117.96
CULVERT LINING DETAIL
NOT TO SCALE

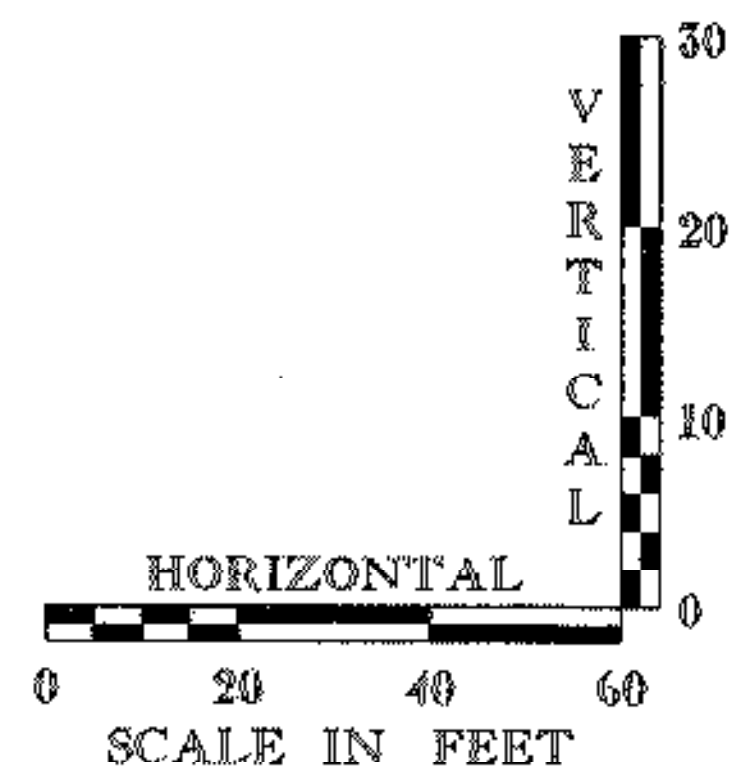

PROJECT NAME:	BARNET
PROJECT NUMBER:	1M SCRP(2)
FILE NAME:	d07s102wrk.dgn
PROJECT LEADER:	K. UPMAL
DESIGNED BY:	J. DEVLIN
MM 117.96 CULVERT LINING DETAIL	PLOT DATE: 25-FEB-2008
	DRAWN BY: J. DEVLIN
	CHECKED BY: K. UPMAL
	SHEET 9 OF 20

DATUM	
VERTICAL	NAVD88
HORIZONTAL	NAD83(96)