

CONSERVATION SEED MIX

RURAL AREA - SEED MIXTURE

% WT.	LBS./A.	NAME	PUR %	GERM %
37.5	22.5	CREeping RED FESCUE	98	85
37.5	22.5	TALL FESCUE	95	90
5.0	3.0	RED TOP	95	90
15.0	9.0	BIROSFoot TREFOIL	98	85
5.0	3.0	ANNUAL RYEGRASS	95	85
100.00	60.0			

SEED MIXTURE:
SHALL NOT HAVE A WEED CONTENT EXCEEDING 0.40% BY WEIGHT AND SHALL BE FREE OF ALL NOXIOUS WEED SEED.

SEED:
TO BE APPLIED PER SEEDING FORMULA OR AS DIRECTED BY THE RESIDENT ENGINEER

FERTILIZER:
FORMULA 10-20-10 TO BE USED WITH SEED, APPLIED AT THE RATE OF 500 LBS/ACRE (HYDROSEEDERS MAY USE 19-19-19 FORMULA)

AGRICULTURAL LIMESTONE:
TO BE APPLIED AT THE RATE OF 2 TONS/ACRE OR AS DIRECTED BY THE RESIDENT ENGINEER

HAY MULCH:
TO BE APPLIED ON EARTH SLOPES AT THE RATE OF 2 TONS/ACRE OR AS DIRECTED BY THE RESIDENT ENGINEER

TOPSOIL:
TO BE USED WITH SEED AS INDICATED ON THE PLANS OR AS DIRECTED BY THE RESIDENT ENGINEER


NOTE:
IF A HYDROSEEDER IS USED THE APPLICATION RATES SHALL BE DOUBLED

GENERAL NOTES:

1. SHOULD CHANGES PRIOR TO OR DURING CONSTRUCTION RESULT IN ONE OR MORE ACRES OF EARTH DISTURBANCE OR SHOULD THE PROJECT BECOME PART OF A LARGER PLAN OF DEVELOPMENT THEN THE SELECTED CONTRACTOR WILL BE RESPONSIBLE FOR ADDITIONAL PERMITTING WITH VANR VIA FILING OF THE APPROPRIATE NOTICE OF INTENT UNDER THE CONSTRUCTION GENERAL PERMIT PROCESS.
2. BRUSH REMOVAL SHALL BE MINIMIZED TO THAT WHICH IS NECESSARY TO INSTALL THE LINERS.
3. EARTH DISTURBANCE SHALL BE MINIMIZED BY LINING ONE CULVERT AT A TIME.
4. GRUBBING OF STUMPS IS NOT PERMITTED.
5. INSTALL, MONITOR, AND REPLACE OR REPAIR EROSION AND SEDIMENT CONTROL MEASURES DURING CONSTRUCTION.

LEGEND

- PERMANENT SLOPE LIMITS
- PROJECT DEMARCATION FENCE
- GEOTEXTILE FOR SILT FENCE

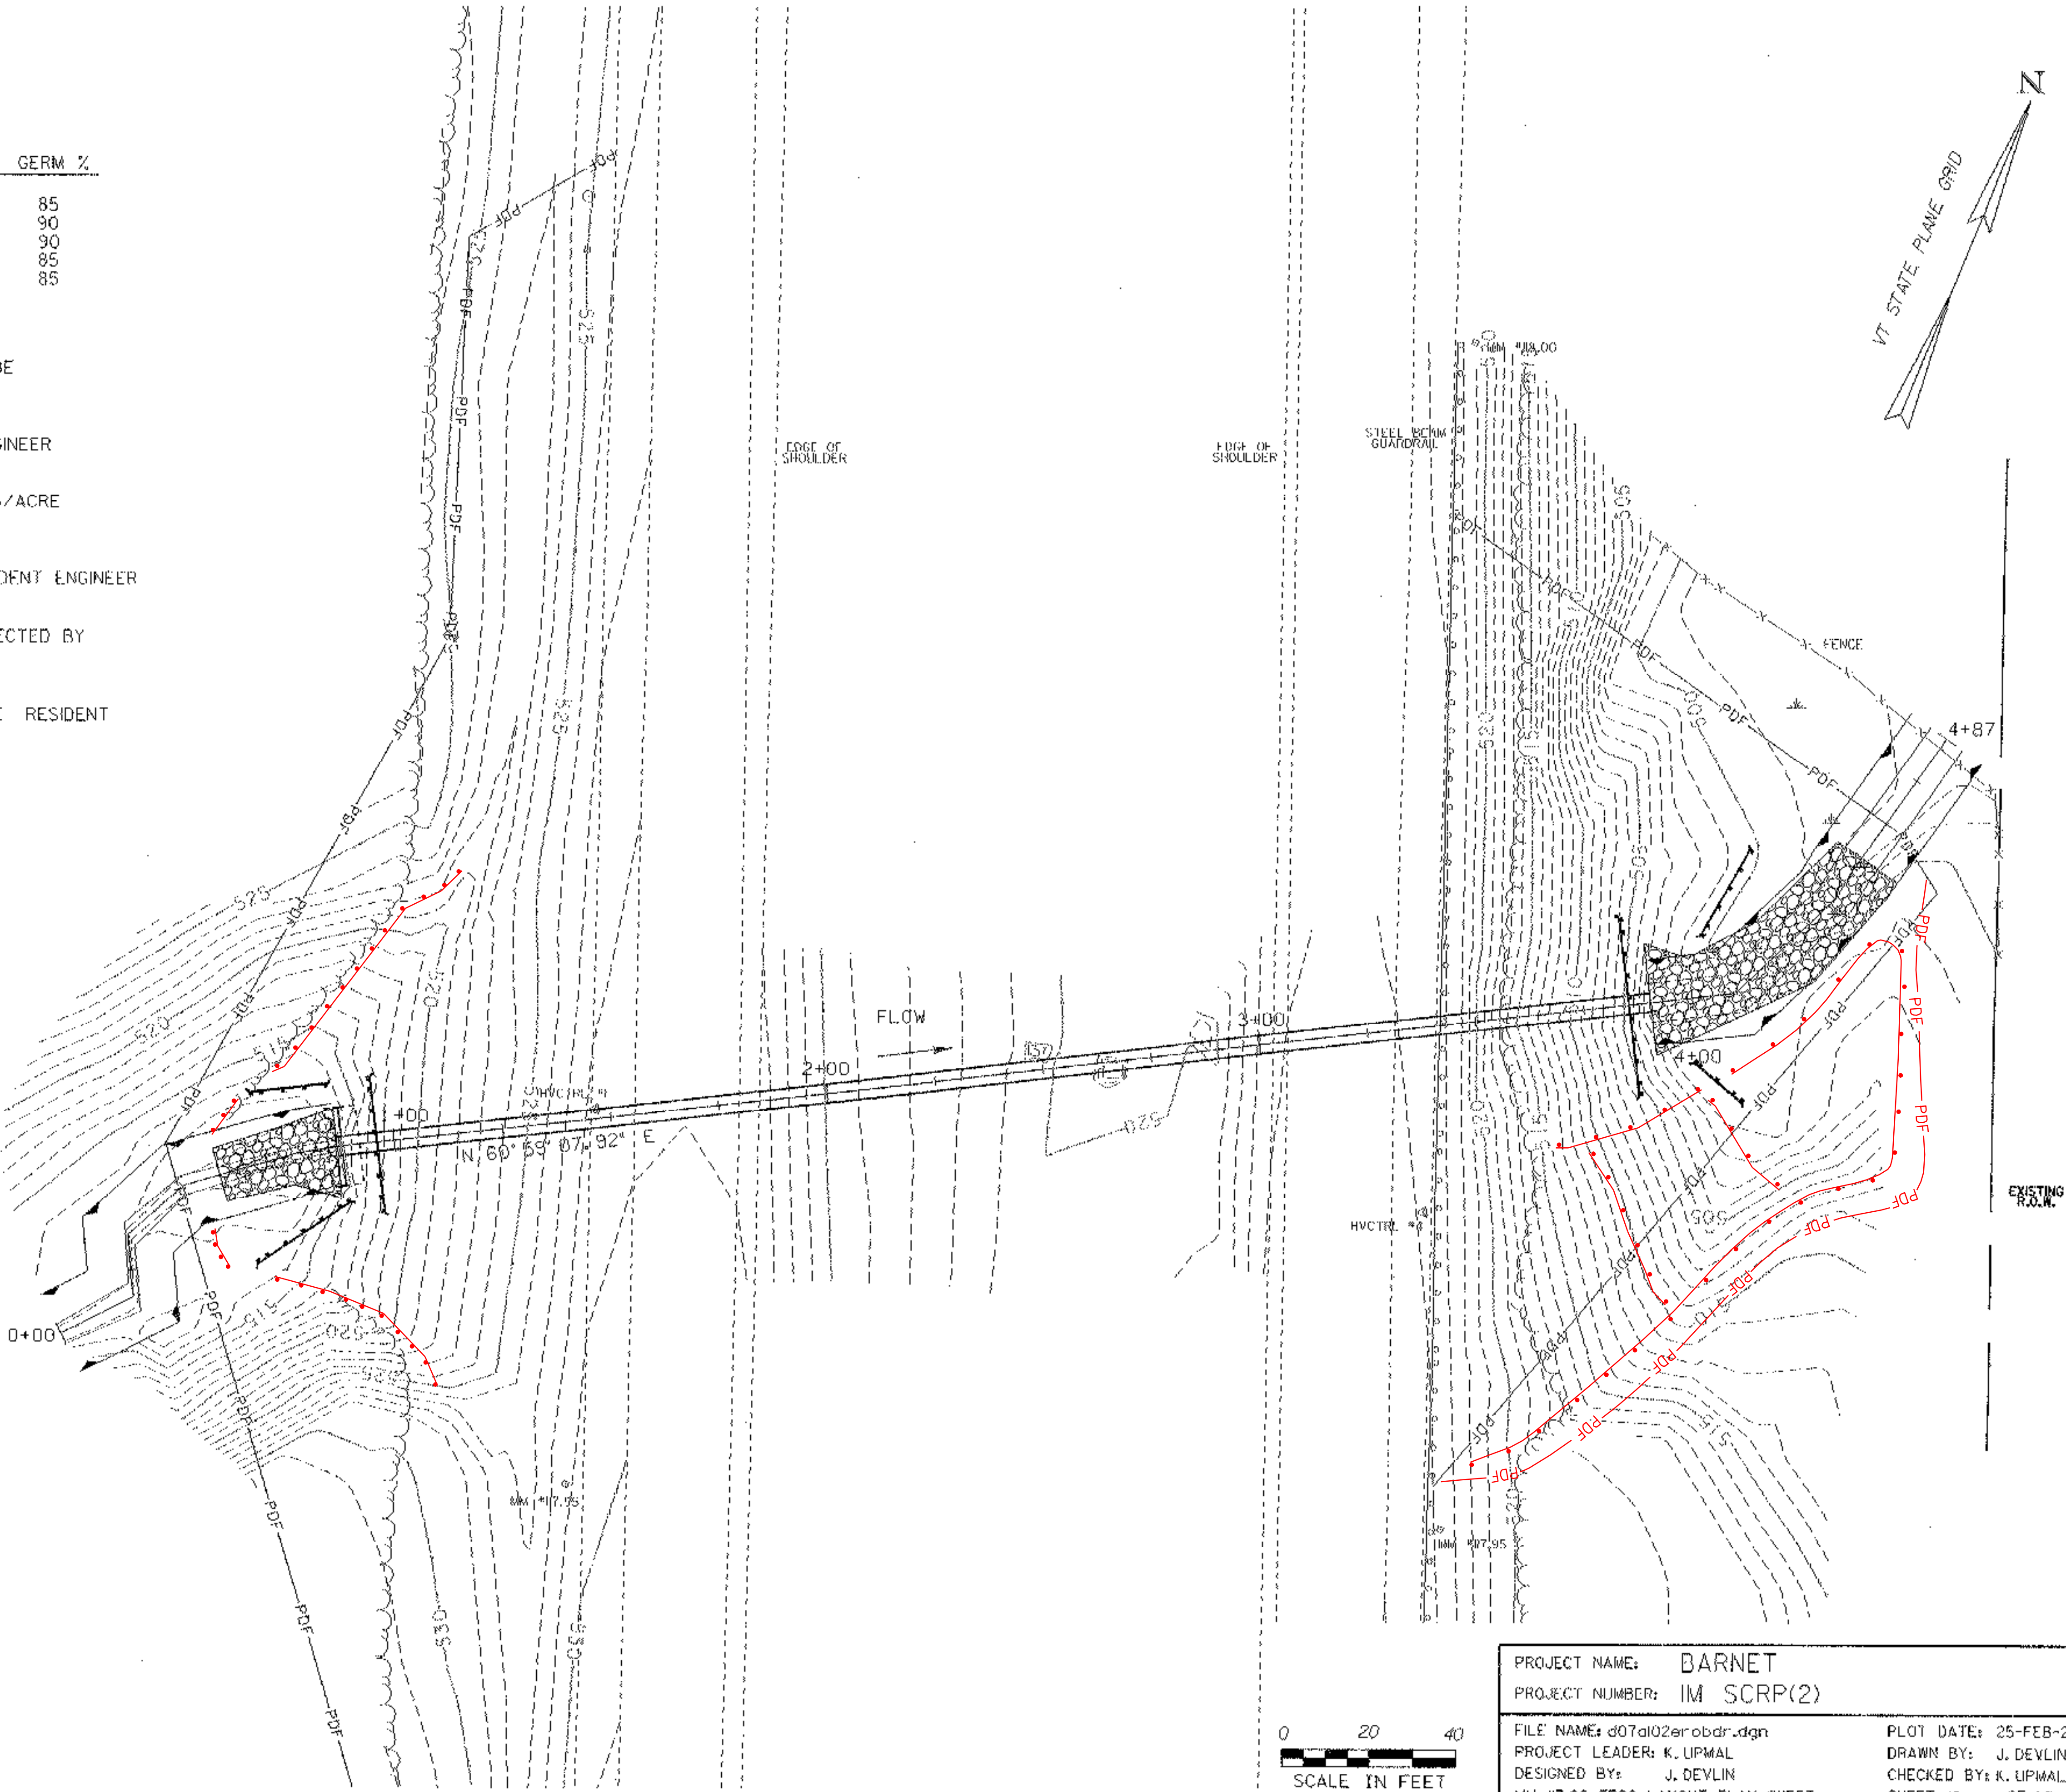

PROJECT NAME: BARNET
PROJECT NUMBER: IM SCRP(2)

FILE NAME: d07a102arobdr.dgn
PROJECT LEADER: K. UPMAL
DESIGNED BY: J. DEVLIN
MM 117.96 EPSC LAYOUT PLAN SHEET

PLOT DATE: 25-FEB-2008
DRAWN BY: J. DEVLIN
CHECKED BY: K. UPMAL
SHEET 18 OF 20