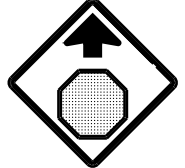
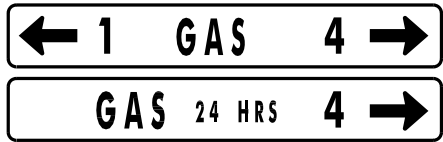
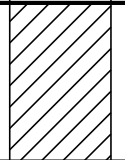
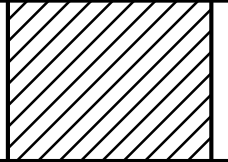


STATE OF VERMONT AGENCY OF TRANSPORTATION				TRAFFIC SIGN SUMMARY SHEET 12																																
MILEMARKER, STATION, OR SIGN NUMBER	SIGN LEGEND	SIGN DIMENSIONS			NEW & SALVAGED SIGNS				EXIST POST	NO. OF POSTS	FLANGED CHANNEL			SQUARE STEEL (in)				ANCHOR	SLEEVE	TUBULAR ALUMINUM Ø (in)			TUBULAR STEEL Ø (in)				W-SHAPE STEEL				REQUIRE SIGN FRAME	REMARKS	SIGN DETAIL			
		E A	WIDTH (in)	HEIGHT (in)	"A"	"B"	SALV SIGN	SALV TIS	RETAIN		SALVAGE	1.12	2.0	3.0	1.75	2.0	2.5			3.0	4.0	4.0 MOD	FOUND- ATION	3.0	3.5	4.0	5.0	FTG. SIZE		WEIGHT			POST SIZE	DETAIL ON DWG. NUMBER	STD. SHEET NUMBER	
																												lb/ft	lb/ft							24"
															1.12	2.0	3.0																			
RAMP C: C2+00.0, RT		I	36	36	9.00						2										2	228.0								SIGN ID CODE VR-046		E-I42				
		I	36	36	9.00																									SIGN ID CODE VR-002		E-I42				
C7+56.0, RT		I	30	30	6.25						1				X		X													SIGN ID CODE R3-2		E-I43				
RAMP D: D0+00.0, RT		I	48	60	20.00						2										2	228.0								SIGN ID CODE W13-2		E-I50				
D8+08.0, LT		I	18	18	2.25						1				X		X													SIGN ID CODE OMI-I		E-I50				
D8+37.0, LT		I	72	60		30.00					2										2	182.4								SIGN ID CODE E5-1A		E-I31				
D9+10.0, RT		I	36	36	9.00						2				X		X													SIGN ID CODE W3-1A		E-I50				
DI2+56.0, RT		I	72	10	5.00						2										2	218.3								SEE REVISED SHEET *37/56	37 37	E-I33				
		I	72	10	5.00																										SEE REVISED SHEET *37/56	37 37	E-I33			
		I	72	10	5.00																										SEE REVISED SHEET *37/56	37 37	E-I33			
FINAL POST LENGTHS ARE TO BE DETERMINED IN THE FIELD. POST SIZES ARE COMPUTED BASED ON INFORMATION FURNISHED ON THE STANDARD SHEETS AND THE VTRANS "SIGN POST DESIGN GUIDELINE."												LF	LF	LF	LF	LF	56		EA.	LB	LB	LB		LB	LB	LB	LB									
			TOTALS			SF 85.50	SF 30.00	EA.	SF			LF			LF 56					LB		EA.	8	LB 856.7				EA.	EA.	LB	TRAFFIC SIGN SUMMARY SHEET #12		PROJECT NAME: WINDSOR - HARTLAND PROJECT NUMBER: IM 09I-I(6I) FILE NAME: p07al42.dgn PROJECT LEADER: D.E.G. DESIGNED BY: M.J.L. IPARM FILE: p07al42+ssl2.i		PLOT DATE: 16-AUG-201113:42 DRAWN BY: C.A.K. CHECKED BY: R.A.B. SHEET 30 OF 56	