



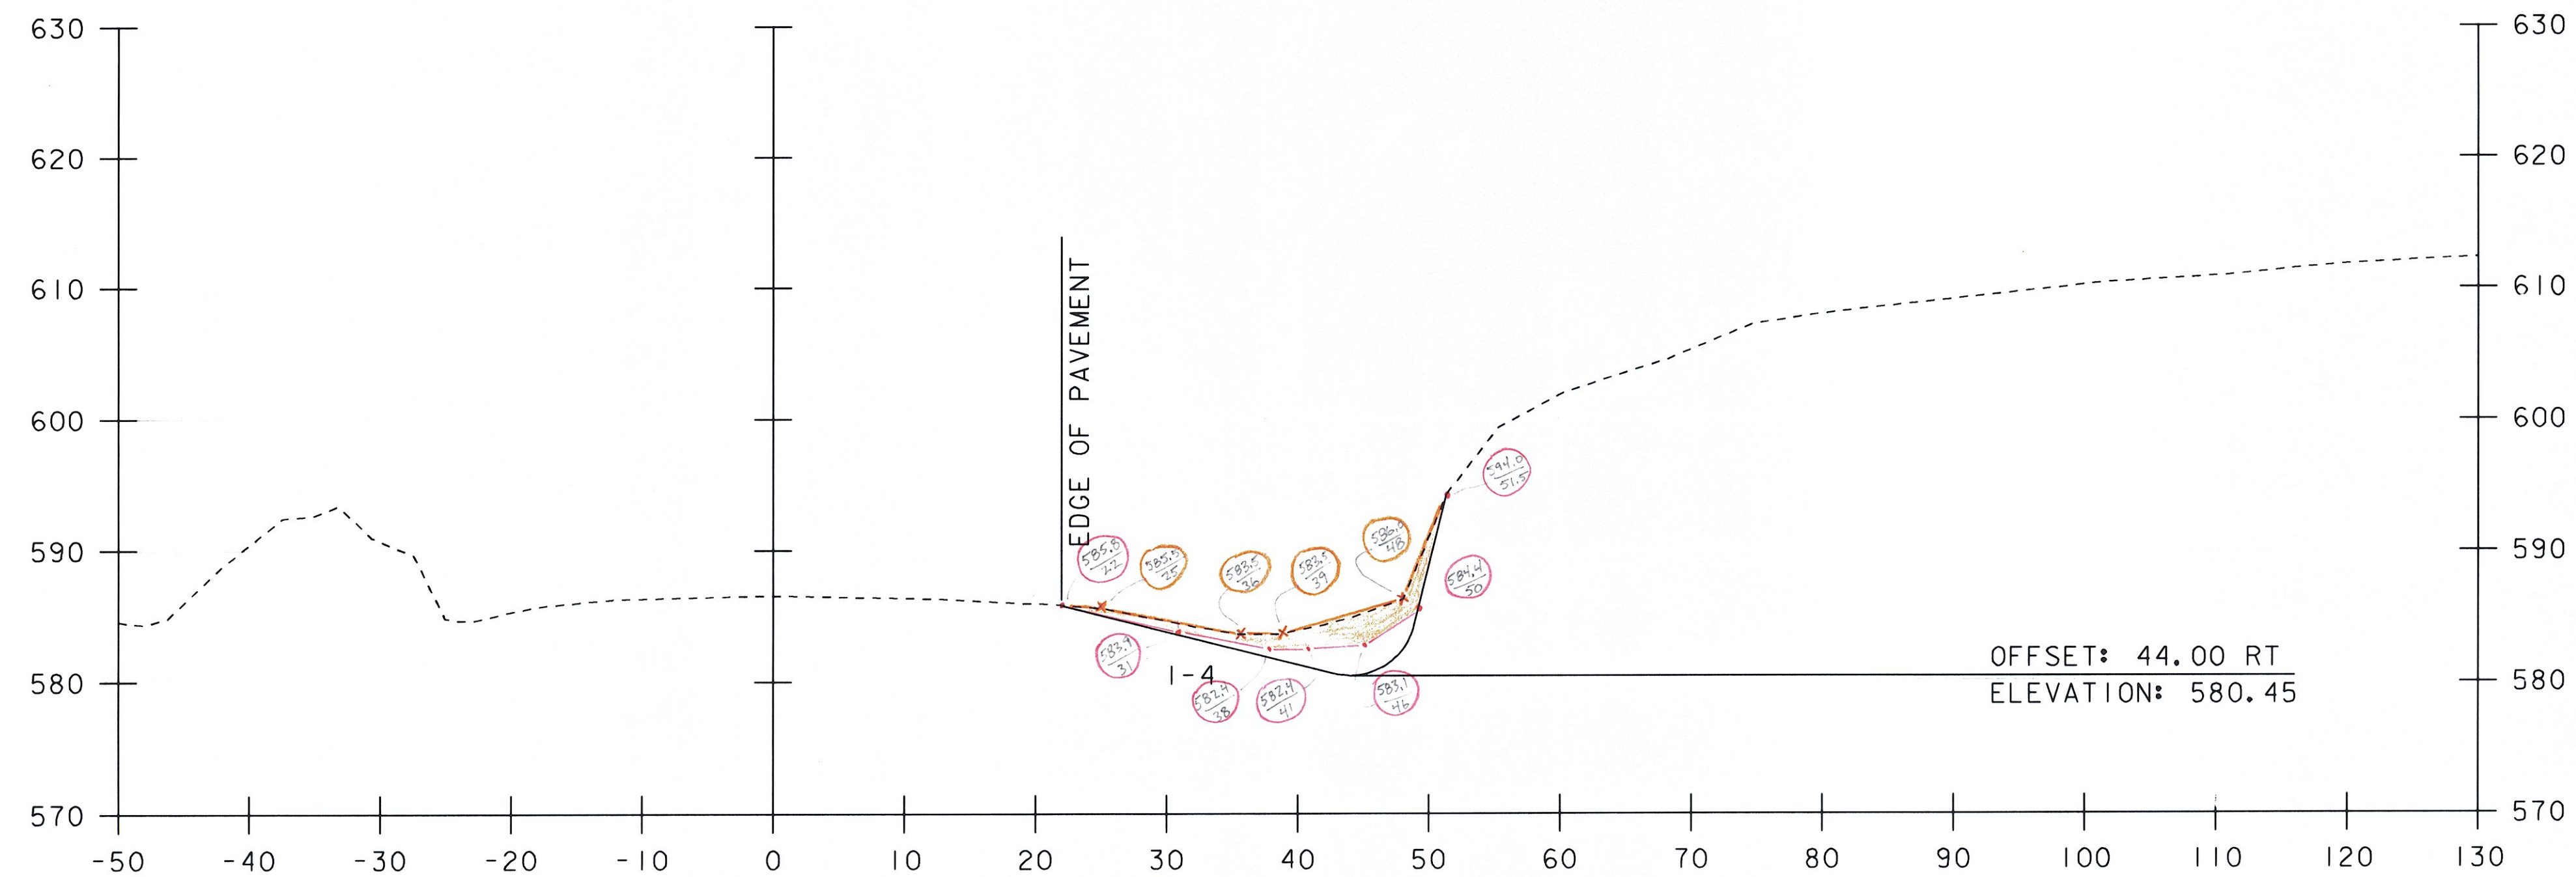

1842+50 ✓

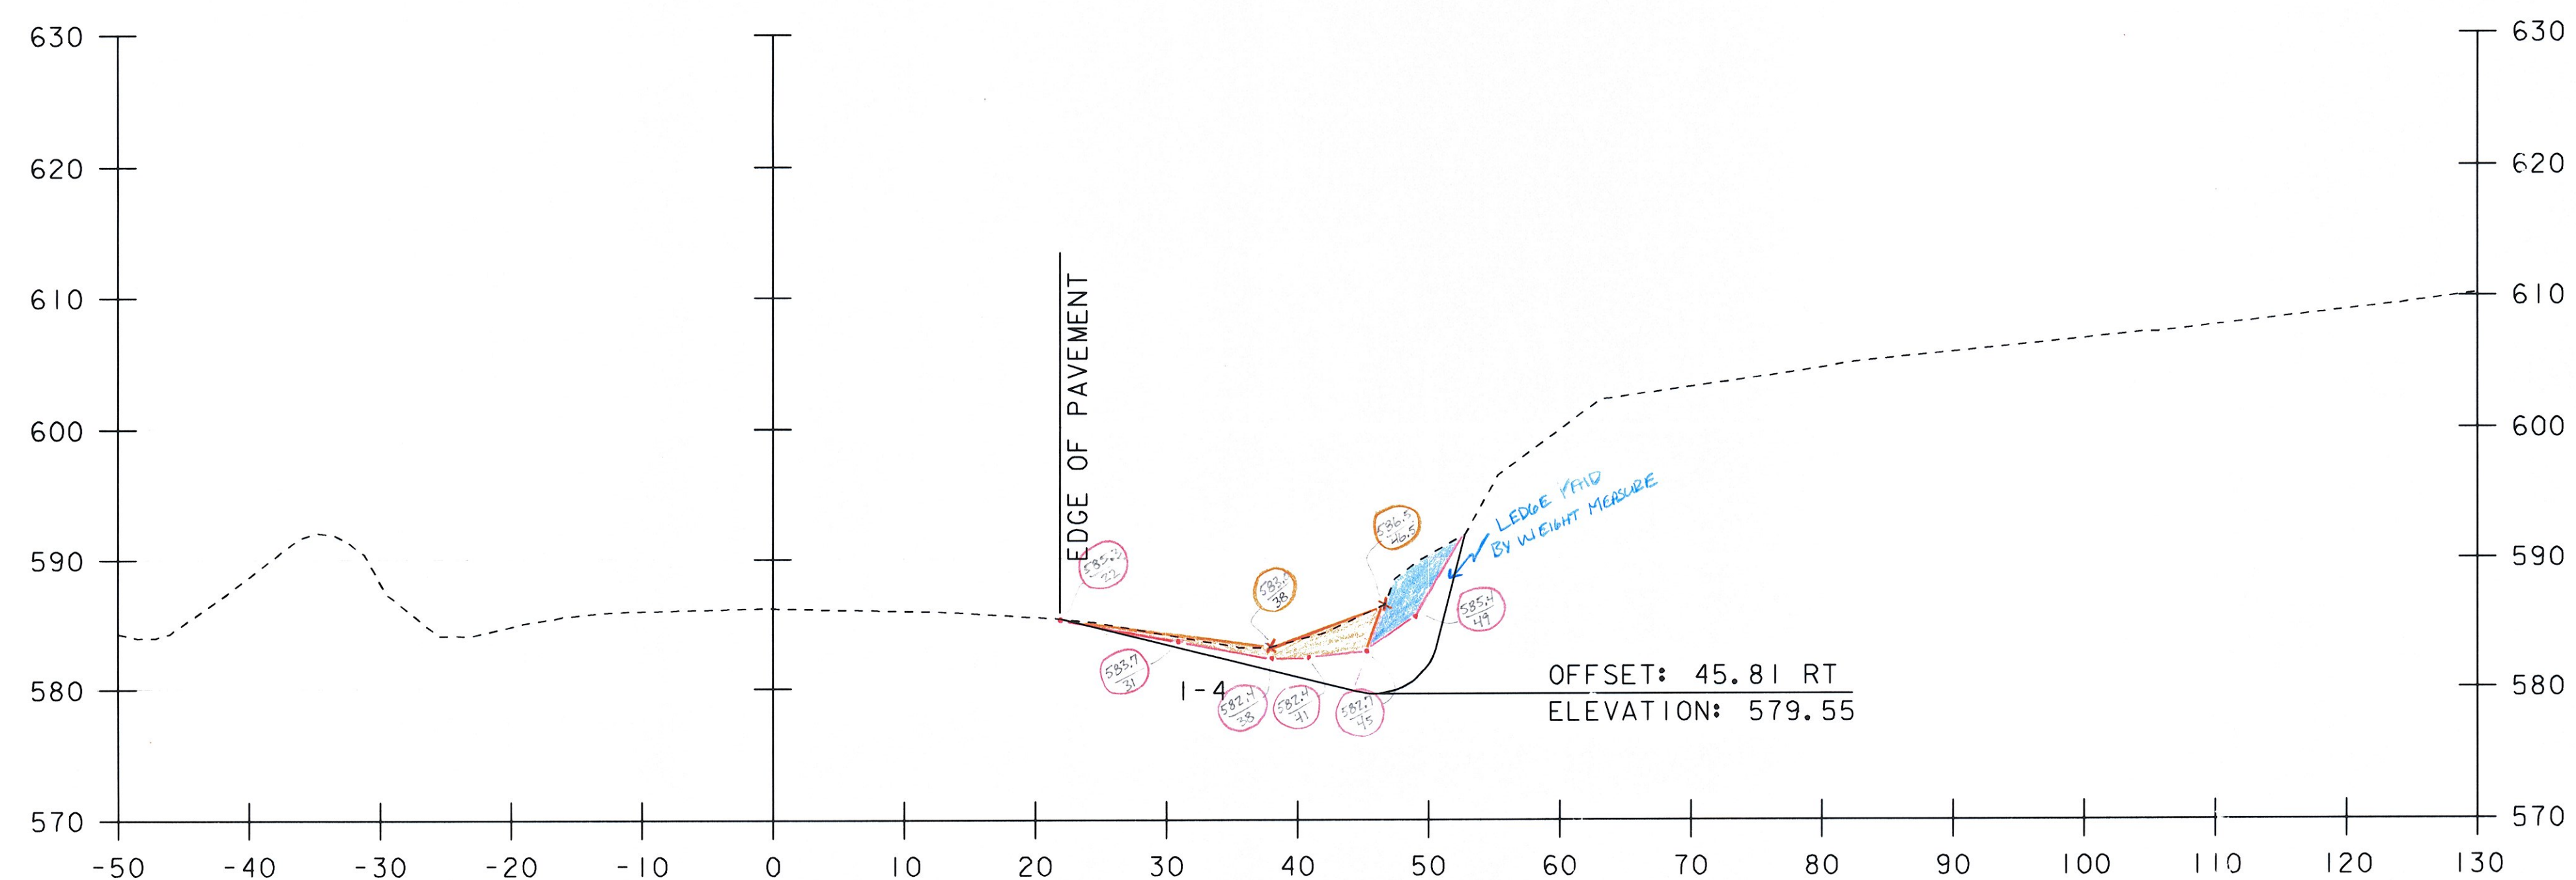

1842+00 ✓

0 10 20
SCALE IN FEET

STA. 1842+00 TO STA. 1842+50

AP 2-6-11 RCD 3116111

PROJECT NAME: ROCKINGHAM
PROJECT NUMBER: IM 09I-1(57)

FILE NAME: 07a158/Design/d07a158xs.dgn
PROJECT LEADER: K. ROBIE
DESIGNED BY: P. PELOQUIN
CROSS SECTION SHEET 5

PLOT DATE: 26-MAY-2010
DRAWN BY: P. PELOQUIN
CHECKED BY: S. MENARD
SHEET 31 OF 78