



646.426 DURABLE 6 INCH WHITE LINE, RECESSED POLYUREA
STA. D17+25 TO D19+78, SOLID RT (EDGE LINE)
STA. D17+25 TO D19+78 LT DOTTED

646.622 TEMPORARY 6 INCH WHITE LINE, PAINT
STA. D17+25 TO D19+78, SOLID RT (EDGE LINE)
STA. D17+25 TO D19+78 LT DOTTED

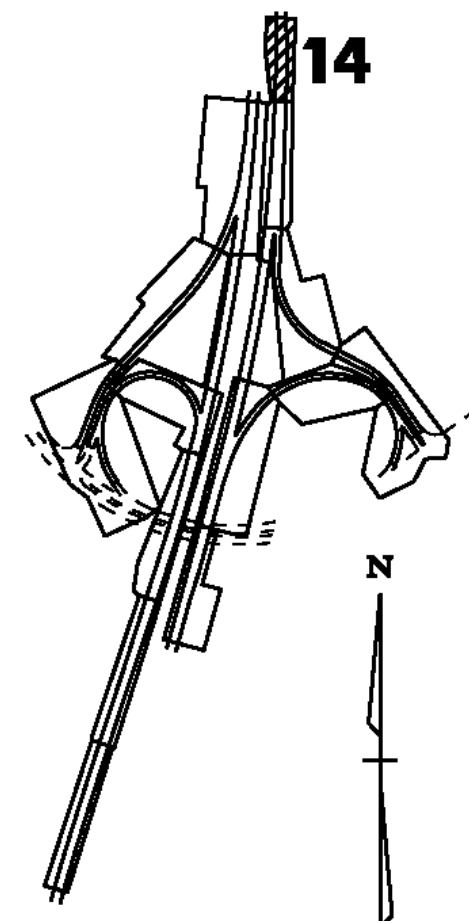

KEY PLAN

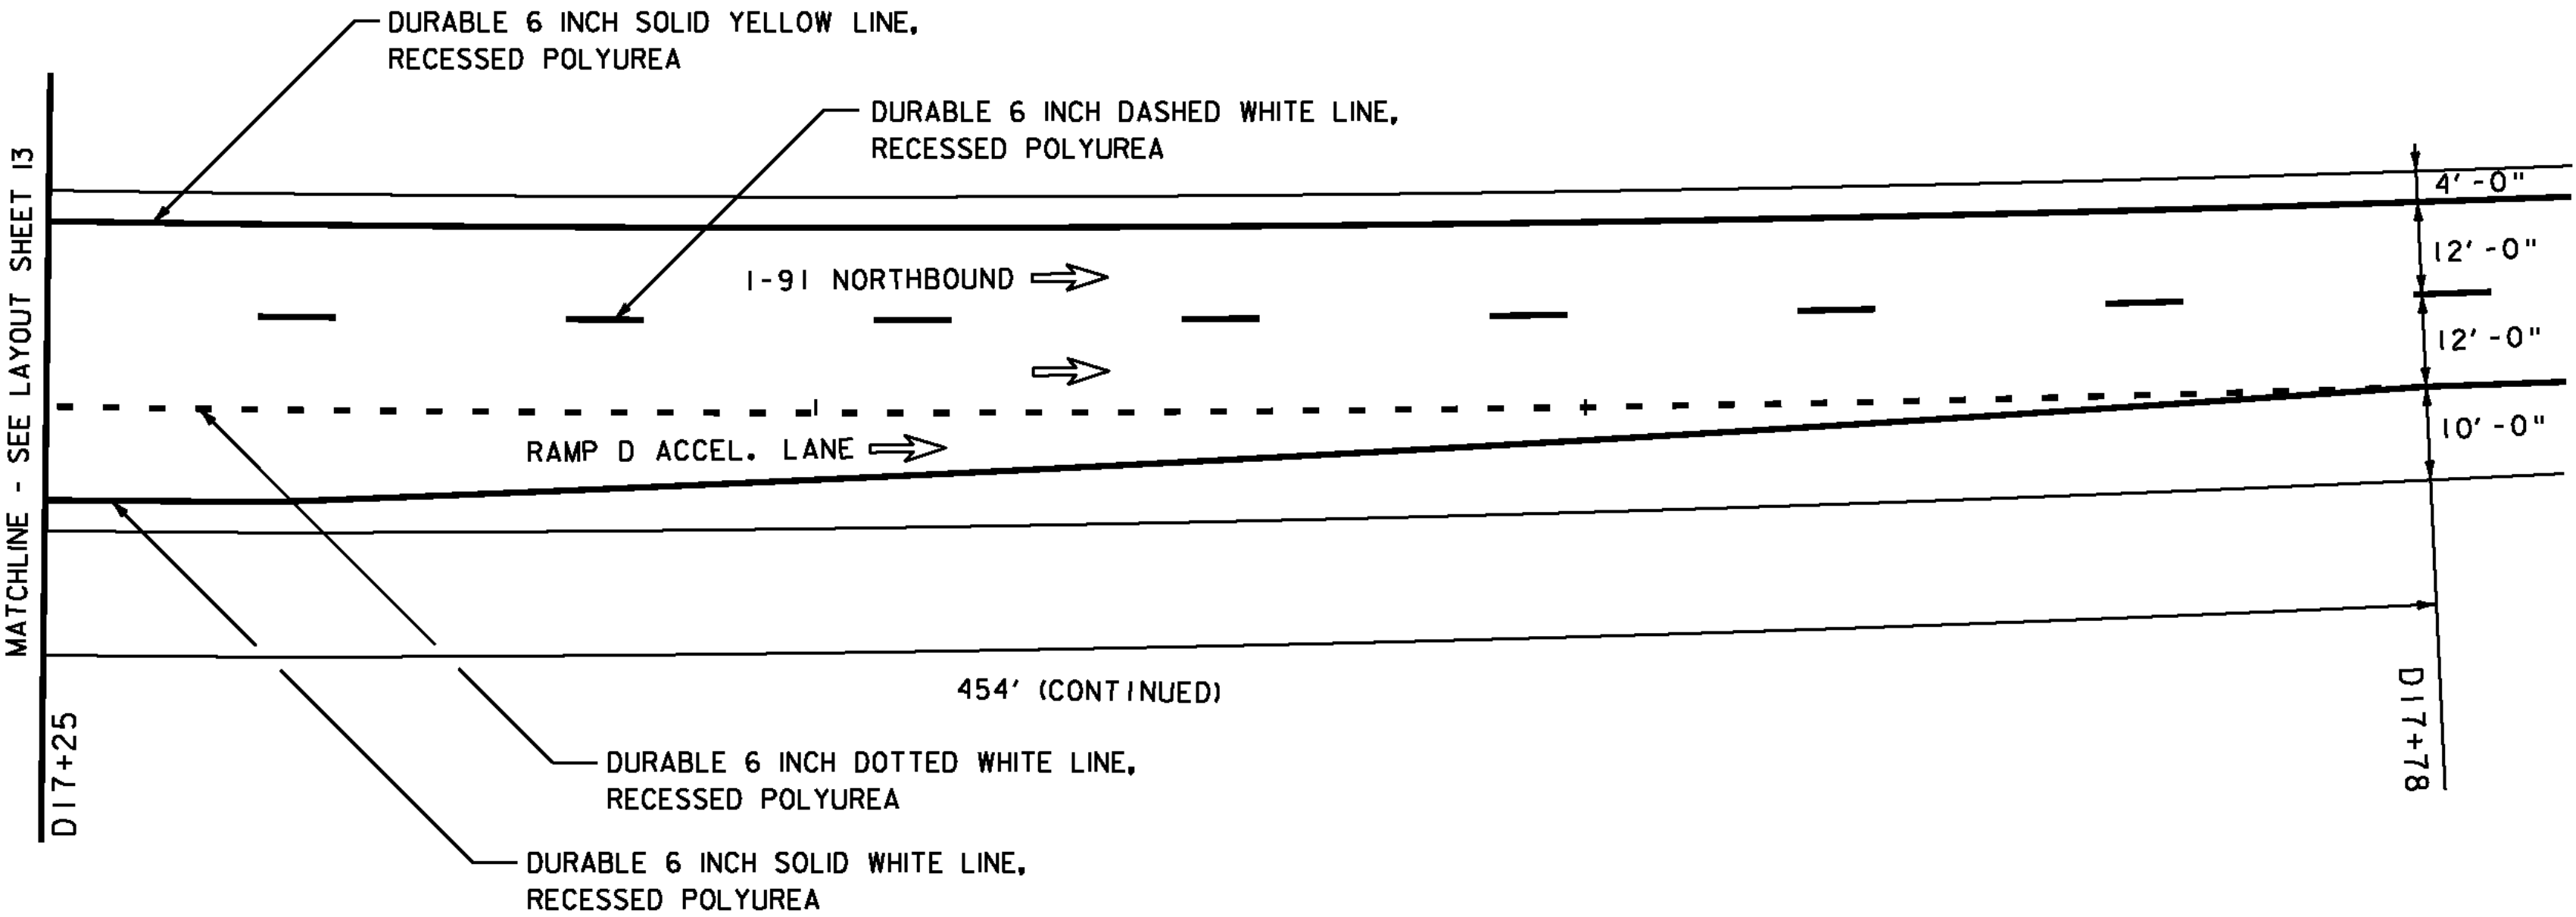

UTILITY LEGEND	
	= EXISTING DI
	= EXISTING SIGN POST
	= EXISTING GUARDRAIL
	= EXISTING CULVERT

SIGN LEGEND	
N	= NEW
R	= REMOVE
R&S	= REMOVE & SALVAGE
S	= SALVAGE SIGN
RET	= RETAIN
B-B	= BACK TO BACK



INTERCHANGE
26 LAYOUT
SHEET #14

NOTE:
ALL EXISTING SIGNS NOT SHOWN SHALL BE RETAINED.

PROJECT NAME: BARTON-IRASBURG
PROJECT NUMBER: IM 091-3(48)

FILE NAME: p07a286.dgn
PROJECT LEADER: JLL
DESIGNED BY: STANTEC
IPARM FILE: p07a286120.i

PLOT DATE: 06-JUL-2011
DRAWN BY: STANTEC
CHECKED BY: STANTEC
SHEET 35 OF 40