




TYPICAL INTERCHANGE CONSTRUCTION DETAILS

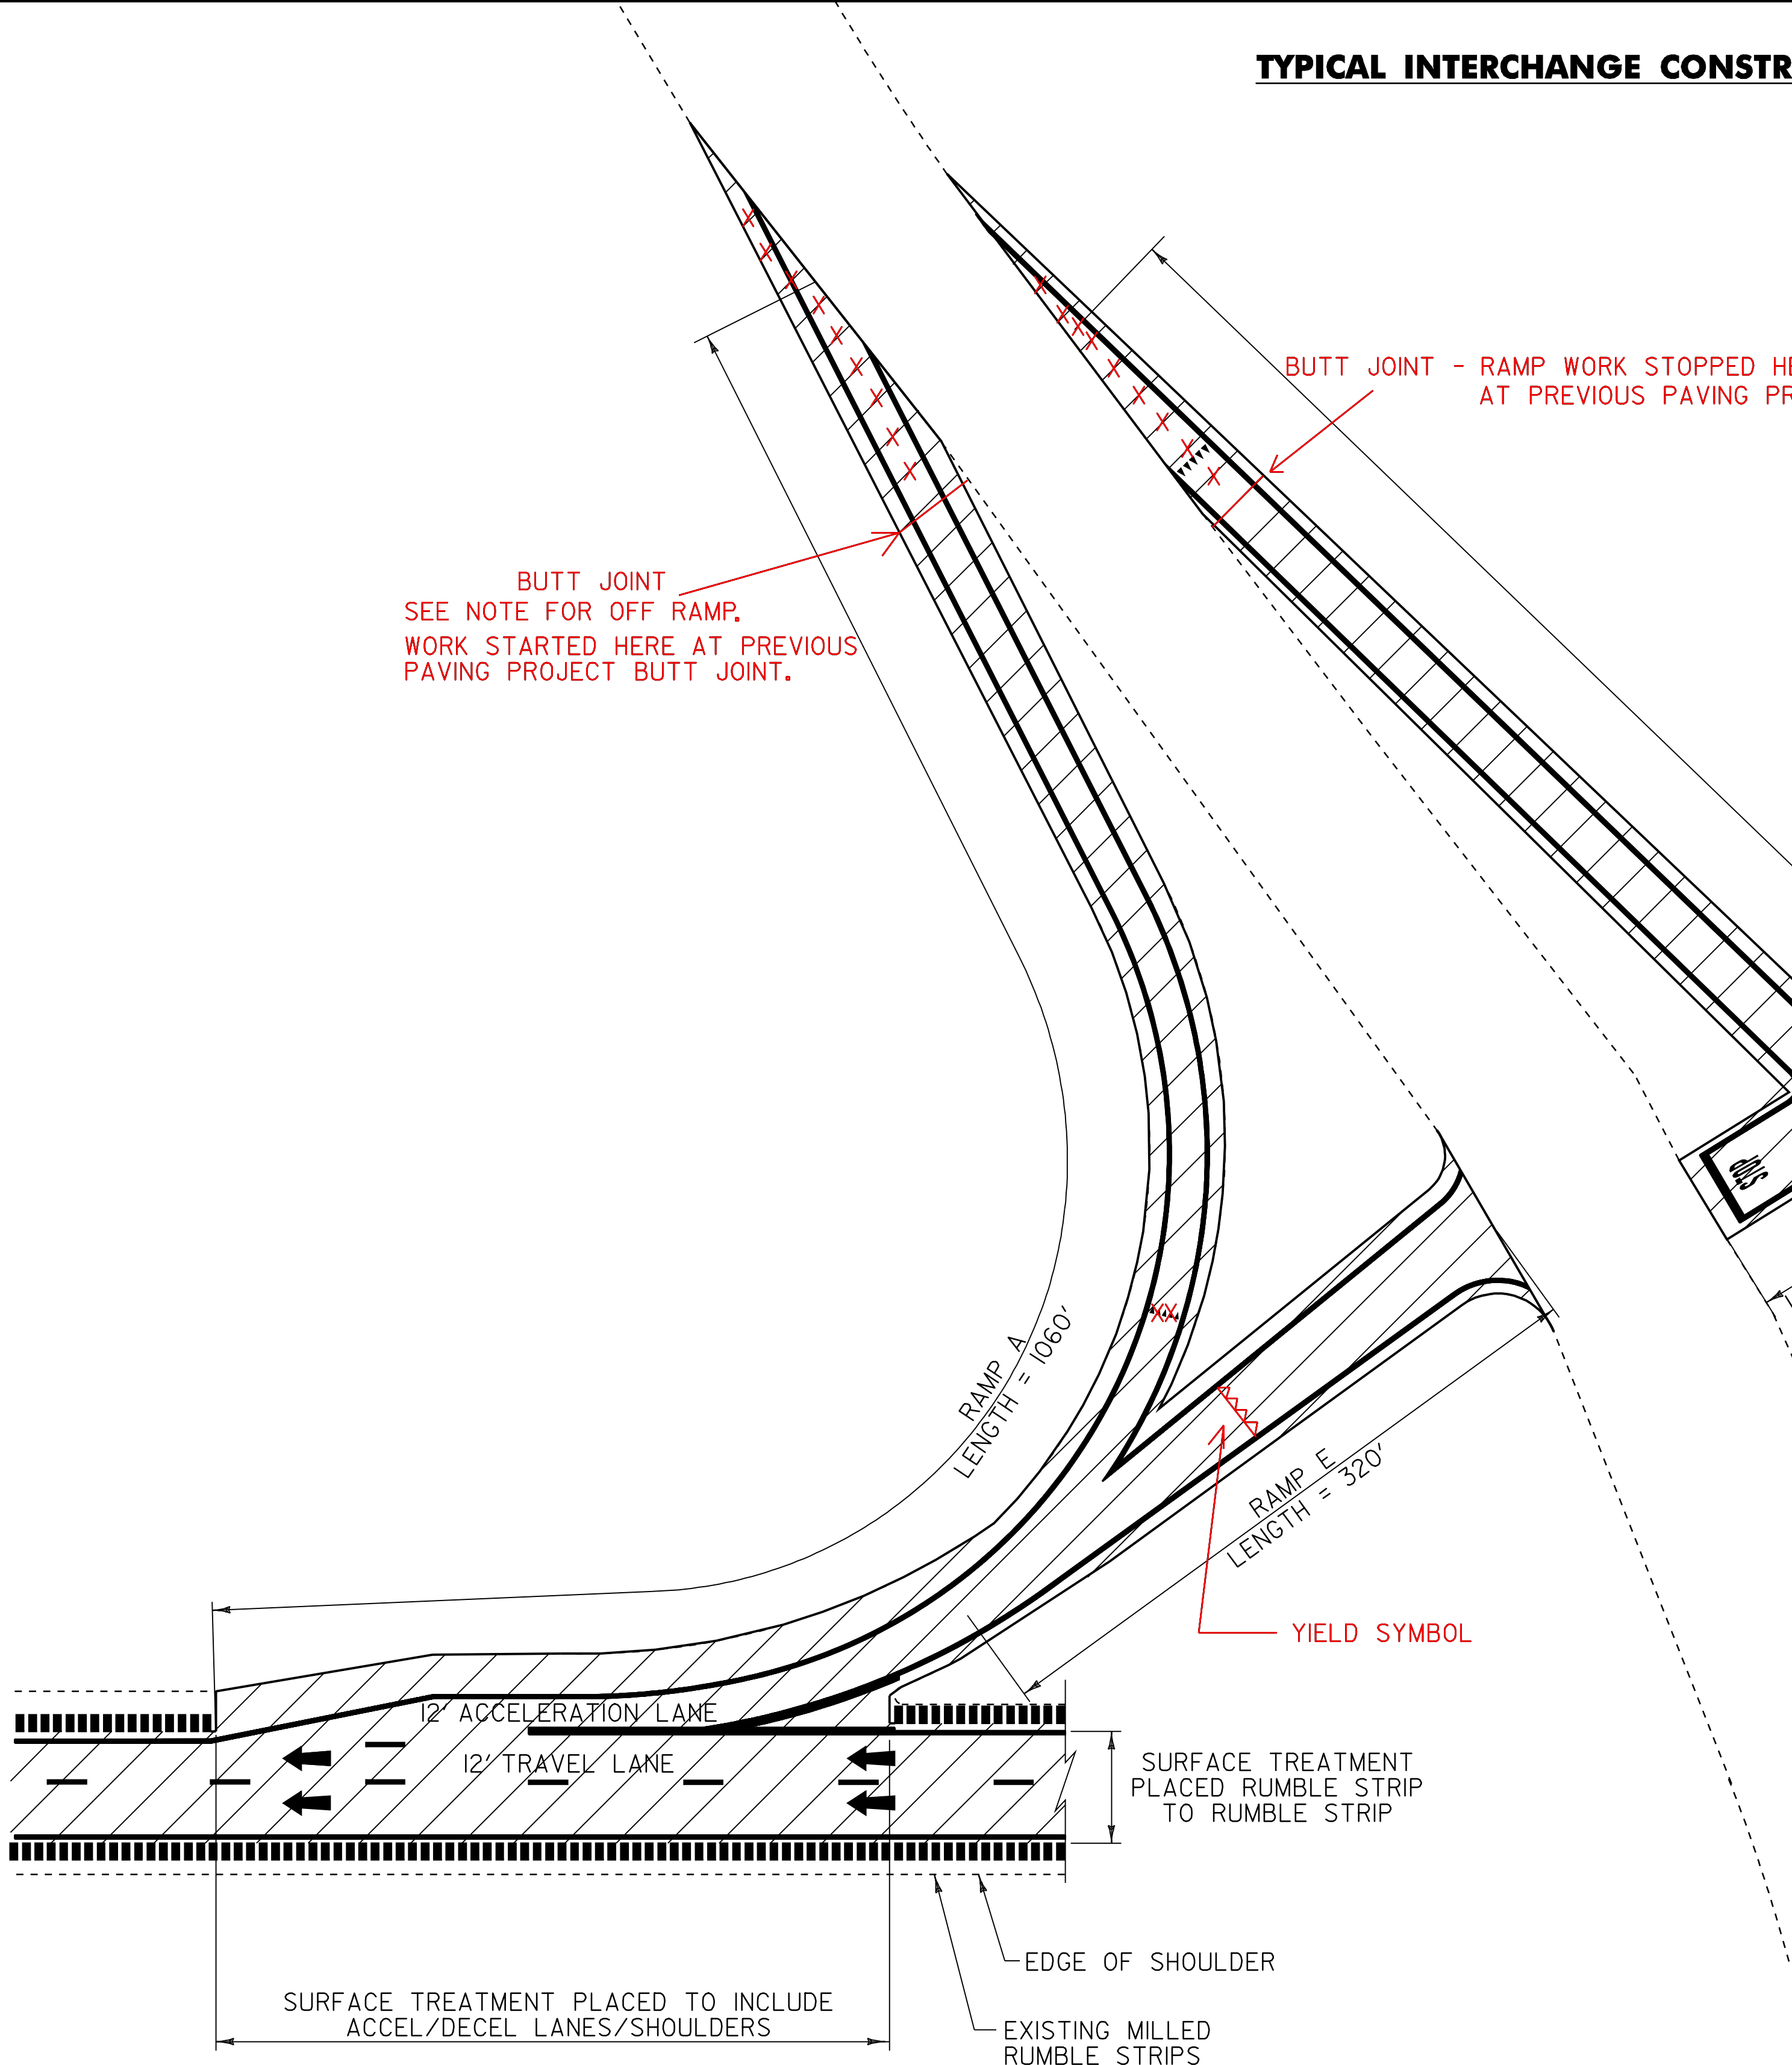

EXIT 7 ON RAMP CONSTRUCTION DETAILS

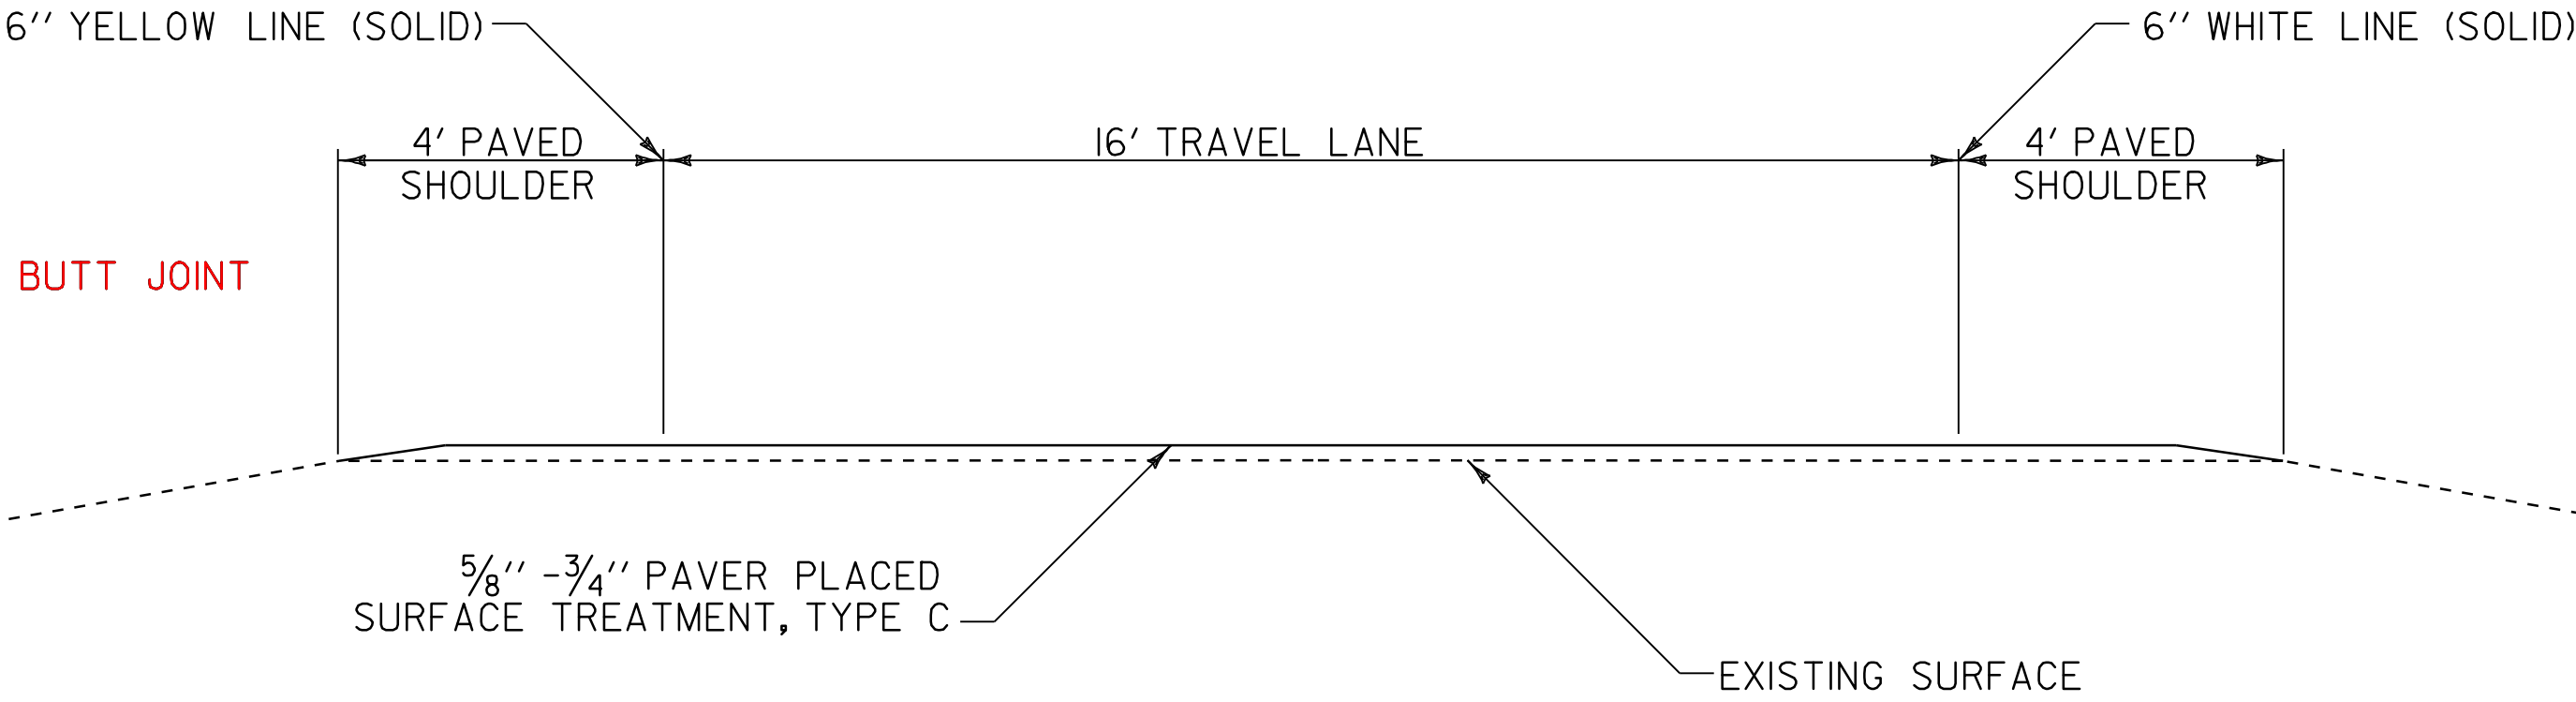


TYPICAL RAMP SECTION

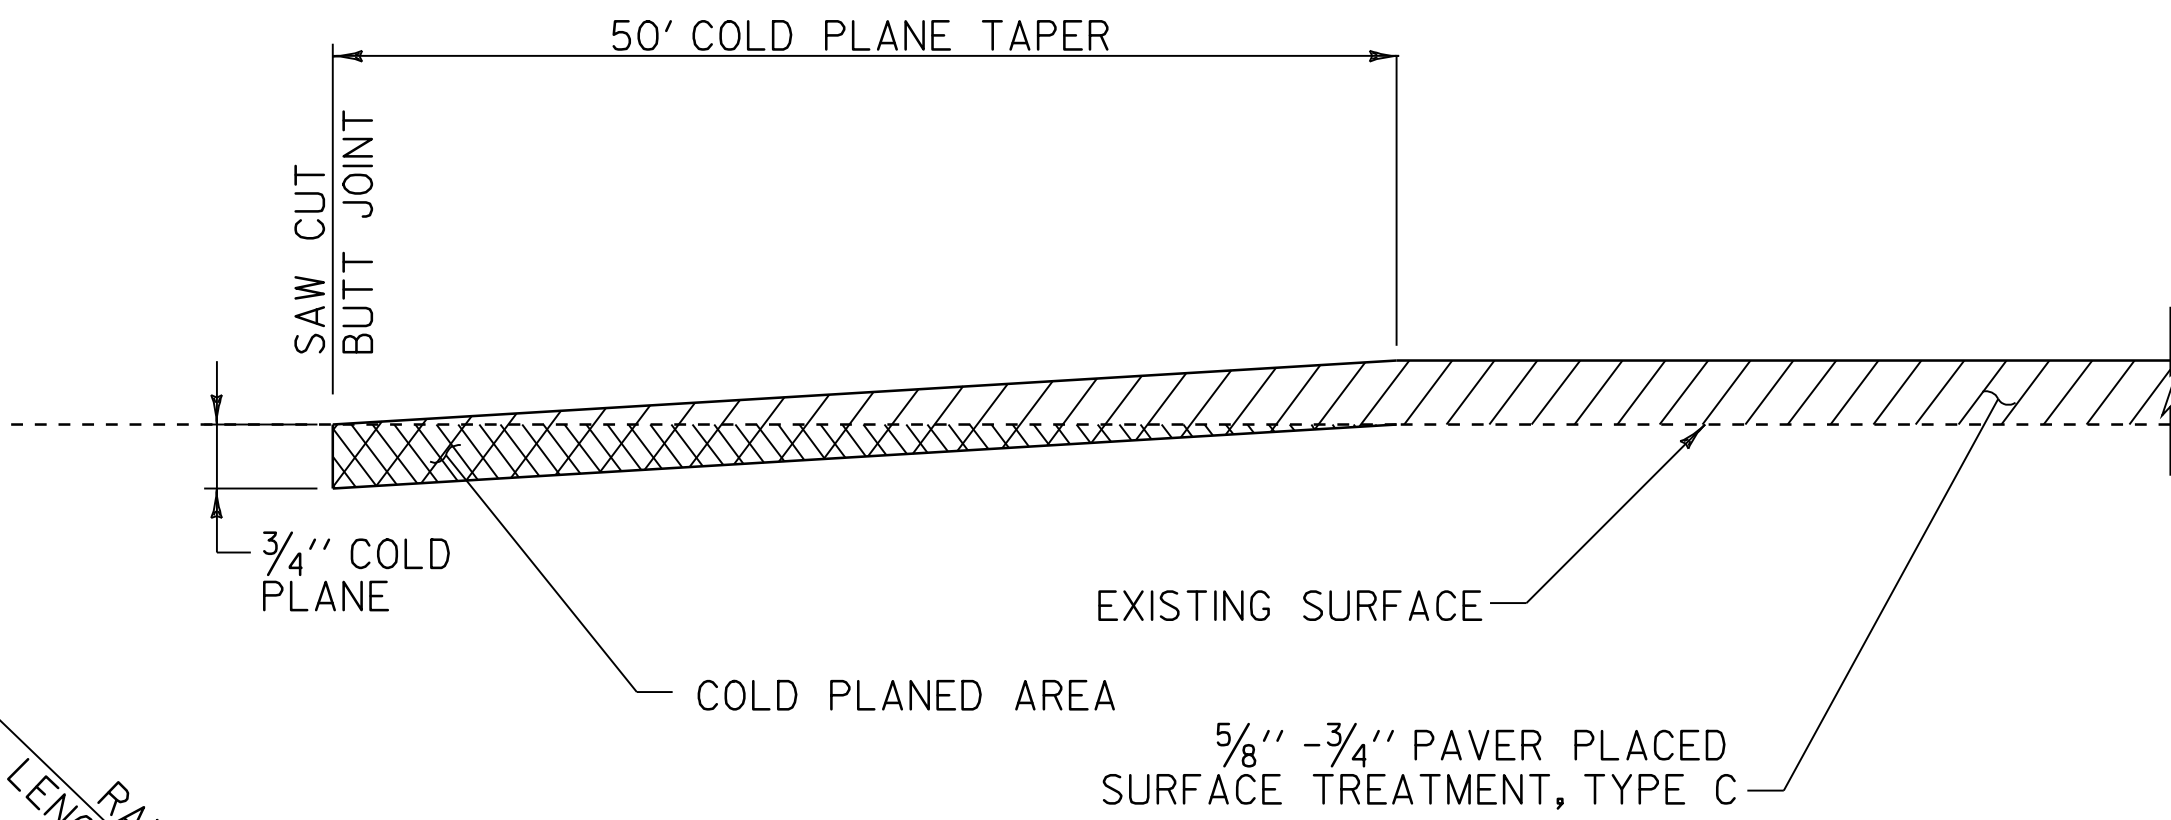


COLD PLANE DETAIL AT RAMPS

NOTES:  
1. SURFACE PREPARATION IS REQUIRED ON ALL RAMPS.

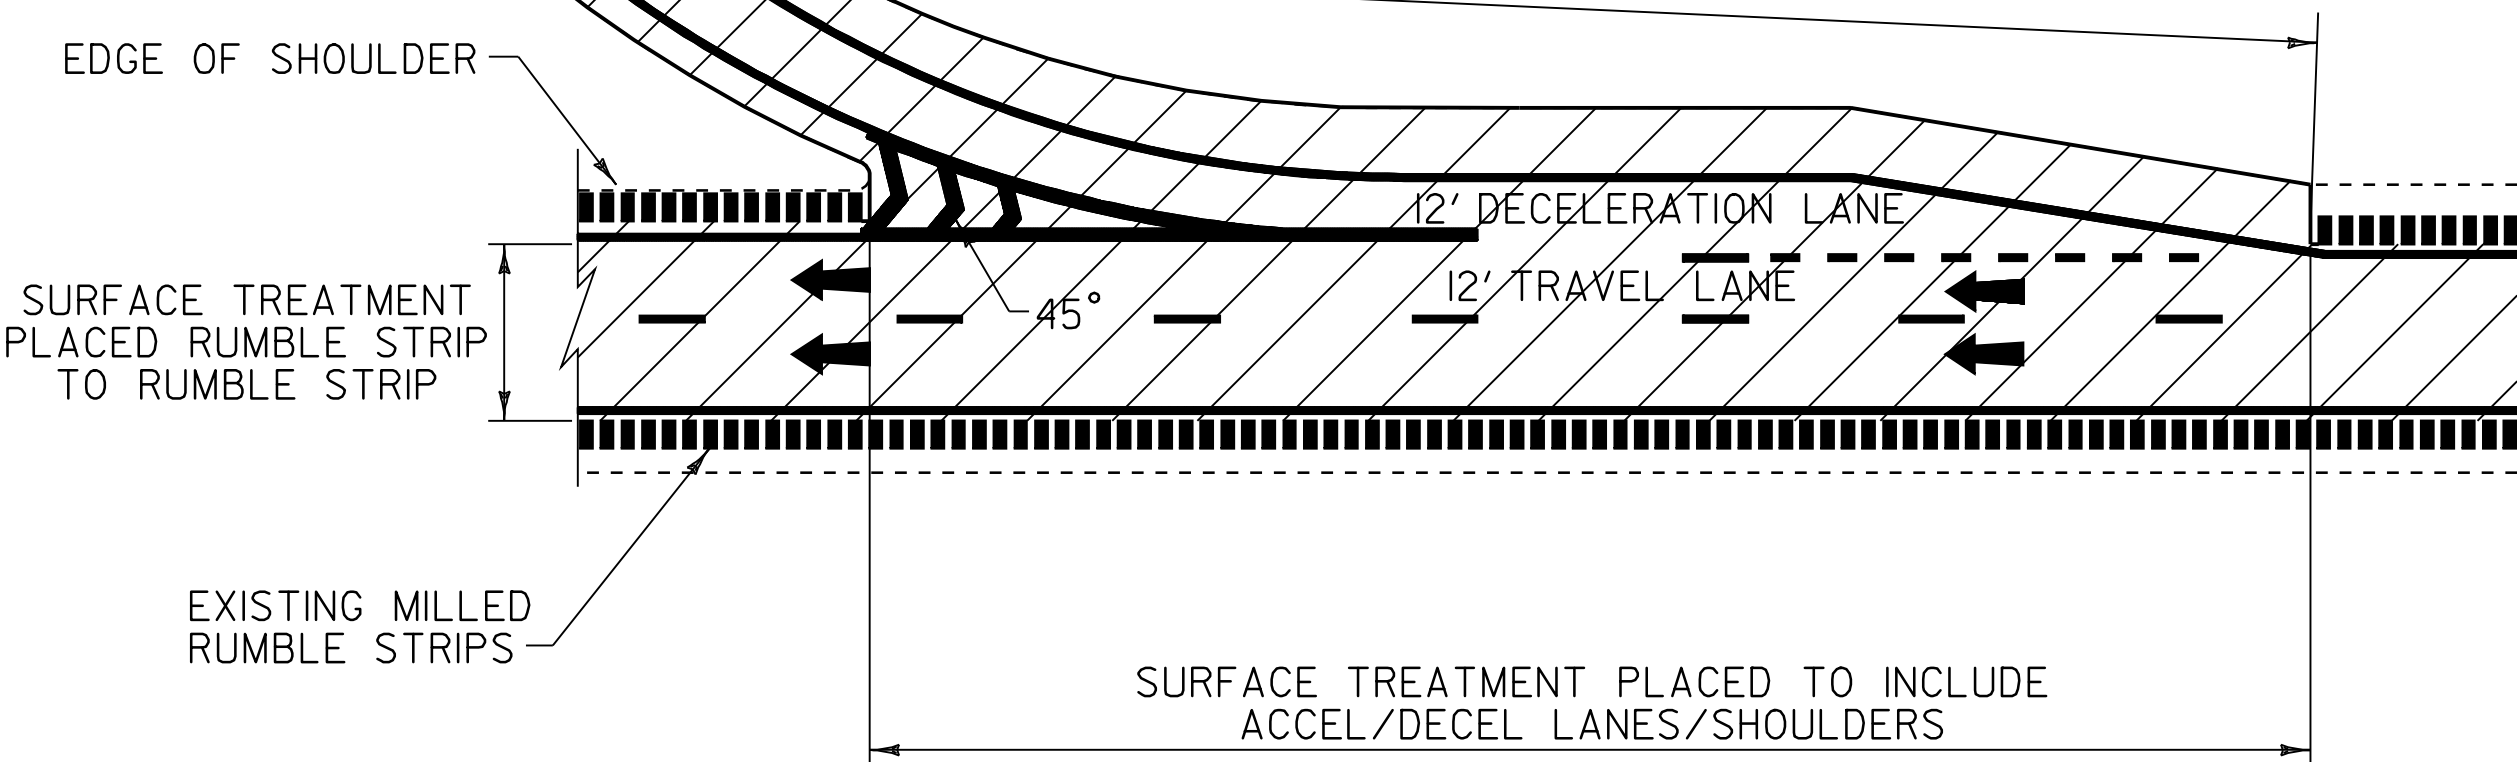

EXIT 7 OFF RAMP CONSTRUCTION DETAILS

LEGEND

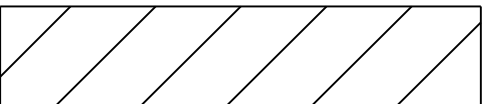

AREA OF PAVER PLACED SURFACE TREATMENT TYPE C



DIRECTION OF TRAFFIC FLOW



EXISTING MILLED RUMBLE STRIPS

NOT TO SCALE

TYPICAL CONSTRUCTION DETAIL SHEET 1

|                                    |                              |       |
|------------------------------------|------------------------------|-------|
| PROJECT NAME:                      | ROCKINGHAM - SPRINGFIELD     |       |
| PROJECT NUMBER:                    | IM SURF (10)                 |       |
| FILE NAME: ...08A150\...08A150.dgn | PLOT DATE: 02-AUG-2010 14:41 |       |
| PROJECT LEADER: DOMEY              | DRAWN BY: HUNT               |       |
| DESIGNED BY: HUNT                  | CHECKED BY: PAVT MGMT        |       |
| IPARM FILE NAME: 08A150_06.1       | SHEET 6                      | OF 12 |