
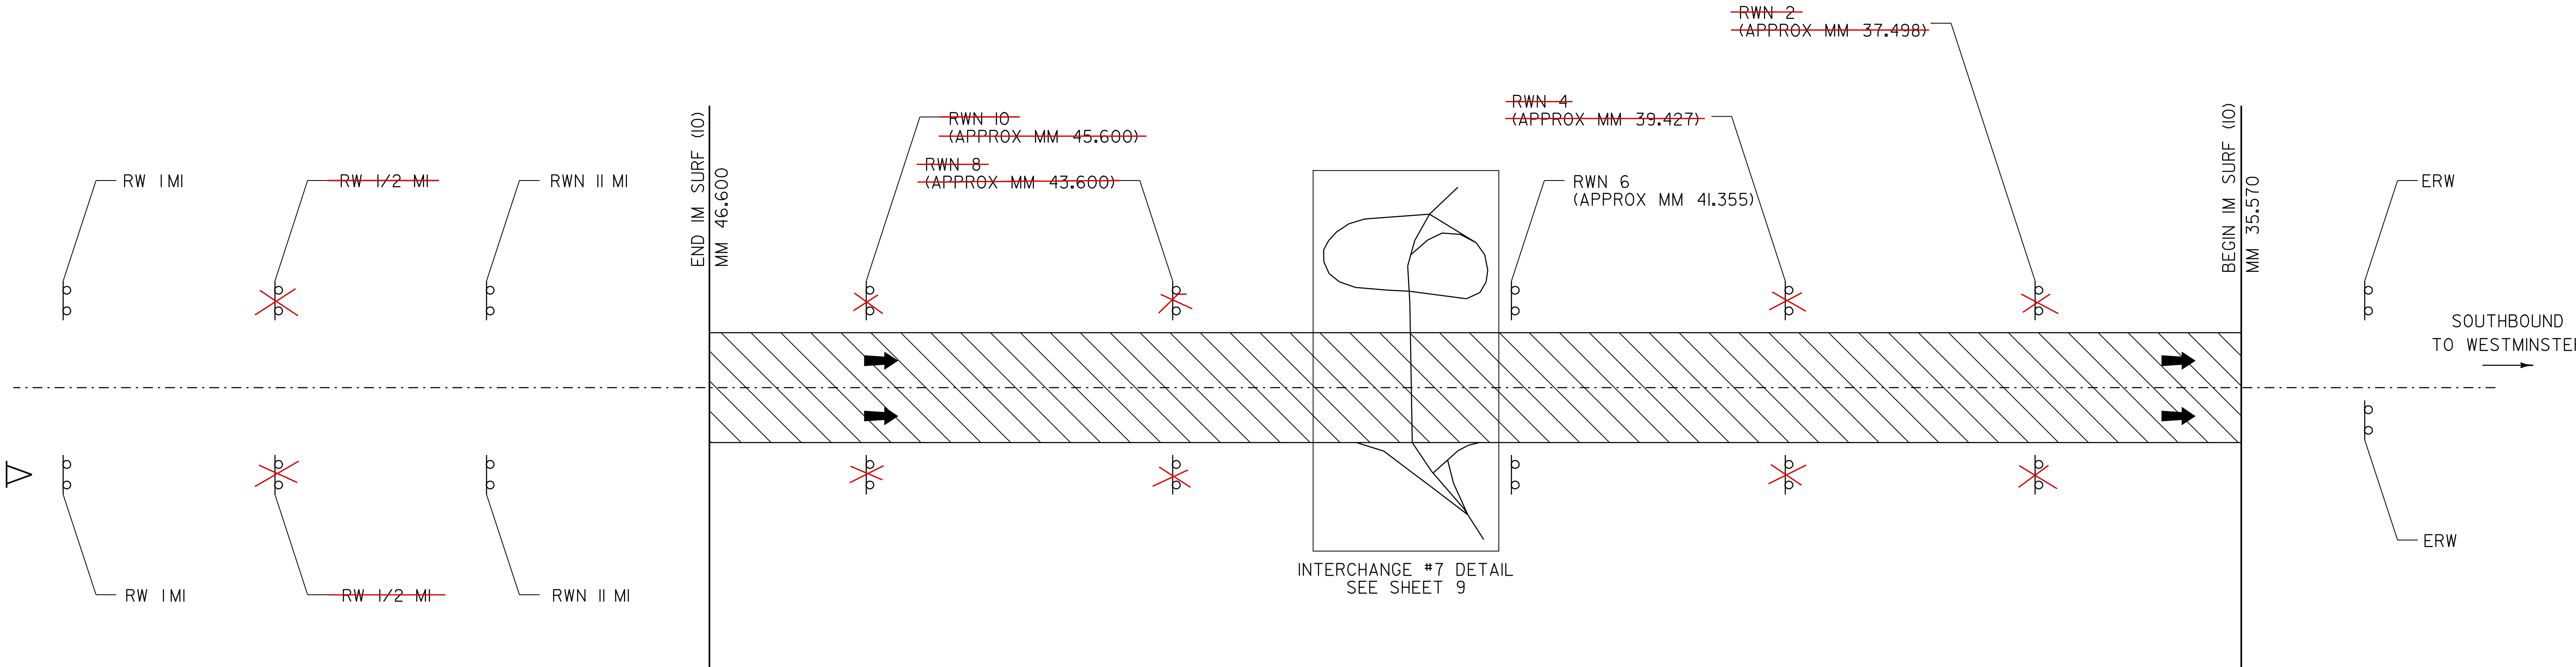


BEGIN /END PROJECT
CONSTRUCTION APPROACH SIGNING

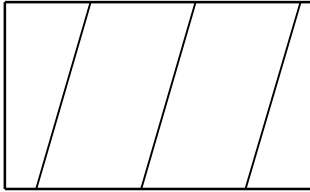

- LEGEND
- RWN = ROAD WORK NEXT (X MILES)
 - ERW = END ROAD WORK
 - RW 1 MI = ROAD WORK IN 1 MILE
 - ~~RW 1/2 MI~~ = ~~ROAD WORK IN 1/2 MILE~~
 -  = PORTABLE CHANGEABLE MESSAGE SIGN
 -  = WORK AREA
 -  = DIRECTION OF TRAFFIC FLOW

NOT TO SCALE

CONSTRUCTION
APPROACH
SIGNING
SHEET

PROJECT NAME: ROCKINGHAM - SPRINGFIELD
PROJECT NUMBER: IM SURF (10)

FILE NAME: ...08A150\...08A150.dgn
PROJECT LEADER: DOMEY
DESIGNED BY: HUNT
IPARM FILE NAME: 08A150_08.1
PLOT DATE: 02-AUG-2010 14:19
DRAWN BY: HUNT
CHECKED BY: PAVT MGMT
SHEET 8 OF 12