




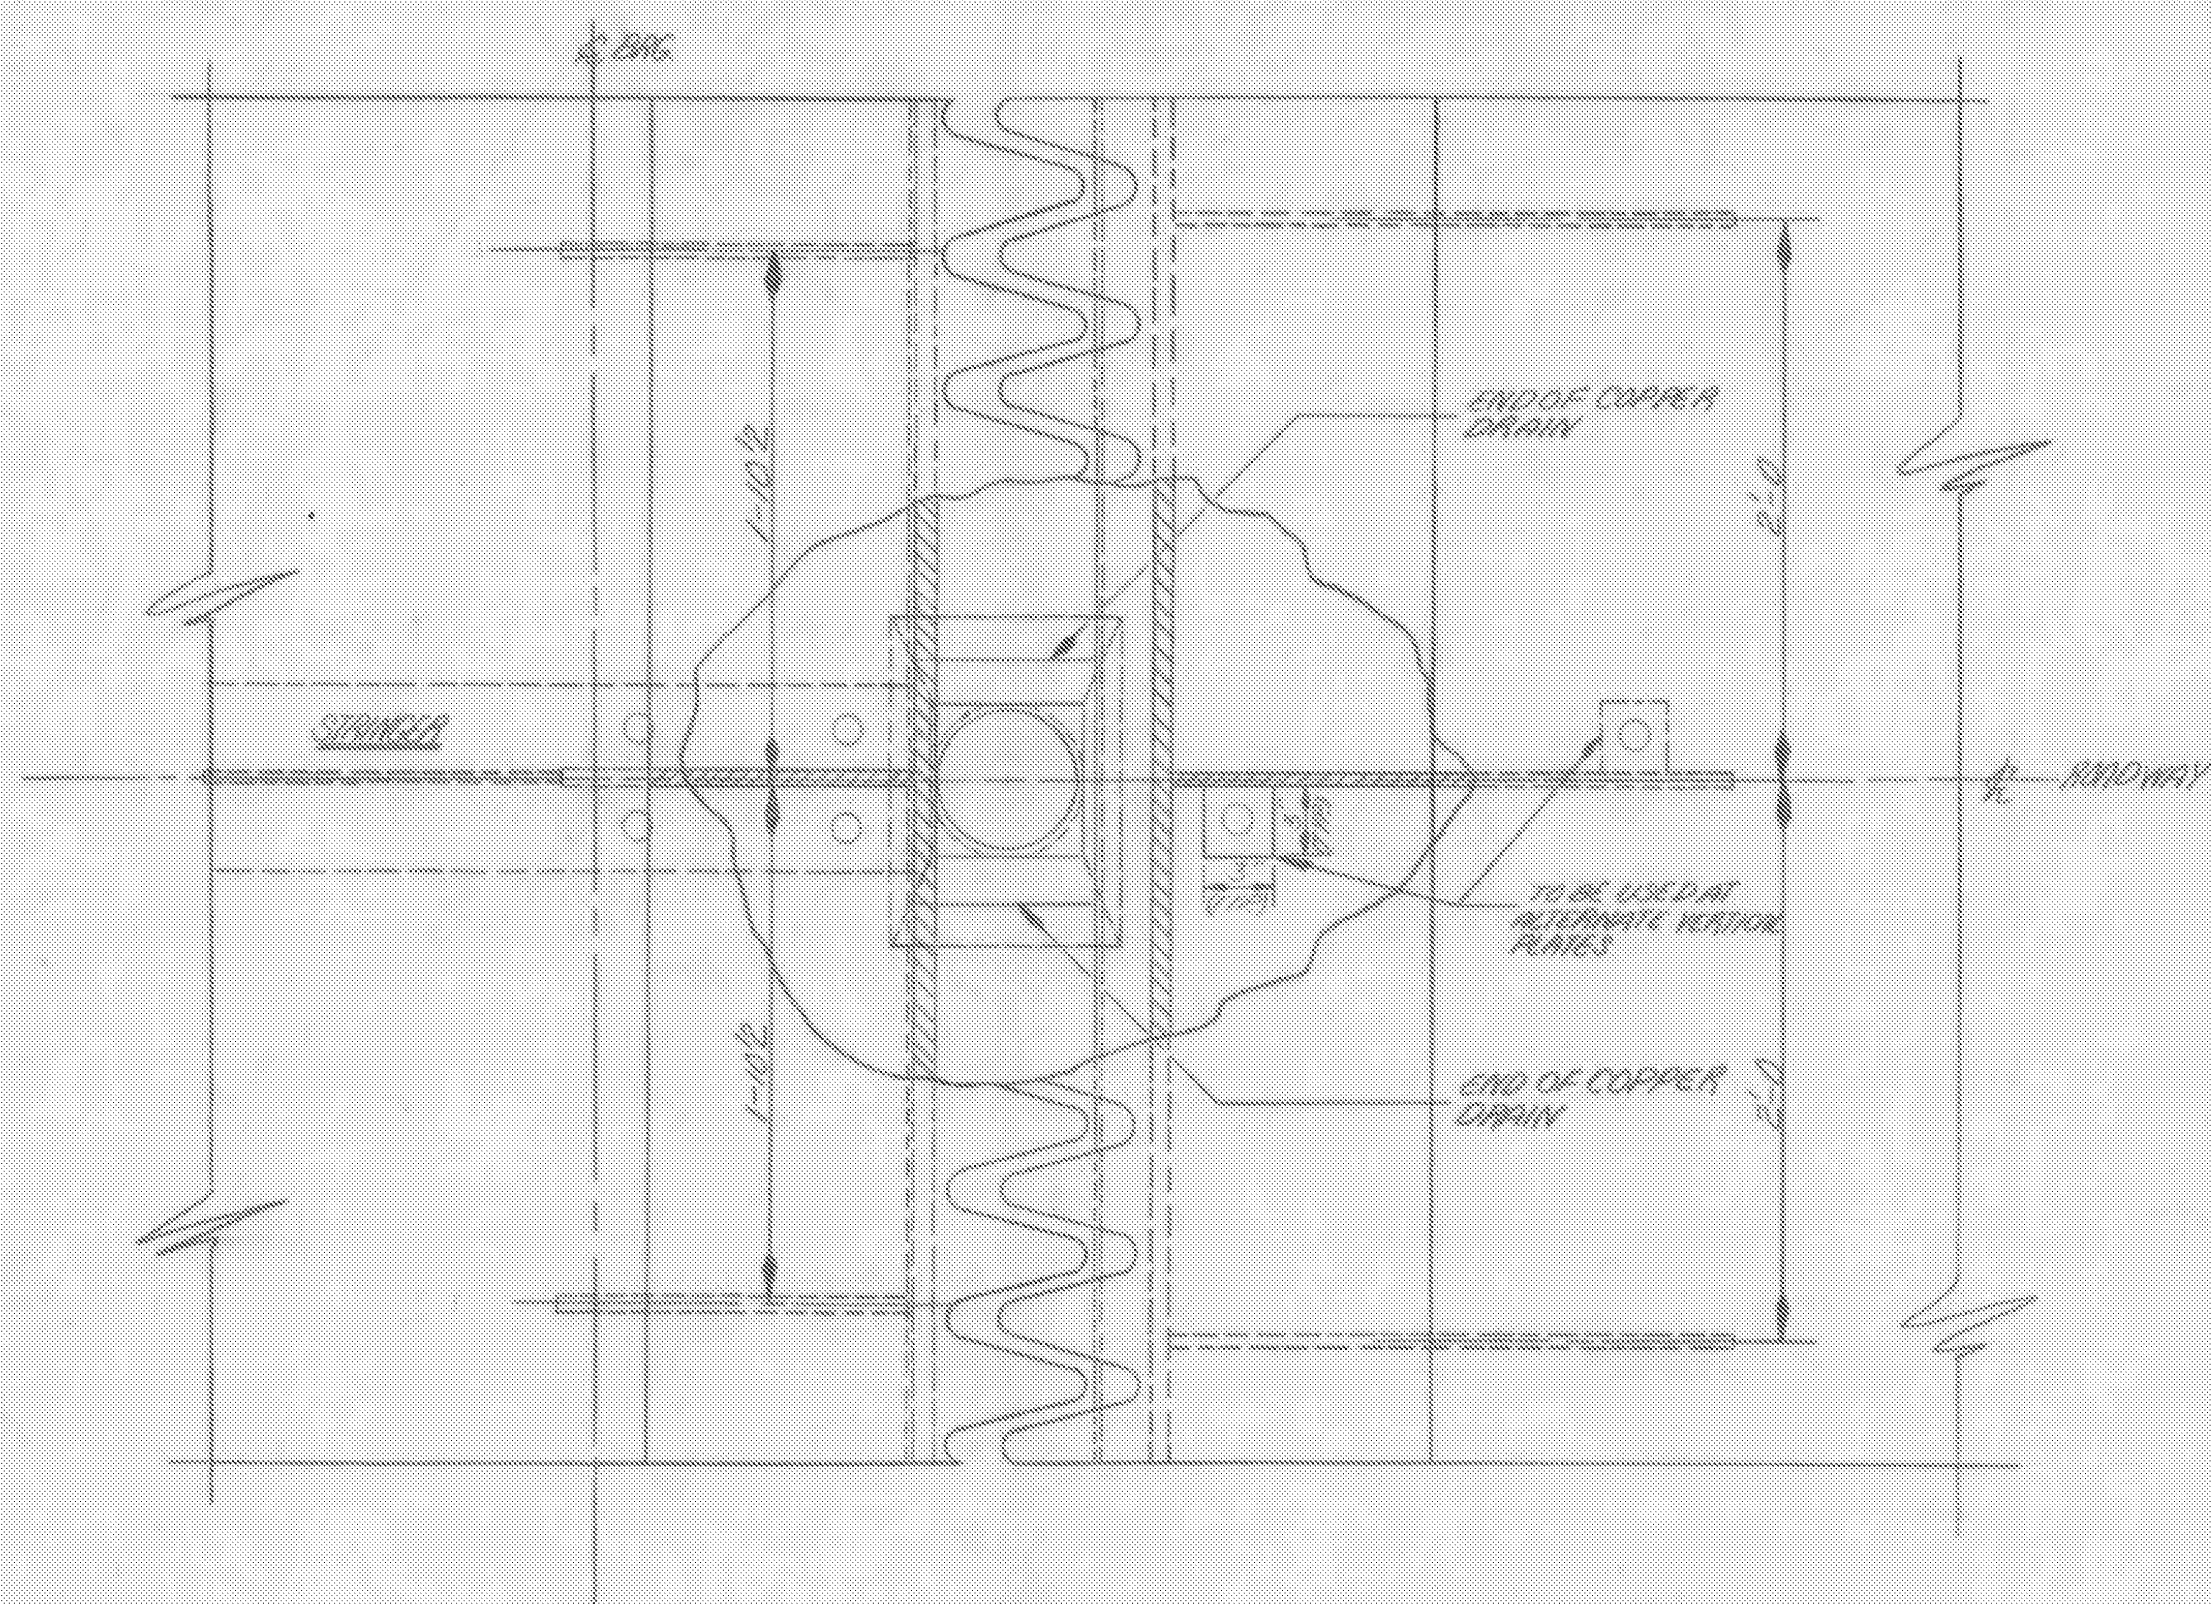


PLAN AT C. OF ROADWAY

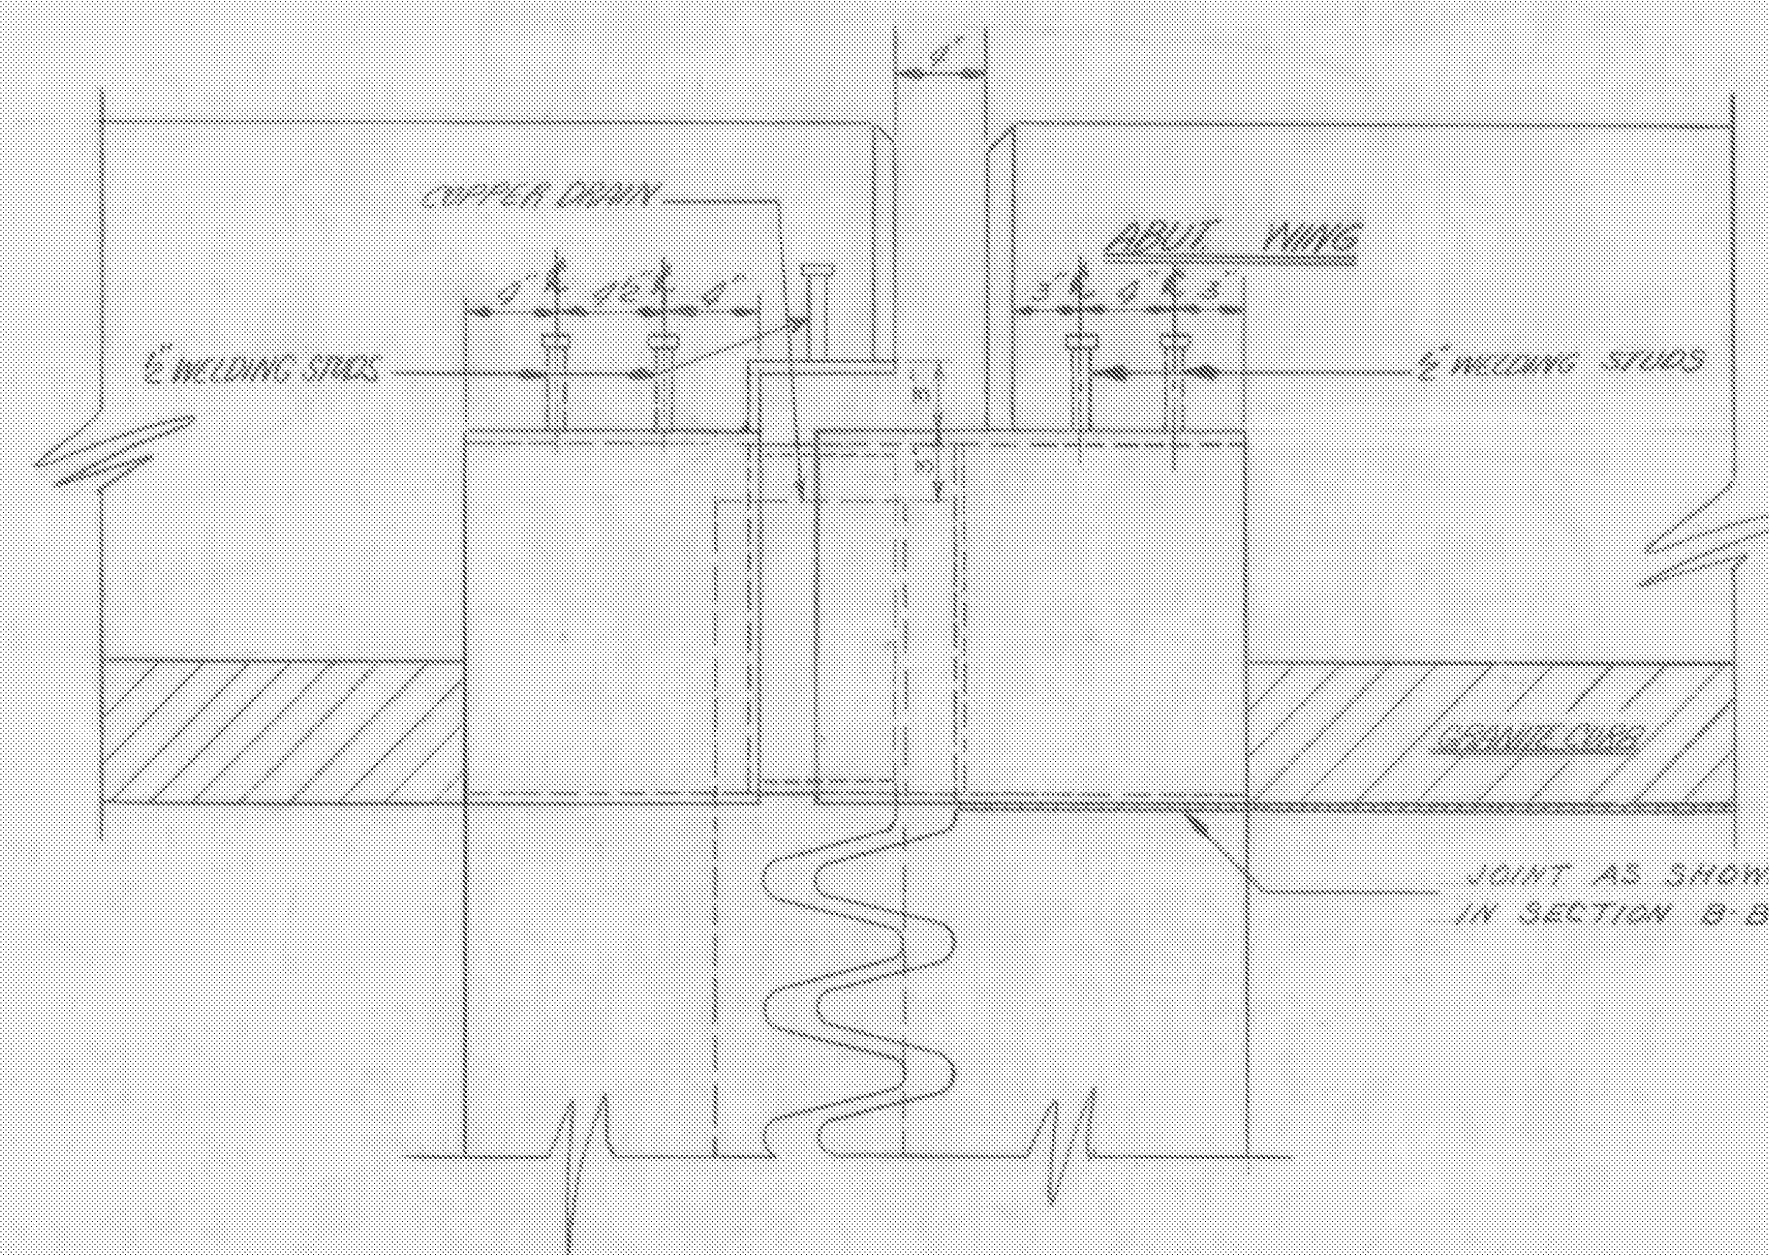


PLAN AT CURB

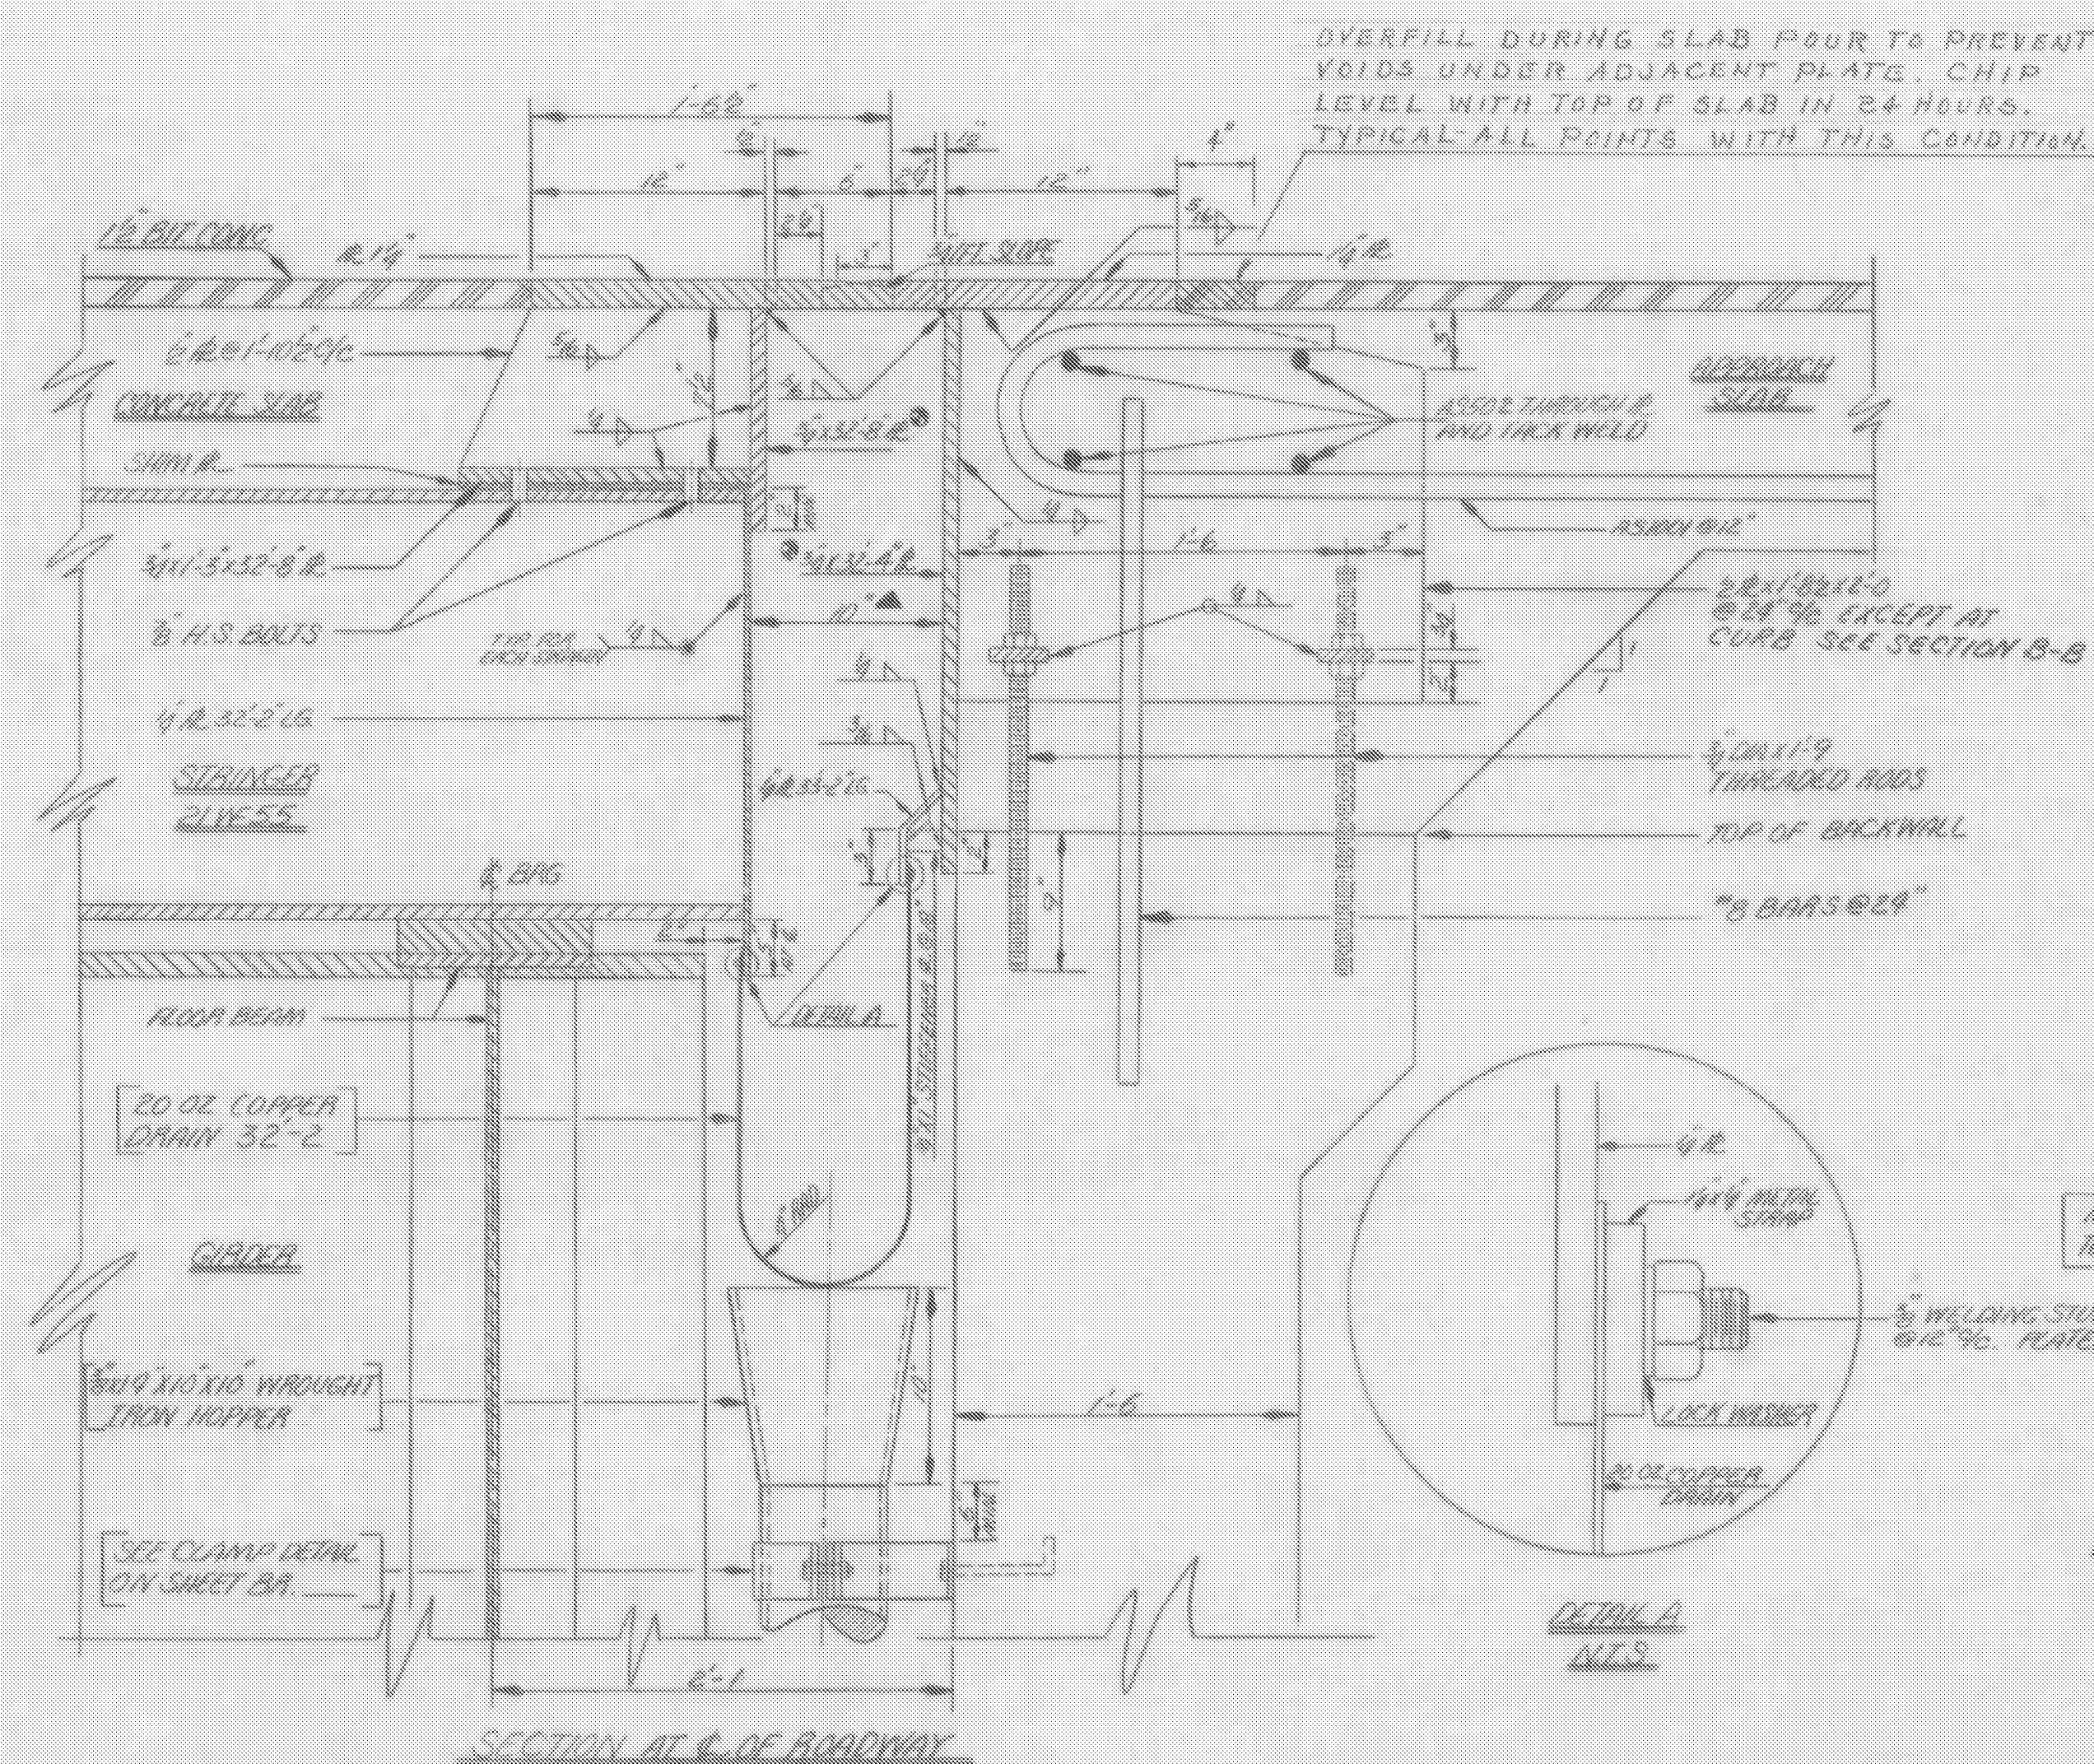

SECTION AT C. OF ROADWAY

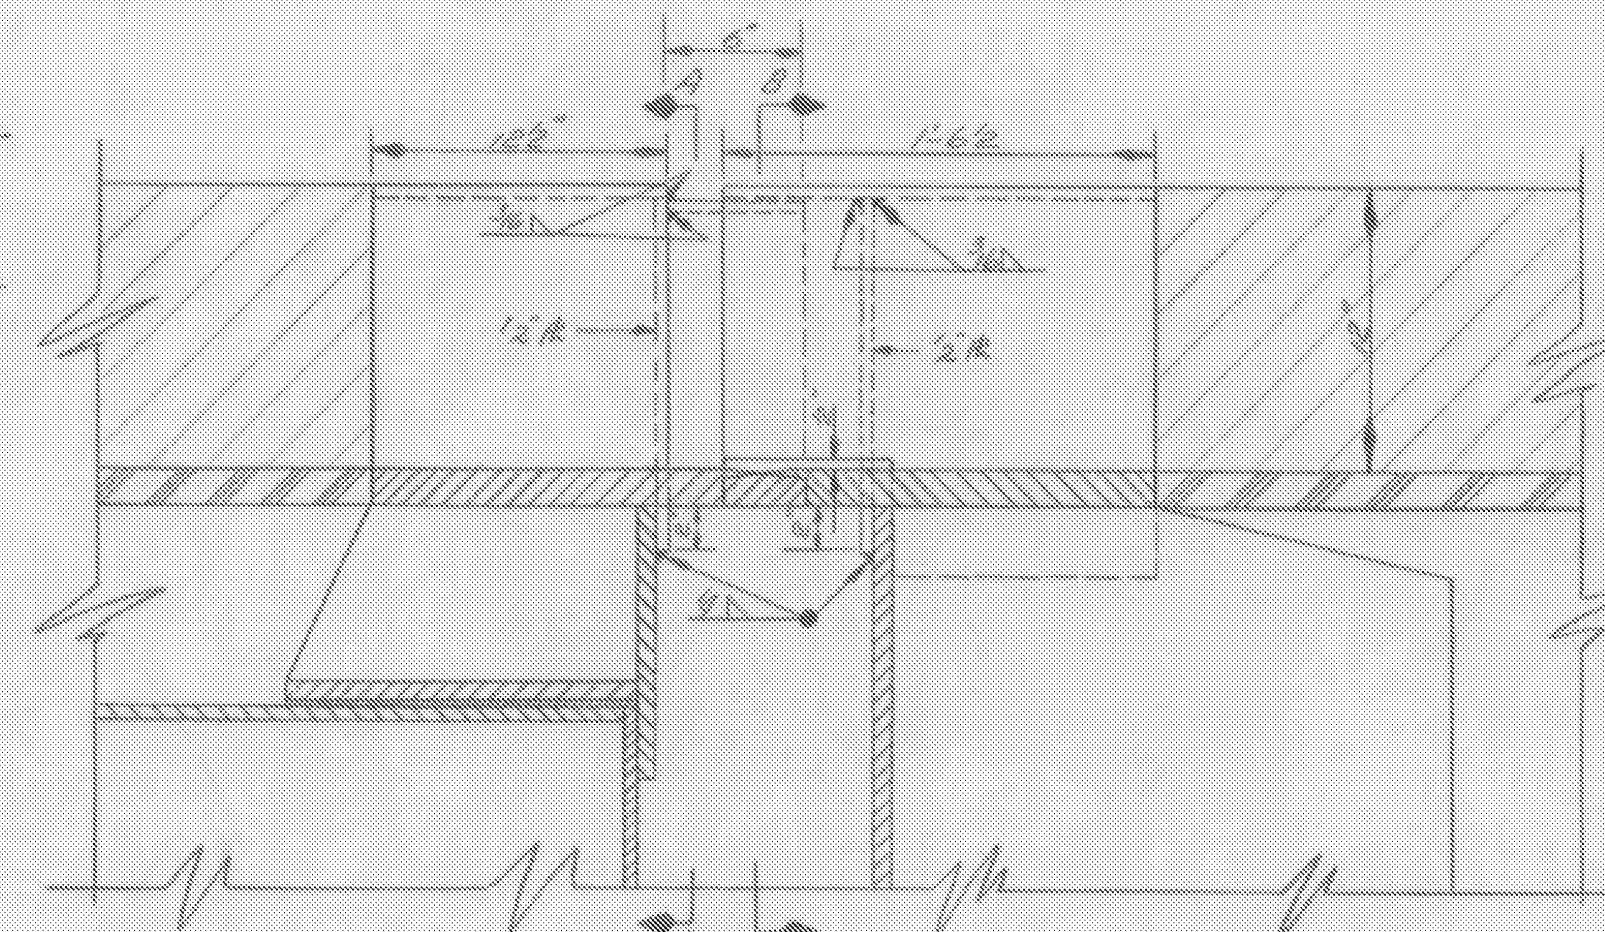


SECTION AT CURB

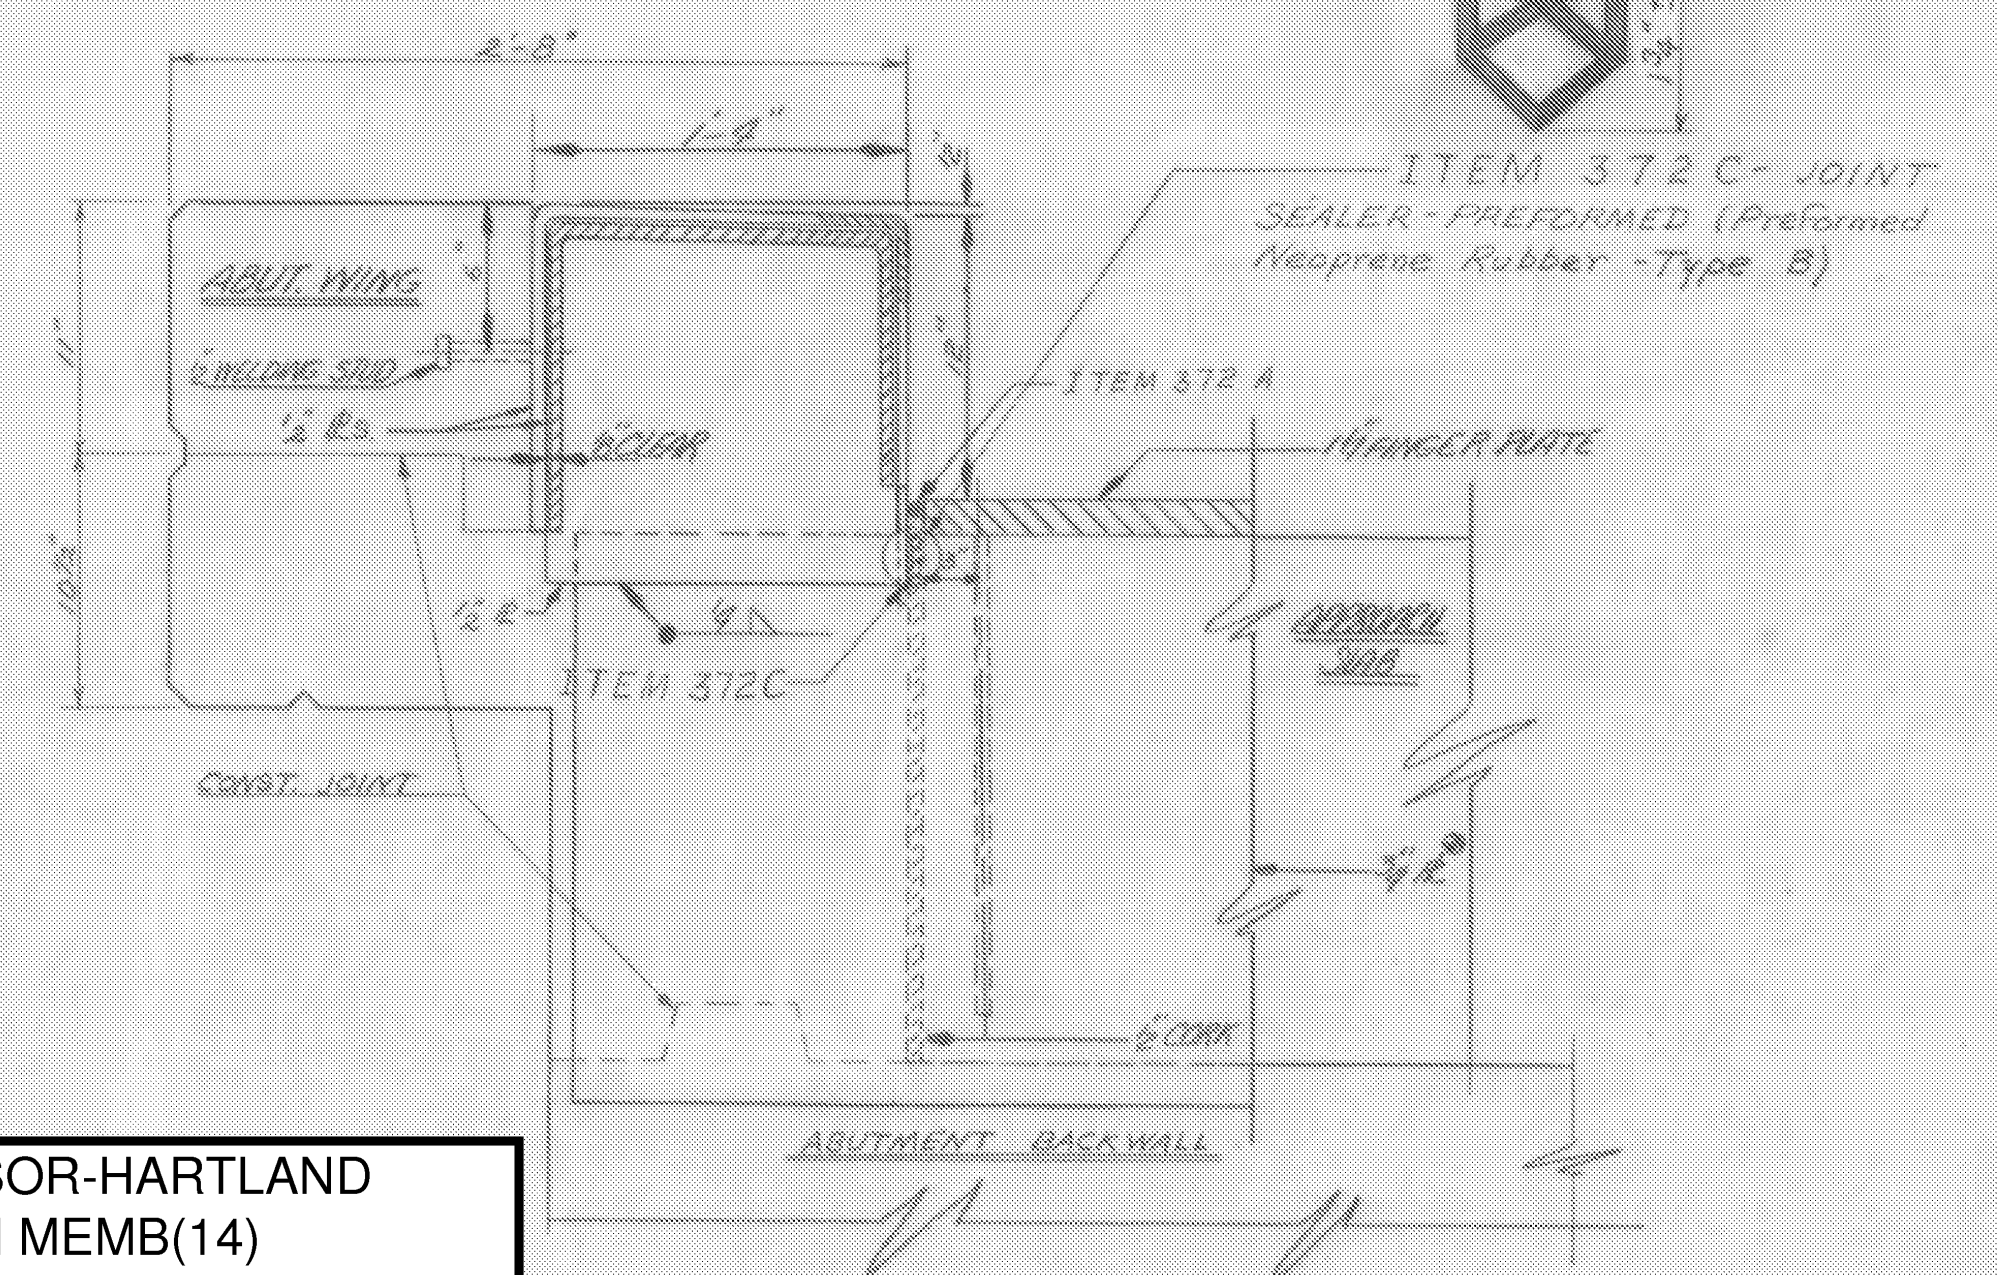

SECTION B-B

WINDSOR-HARTLAND
IM MEMB(14)

SHEET 38 OF 39
BRIDGE 40S
FOR REFERENCE ONLY

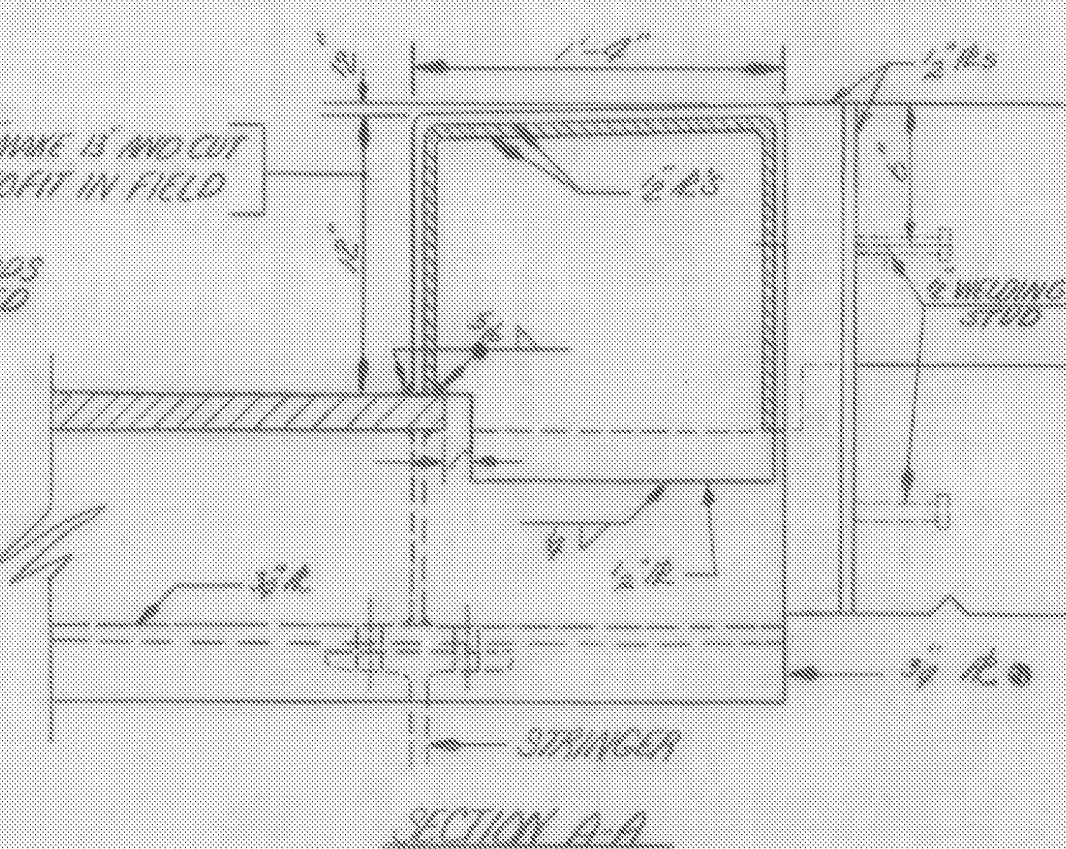

SECTION A-A

ITEM NO.	ITEM	UNIT	NET	TOTAL	FINAL
1	CHAN. EXCAV. OF EARTH	C.Y.			
2	CHAN. EXCAV. OF ROCK	C.Y.			
3	UNCLAS. CHAN. EXCAV.	C.Y.			
4	STRUCT. EXCAV.	C.Y.			
5	CONC. CLASS AA (MOD.)	C.Y.			
6	CONC. CLASS B (MOD.)	C.Y.			
7	REINF. STEEL	LBS.			
8	ASPHALTIC-ARB. COATING	S.Y.			
9	TREATED TIMBER PILING	L.F.			
10	SPLICES FOR STEEL PILING	EA.			
11	STEEL PILING	L.F.			
12	UNTREATED TIMBER PILING	L.F.			

BR. 211 OF 222

STATE OF VERMONT
DEPARTMENT OF HIGHWAYS

TOWN OF HARTLAND - HARTFORD

ROAD NO. BRIDGE NO.

I-91 OVER THE OTHAQUECHEE RIVER

EXPANSION DAM DETAILS

SCALE 1/2" = 1'-0"

SURVEYED BY

DRAWN BY SHS

CHECKED BY RLO

PROJECT NO. I-91-100-000-03(1)

Sheet 170 of 242