

BRIDGE NO.	A(FT)	B(FT)
43 SOUTH 57	37.0	36.0
48 SOUTH	27.0	29.0
49 SOUTH	20.0	20.0
50 SOUTH	37.0	36.0
43 NORTH	43.0	16.0

40'


(DRIVING LANE ONLY)

BRIDGE LENGTH AND WIDTH (CURB TO CURB)

BRIDGE NO.	WIDTH (CURB TO CURB) (FEET)	LENGTH (FEET)
43 NORTH	32.00	175.11
43 SOUTH	32.00	205.29
45 SOUTH	42.00	115.88
46 NORTH	30.00	356.67
46 SOUTH	30.00	356.67
46A	22.00	434.00
48 SOUTH	32.00	300.70
49 SOUTH	44.00	100.73
50 NORTH	32.00	237.87
50 SOUTH	32.00	224.73

ASPHALTIC PLUG JOINT REPLACEMENT SCHEDULE


BRIDGE NO.	ABUT. 1	PIER 1	PIER 2	PIER 3	PIER 4	ABUT. 2
43 SOUTH	--	--	--	--	--	45.25 46 FT
45 SOUTH	--	42.24 FT	--	--	--	--
46 NORTH	19 FT --	38.08 --	3.5 --	--	31.08 31 FT	--
46 SOUTH	36.75 37 FT	38 FT	38.34 39 FT	40.67 40 FT	41.16 41 FT	45.25 --
46A	--	22 FT	6.58 --	--	--	--
48 SOUTH	--	--	--	--	--	36.37 FT
49 SOUTH	44.16 44 FT	--	--	--	--	--
50 SOUTH	--	--	--	--	--	45.25 46 FT
43 NORTH	45.42 FT	--	--	--	--	--

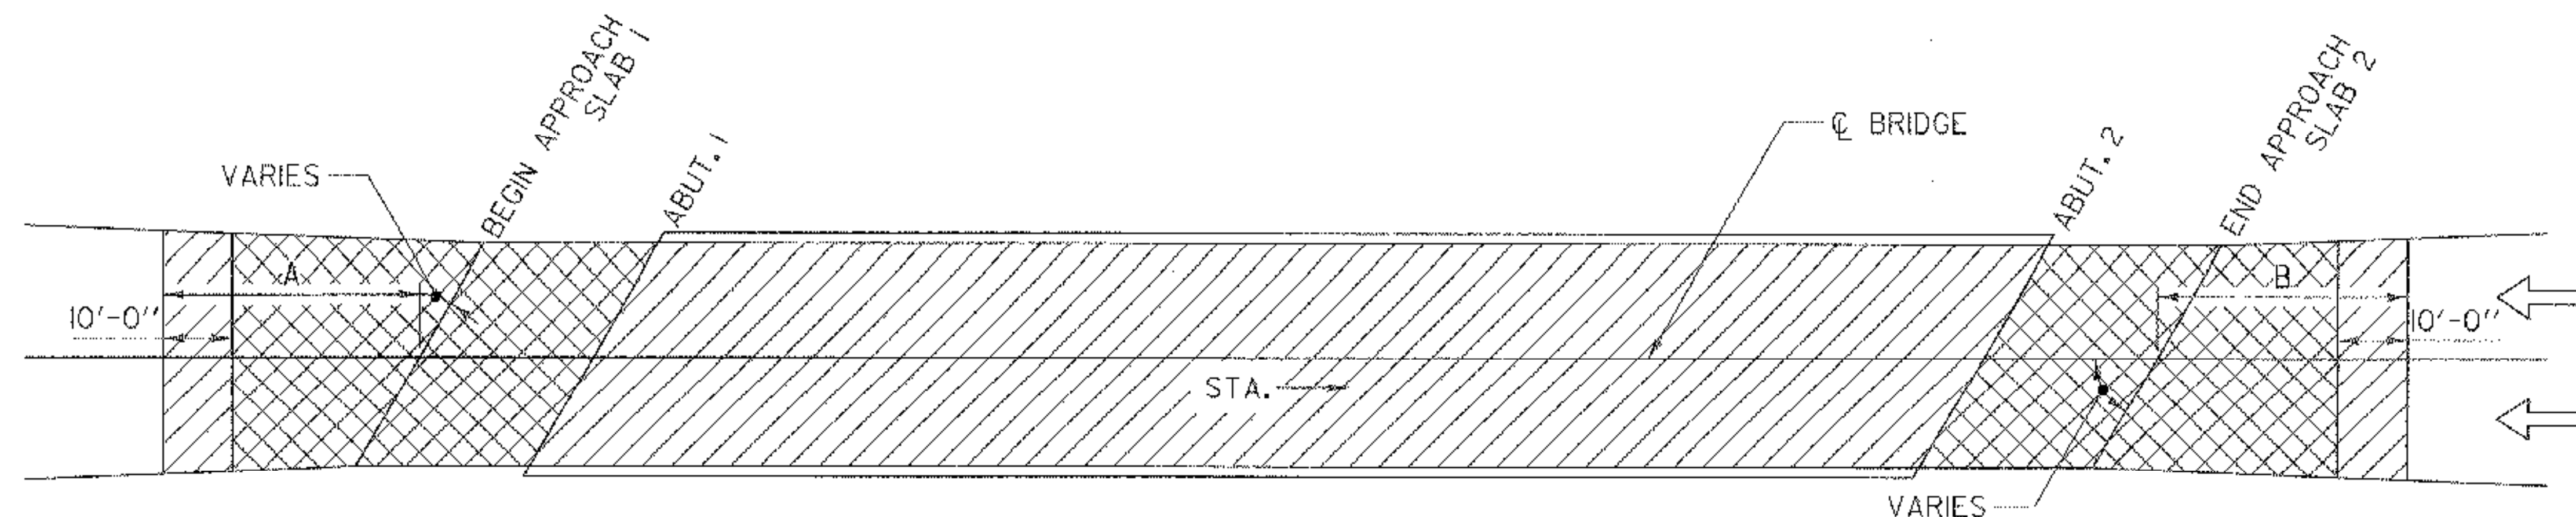

- ← FLOW OF TRAFFIC
- ▨ COLD PLANE - 1 1/4"
- ▩ COLD PLANE - 2 1/2" REMOVE BARRIER MEMBRANE ON APPROACH SLAB.

BRIDGES 43S, 48S, 49S & 50S BITUMINOUS CONCRETE REMOVAL & REPLACEMENT PLAN

NOT TO SCALE

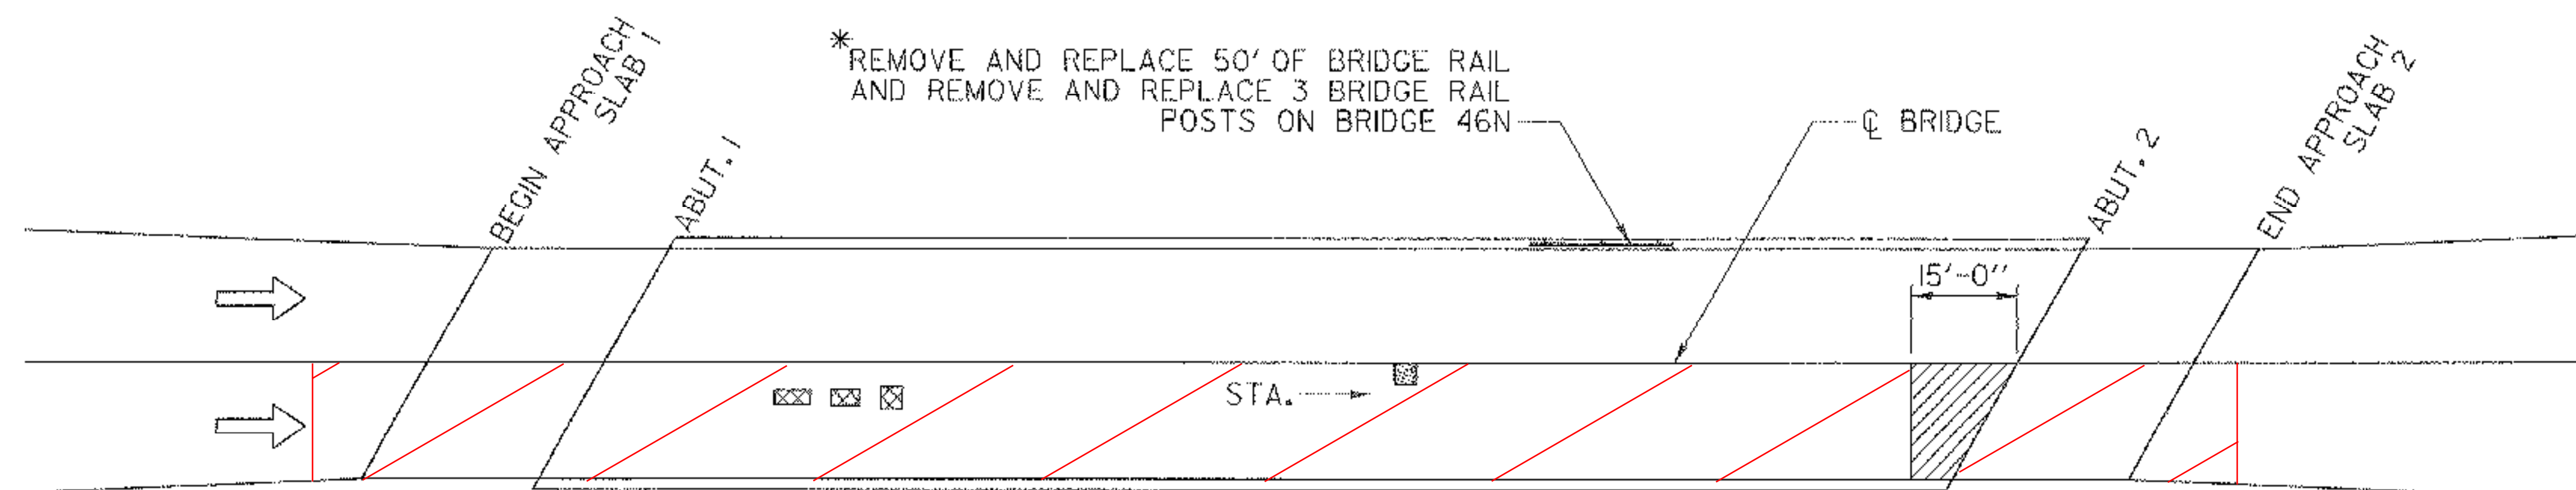

- ← FLOW OF TRAFFIC
- ▨ COLD PLANE - 1 1/4" ON BRIDGE 43N
- ▩ REPAIR POT HOLES ON BRIDGE 46N
- ▩ REPAIR POT HOLE ON BRIDGE 50N
- * - SEE NOTE 4 ON SHEET 6.

BRIDGES 43N, 46N & 50N BITUMINOUS CONCRETE REMOVAL & REPLACEMENT PLAN

NOT TO SCALE



PROJECT NAME:	MIDDLESEX - WATERBURY
PROJECT NUMBER:	ST-IM 089-2(42)
FILE NAME:	...drawing\Cono Remov Plan.dgn
PROJECT LEADER:	G. BOGUE
DESIGNED BY:	S. HURBANK
DRAWN BY:	J. SOTER
CHECKED BY:	G. BOGUE
BITUMINOUS CONCRETE REMOVAL PLAN	SHEET 5 OF 25