



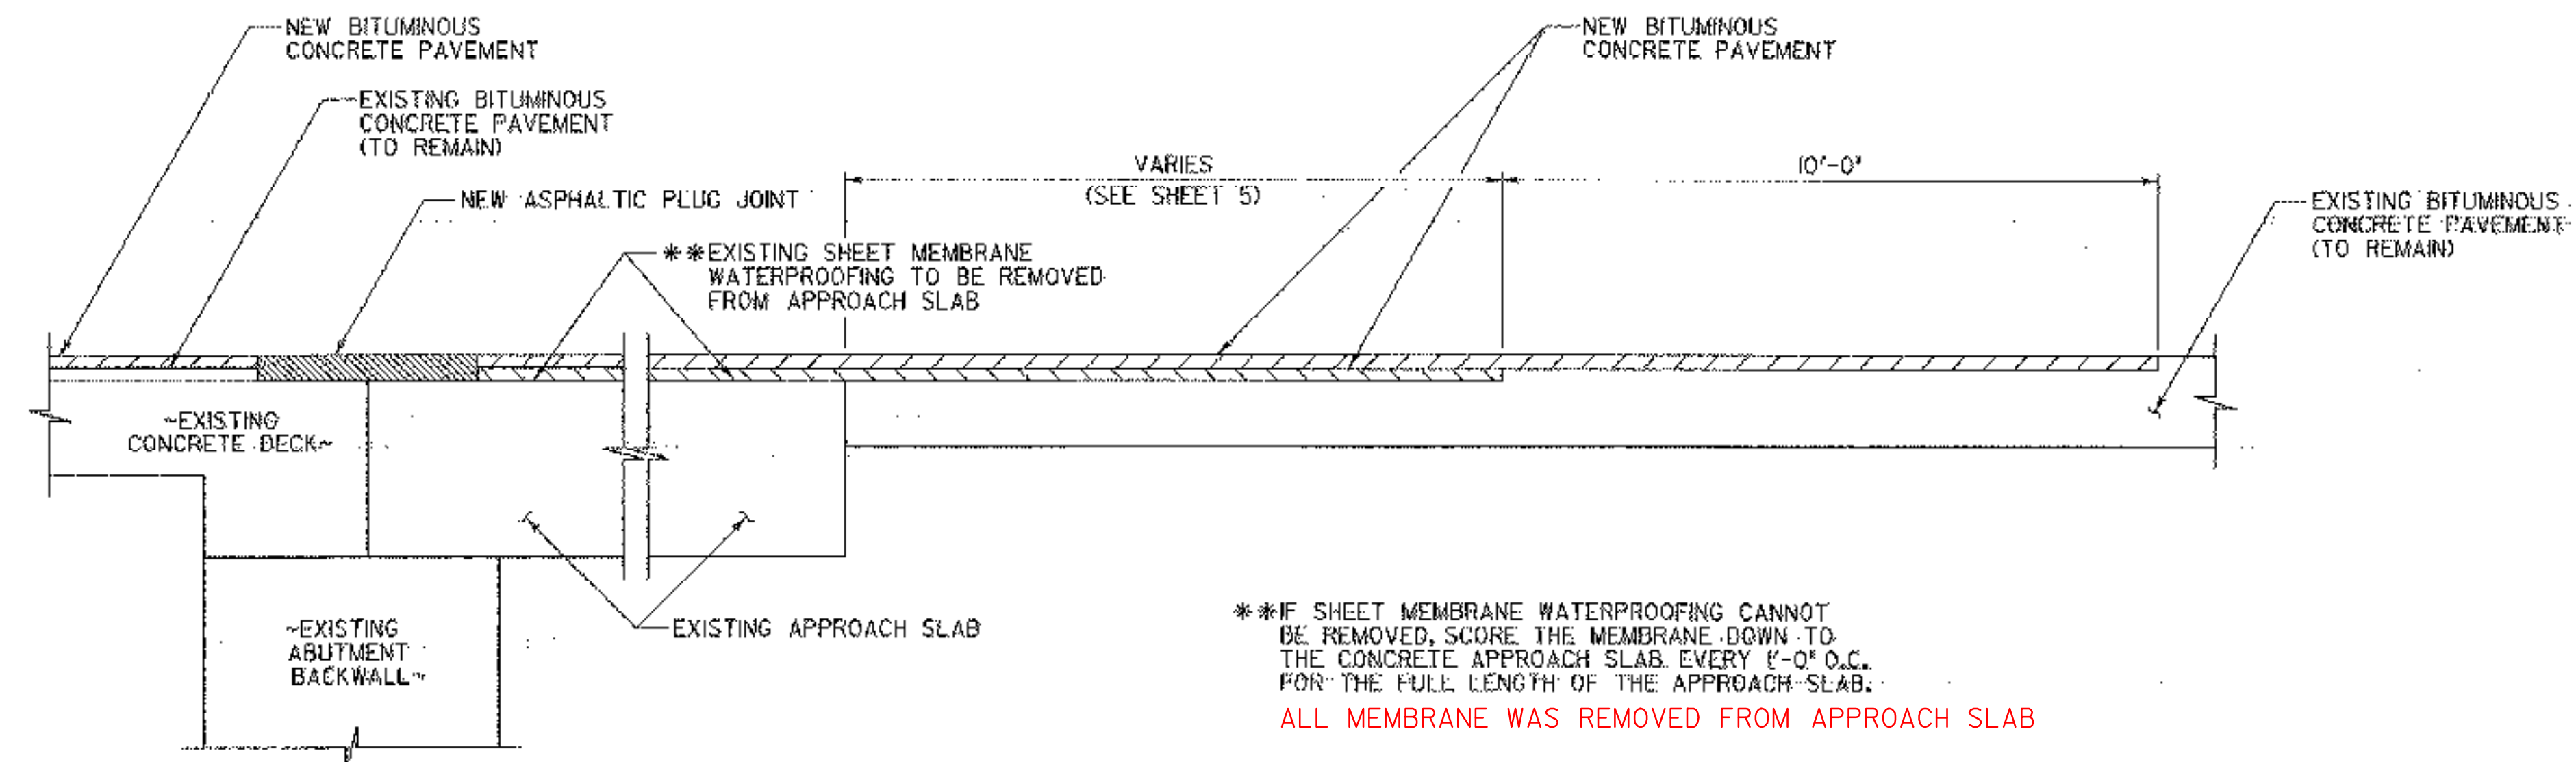

TYPICAL APPROACH SECTION
NOT TO SCALE

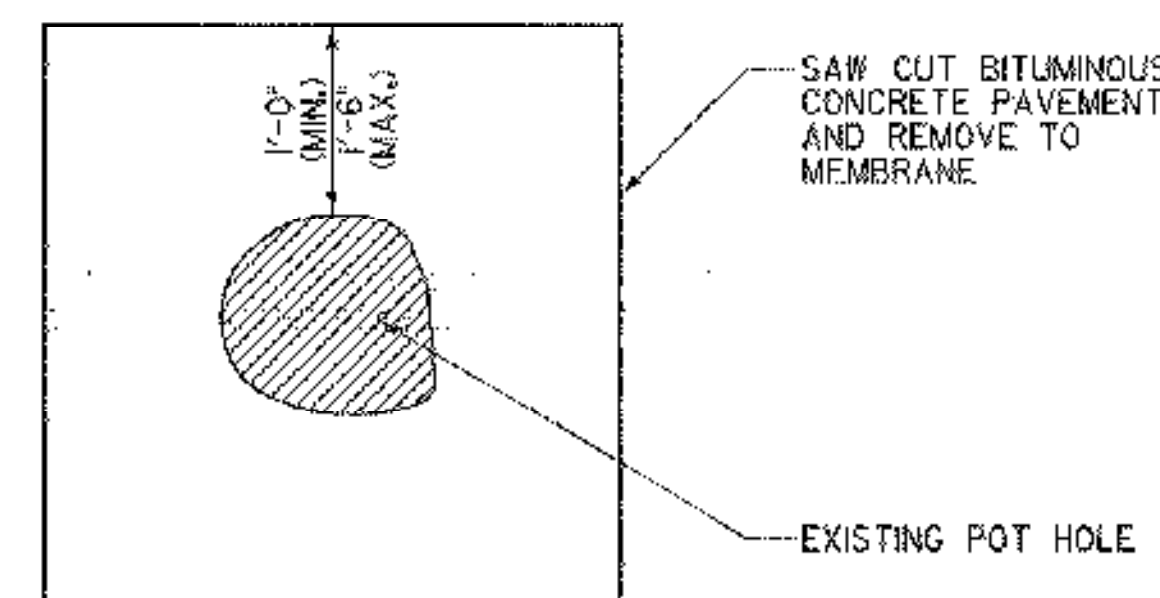

LIMITS OF SPECIAL PROVISION
(BRIDGE POT HOLE REPAIR)
NOT TO SCALE

NOTES:

1. SAW CUTTING OF THE BITUMINOUS CONCRETE PAVEMENT SHALL BE INCIDENTAL TO ITEM 529.10 "REMOVAL OF BRIDGE PAVEMENT".
2. SEE SECTION 900 OF THE PROJECT SPECIAL PROVISIONS FOR ADDITIONAL INFORMATION AND REQUIREMENTS FOR BRIDGE POT HOLE REPAIR.

PROJECT NOTES

GENERAL

1. ALL MATERIALS AND CONSTRUCTION SHALL CONFORM TO: STATE OF VERMONT, AGENCY OF TRANSPORTATION, 2006 STANDARD SPECIFICATIONS FOR CONSTRUCTION, AND ITS LATEST REVISIONS, AND THE AASHTO STANDARD SPECIFICATIONS FOR HIGHWAY BRIDGES, DATED 2002, AND ITS LATEST REVISIONS.
2. ALL WORK AND ANY ASSOCIATED ACTIVITY ON THIS PROJECT SHALL BE PERFORMED WITHIN THE EXISTING RIGHT-OF-WAY LIMITS.
3. WATER REPELLENT, SILANE SHALL BE APPLIED TO ALL EXPOSED CONCRETE SURFACES, EXCEPT THE PIERS AND THE UNDERSIDE OF THE DECK.
4. REMOVAL AND REPLACEMENT OF THE TWO RAIL BOX BEAM BRIDGE RAIL AND THE THREE POSTS ON BRIDGE 46N WILL BE PAID FOR UNDER ITEM 900.640, "SPECIAL PROVISION (BRIDGE RAILING REPAIR, TYPE IV). SEE STANDARD SB-R4A-82 AND SPECIAL PROVISION FOR ADDITIONAL INFORMATION. IF IT IS NECESSARY TO REMOVE ADDITIONAL UNDAMAGED BOX BEAM BRIDGE RAIL TO REPAIR THE DAMAGED RAIL, THEN THE COSTS OF REMOVING AND RESETTING THE UNDAMAGED RAIL WILL BE PAID FOR UNDER ITEMS 525.10 AND 525.11.

TRAFFIC CONTROL

5. UNLESS COVERED UNDER INDIVIDUAL PAY ITEMS, ALL COSTS FOR WORK SHOWN ON SHEETS 3 AND 4 AND FOR TEMPORARY TRAFFIC CONTROL DEVICES INCLUDING TRAFFIC BARRIERS, SIGNS, AND SIGN POSTS WILL BE CONSIDERED TO BE INCLUDED IN THE CONTRACT LUMP SUM PRICE FOR TRAFFIC CONTROL, ITEM 641.10.
6. THE CONTRACTOR WILL NOT BE ALLOWED TO REDUCE THE NUMBER OF TRAVEL LANES OR PERFORM ANY WORK ON BRIDGE 46N WHILE WORKING ON BRIDGE 46A (RAMP BRIDGE).



Stantec

PROJECT NAME: MIDDLESEX - WATERBURY
PROJECT NUMBER: ST-IM 089-2(42)

FILE NAME: ...drawing\Details and Notes.dgn PLOT DATE: 7/2/2008
PROJECT LEADER: G. BOGUE DRAWN BY: J. SOTER
DESIGNED BY: S. BURBANK CHECKED BY: G. BOGUE
BIT. CONCRETE DETAILS & NOTES SHEET 6 OF 25