

SHEET NO.	TITLE	PAGE
2	BRIDGE QUANTITY SHEET	
3-5	PLAN AND PROFILE SHEETS	
6	E-2 BARRICADES, SIGNS AND LIGHTS (BRIDGE)	
7	E-31 CONSTRUCTION IDENTIFICATION SIGNS	
8	J-1 MARKERS	
9	J-4 FIELD OFFICE	
10	PLAN AND ELEVATION—(1" = 50' SCALE)	
11-12	PLAN AND ELEVATION—(1" = 20' SCALE)	
13	GENERAL NOTES	
14	PRELIMINARY INFORMATION SHEET	
15-16	SCORINGS SHEETS	
17	FRAMING PLAN, DETAILS, TYPICAL CROSS-SECTION	
18	FRAMING PLAN, DETAILS	
19-22	GIRDER DETAILS	
23	MOMENT, DEAD LOAD DEFLECTION, SHEARS, REACTIONS	
24	ROADWAY EXPANSION DEVICE	
25	BLANK	
26	BEARING DEVICES	
27	ABUTMENT NO. 1 NB	
28	ABUTMENT NO. 1 SB	
29	ABUTMENT NO. 2 NB AND SB	
30	PIER NO. 1 NB AND SB	
31	PIER NO. 2 NB AND SB	
32	PIER NO. 3 NB AND SB	
33	PIER NO. 4 NB AND SB	
34	PIER NO. 5 NB AND SB	
35	PIER NO. 6 NB AND SB	
36	APPROACH SLABS NO. 1 AND NO. 2 NB AND SB	
37-40	REINFORCING STEEL DETAIL SHEETS	
41-42	CHANNEL SECTIONS	
43-60	ROADWAY CROSS SECTIONS	
	SCB-D6-62, DETAILS "B" AND "F"	
	SCB-D7-62, DETAIL "D"	
	SB-R1-64, SHEETS 1 AND 2	
	SB-R2-65	
	2A-B R.O.W. DETAILS	

STATE OF VERMONT DEPARTMENT OF HIGHWAYS Proposed Improvement

INTERSTATE PROJECT TOWN OF HARTFORD COUNTY OF WINDSOR INTERSTATE ROUTE 91 BELLOWS FALLS—BRADFORD ROAD STAGE I

BEGINNING AT A POINT 3.262 MILES NORTH OF THE HARTLAND-HARTFORD TOWN LINE AT NB STA 3763+89.50 AND EXTENDING NORTHERLY 0.225 MILE TO SB STA 3776+08.51
LENGTH OF BRIDGE NB 1198.02 FEET ± 0.225 MILE
SB 1178.01 FEET



ADT 1965	2000
ADT 1985	4860
DIV 1985	750
T	7%
D	51%
V	80

PROJECT NAME & NUMBER	TYPE	BRIDGE
HARTFORD I 91-2 (3)	CONT. WELDED PLATE GIRDER	
RECORD PLANS		
MATERIALS		

SUBBASE OF CRUSHED ROCK — SMITH L'HEUREUX QUARRY (PERINI CRUSHER) — HARTFORD, VT.
CONCRETE CLASS AA & B — MILLER'S READY MIX PLANT — W. LEBANON, N. H.
REINFORCING STEEL & STEEL PILING — BETHLEHEM STEEL CORP. — BETHLEHEM, PA.
STRUCTURAL STEEL — AMERICAN BRIDGE DIV. OF U.S. STEEL CORP. — NEW YORK, N. Y.
WATER REPELLENT — RUTLAND FIRE CLAY CO. — RUTLAND, VT.
BRIDGE RAILING — WARD WELLER CO., INC. — NATICK, MASS.
BITUMINOUS CONCRETE PAVEMENT — L. M. PIKE PIKE (PLANT) — W. LEBANON, N. H.
BRIDGE PAINT — THE VOLTAX CO., INC. — BRIDGEPORT, CT.
AMSTERDAM COLOR WORKS — NEW YORK, N. Y.

CONTRACTOR — E. T. O'NEILL & SON CONST. CORP. — HOLYOKE, MASS.
RESIDENT ENGINEER — THOMAS P. PINELLO.
INSPECTOR — P. PLUMB.
RECORD PLANS — A. A. PICHE & R. WEICHERT.

CONTRACT DATED — SEPTEMBER 27, 1965.
STARTED — OCTOBER 1, 1965.
COMPLETED — NOVEMBER 9, 1967.
ACCEPTED — NOVEMBER 9, 1967.

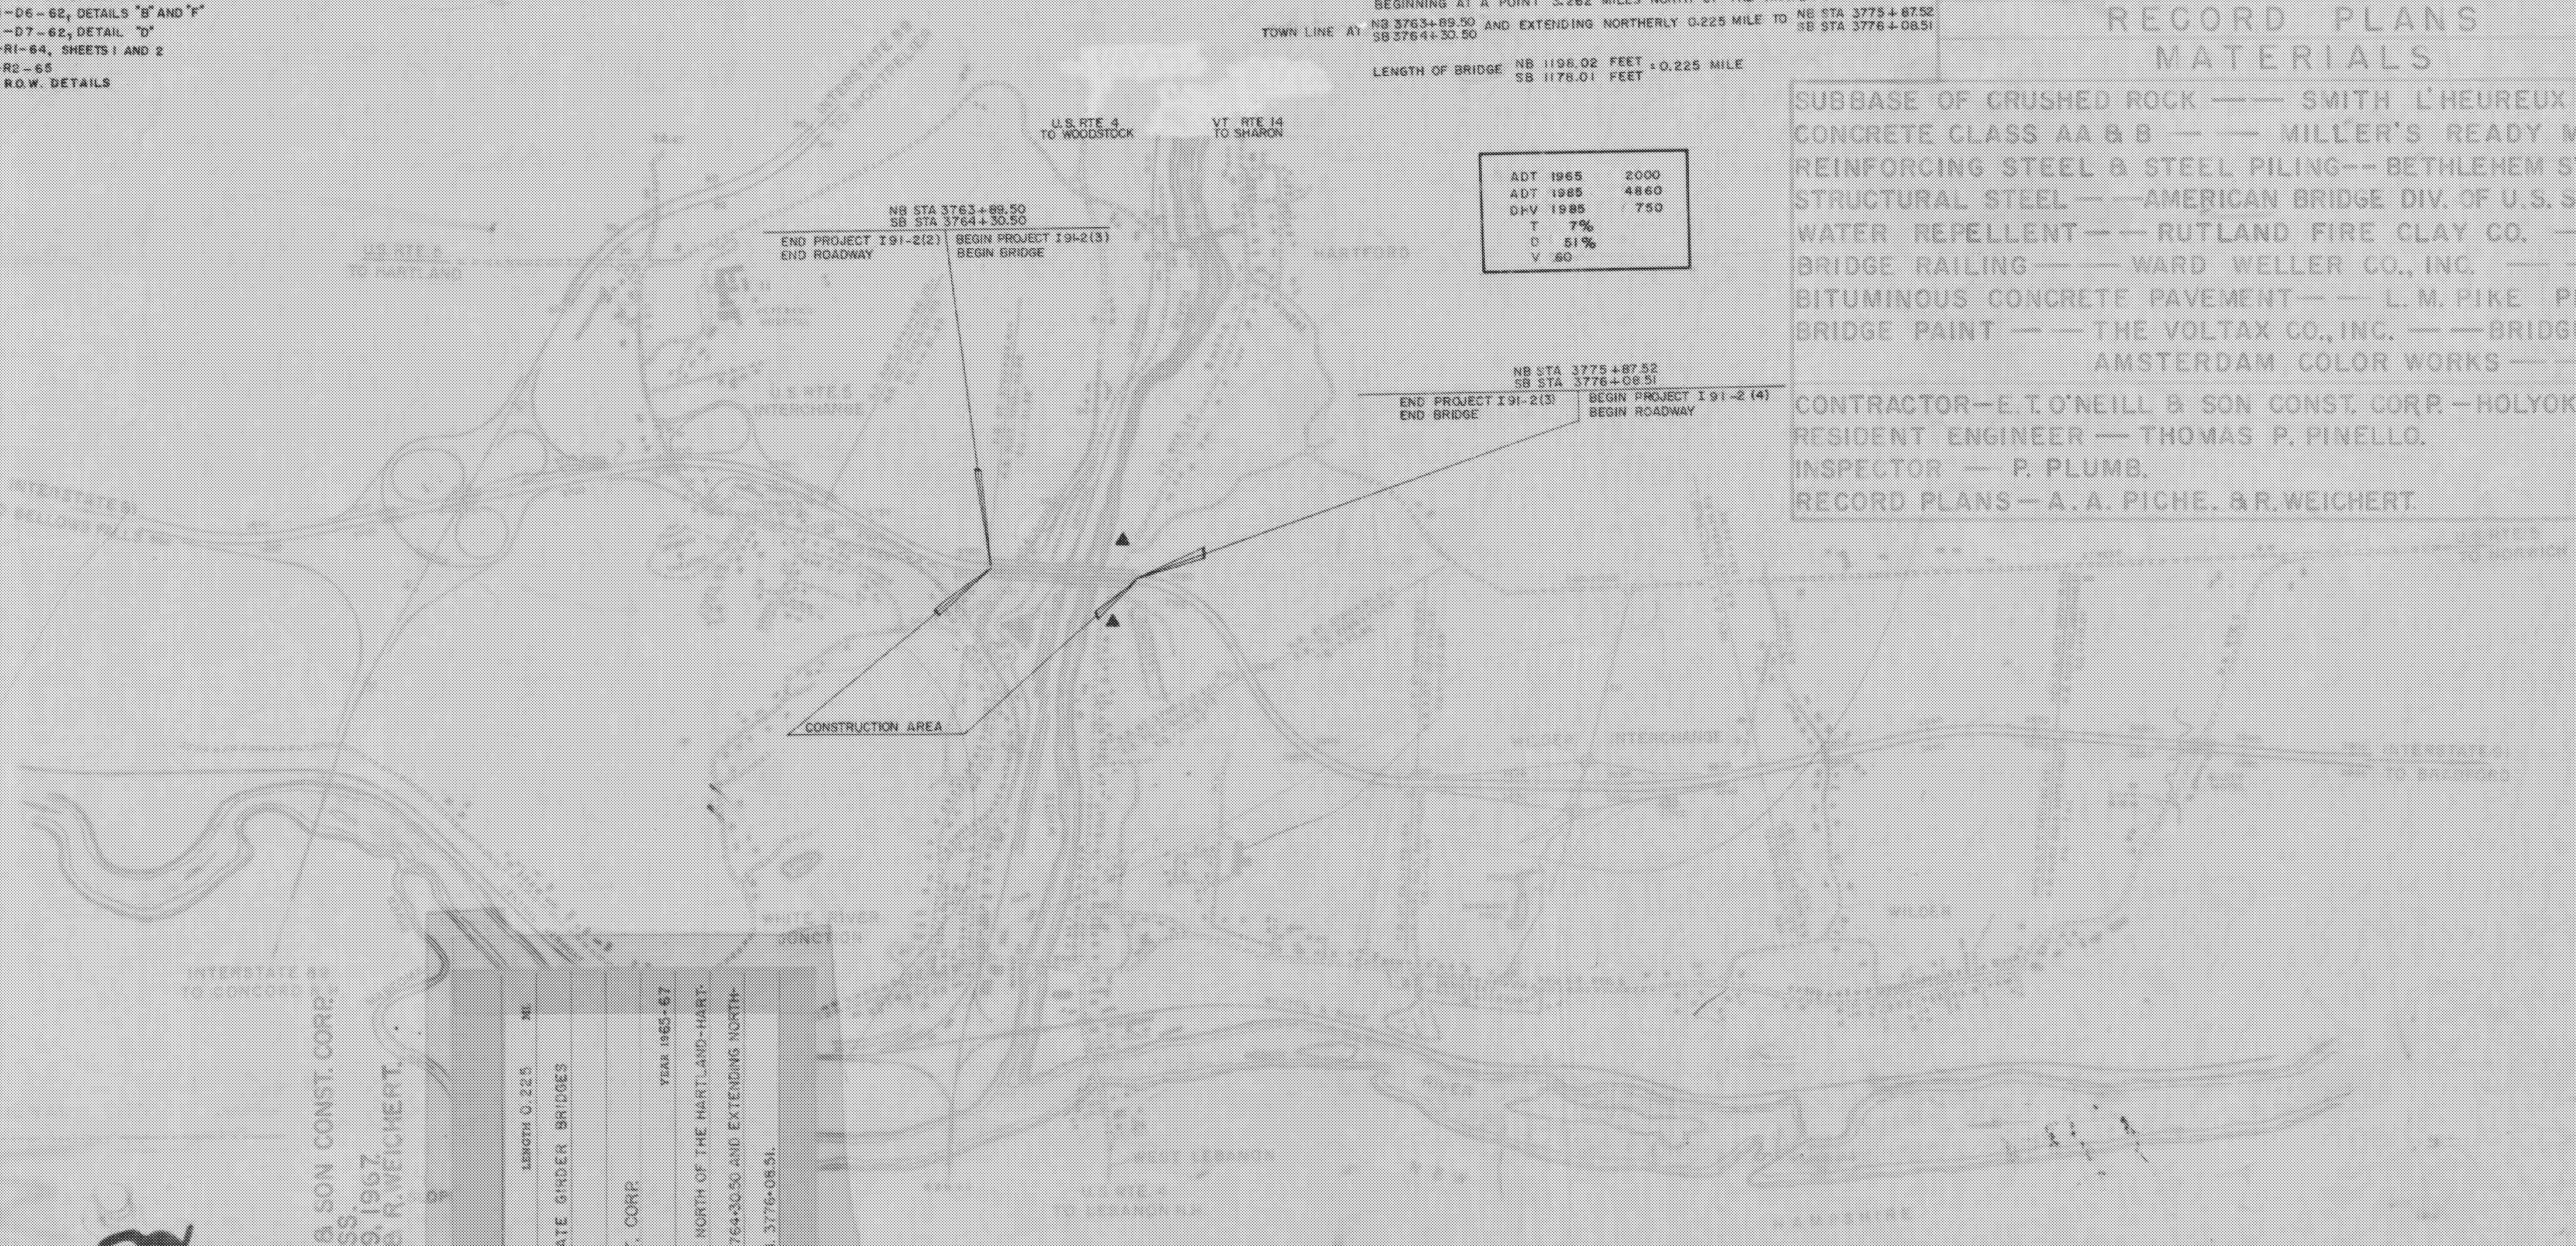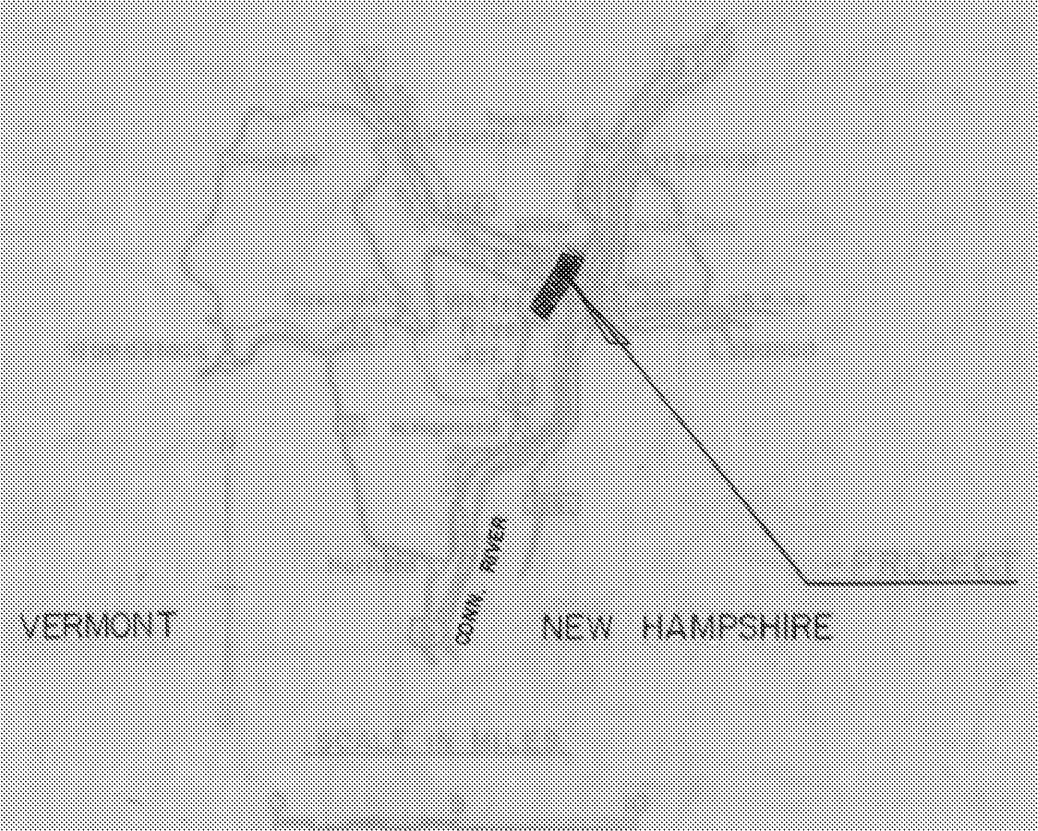

163

HARTFORD I 91-2 (3)
CONTRACTOR — E. T. O'NEILL & SON CONST. CORP.
HOLYOKE, MASS.
CONST. COMP. — NOVEMBER 9, 1967.
RECORD PLANS — A. A. PICHE & R. WEICHERT.

PROJECT	HARTFORD
NUMBER	1 91-2 (3)
TYPE	2-7 SPAN CONTINUOUS WELDED PLATE GIRDER BRIDGES
LENGTH	0.225 MI.
CONTRACTOR	E. T. O'NEILL & SON CONST. CORP.
LOCATION	HOLYOKE, MASS.
LOCATION	BEGINNING AT A POINT 3.262 MILES NORTH OF THE HARTLAND-HARTFORD TOWN LINE AT NB STA 3763+89.50 AND EXTENDING NORTHERLY 0.225 MILE TO SB STA 3776+08.51

R.H. Arnold
ASST. CHIEF
7/27/64

E.H. Sturtevant
8/12/64

D.W. Brown
7/24/64

J.S. Chase
7/31/64

G.W. Lane
8/10/64

G.B. Bishop
July 27/64

HARTFORD-SHARON
IM MEMB(15)

SHEET 35 OF 47
BRIDGE 44N&S
FOR REFERENCE ONLY