


INDEX OF SHEETS
SEE SHEET 2

STATE OF VERMONT
AGENCY OF TRANSPORTATION



PROPOSED IMPROVEMENT
BRIDGE PROJECT
TOWNS OF BRADFORD, NEWBURY, AND RYEGATE
COUNTIES OF CALEDONIA & ORANGE
PROJECT IM MEMB(16)

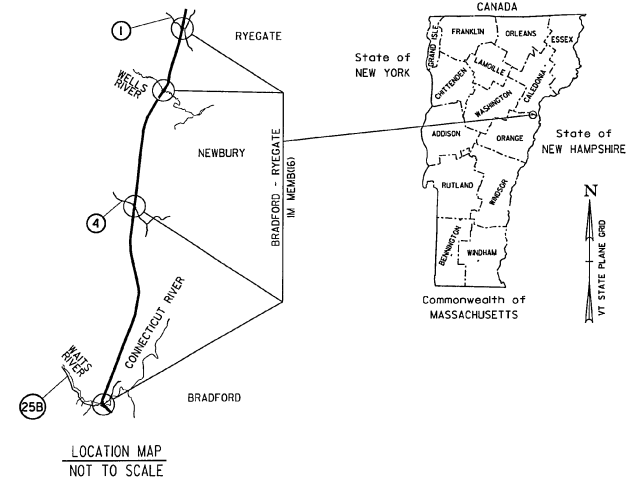

ROUTE NO.: INTERSTATE 91

BRIDGE NO.: 59S, 60S, 64N&S, 67N, AND 69N

PROJECT LOCATION:
BRADFORD - BR 59S OVER WAITS RIVER (MM 97.875)
BRADFORD - BR 60S OVER VT 25B (MM 97.967)
NEWBURY - BR 64N&S OVER TH NO. 4 (SCOTCH HOLLOW ROAD) (MM 105.879)
NEWBURY - BR 67N OVER WELLS RIVER (MM 110.617)
RYEGATE - BR 69N OVER TH NO. 1 (EAST ROAD) (MM 113.101)

PROJECT DESCRIPTION: THIS PROJECT INVOLVES REMOVING AND REPLACING THE SHEET MEMBRANE WATERPROOFING AND BITUMINOUS CONCRETE PAVEMENT ON THE BRIDGE AND ITS APPROACHES ALONG WITH MINOR RELATED WORK.

LENGTH OF STRUCTURES:
BR 59S 270.92'
BR 60S 160.00'
BR 64N 98.00'
BR 64S 128.00'
BR 67N 333.92'
BR 69N 92.00'

TOTAL LENGTH
OF STRUCTURES: 1082.84'

RECORD PLANS	
CONTRACTOR	J. P. SICARD, INC. - BARTON, VT
RESIDENT ENGINEER	CARL FIELDER
CONSTRUCTION BEGAN	JUNE 4, 2009
CONSTRUCTION COMPLETE	AUGUST 20, 2010
RECORD PLANS BY	CARL FIELDER & CRAIG PIERCE
I HEREBY CERTIFY THAT ALL THE CONSTRUCTION REQUIRED BY THIS SET OF DRAWINGS HAS BEEN ACCOMPLISHED AS INDICATED HEREIN	
BY	<i>[Signature]</i> FOR CARL FIELDER, RESIDENT ENGINEER
DATE	6/2/2011
NOTE: Any further information concerning final quantities, amounts or other details relative to this project may be found at Central Files in the electronic archives	


SURVEYED BY : N/A
SURVEYED DATE : N/A

DATUM

VERTICAL N/A
HORIZONTAL N/A

CONVENTIONAL SYMBOLS

COUNTY LINE	
TOWN LINE	
LIMITS OF ACCESS	
POINT OF ACCESS	
FENCE LINE	
STONE WALL	
TRAVELED WAY	
GUARD RAIL	
RAILROAD	
SURVEY LINE	
CULVERT	
POWER POLE	
TELEPHONE POLE	
TREES	
CONTROL OF ACCESS	
PROPERTY LINE	
R.O.W. TAKING LINE	
SLOPE RIGHTS	
TOP OF CUT	
TOE OF SLOPE	

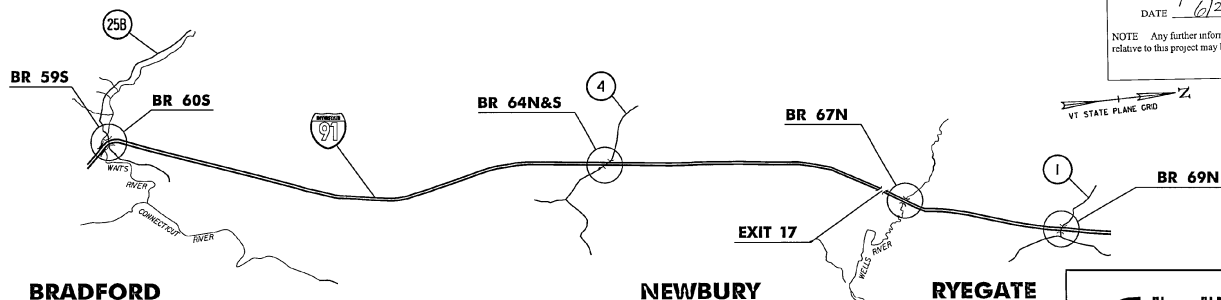

VT STATE PLANE CRD

RYEGATE



PLANS PREPARED BY:



DIRECTOR OF PROGRAM DEVELOPMENT
APPROVED: *[Signature]* DATE: 2-2-10
PROJECT MANAGER: SHERWARD FARNSWORTH
PROJECT NAME: BRADFORD - RYEGATE
PROJECT NUMBER: IM MEMB(16)
SHEET 1 OF 61 SHEETS