




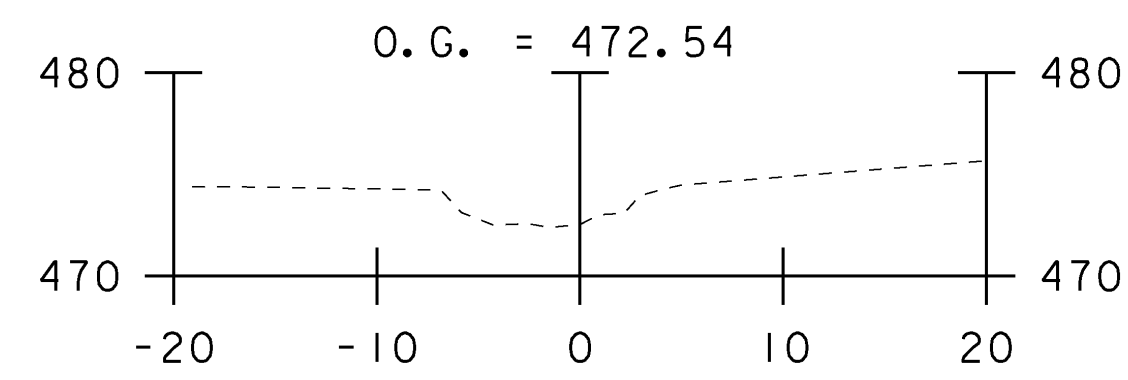


10+60

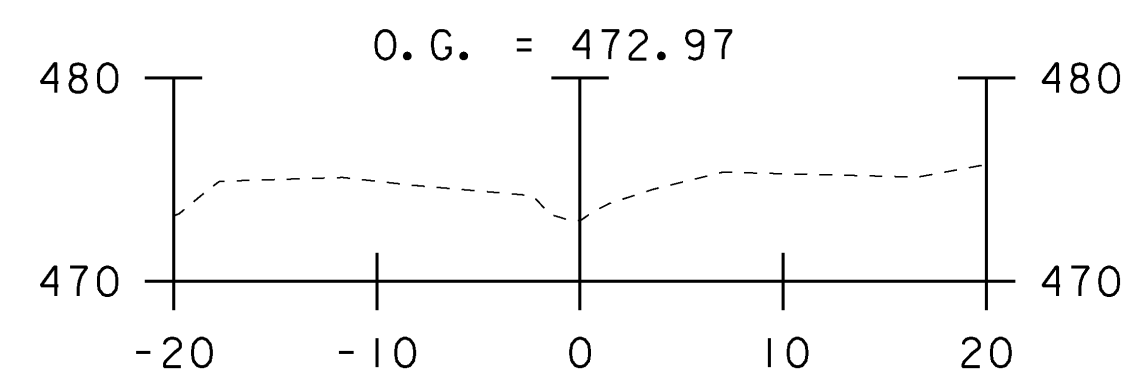


10+50

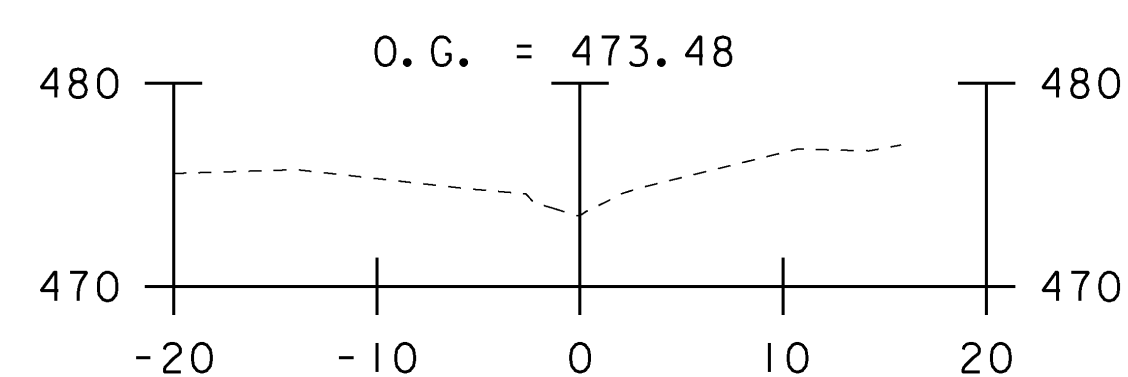


10+40

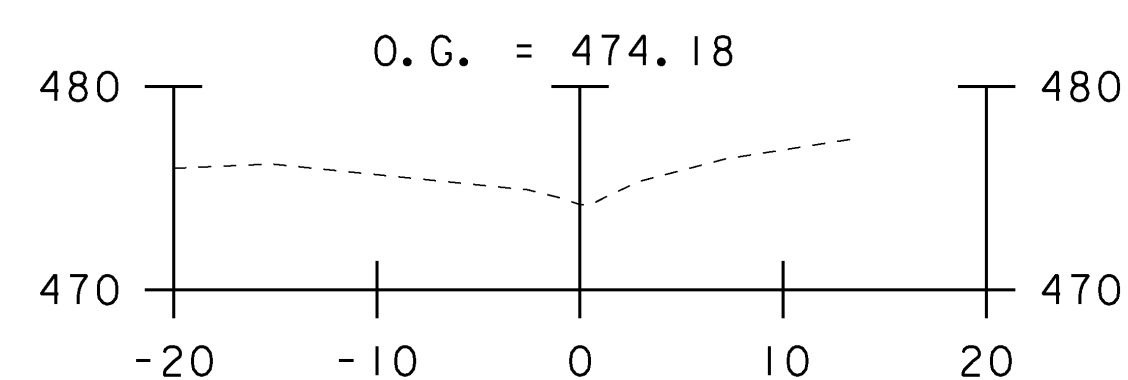


10+30

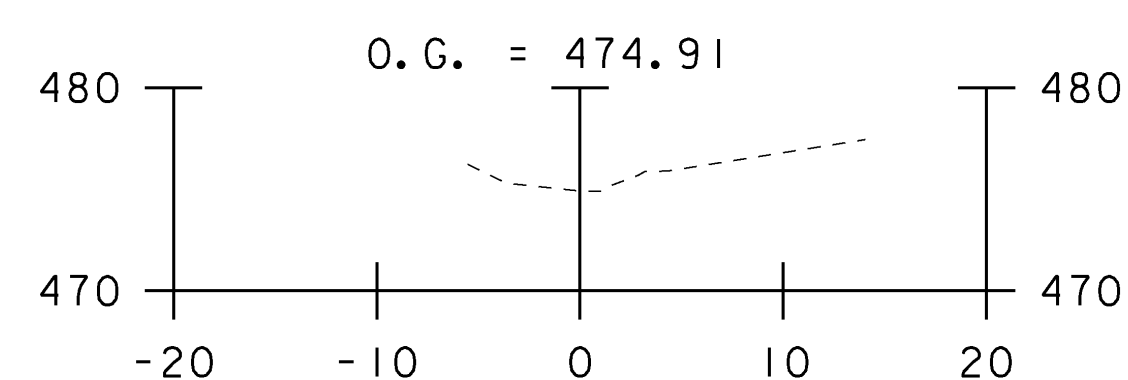


10+20

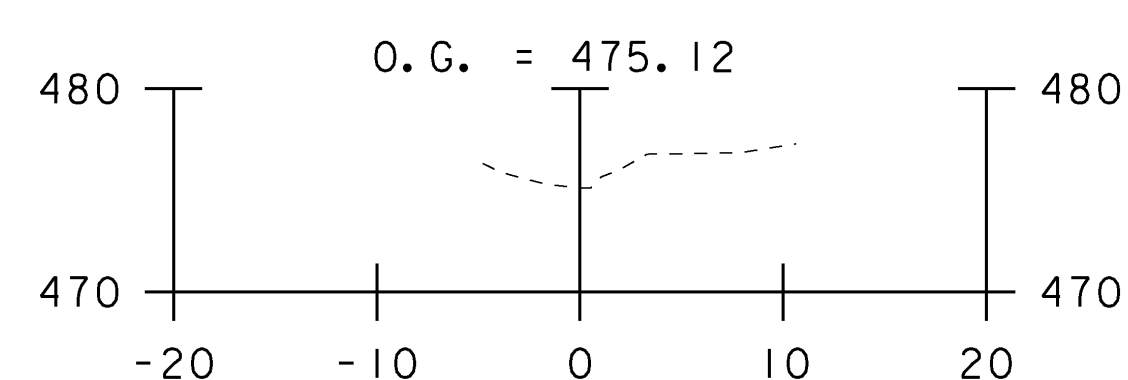


10+10

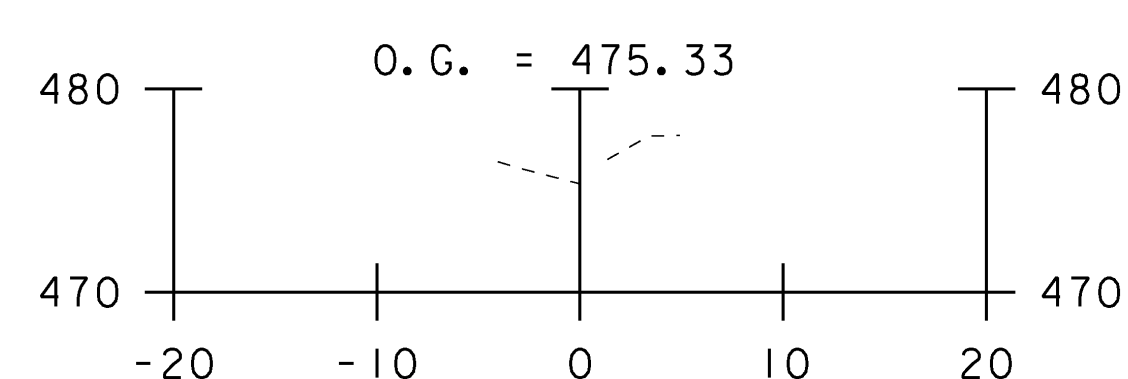


10+00

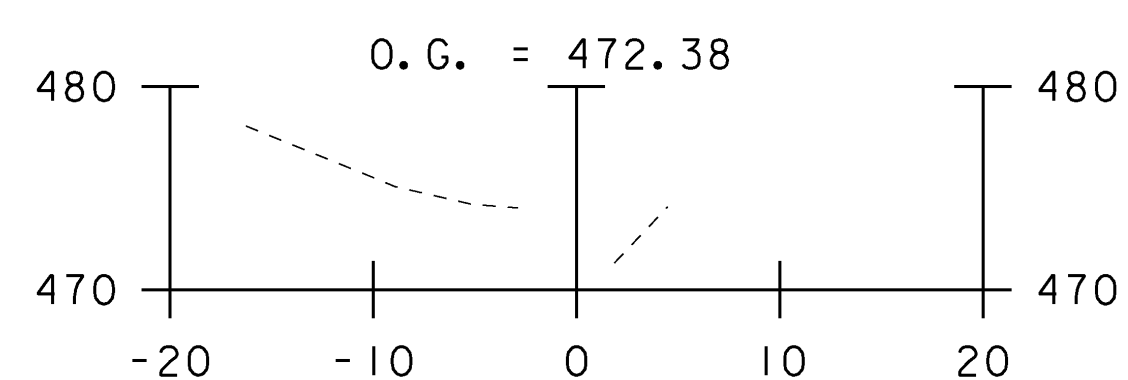


10+91

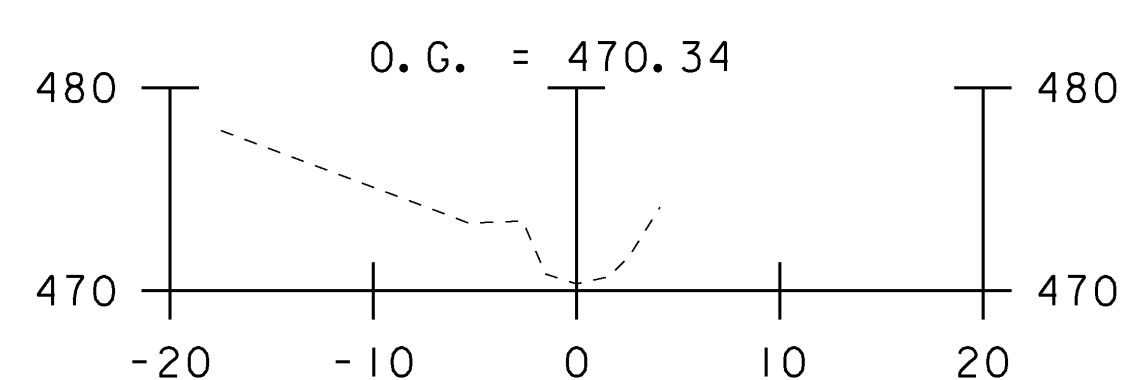


10+90

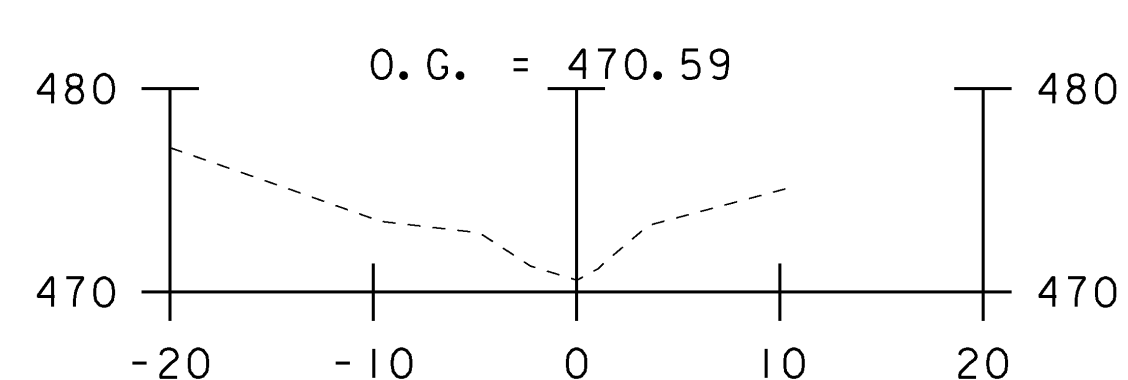


10+80

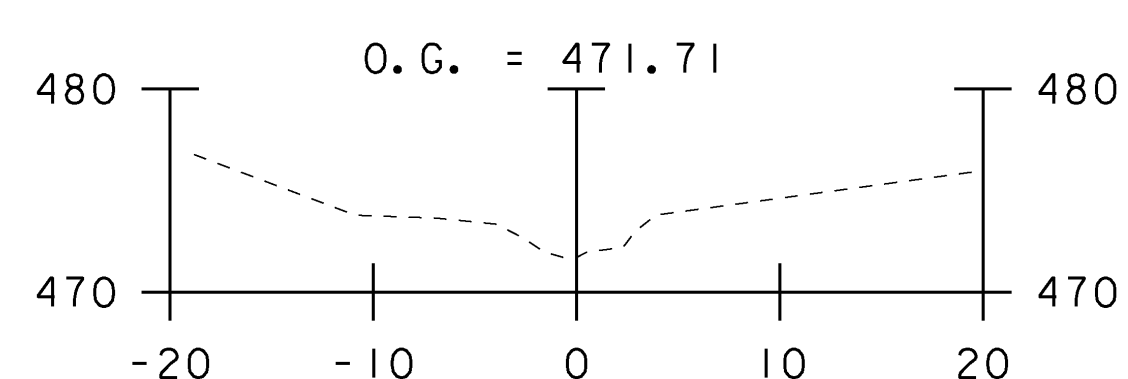


10+70

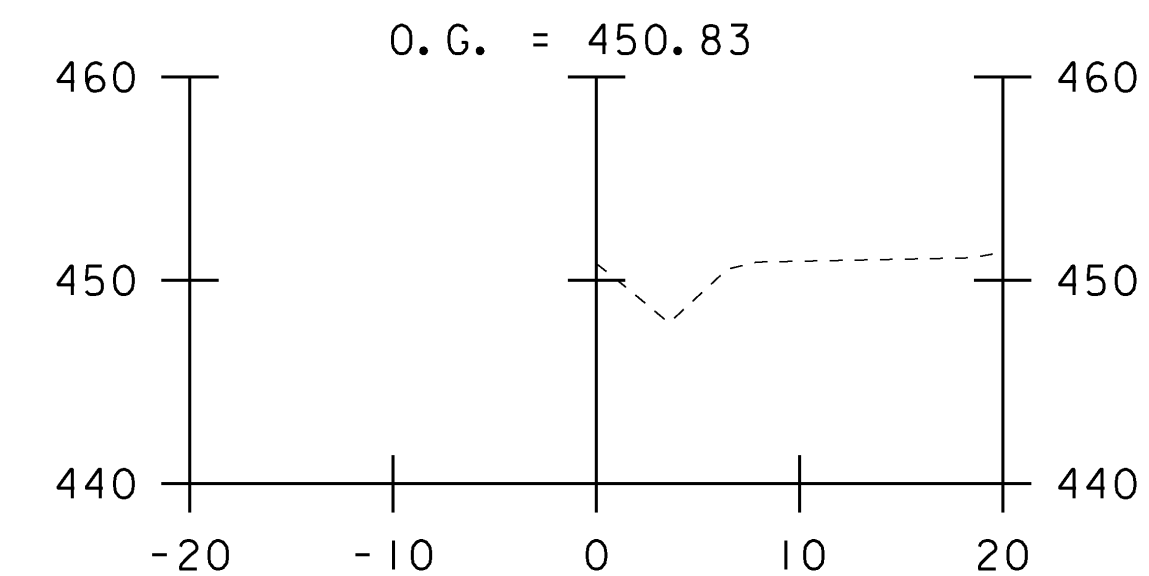


13+96

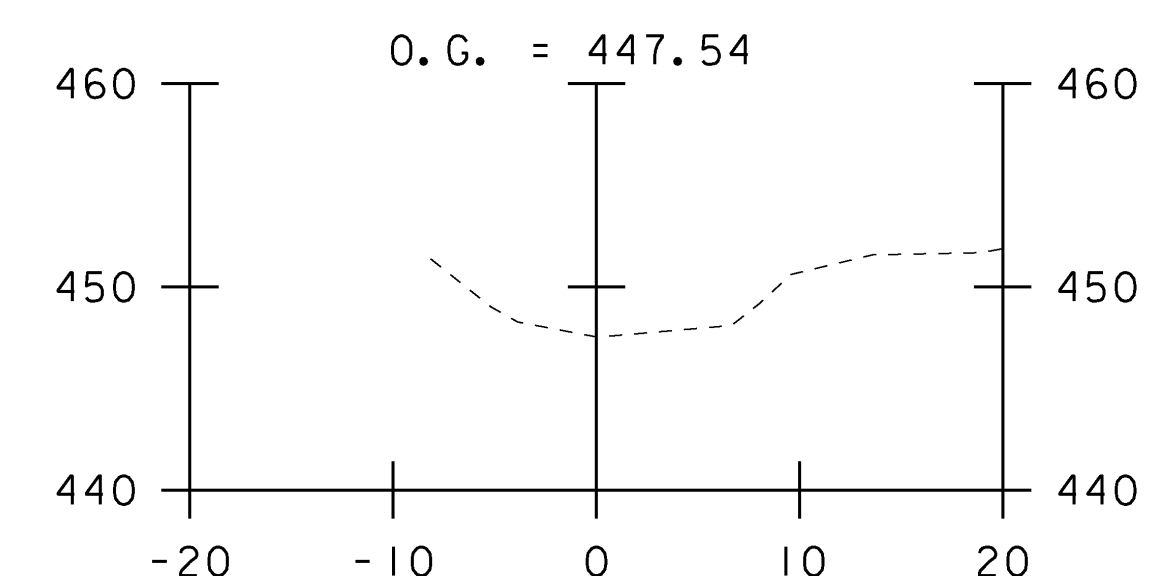


13+90

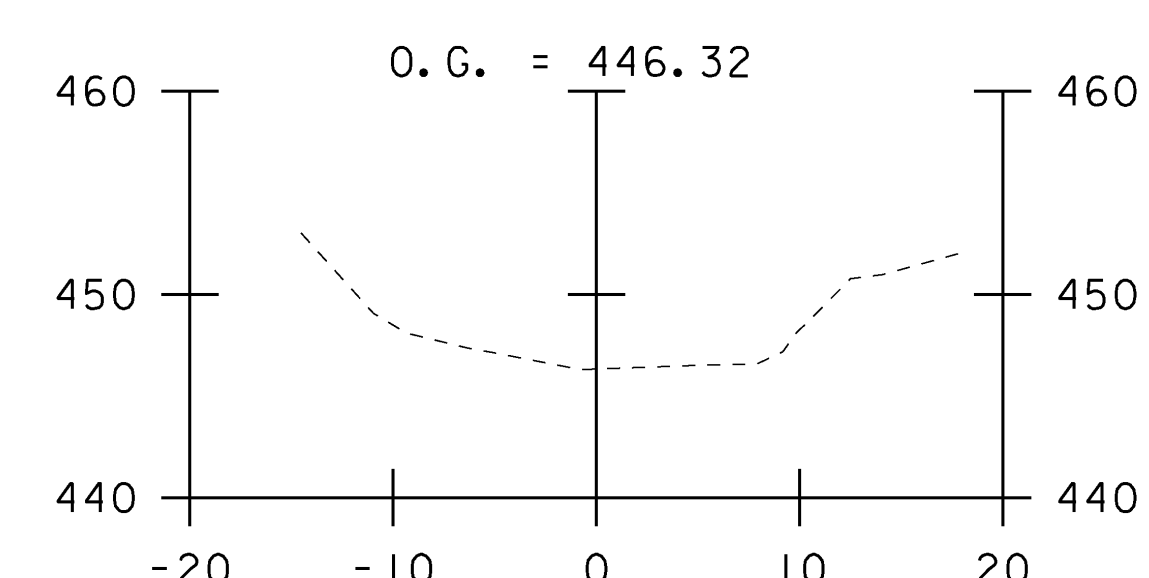

13+80

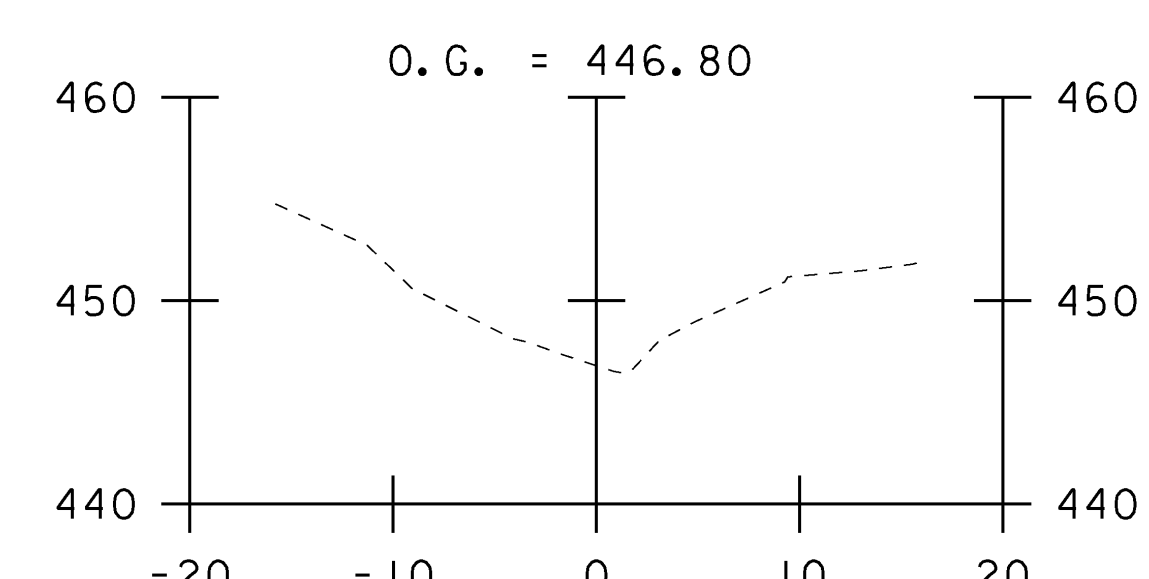

13+70

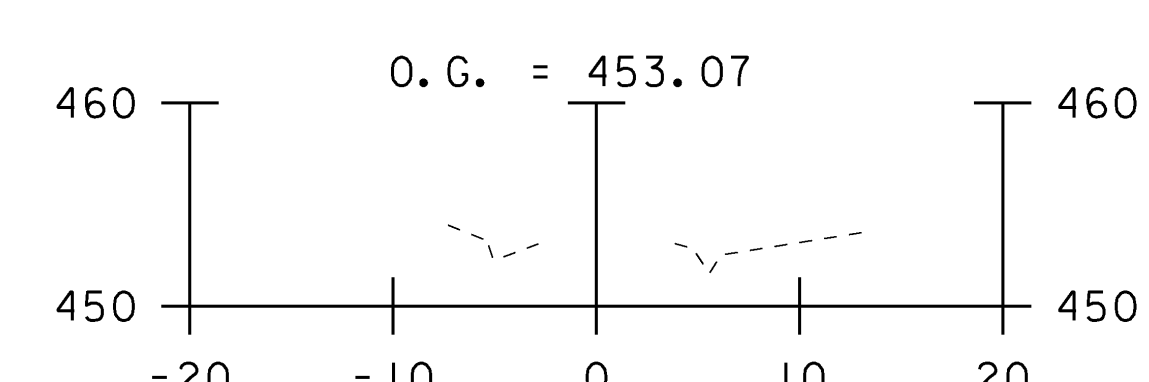

13+61



PROJECT NAME: SHARON
PROJECT NUMBER: IM CULV (18)

FILE NAME: z08a190xsl.dgn
PROJECT LEADER: DMB
DESIGNED BY: MHM
CROSS SECTIONS (13-1)

PLOT DATE: 13-JUL-2009
DRAWN BY: MJF
CHECKED BY: DMB
SHEET 13 OF 36