



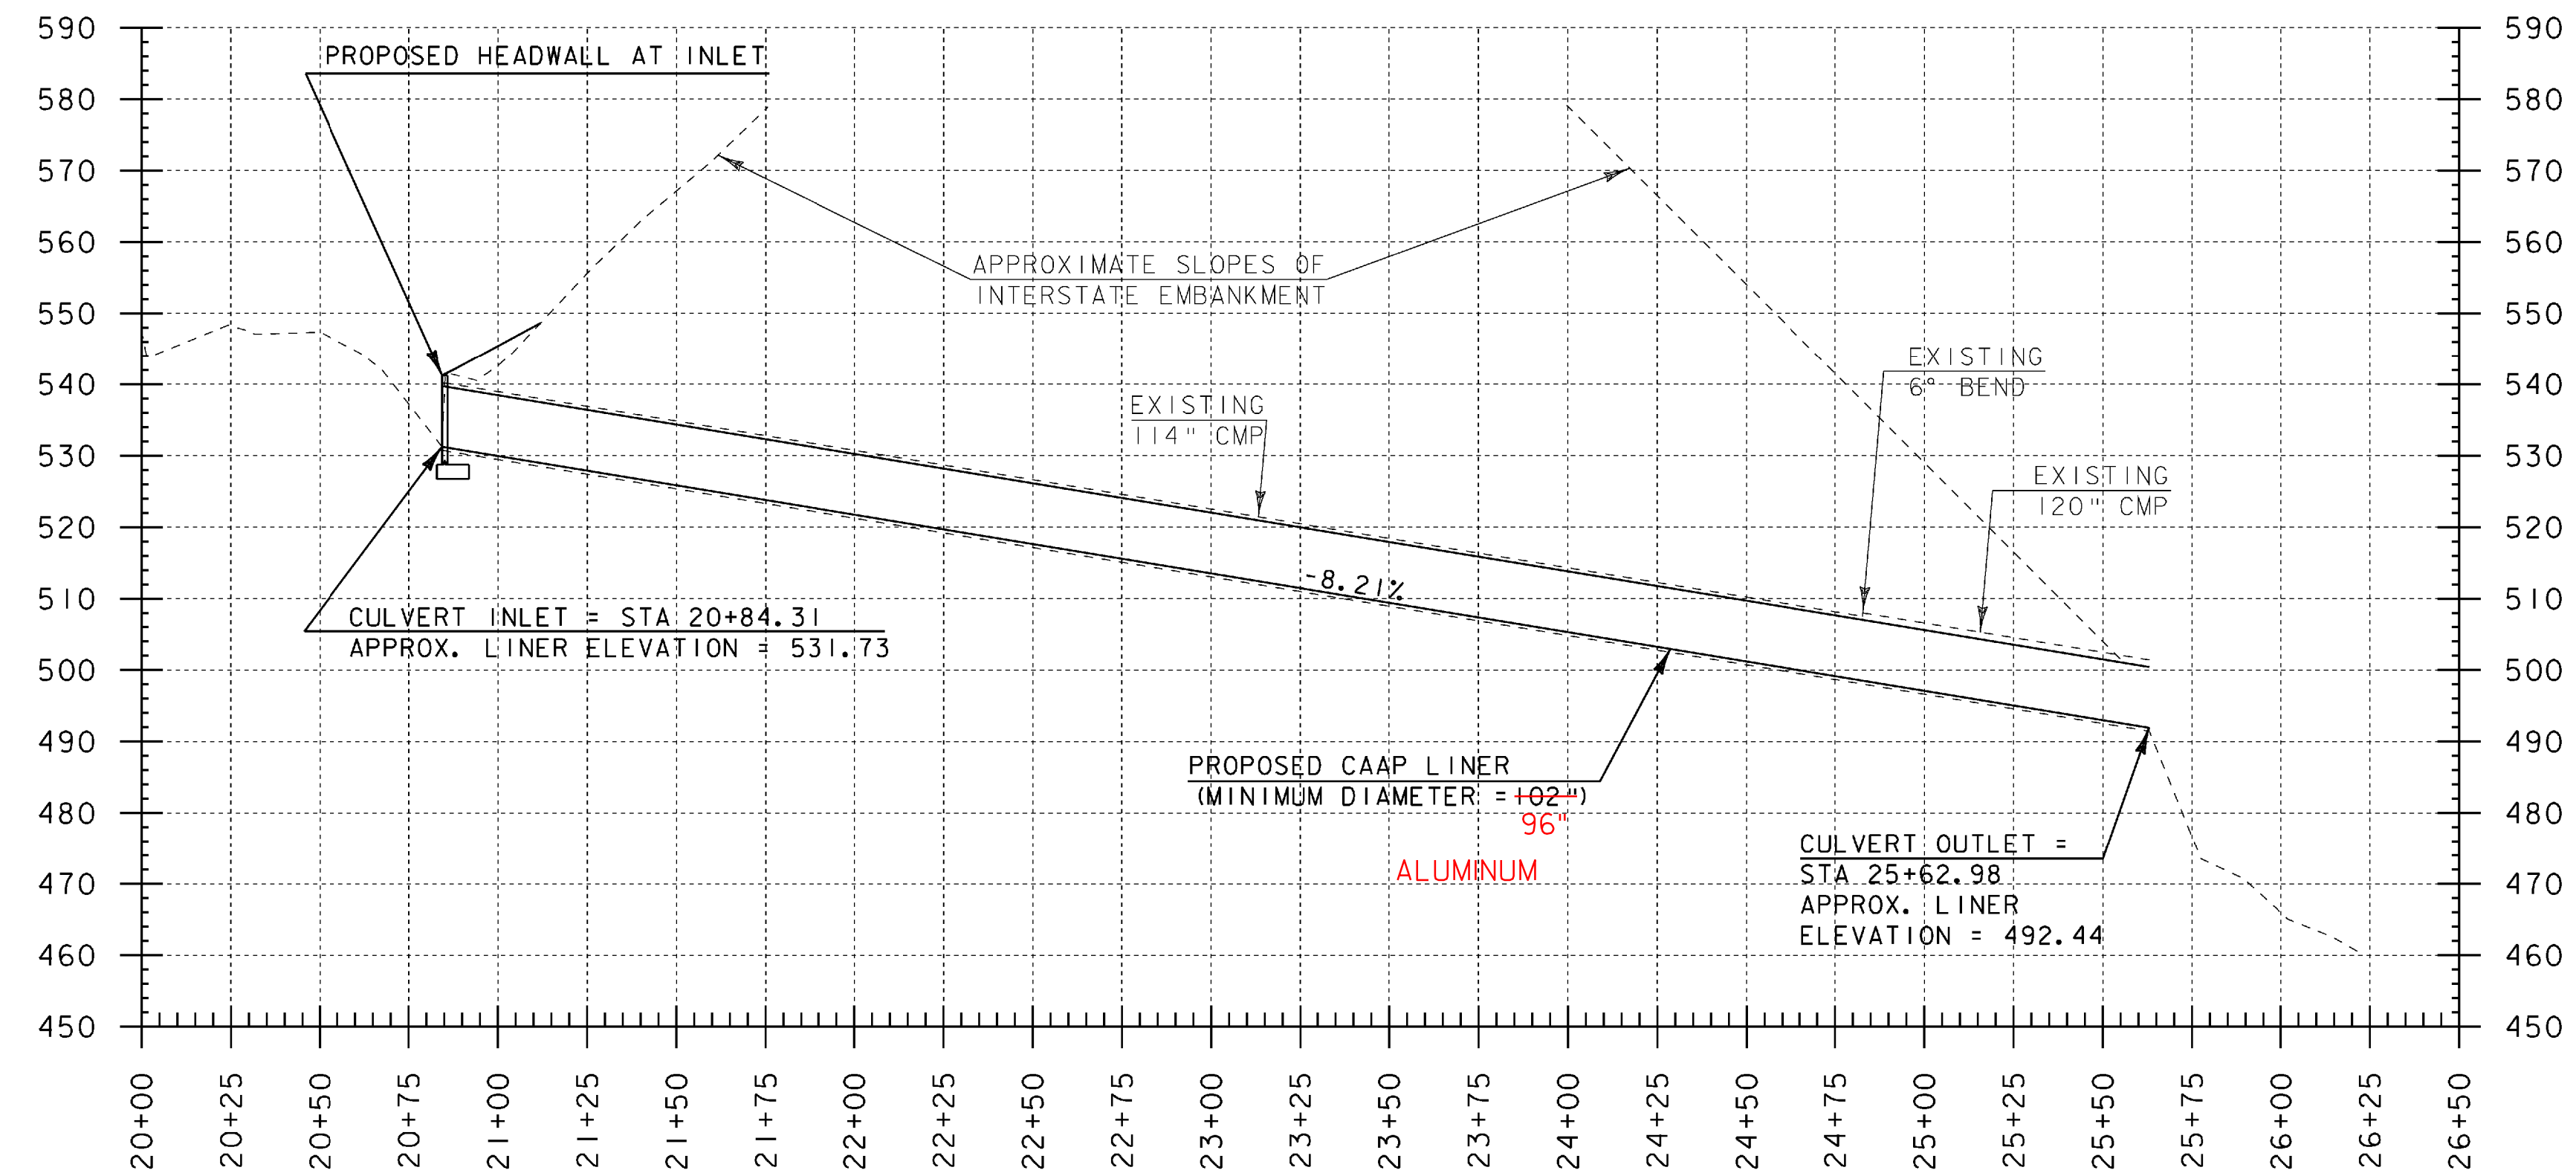

SHARON BRIDGE NO. 14-1
CULVERT CENTERLINE PROFILE

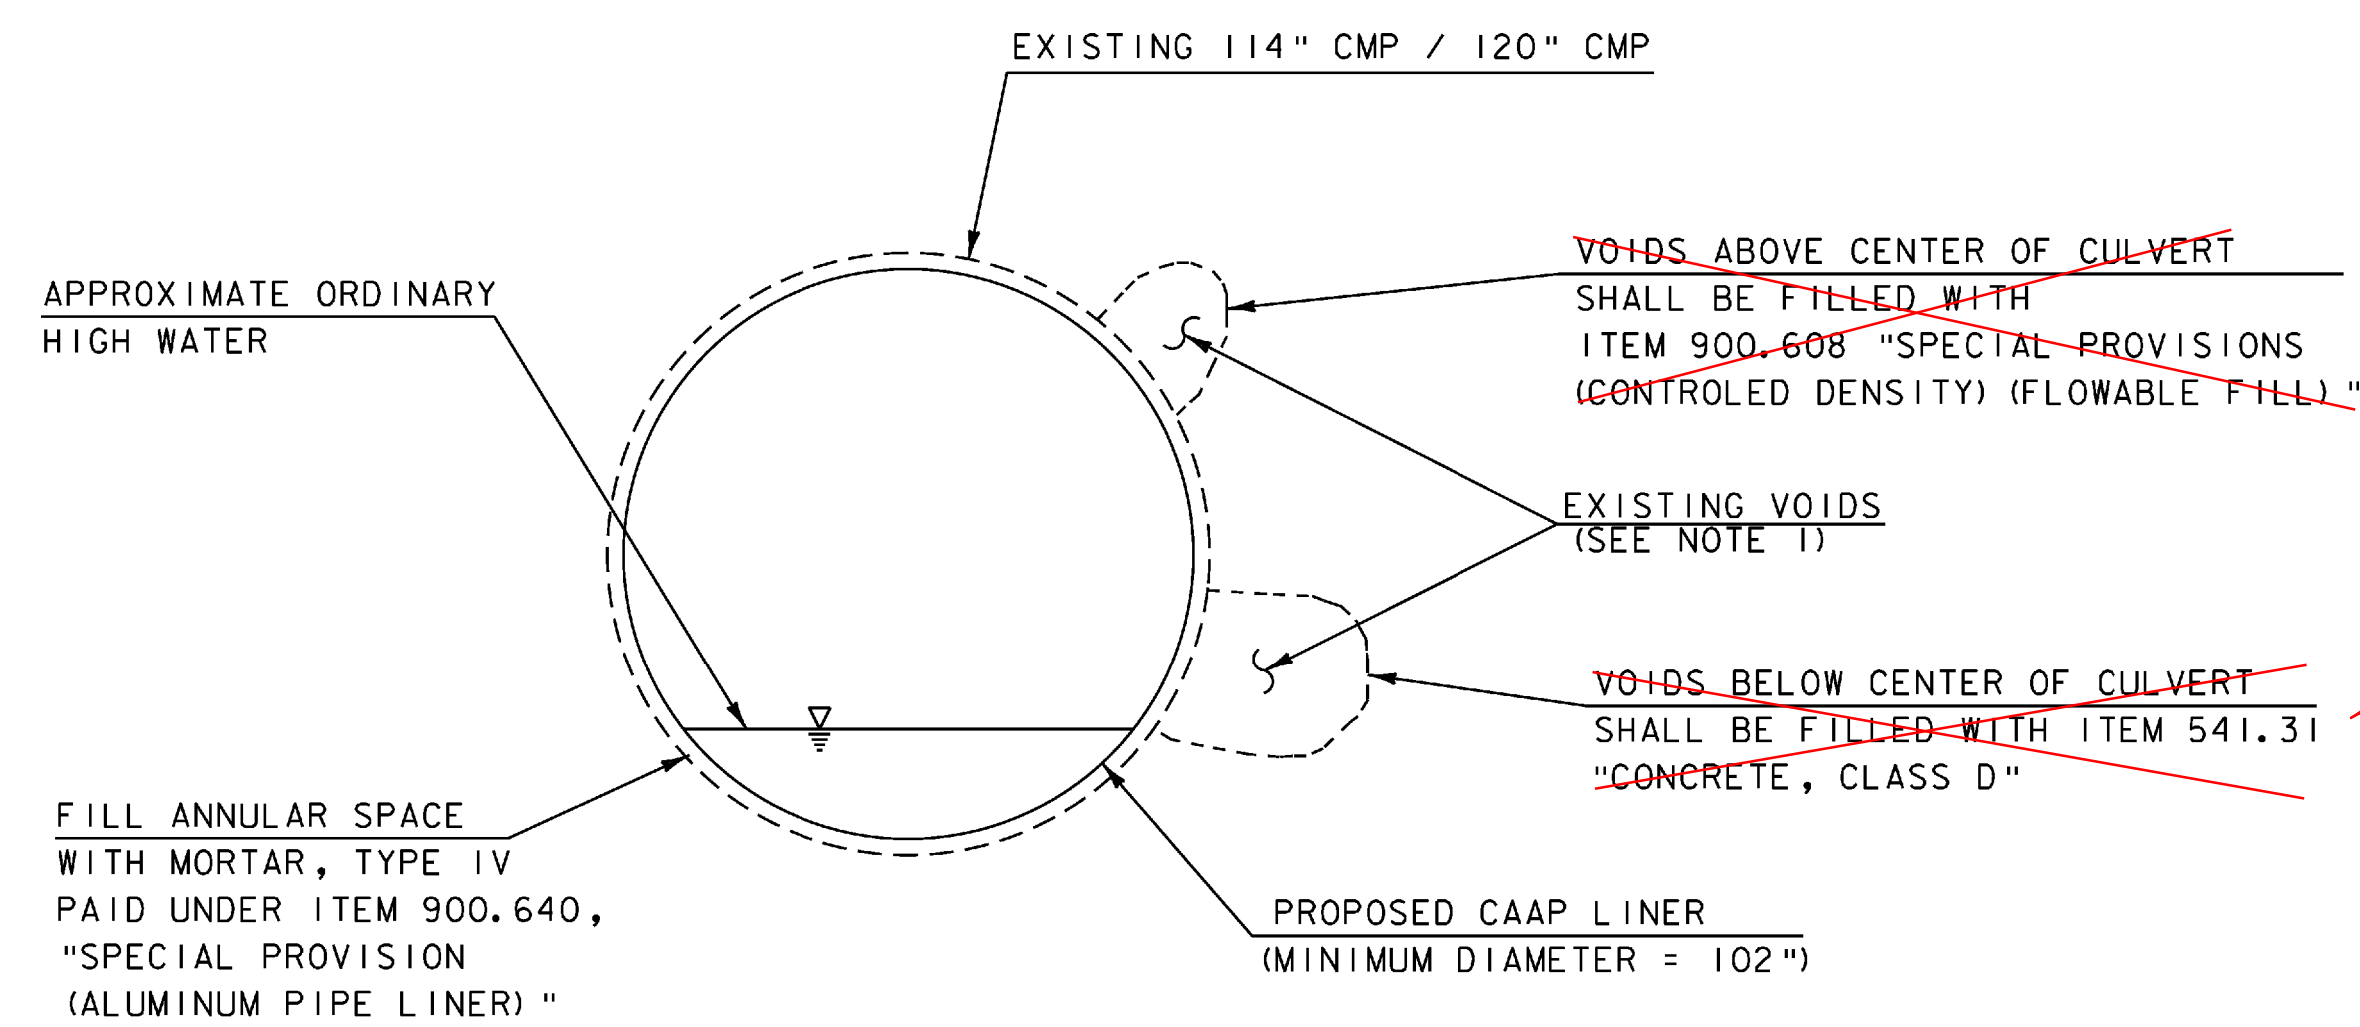


SHARON BRIDGE NO. 14-1
CULVERT LINING DETAIL
NOT TO SCALE

NOT NEEDED.
TYP. FOR ALL 3 PIPES

PROJECT NOTES

1. POTENTIAL VOID LOCATIONS SHOWN FOR EXPLANATION PURPOSES ONLY.

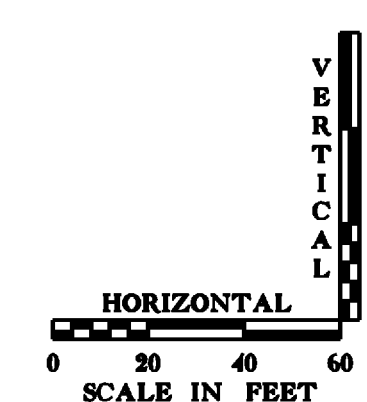

PROJECT NAME: SHARON	
PROJECT NUMBER: IM CULV (18)	
FILE NAME: PROF02.dgn	PLOT DATE: 13-JUL-2009
PROJECT LEADER: DMB	DRAWN BY: MJF
DESIGNED BY: MHM	CHECKED BY: DMB
PROFILE SHEET (14-1)	SHEET 15 OF 36