



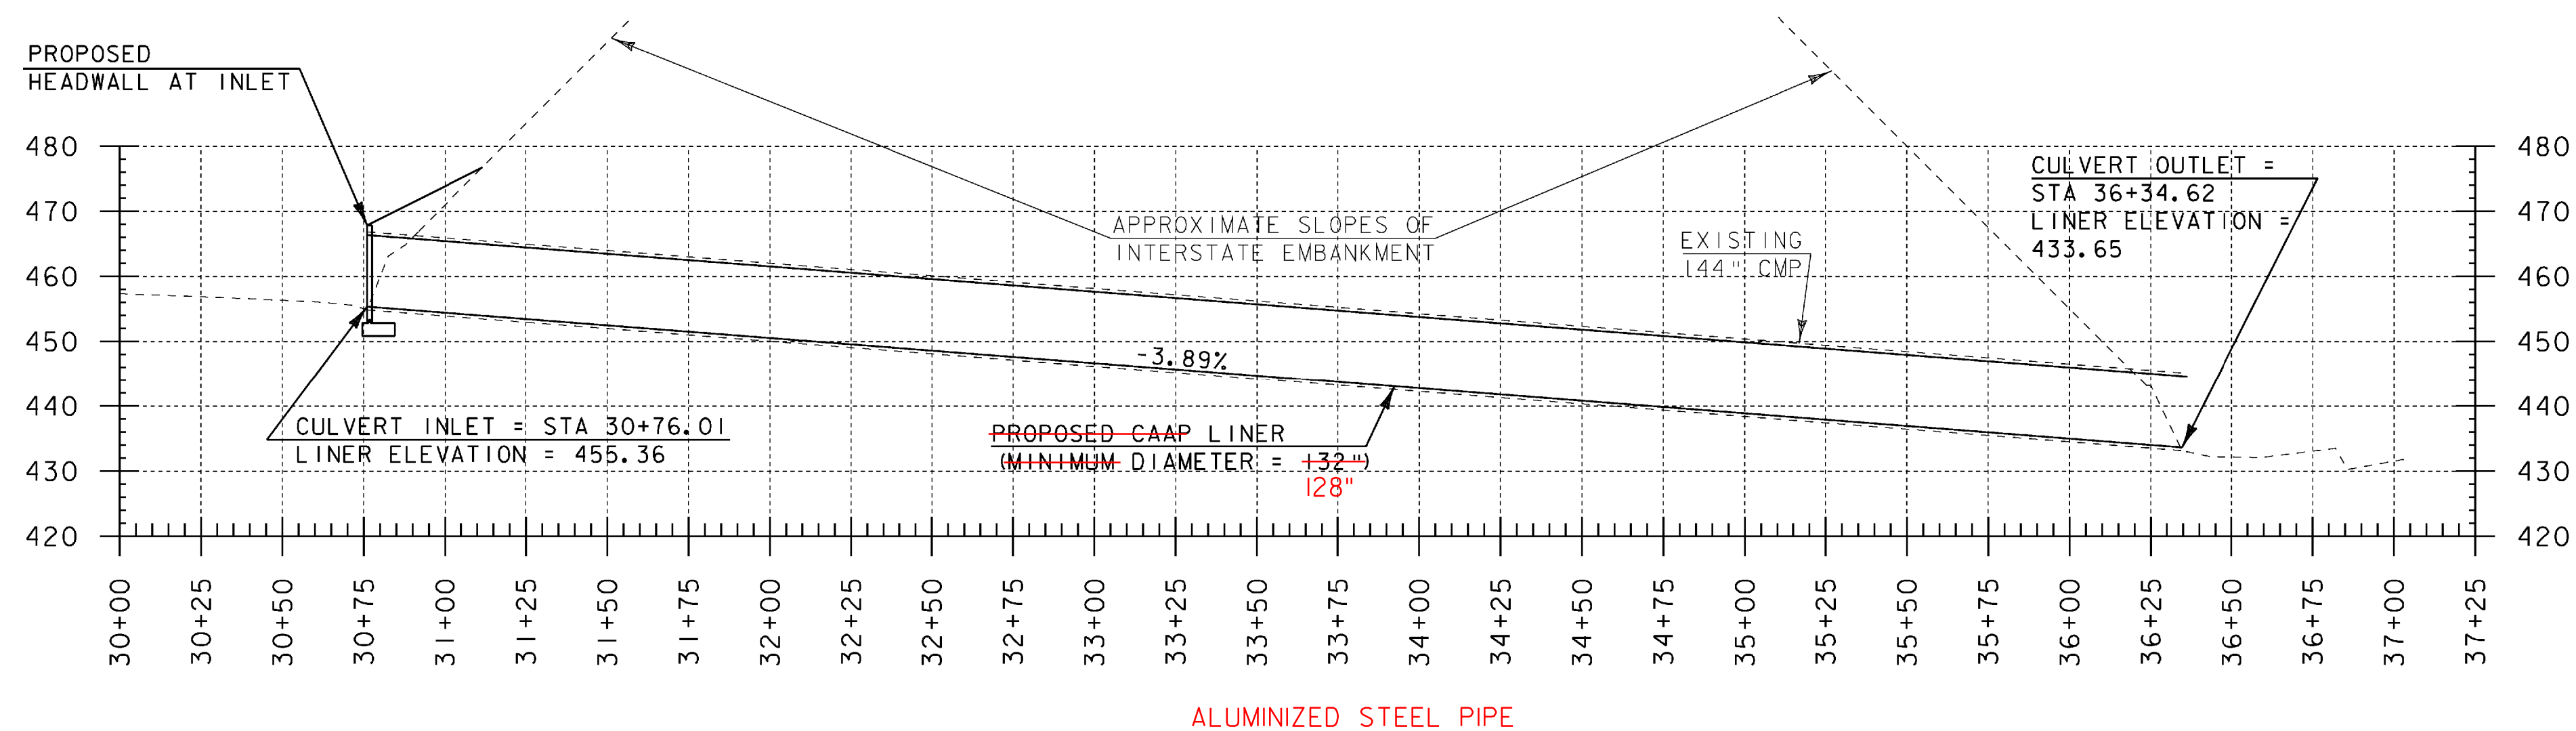


SHARON BRIDGE NO. 14-2  
CULVERT CENTERLINE PROFILE

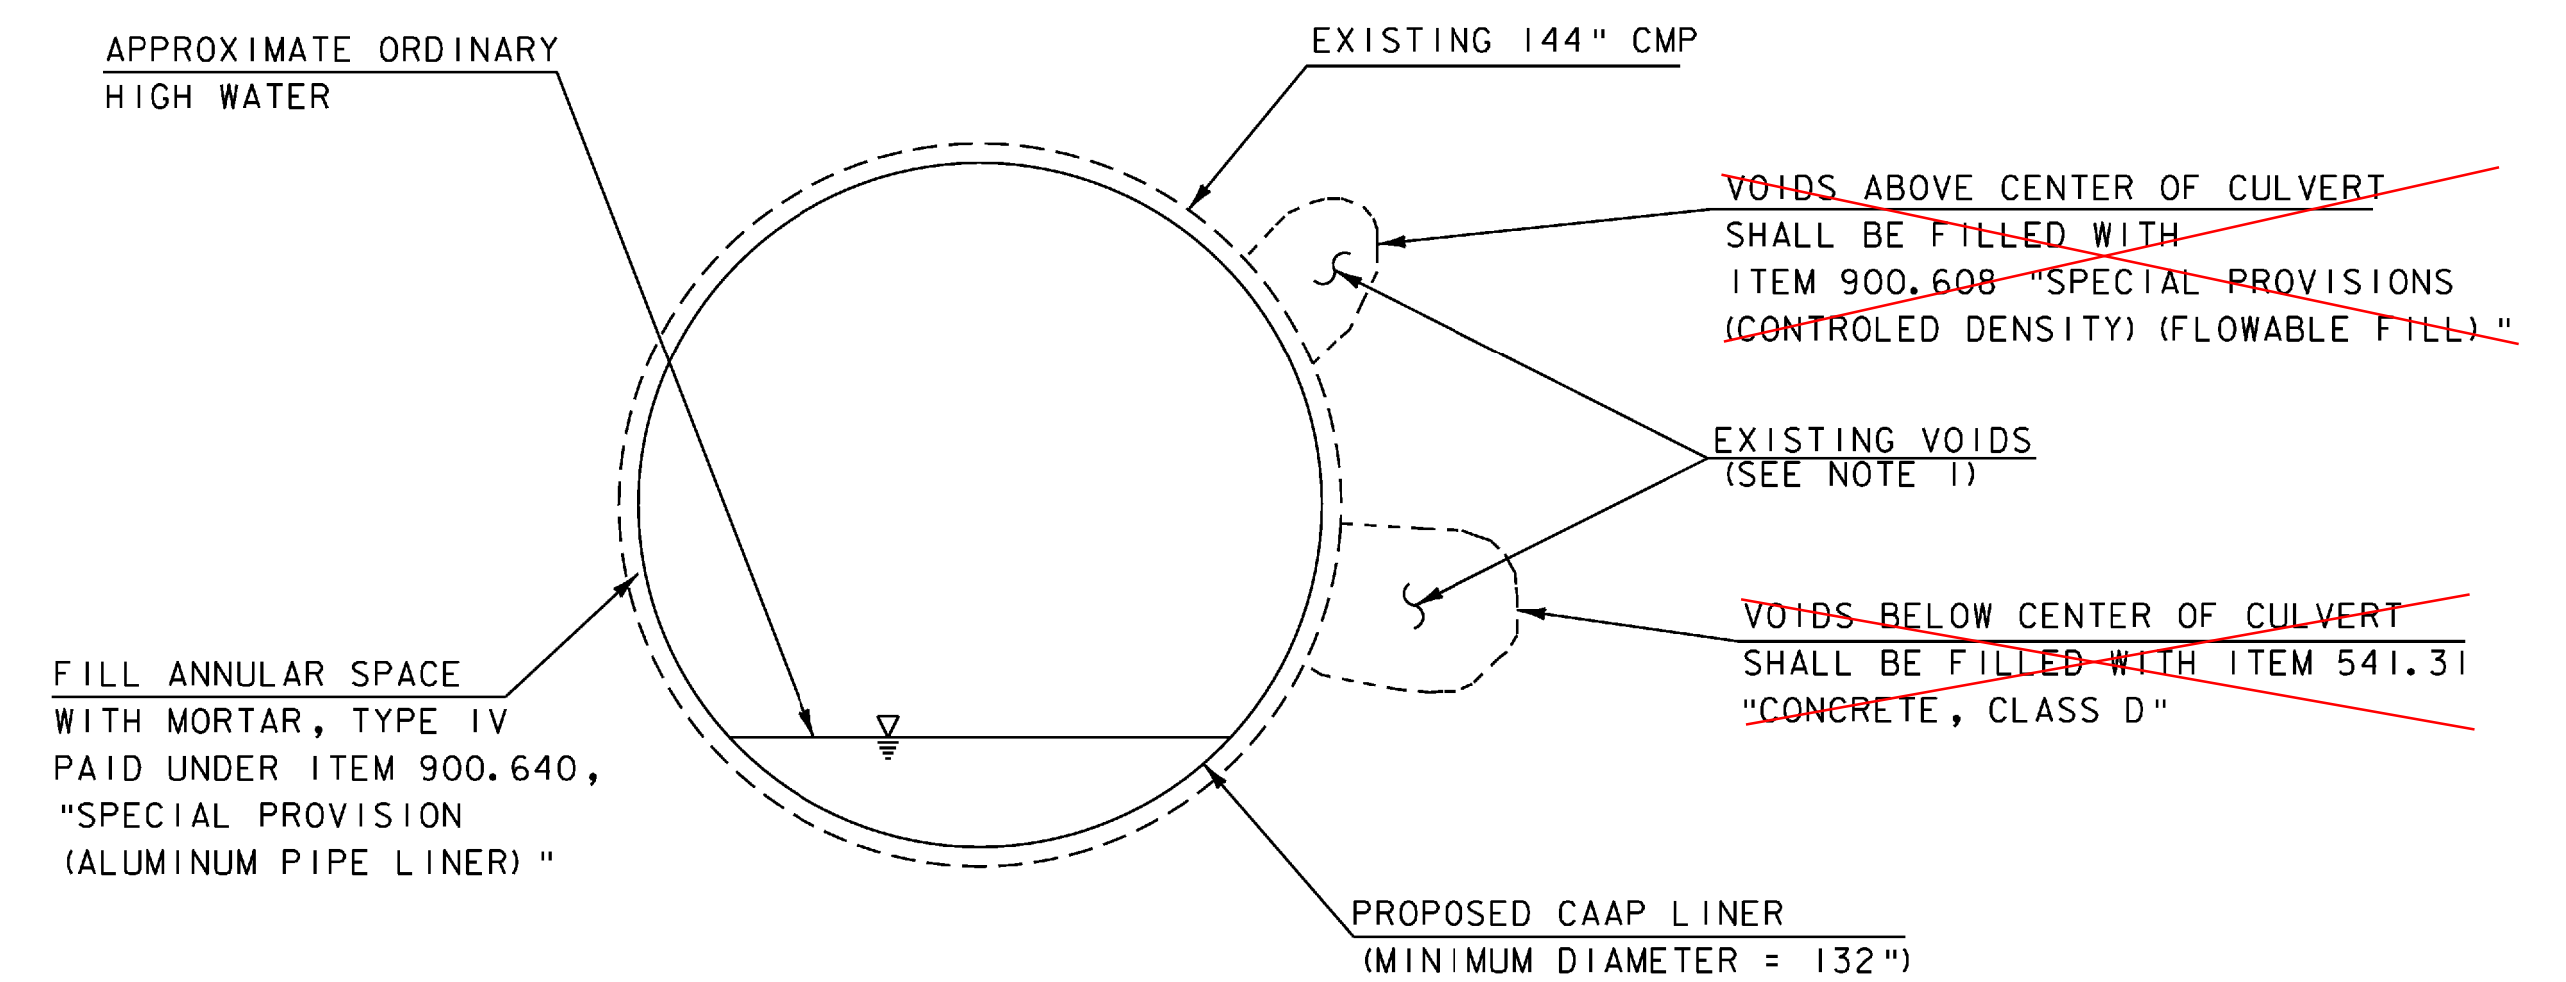

SHARON BRIDGE NO. 14-2  
CULVERT LINING DETAIL  
NOT TO SCALE

# PROJECT NOTES

1. POTENTIAL VOID LOCATIONS SHOWN FOR EXPLANATION PURPOSES ONLY.

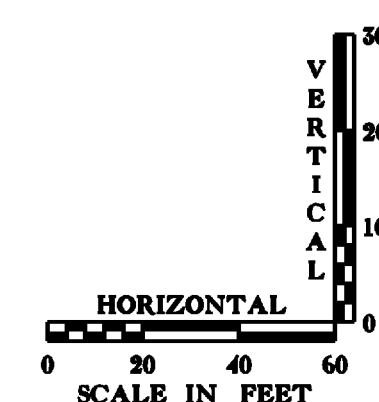

|                              |                        |
|------------------------------|------------------------|
| PROJECT NAME: SHARON         | PLOT DATE: 13-JUL-2009 |
| PROJECT NUMBER: IM CULV (18) | DRAWN BY: MJF          |
| FILE NAME: PROF03.dgn        | CHECKED BY: DMB        |
| PROJECT LEADER: DMB          | SHEET 22 OF 36         |
| DESIGNED BY: MHM             |                        |
| PROFILE SHEET (14-2)         |                        |