
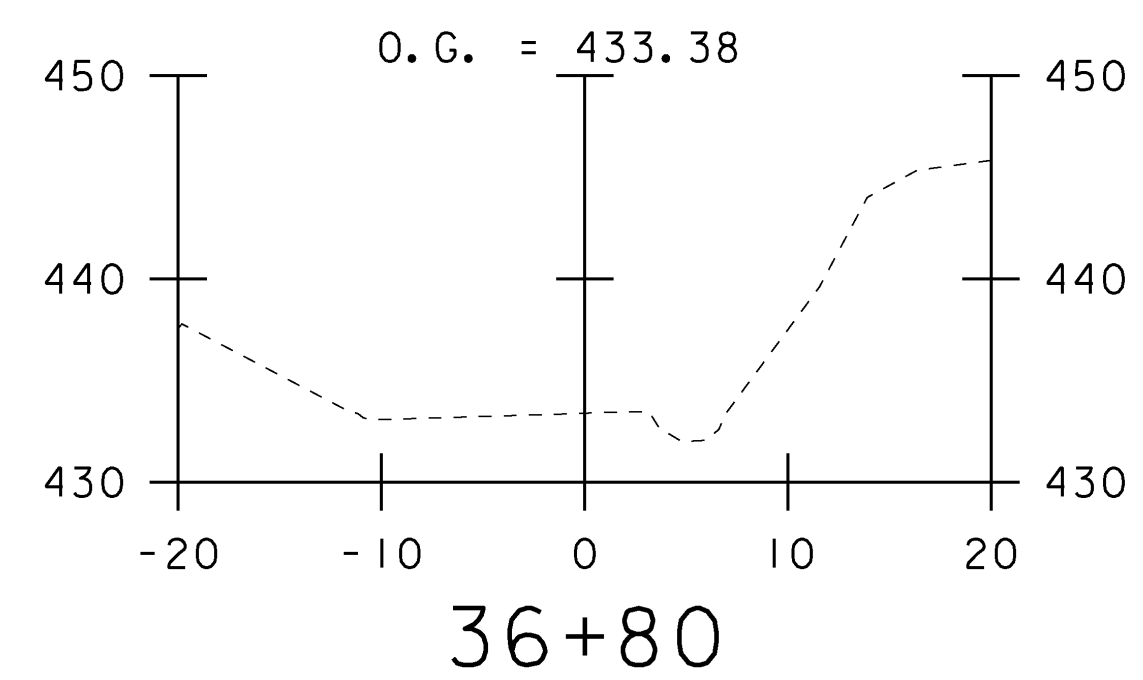
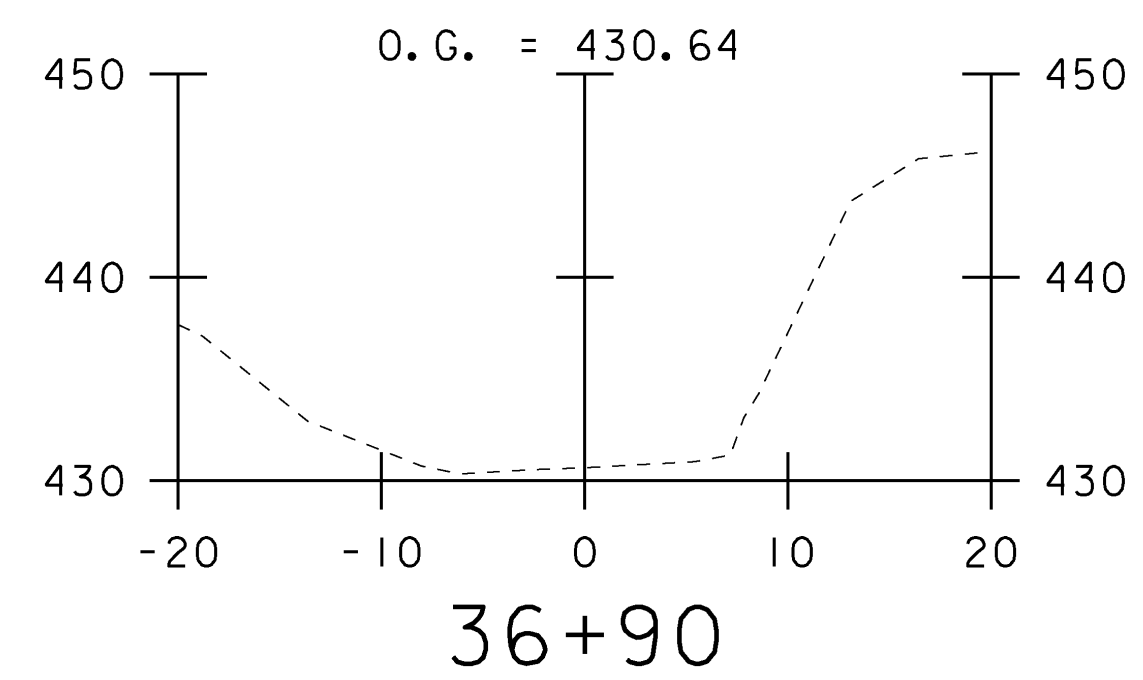
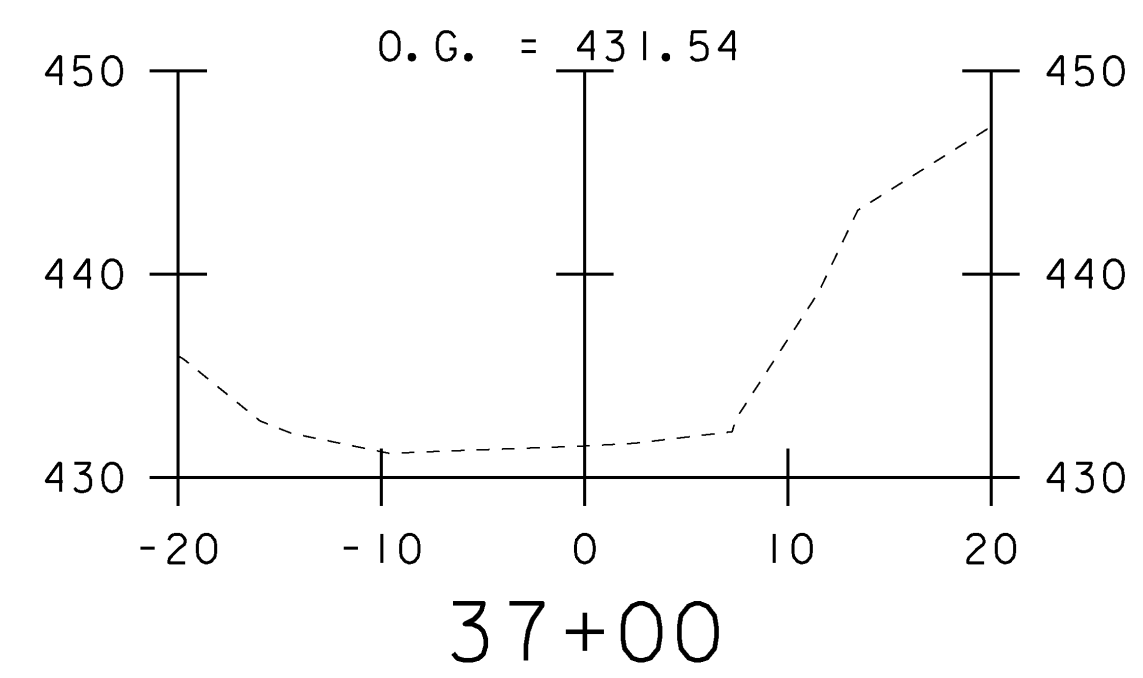
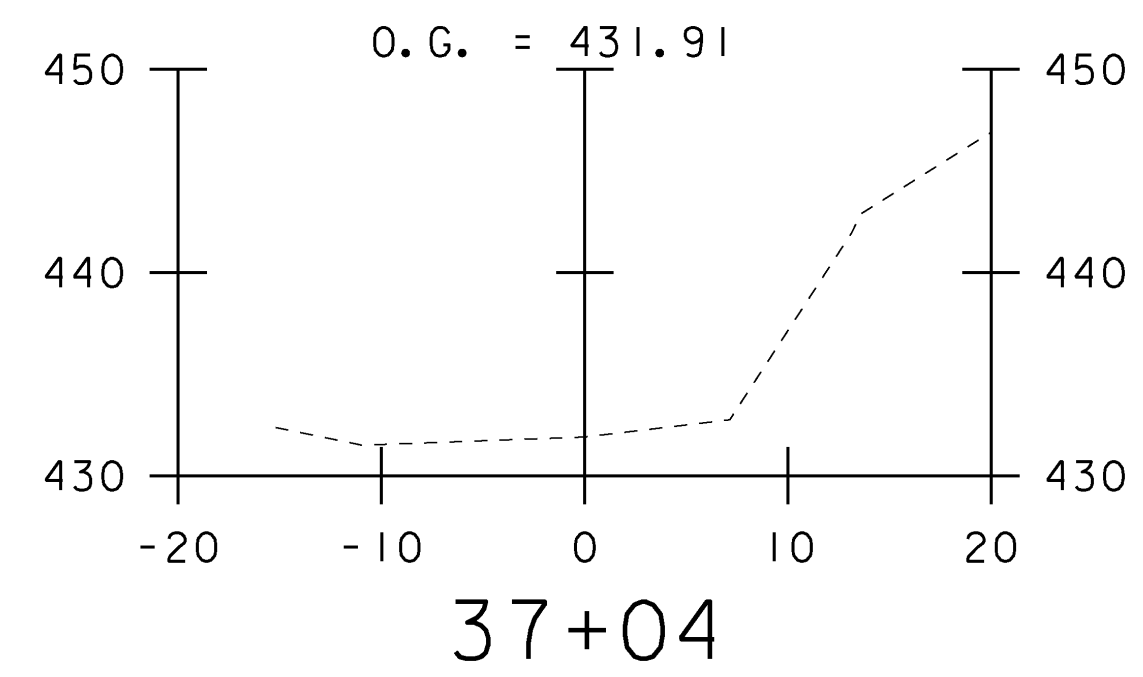
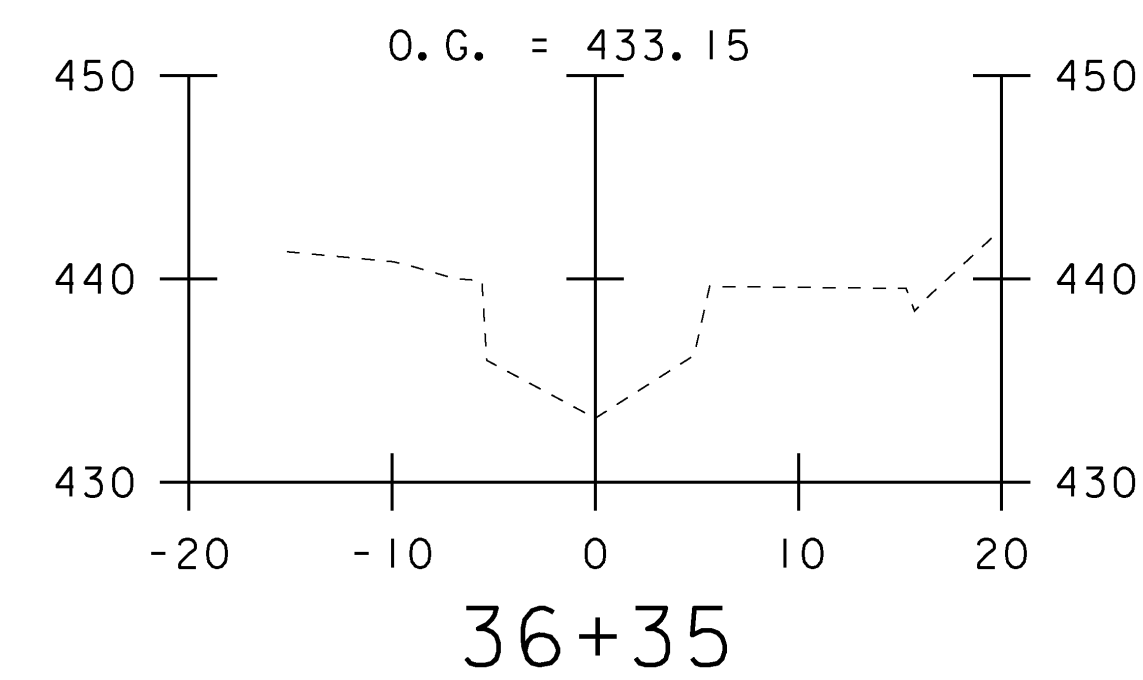
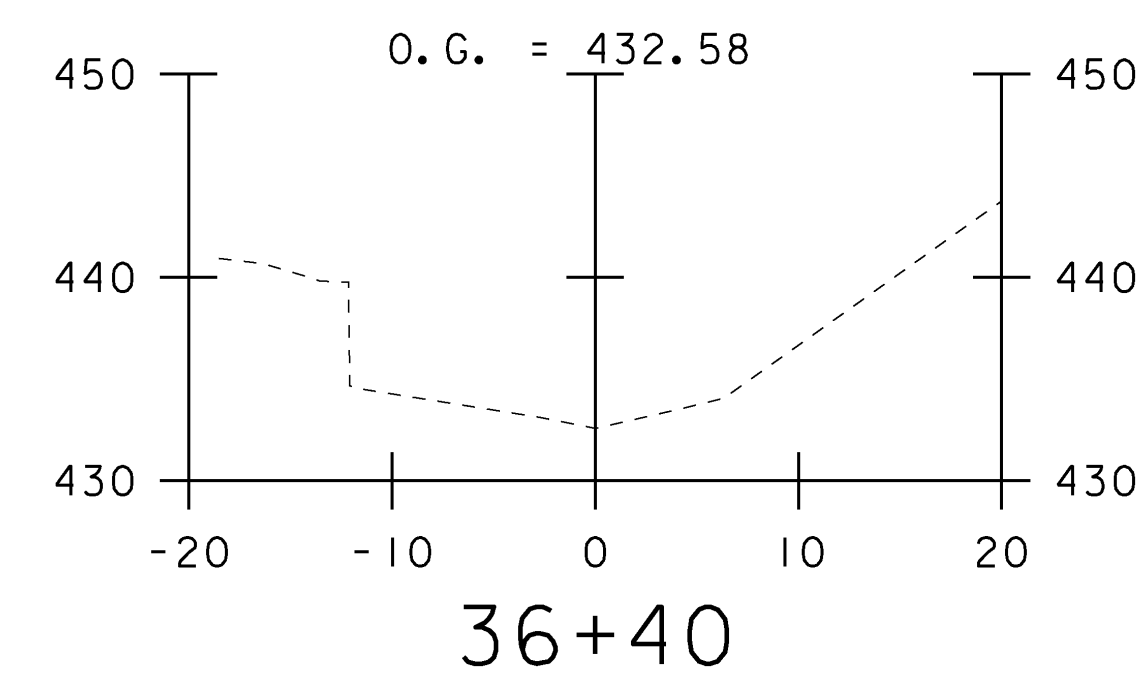
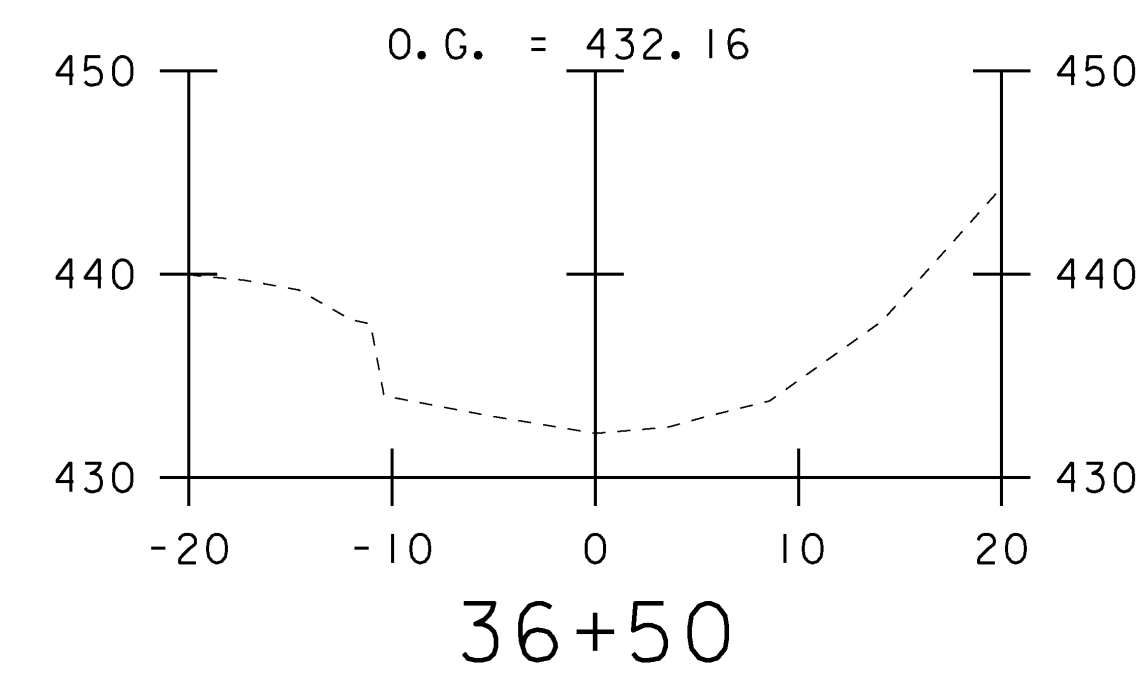
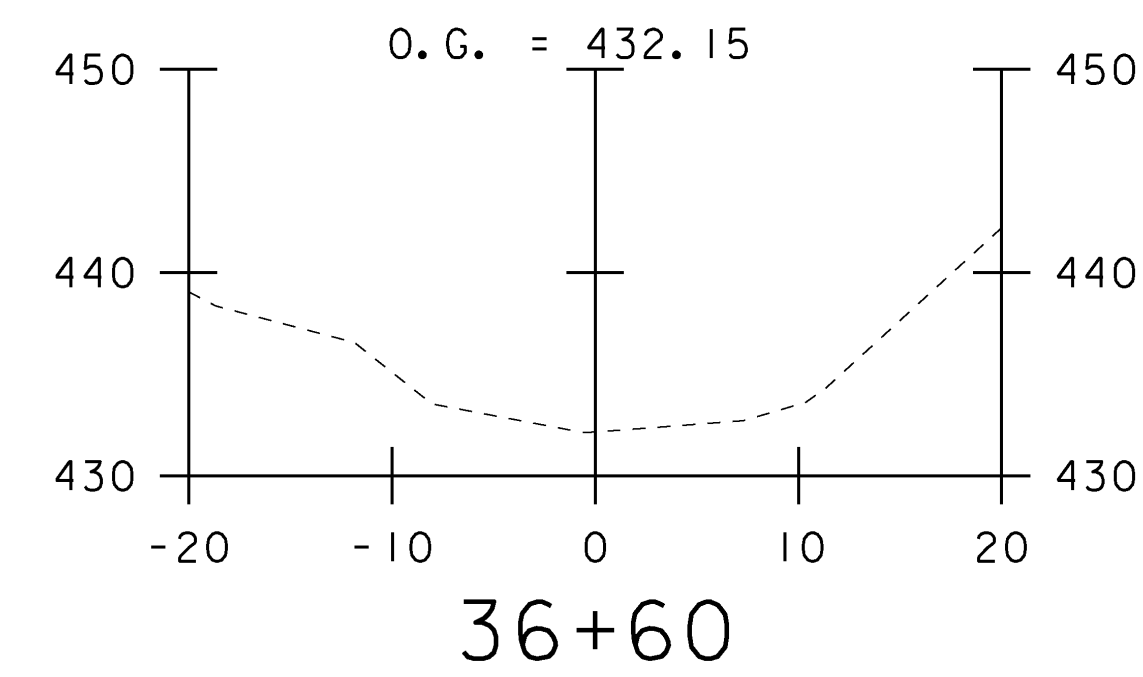
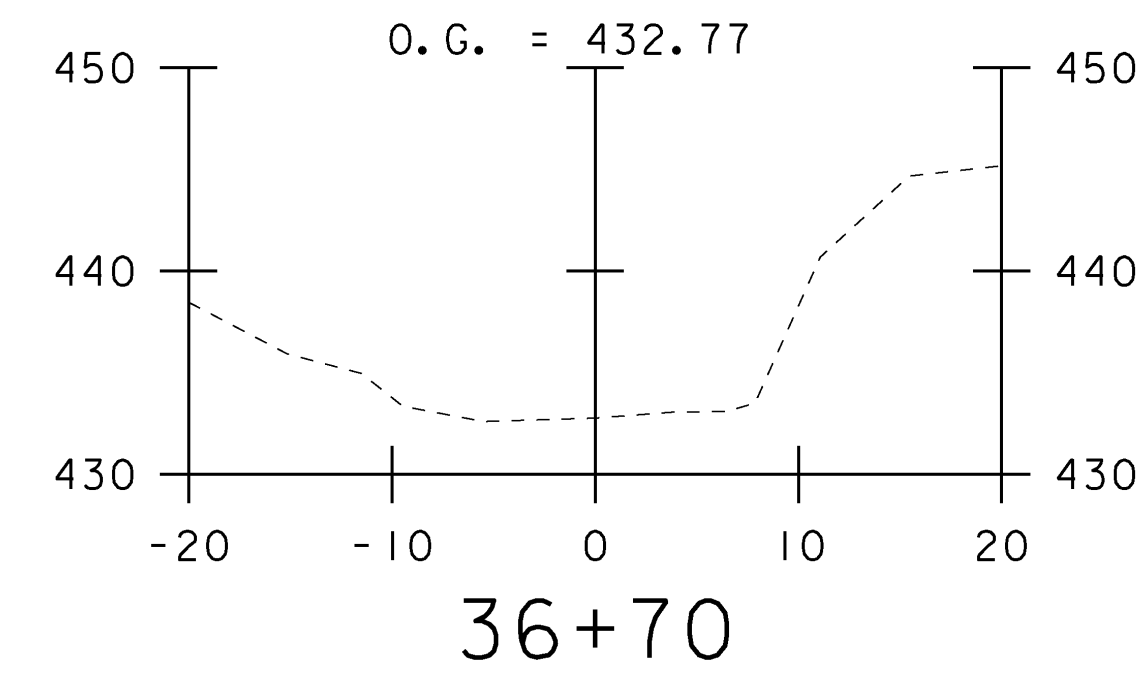
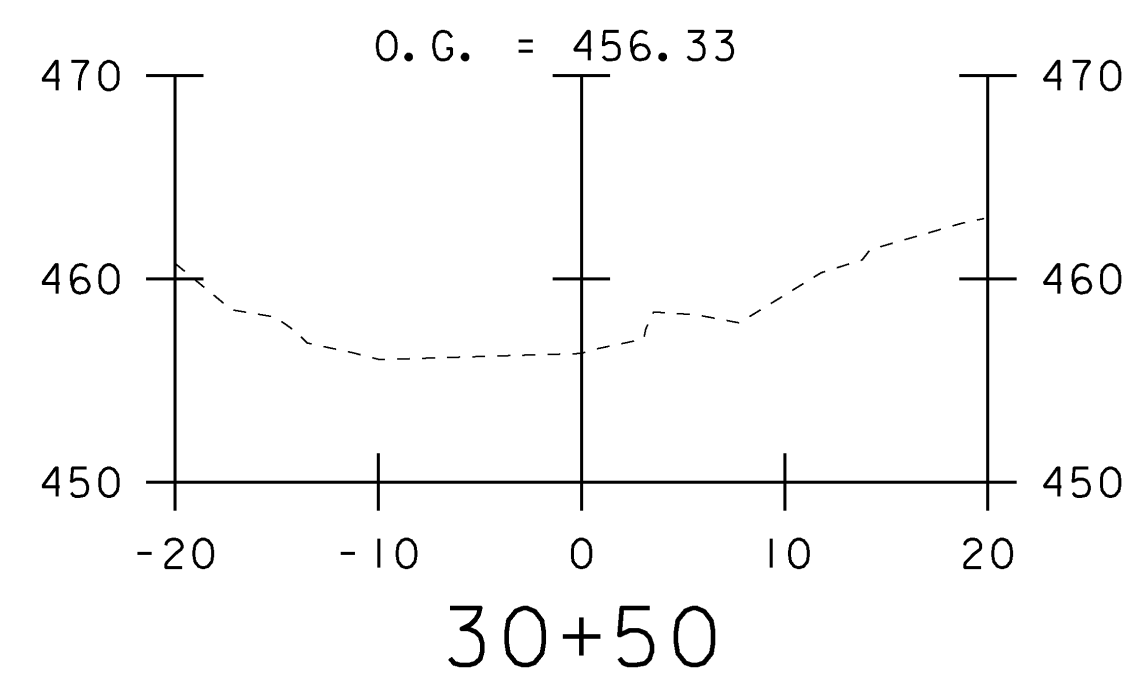
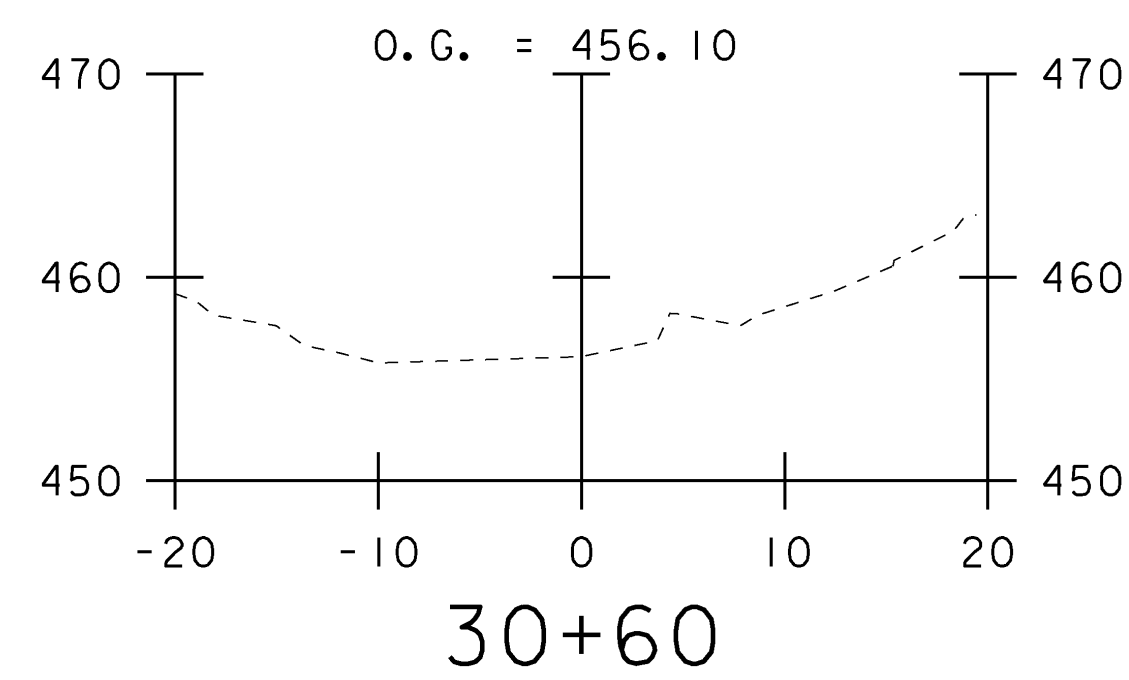
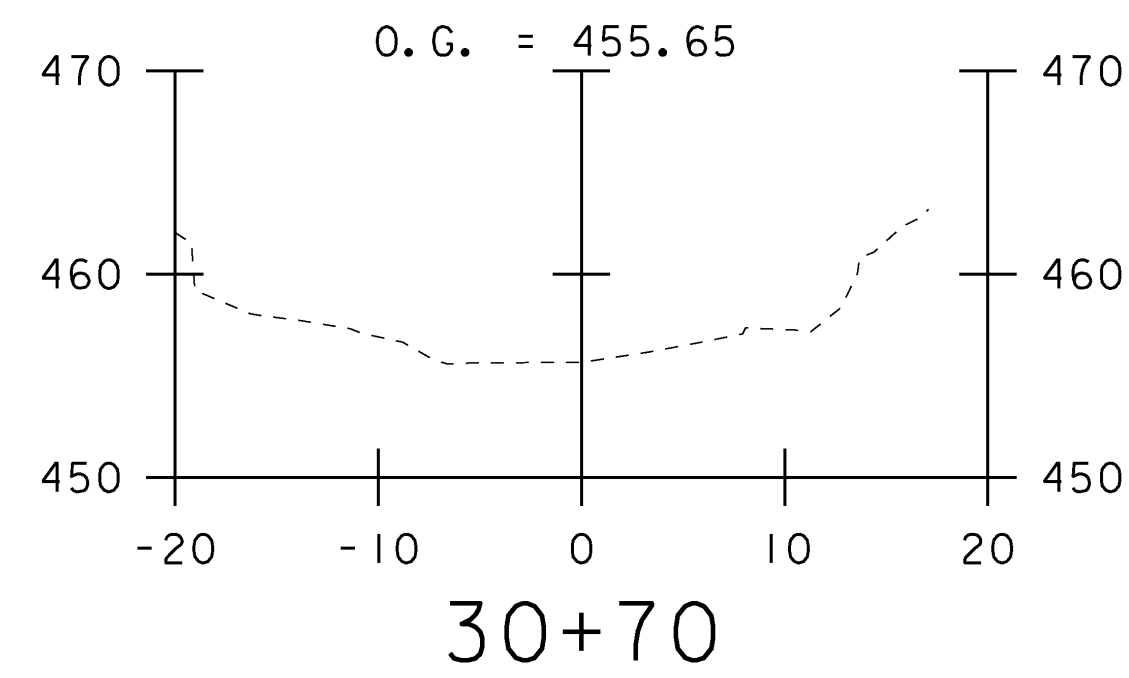
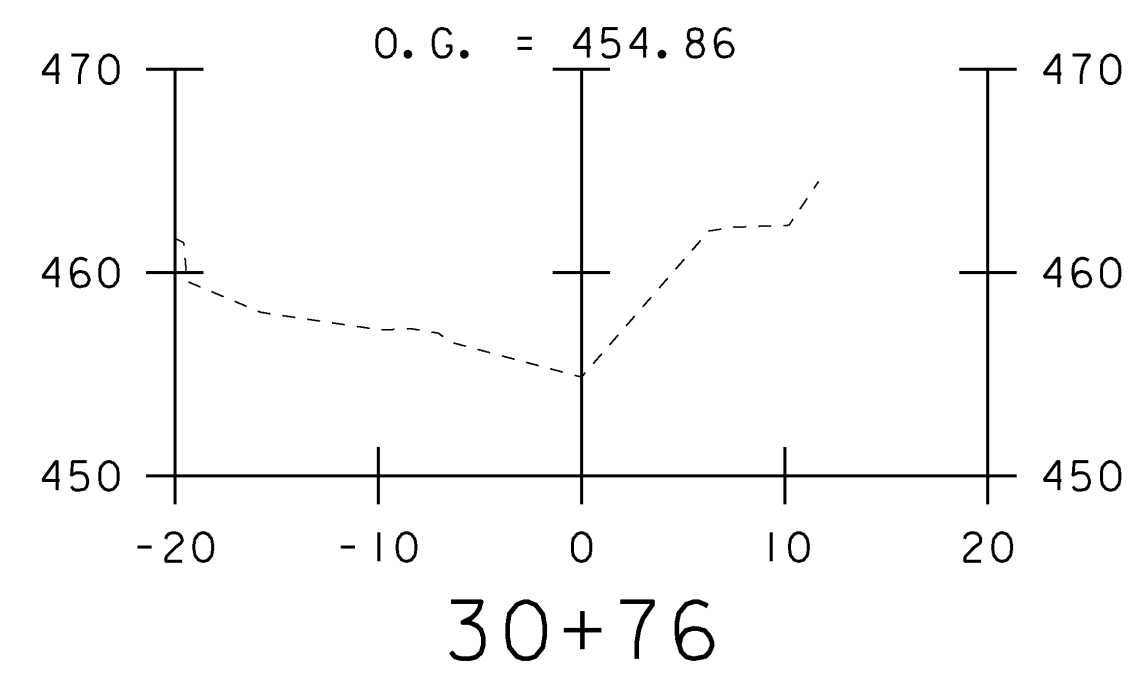
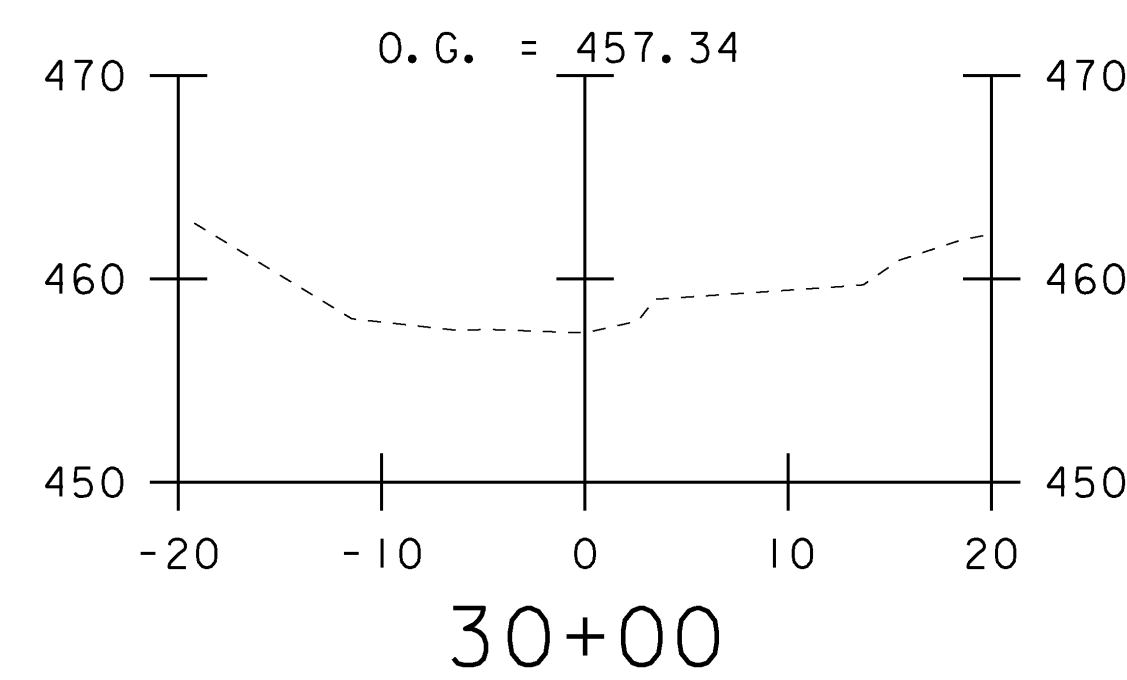
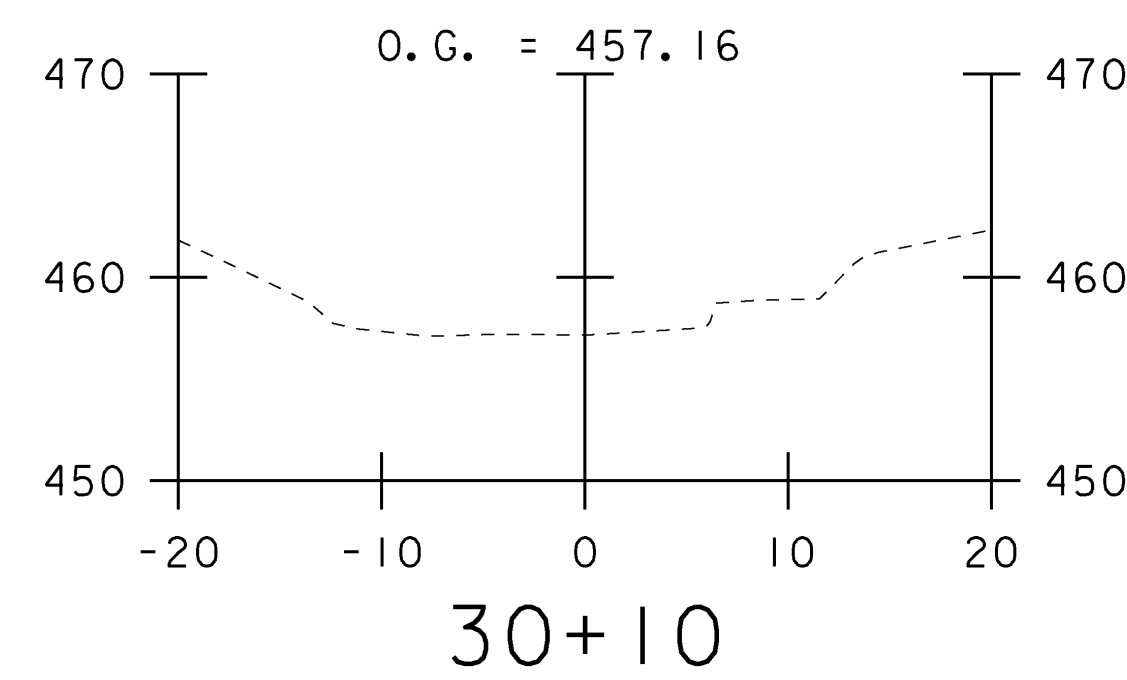
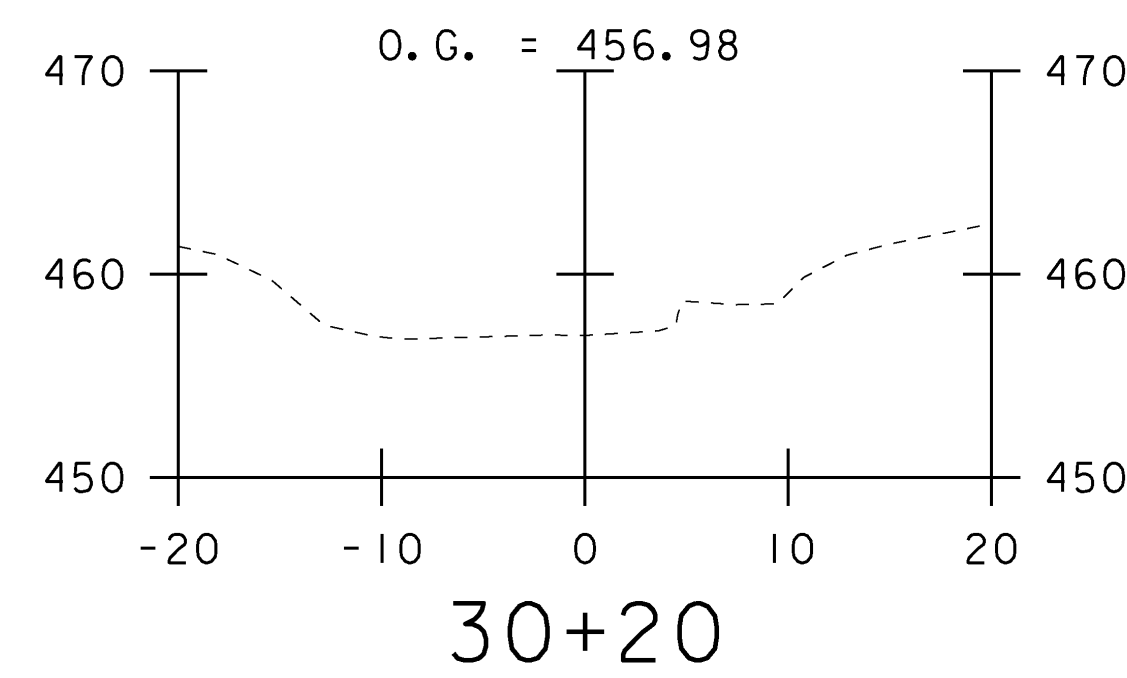
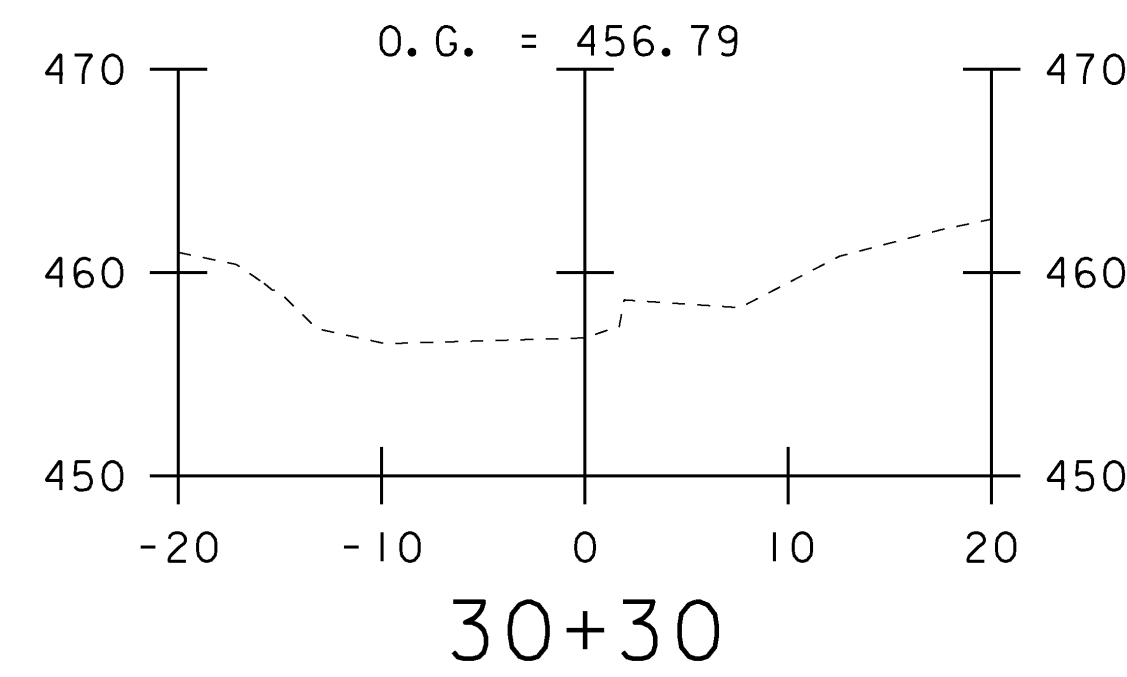


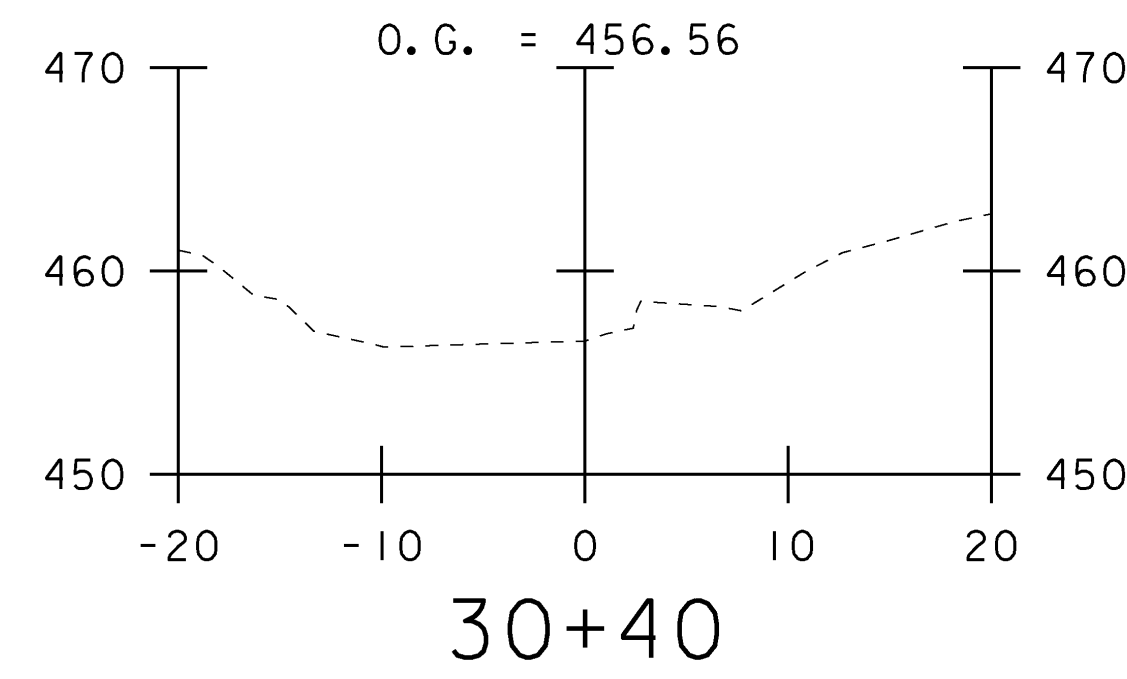

PROJECT NAME: SHARON  
PROJECT NUMBER: IM CULV (18)

FILE NAME: z08a190xsl.dgn  
PROJECT LEADER: DMB  
DESIGNED BY: MHM  
CROSS SECTIONS (14-2)

PLOT DATE: 13-JUL-2009  
DRAWN BY: MJF  
CHECKED BY: DMB  
SHEET 28 OF 36