



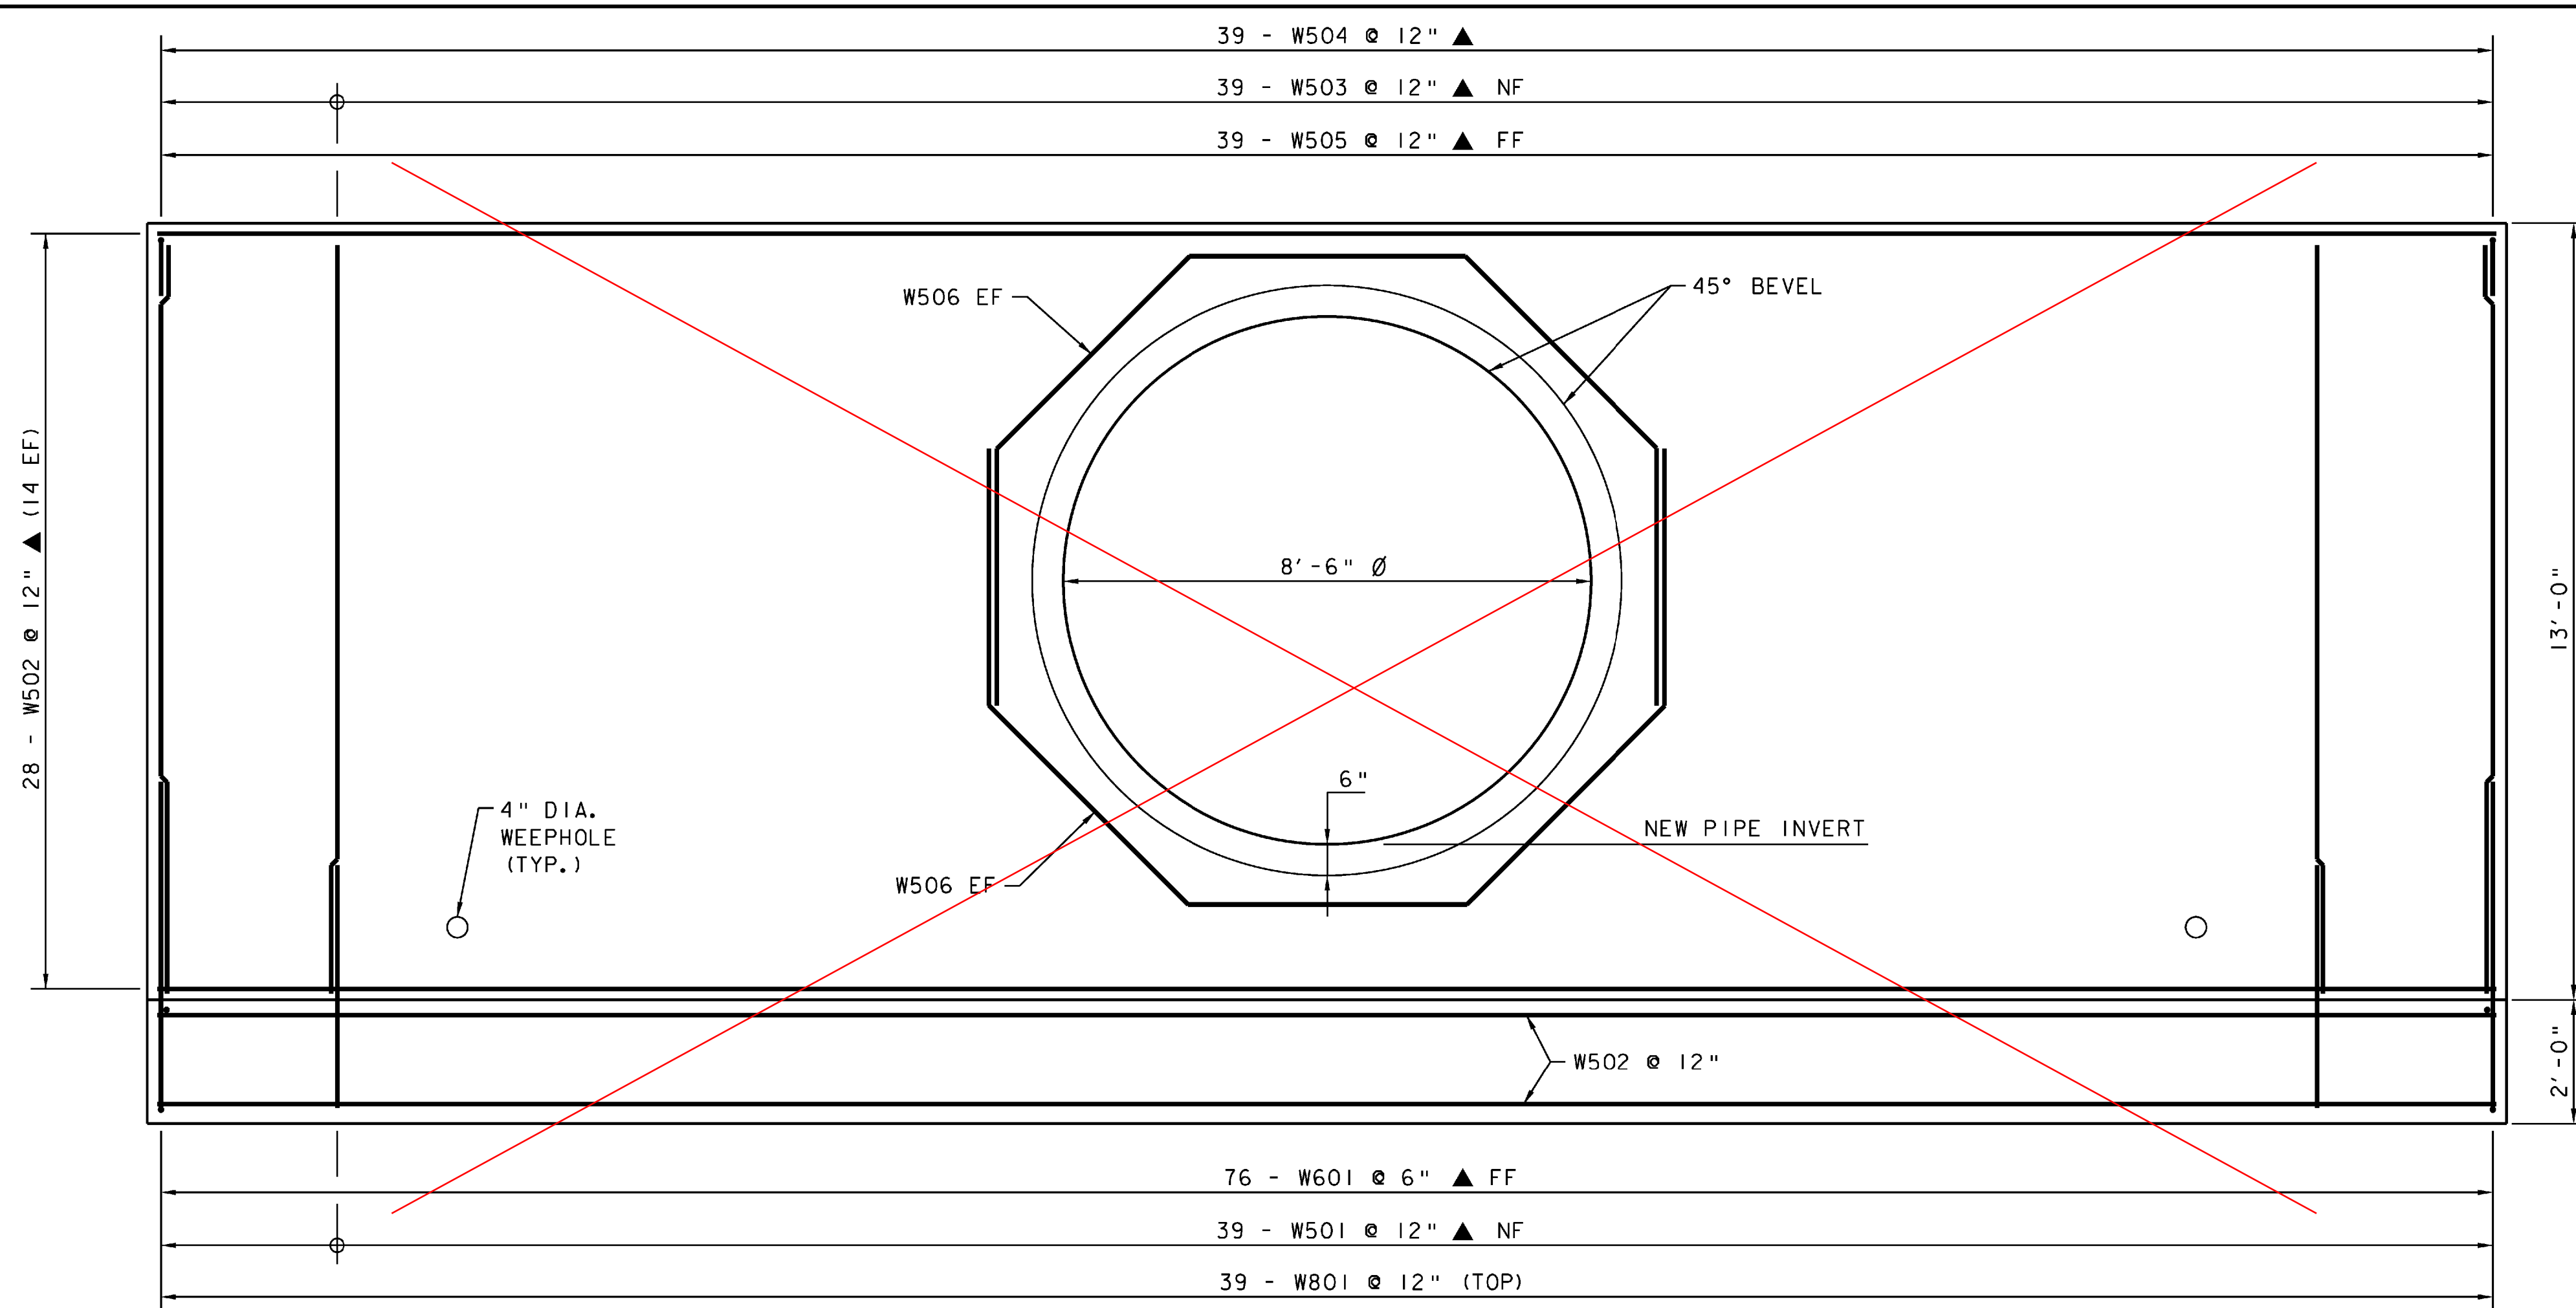

HEADWALL ELEVATION


SCALE $\frac{1}{2}" = 1'-0"$

SEE CHANGE IN DESIGN 3

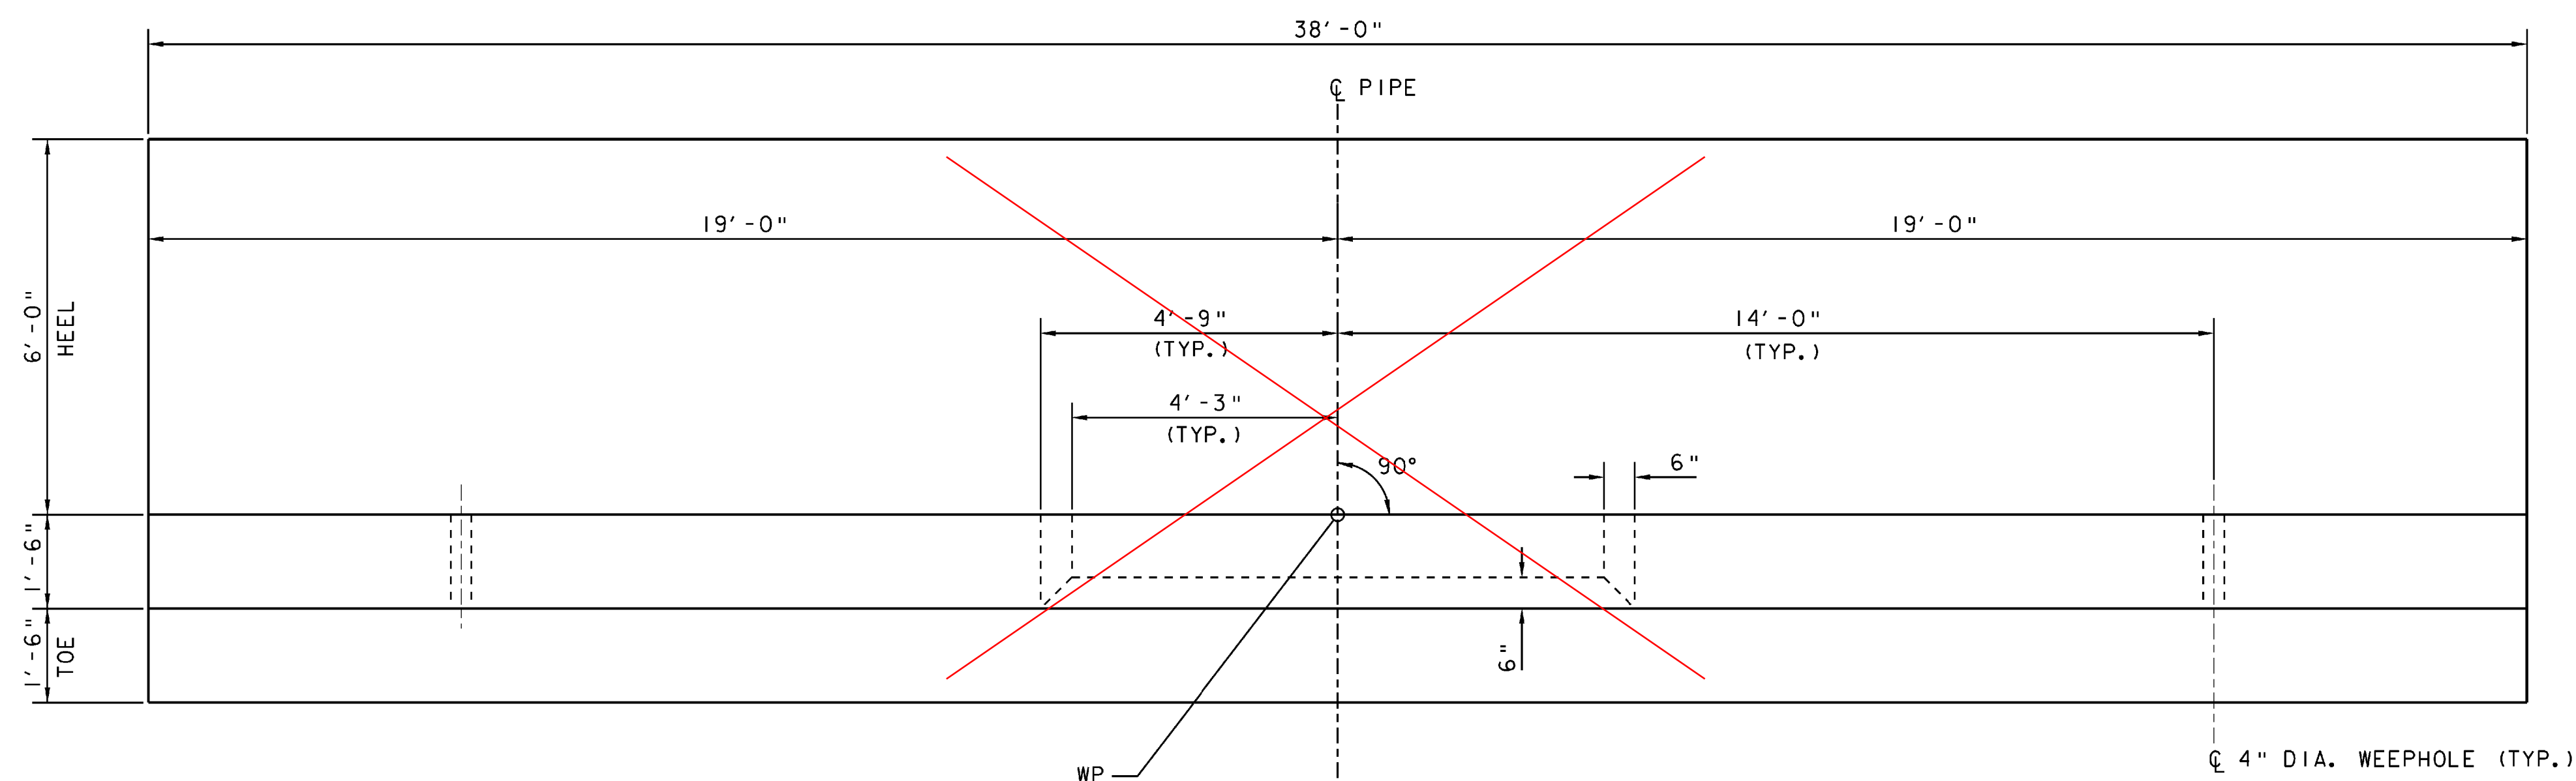


HEADWALL PLAN

SCALE $\frac{1}{2}" = 1'-0"$

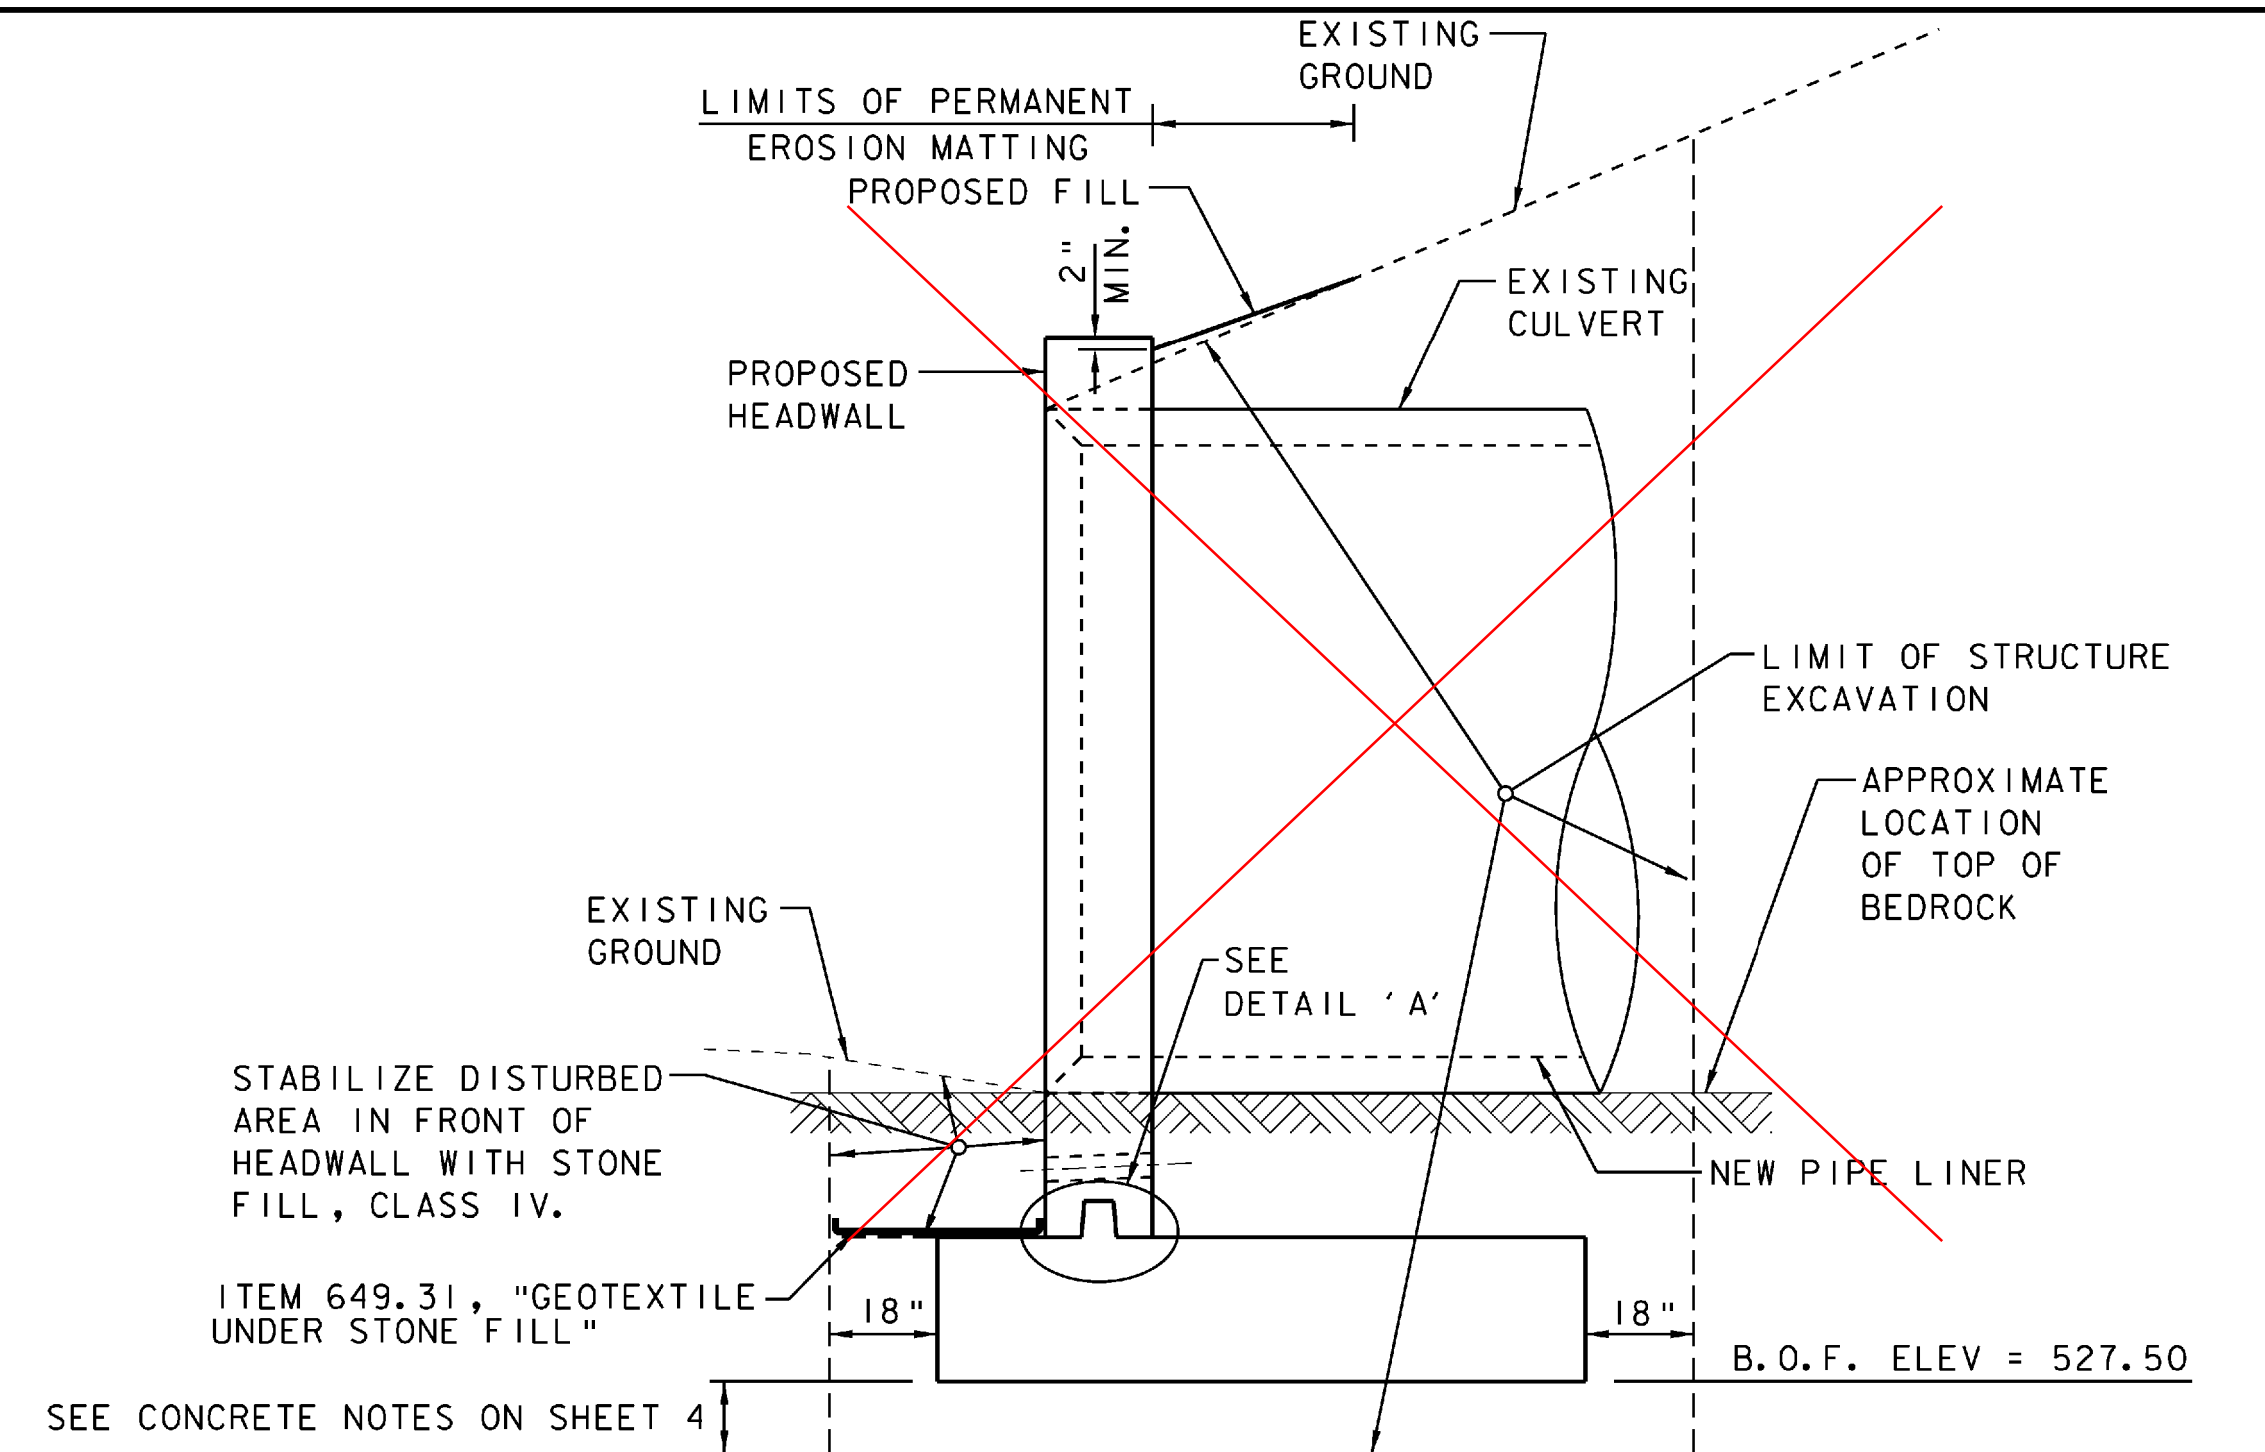

PROPOSED HEADWALL SECTION

SCALE $\frac{3}{8}" = 1'-0"$

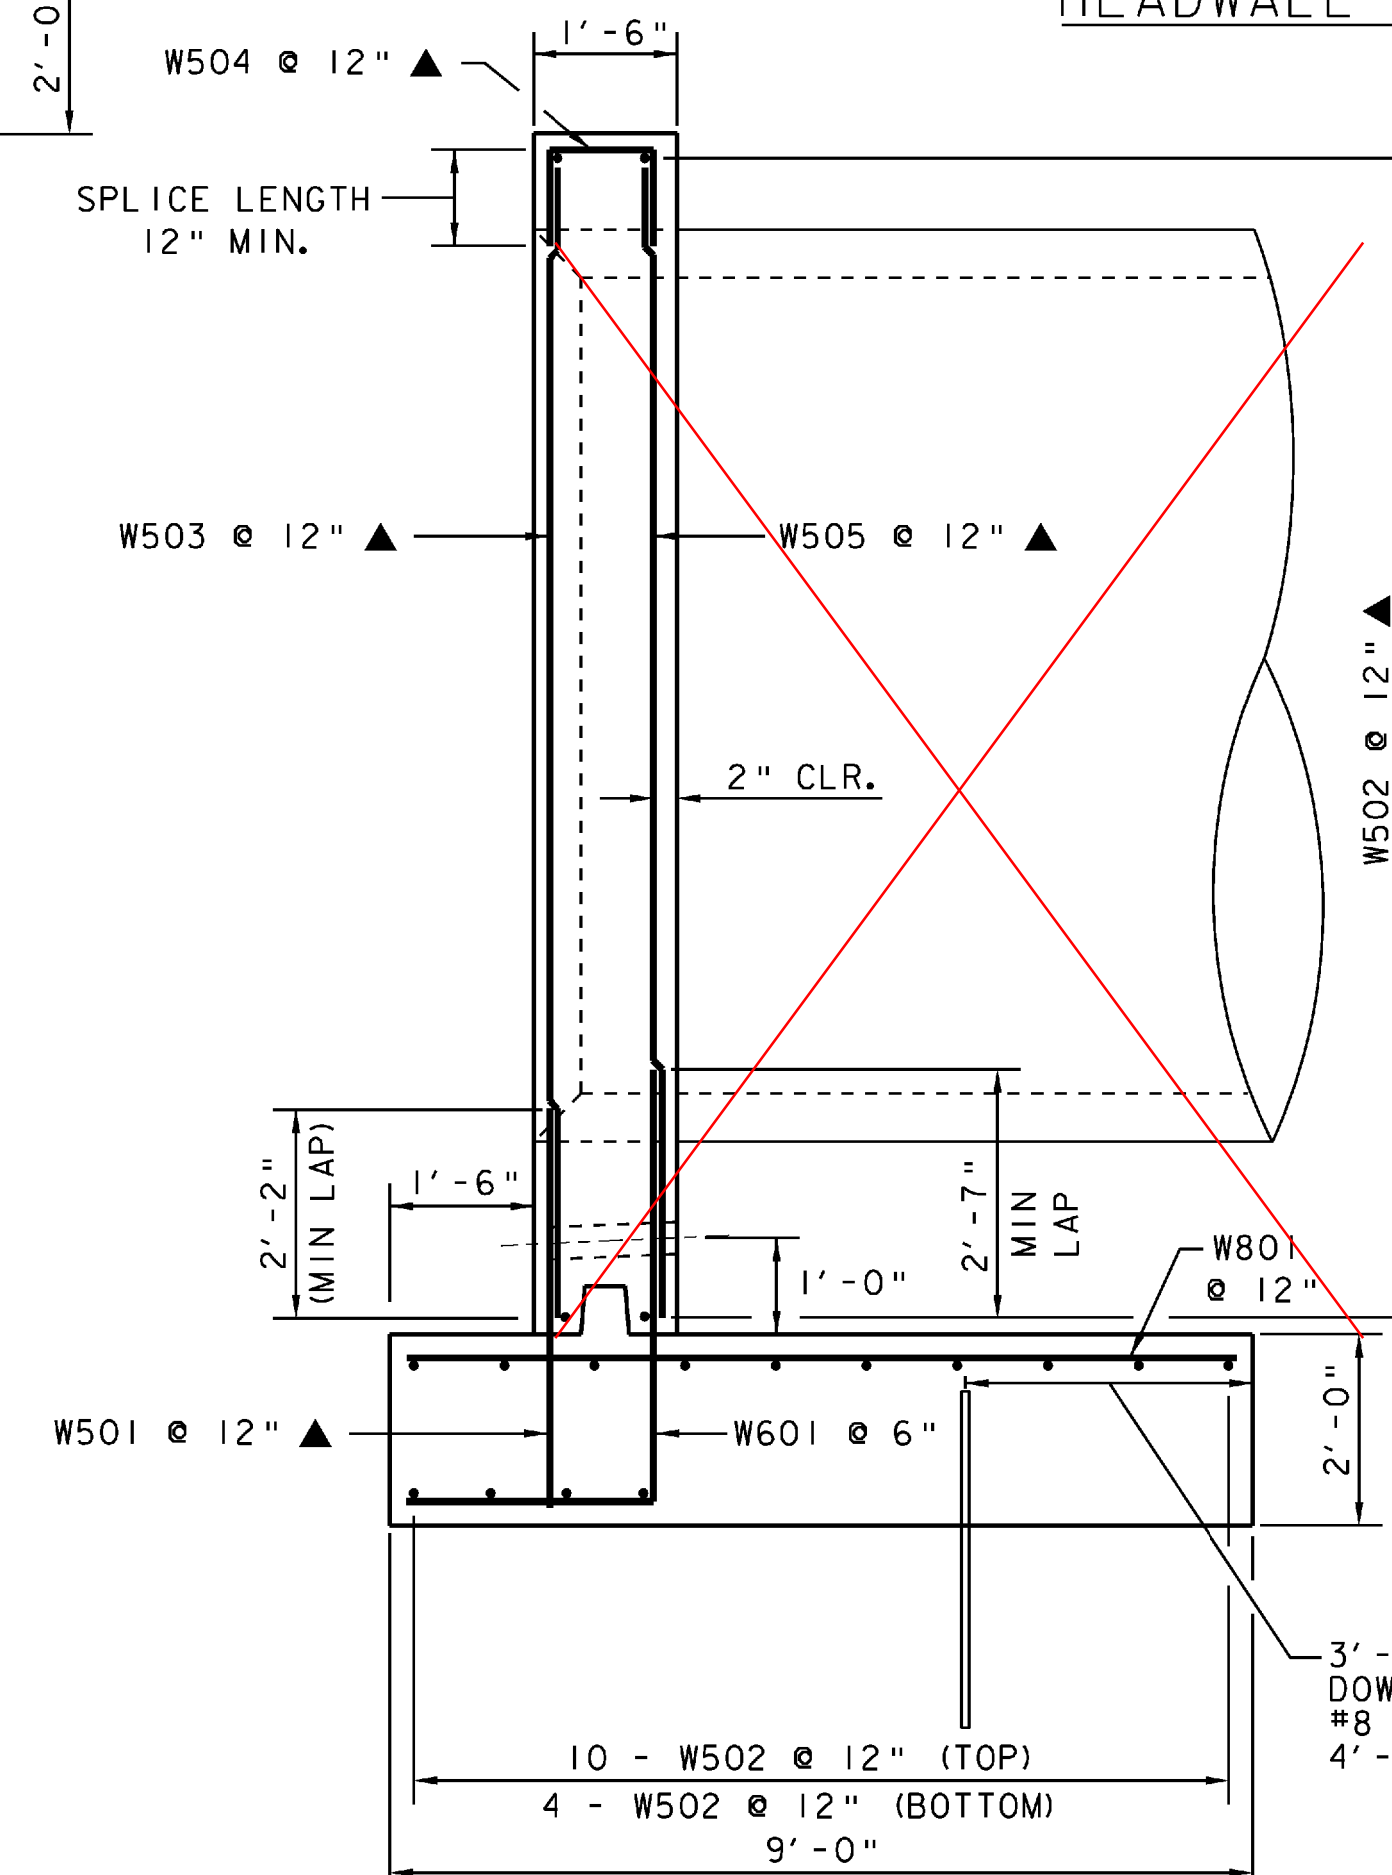


HEADWALL SECTION

SCALE $\frac{1}{2}" = 1'-0"$

NOTES:

1. SEE CONCRETE NOTES ON SHEET 4 FOR SUBFOOTING AND DOWEL DETAILS.
2. BEDROCK ELEVATION DETERMINED BY VISUAL INSPECTION.

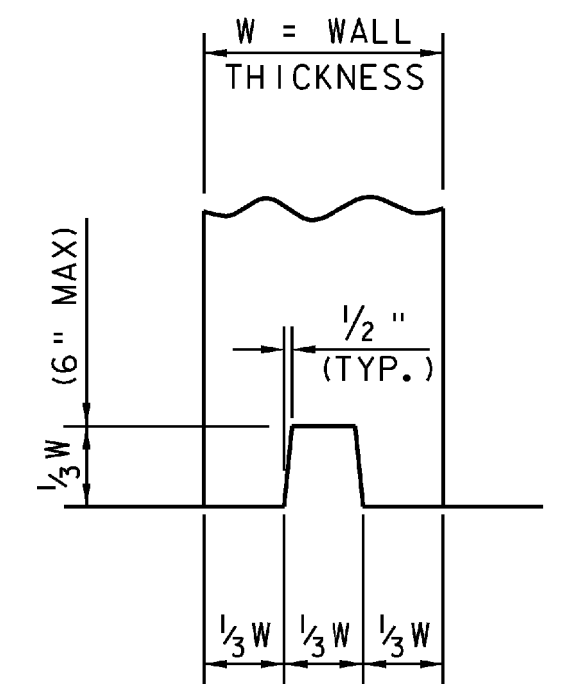

DETAIL 'A'

NOT TO SCALE

NOTE:

NF = NEAR FACE
FF = FAR FACE
EF = EACH FACE
▲ = CUT TO FIT IN FIELD
3" CLR. UNLESS OTHERWISE SPECIFIED ON THE PLANS.



PROJECT NAME: SHARON
PROJECT NUMBER: IM CULV (18)

FILE NAME: HEADWALL I14-SHARON-14-I.DGN
PROJECT LEADER: DMB
DESIGNED BY: LKW
HEADWALL DETAILS (14-I)

PLOT DATE: 10-AUG-2009
DRAWN BY: SLM
CHECKED BY: WLD
SHEET 32 OF 36