



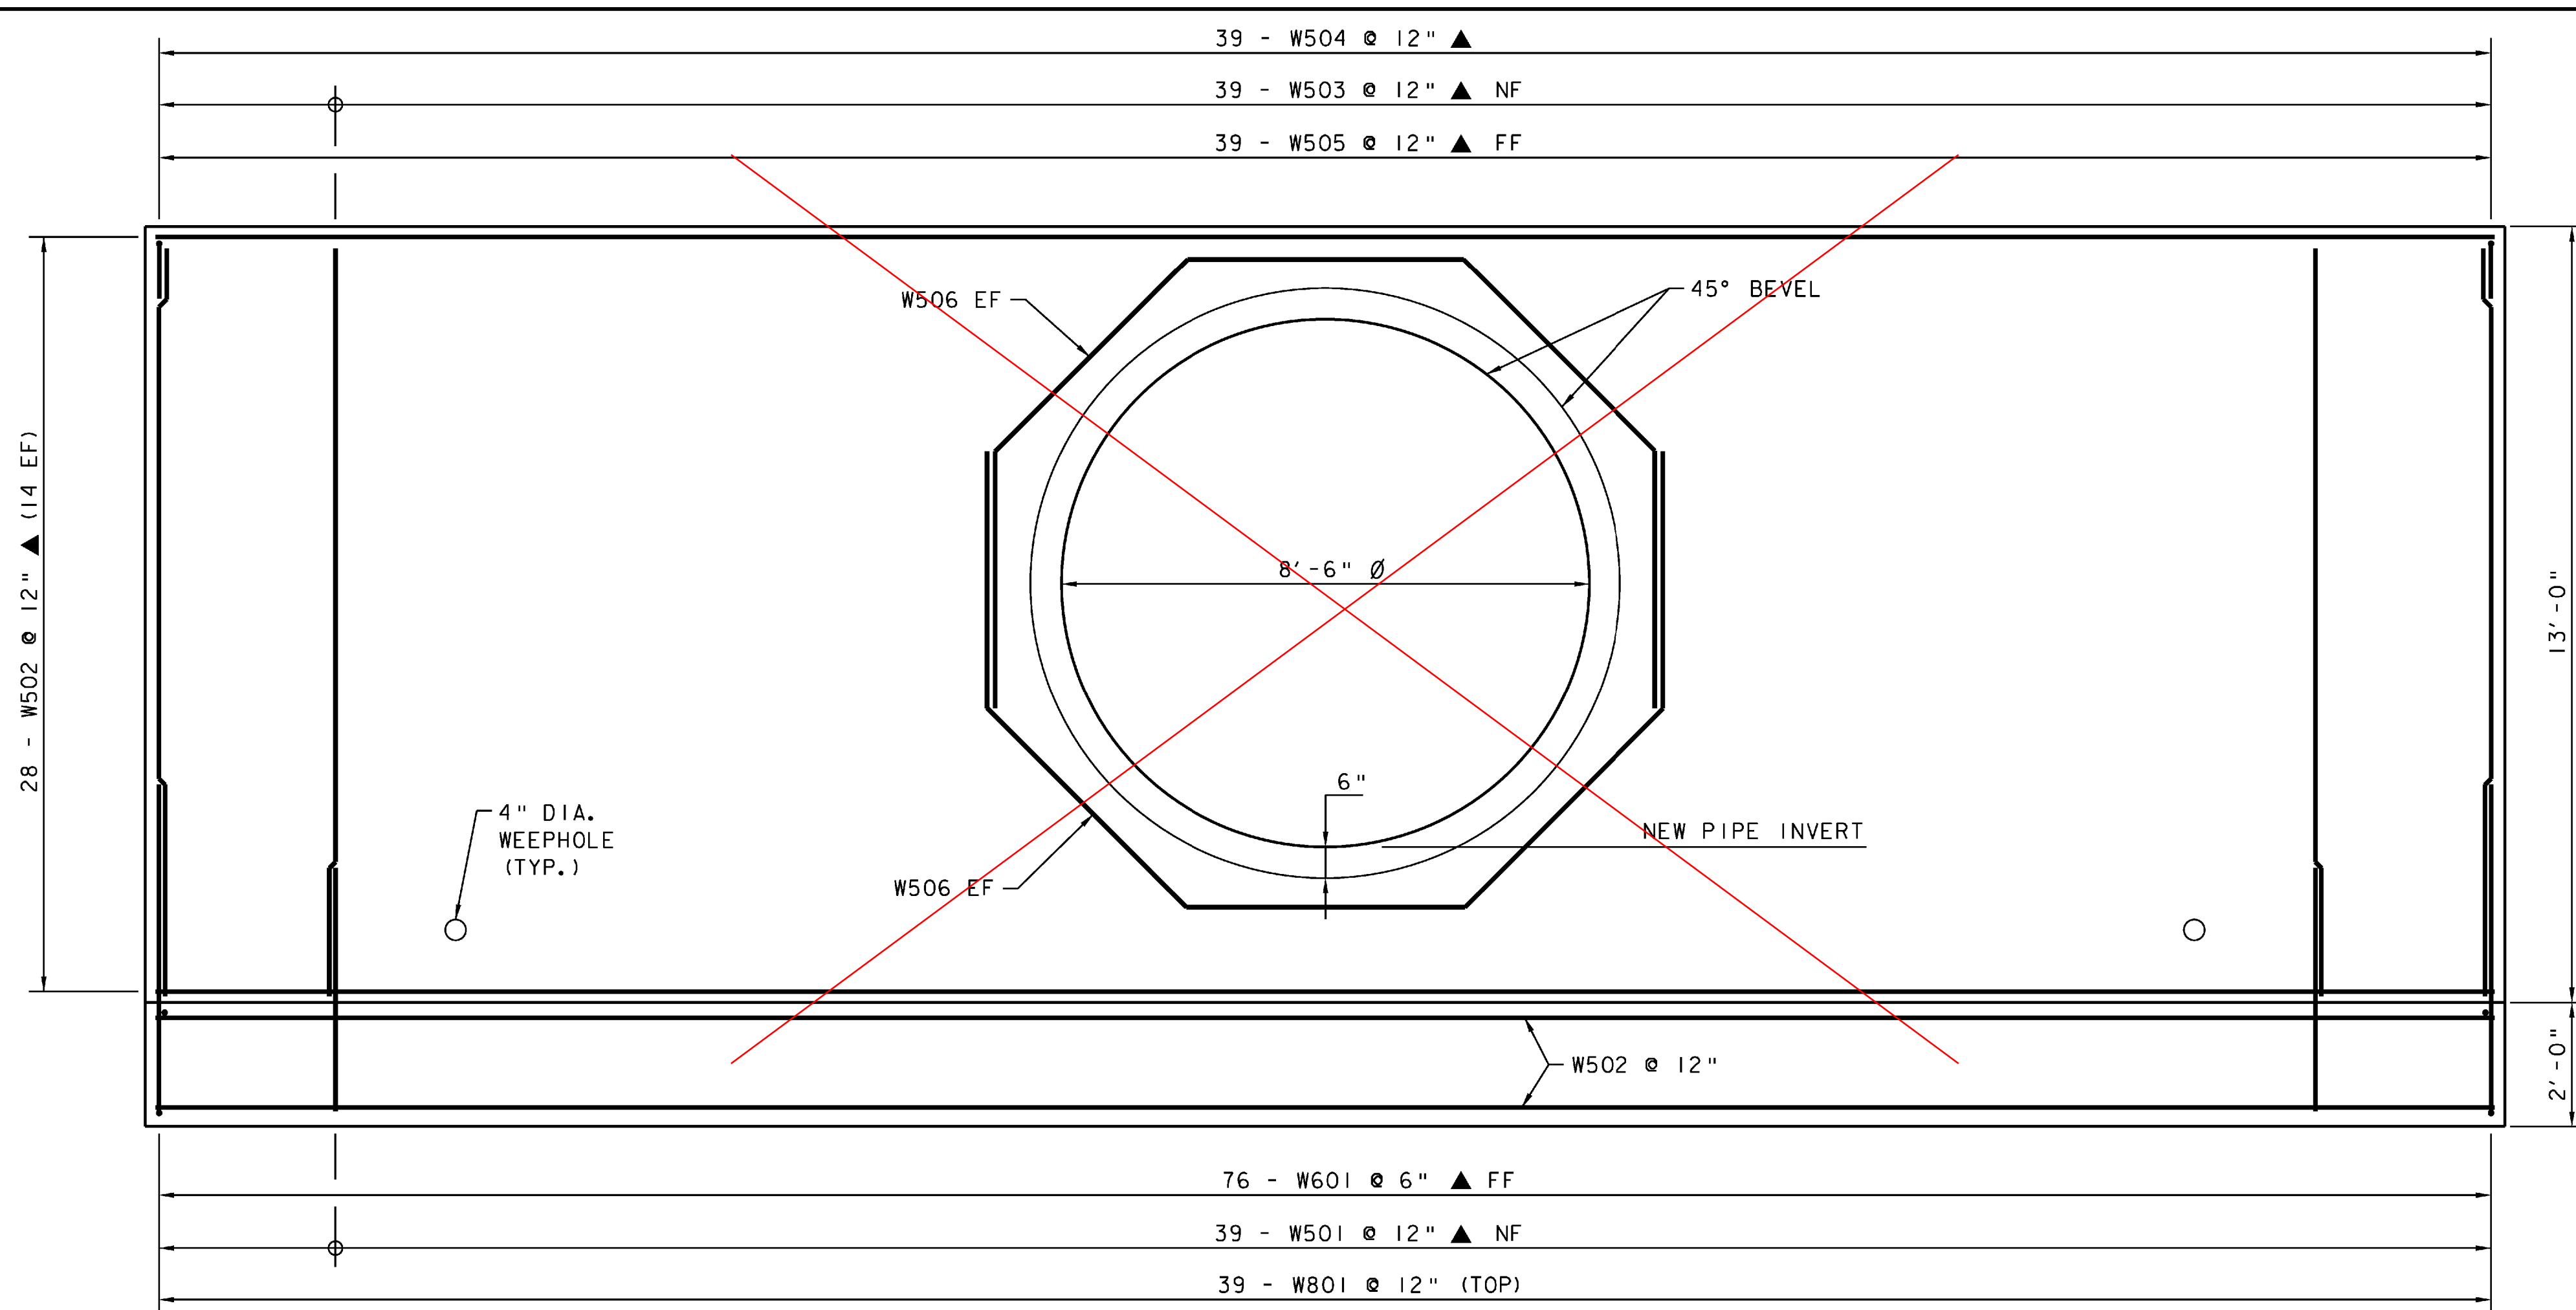

HEADWALL ELEVATION


SCALE 1/2" = 1'-0"

SEE CHANGE IN DESIGN 4

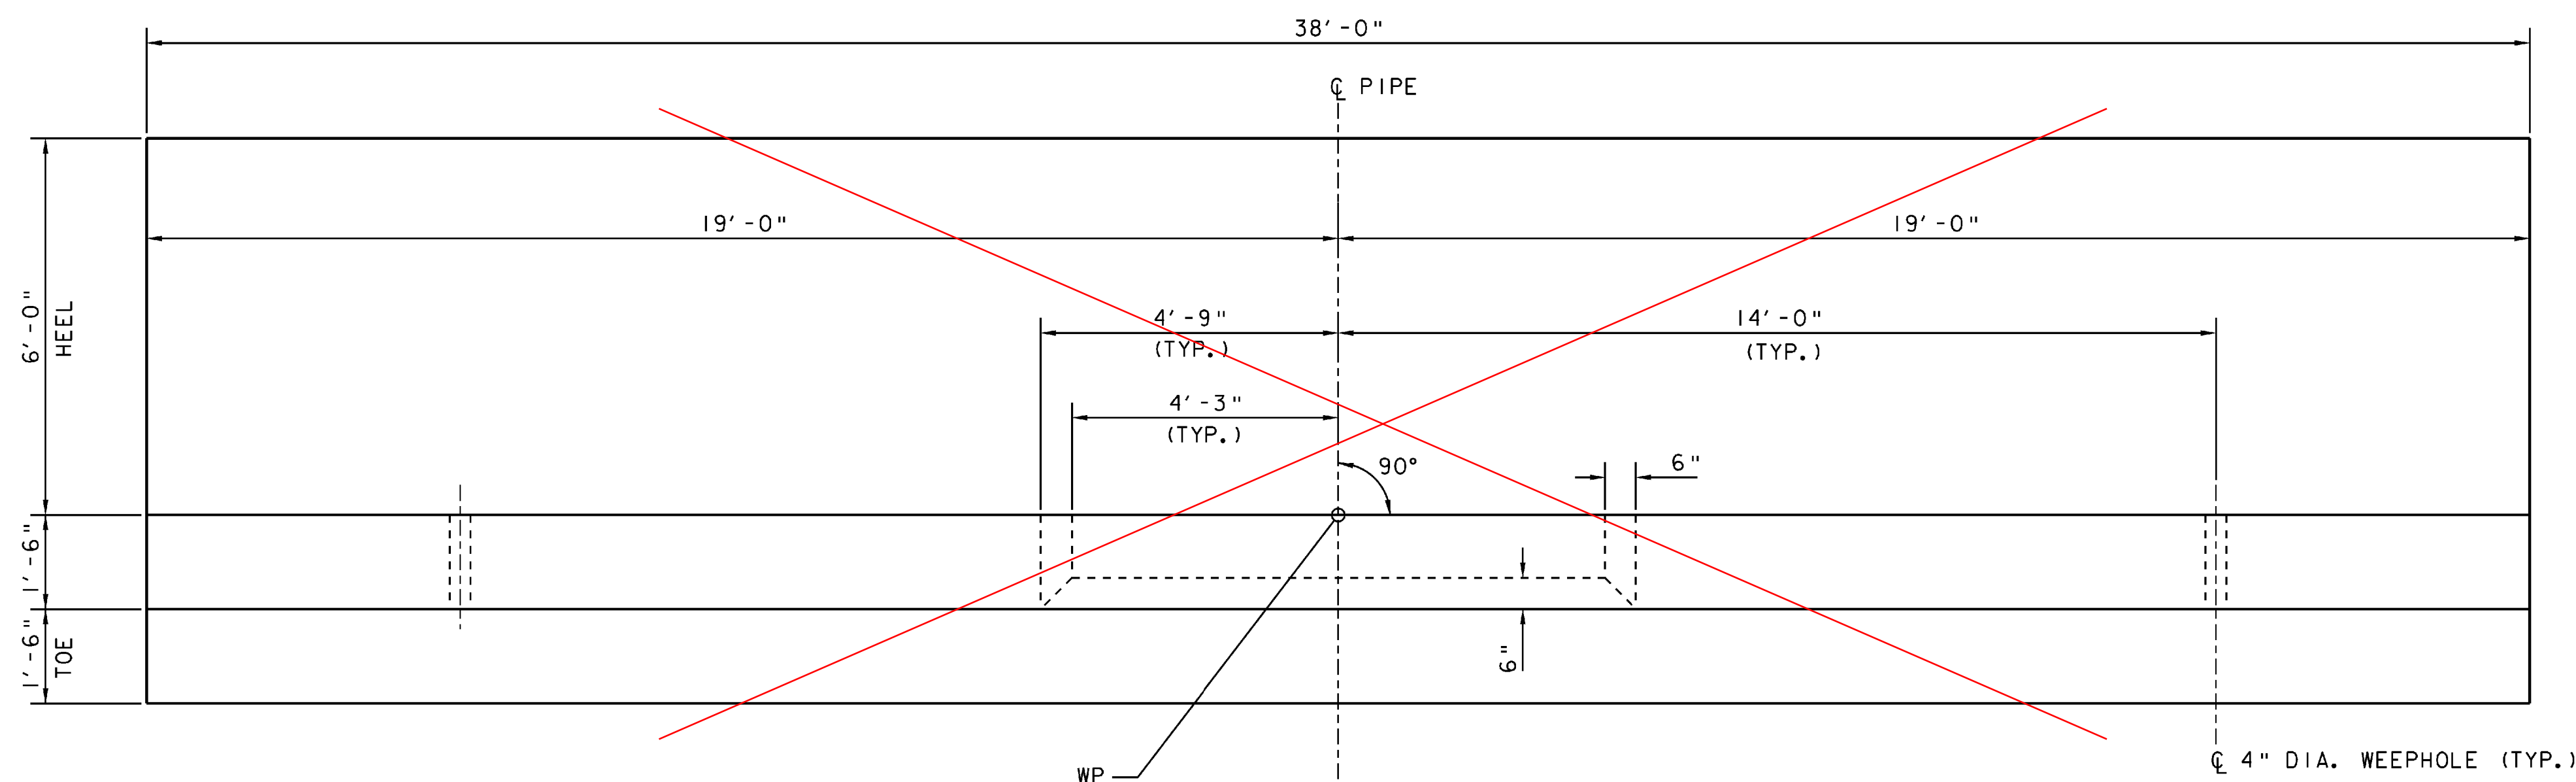


HEADWALL PLAN

SCALE 1/2" = 1'-0"

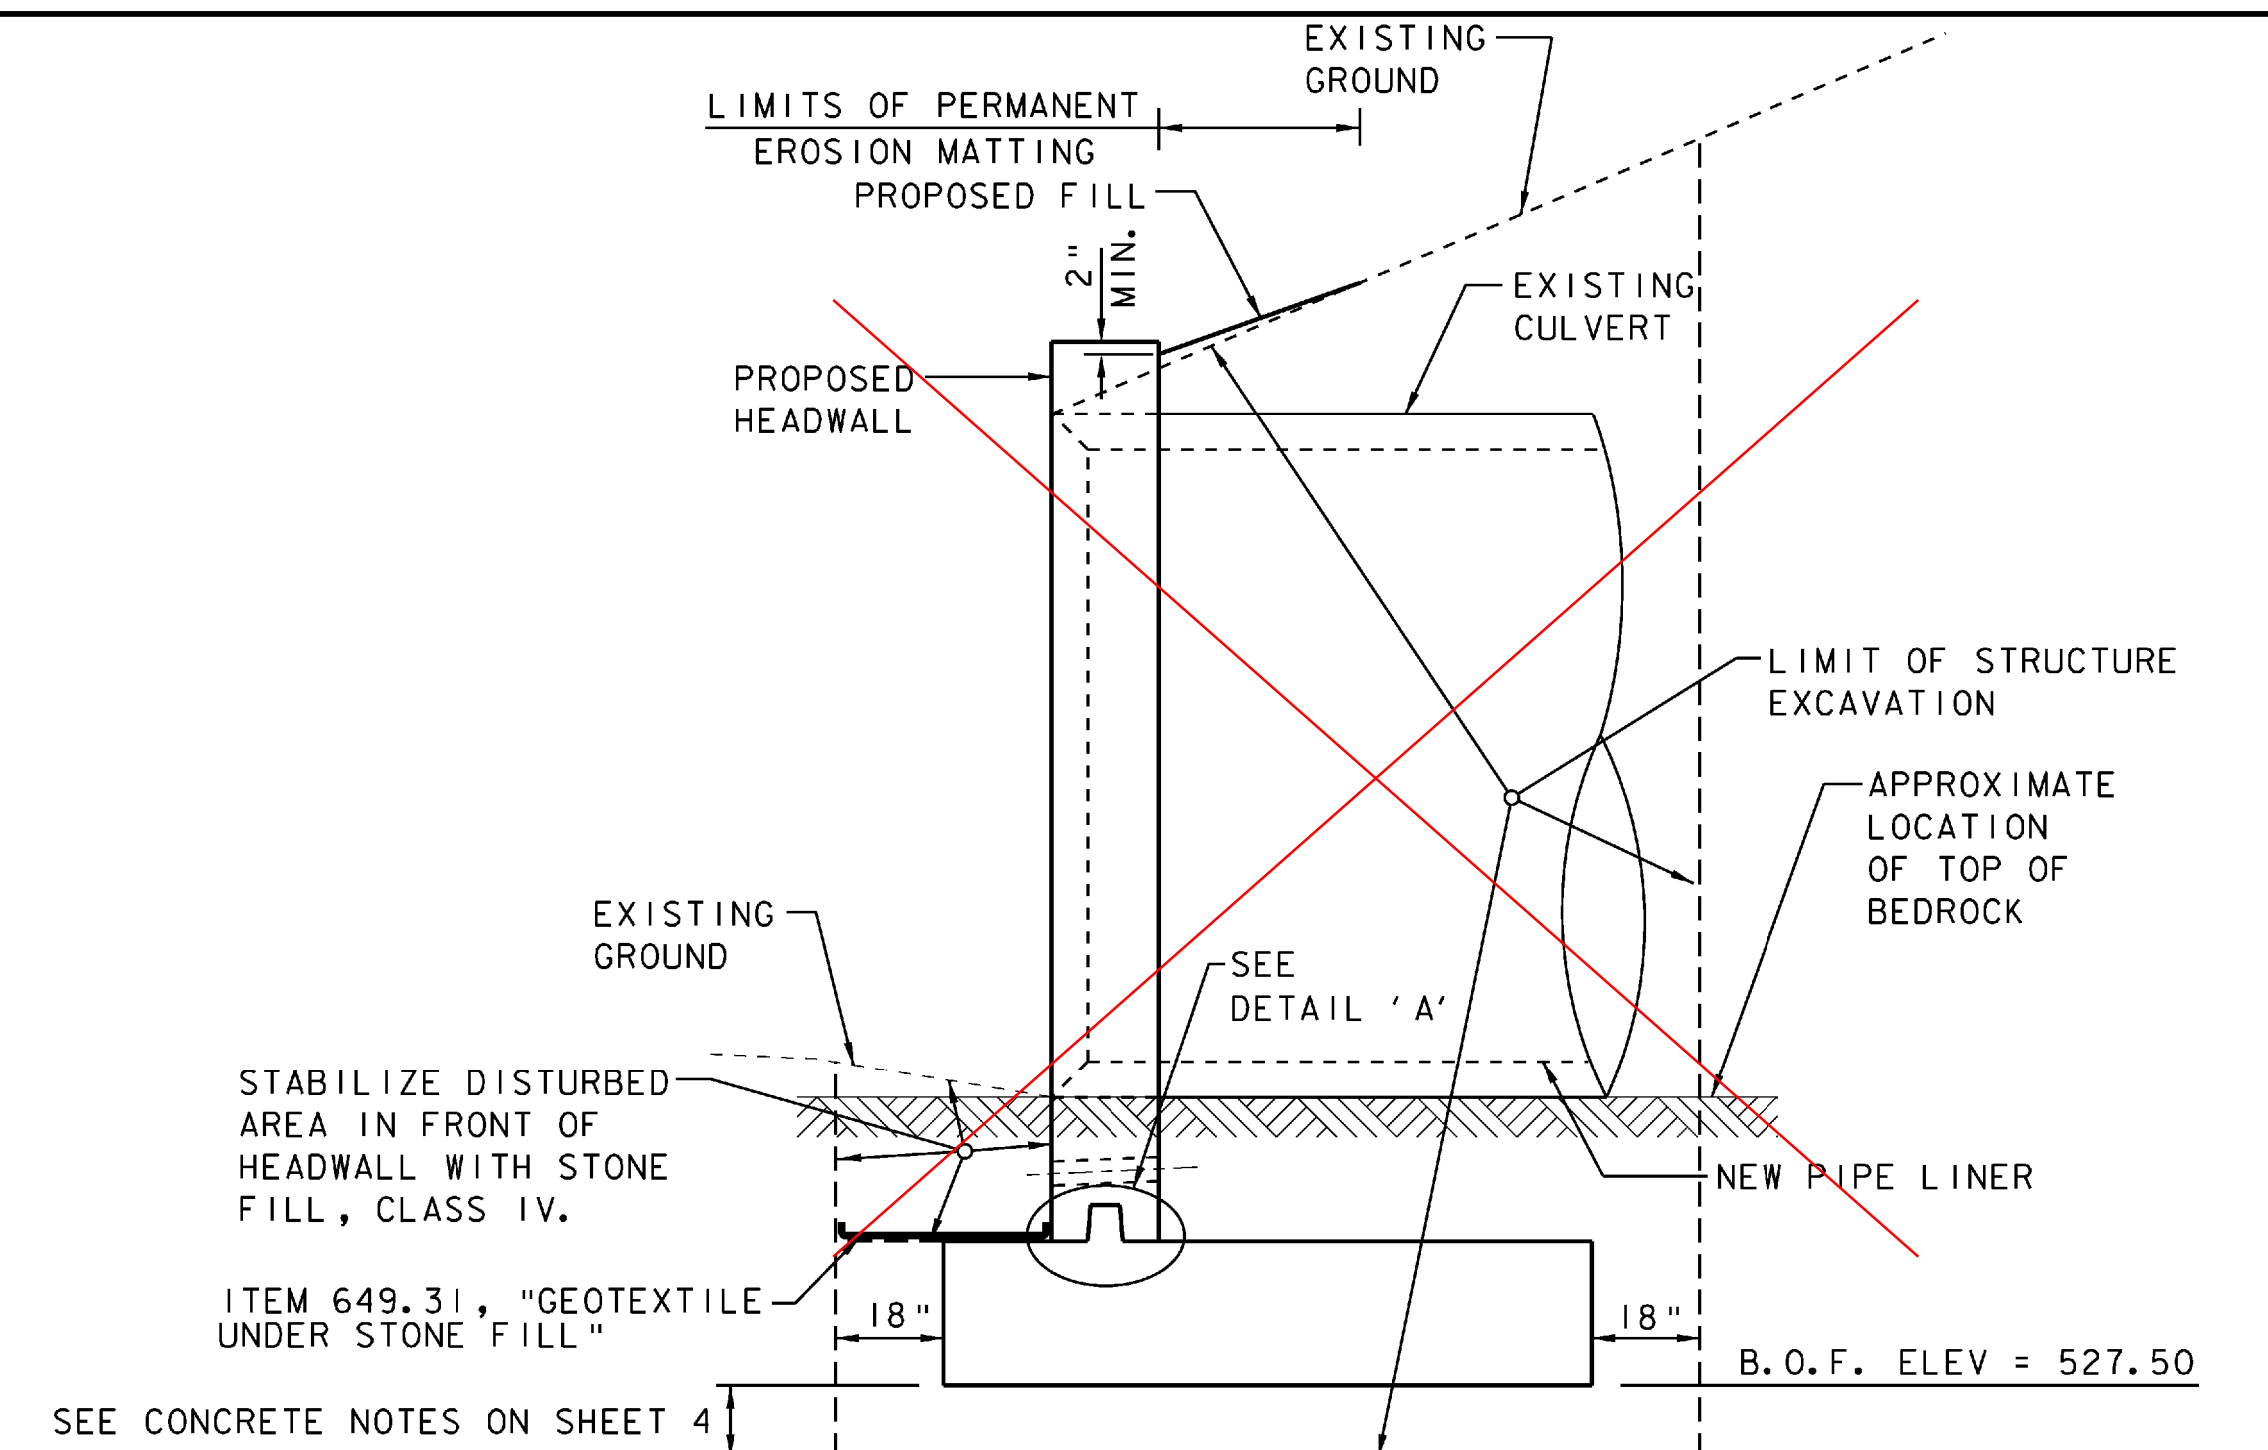

PROPOSED HEADWALL SECTION

SCALE 3/8" = 1'-0"

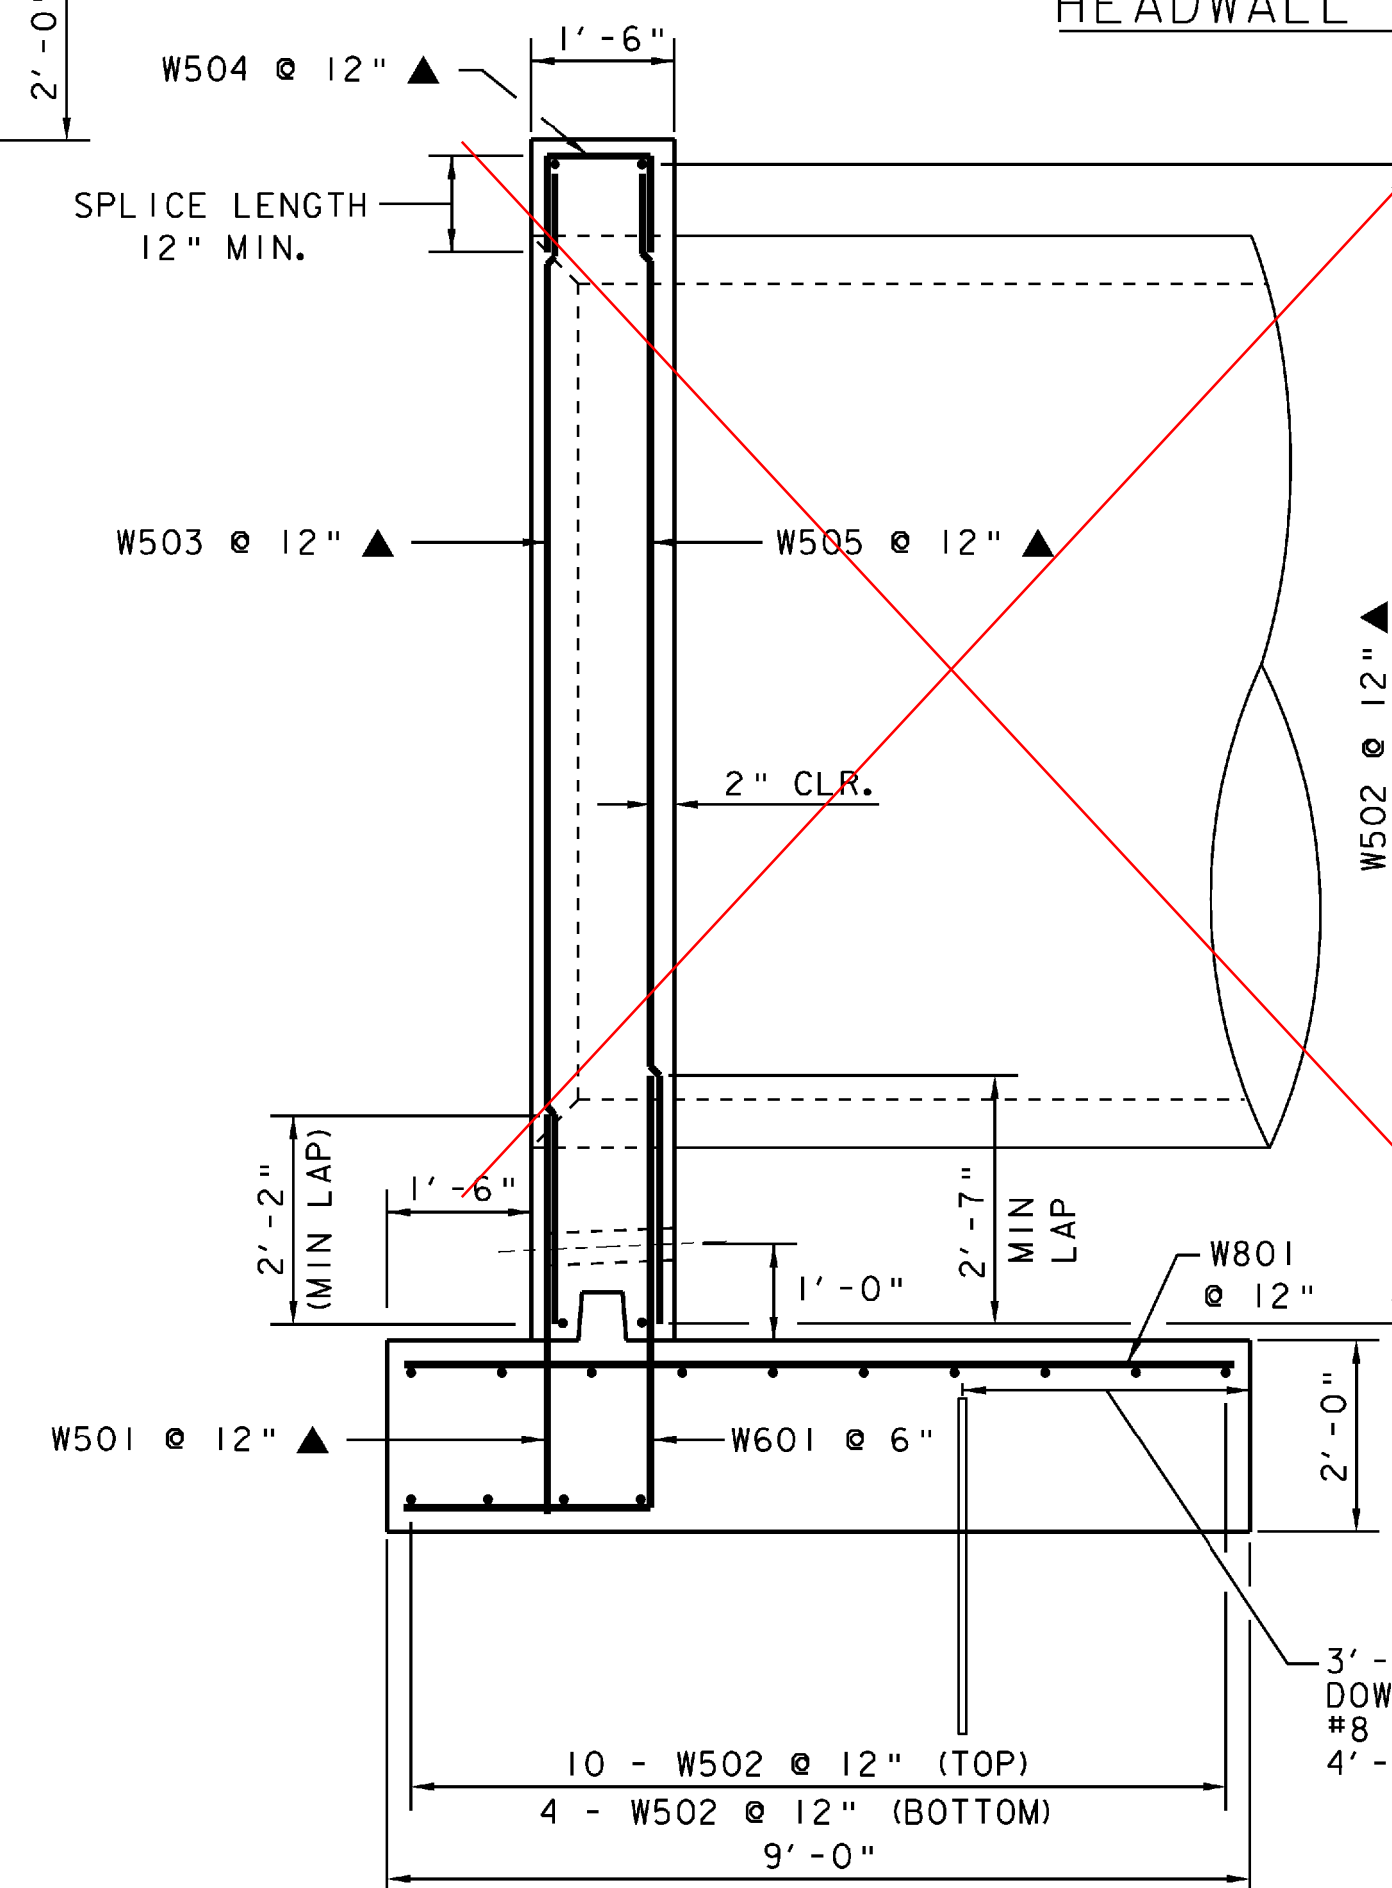


HEADWALL SECTION

SCALE 1/2" = 1'-0"

NOTES:

1. SEE CONCRETE NOTES ON SHEET 4 FOR SUBFOOTING AND DOWEL DETAILS.
2. BEDROCK ELEVATION DETERMINED BY VISUAL INSPECTION.

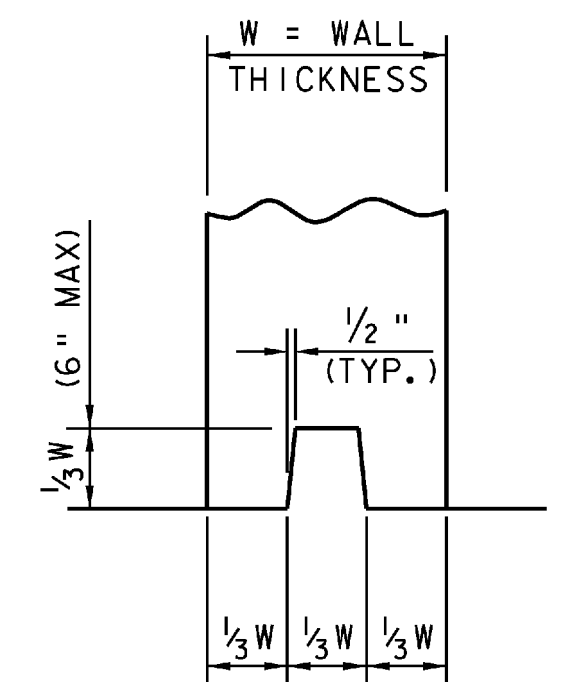

DETAIL 'A'
NOT TO SCALE

NOTE:

- NF = NEAR FACE
FF = FAR FACE
EF = EACH FACE
▲ = CUT TO FIT IN FIELD
3" CLR. UNLESS OTHERWISE SPECIFIED ON THE PLANS.



PROJECT NAME: SHARON
PROJECT NUMBER: IM CULV (18)

FILE NAME: HEADWALL I14-SHARON-14-L.DGN
PROJECT LEADER: DMB
DESIGNED BY: LKW
HEADWALL DETAILS (14-1)

PLOT DATE: 10-AUG-2009
DRAWN BY: SLM
CHECKED BY: WLD
SHEET 32 OF 36