



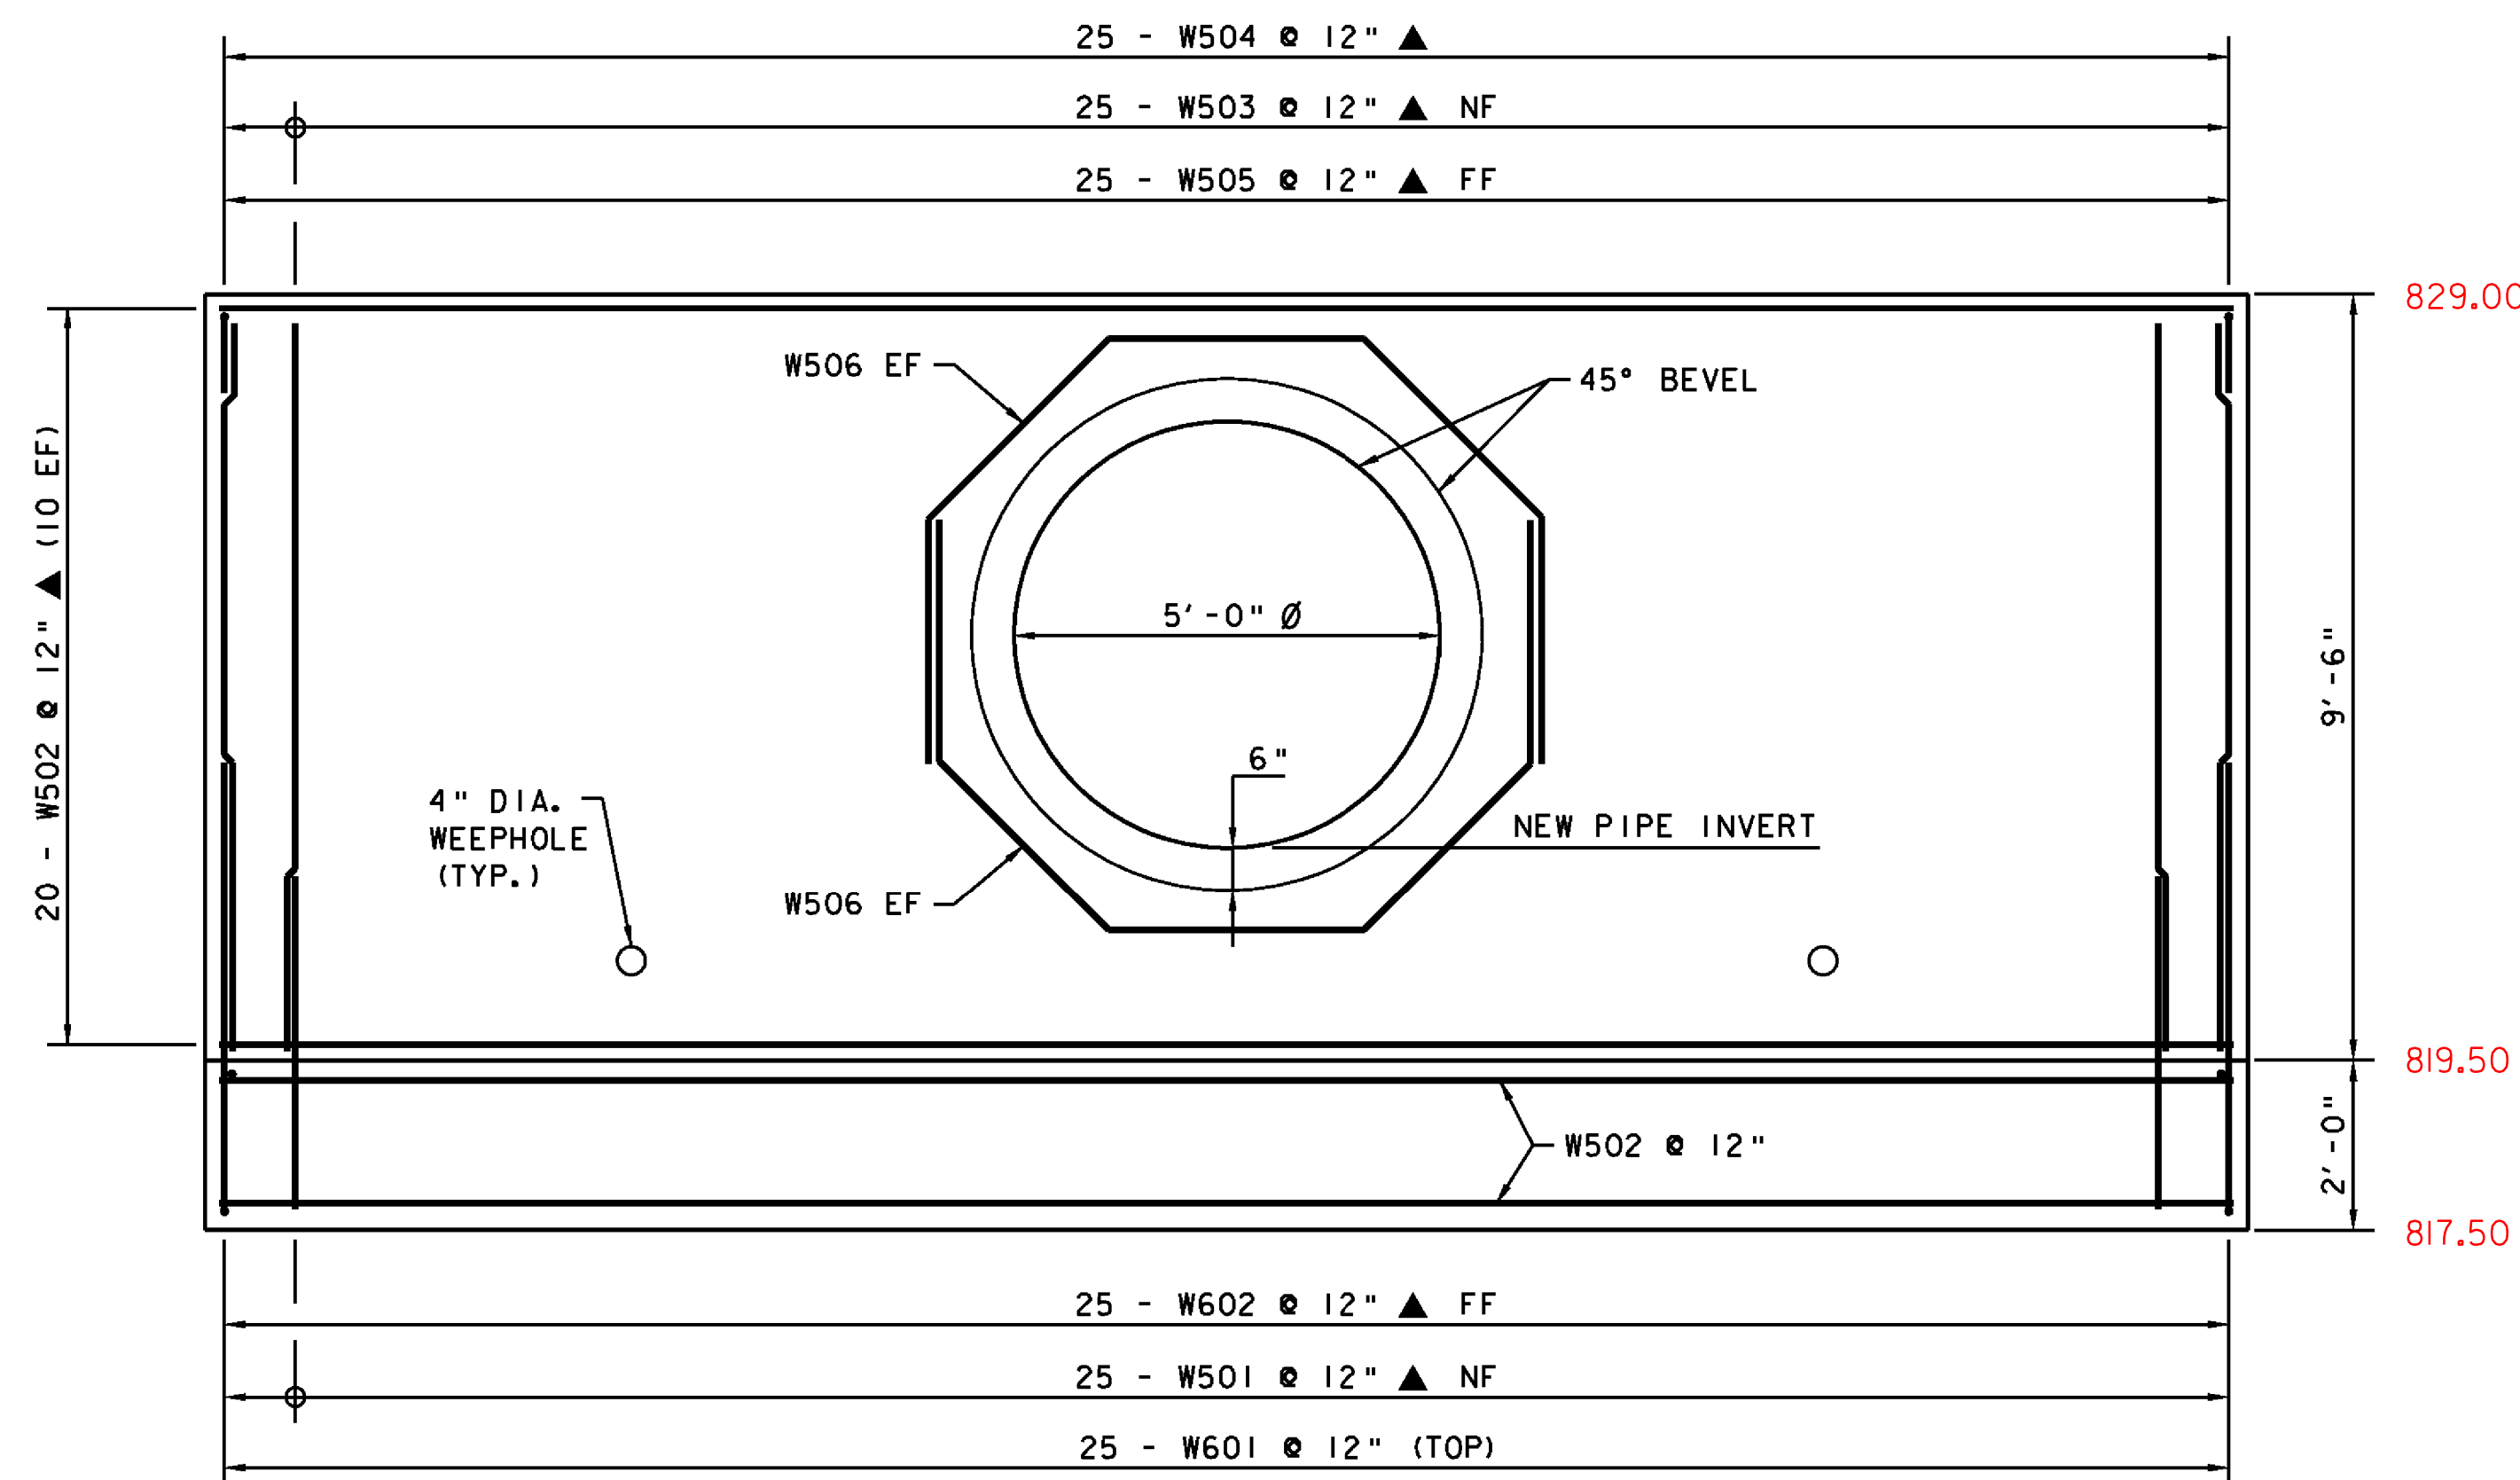

HEADWALL ELEVATION

SCALE 1/2" = 1'-0"

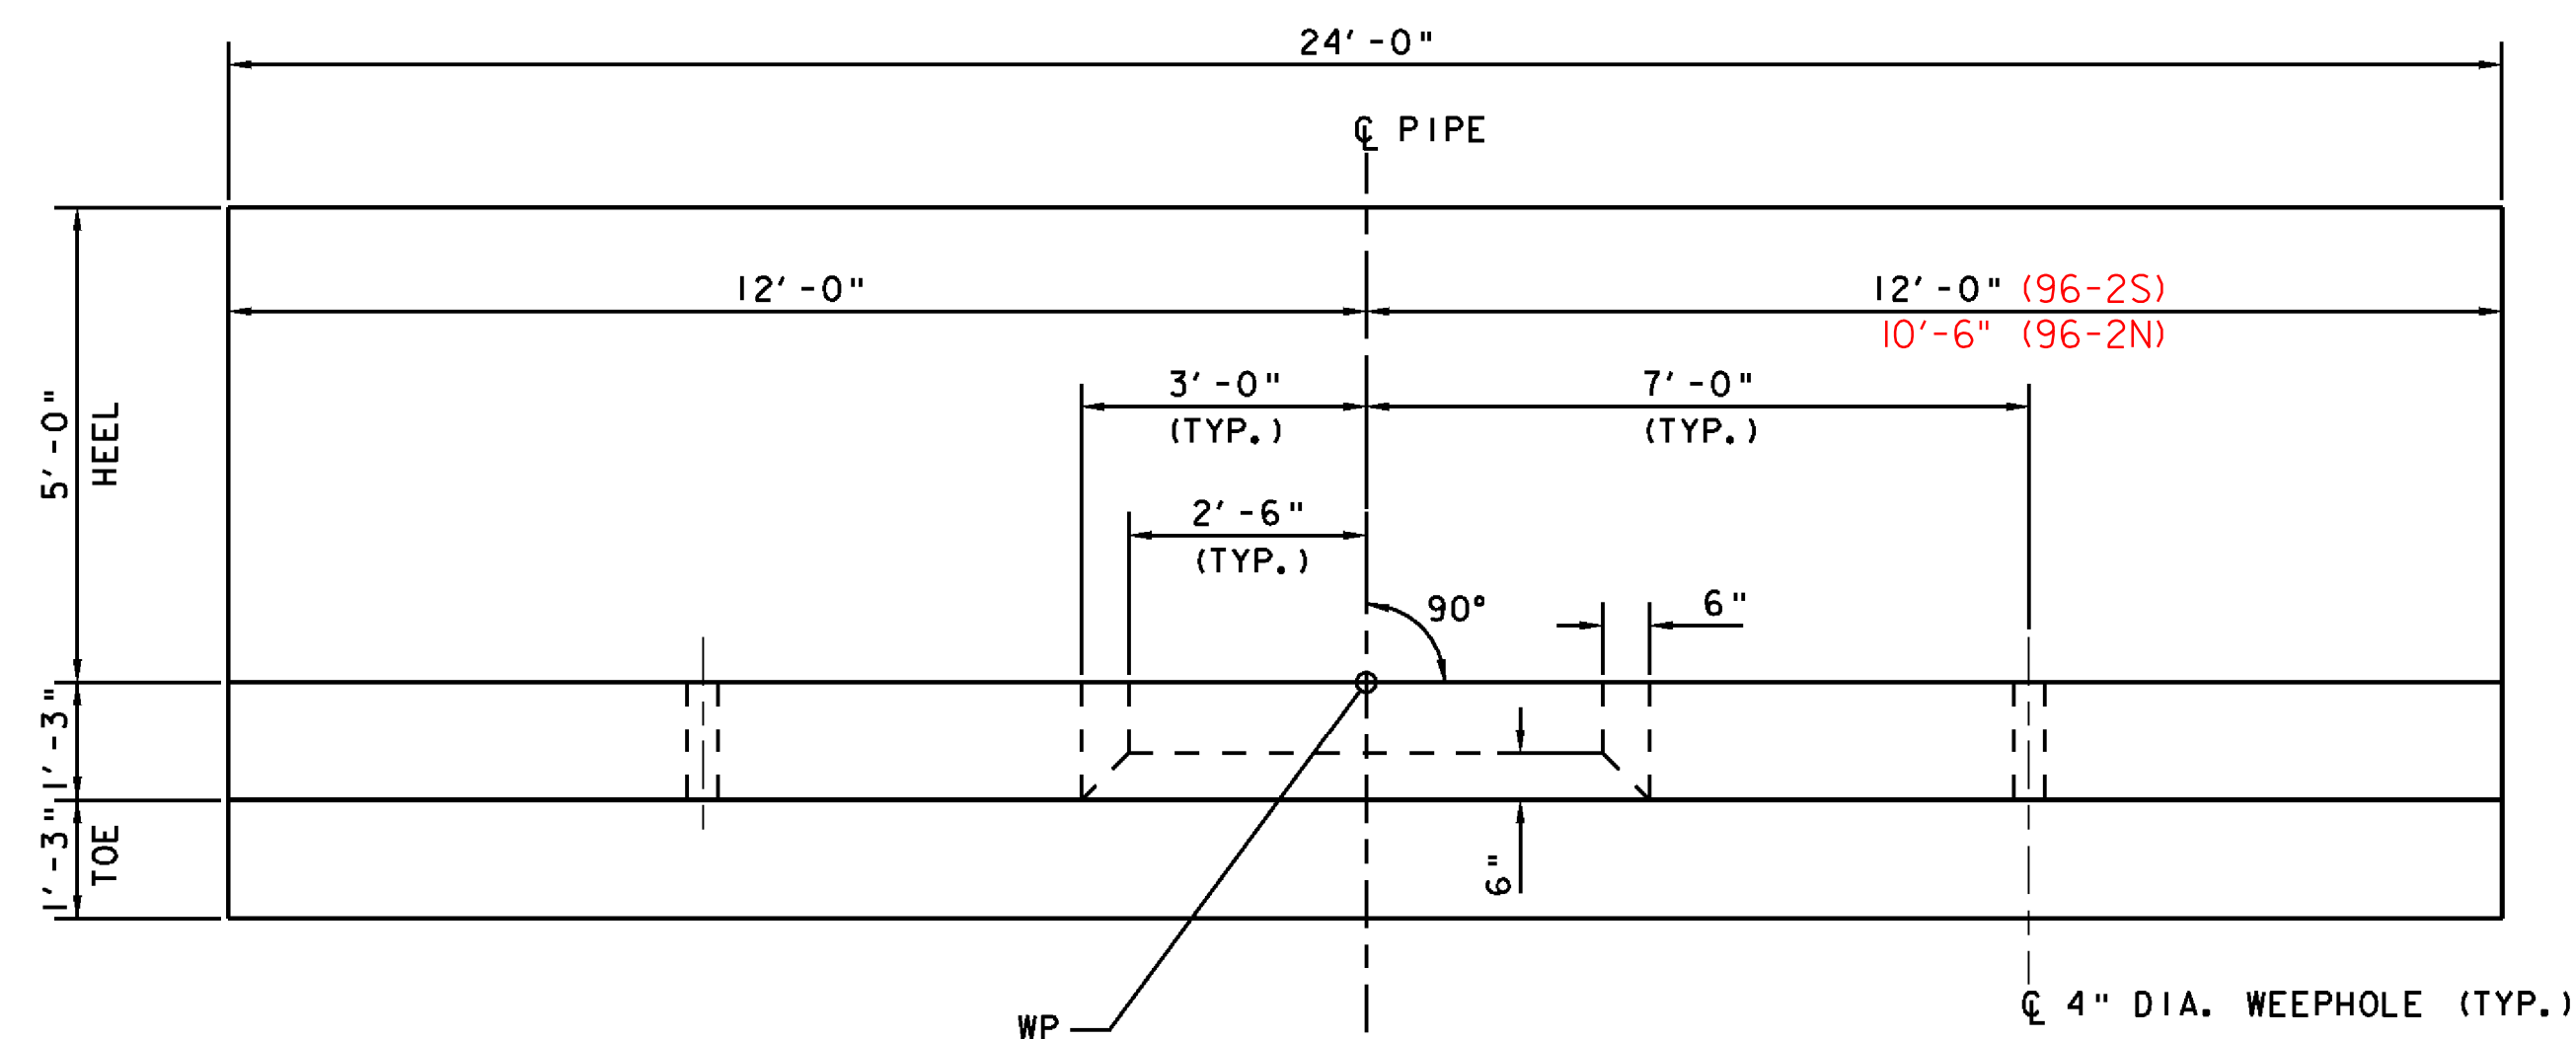

HEADWALL PLAN


SCALE 1/2" = 1'-0"

NOTE:

NF - NEAR FACE
FF - FAR FACE
EF - EACH FACE
▲ - CUT TO FIT IN FIELD
3" CLR. UNLESS OTHERWISE
SPECIFIED ON THE PLANS.


NOTES:

- HEADWALL DETAILS TO BE USED FOR BRIDGES 96-2S AND 96-2N.
- SEE STD. D-34 FOR CRADLE HEADWALL DETAILS.

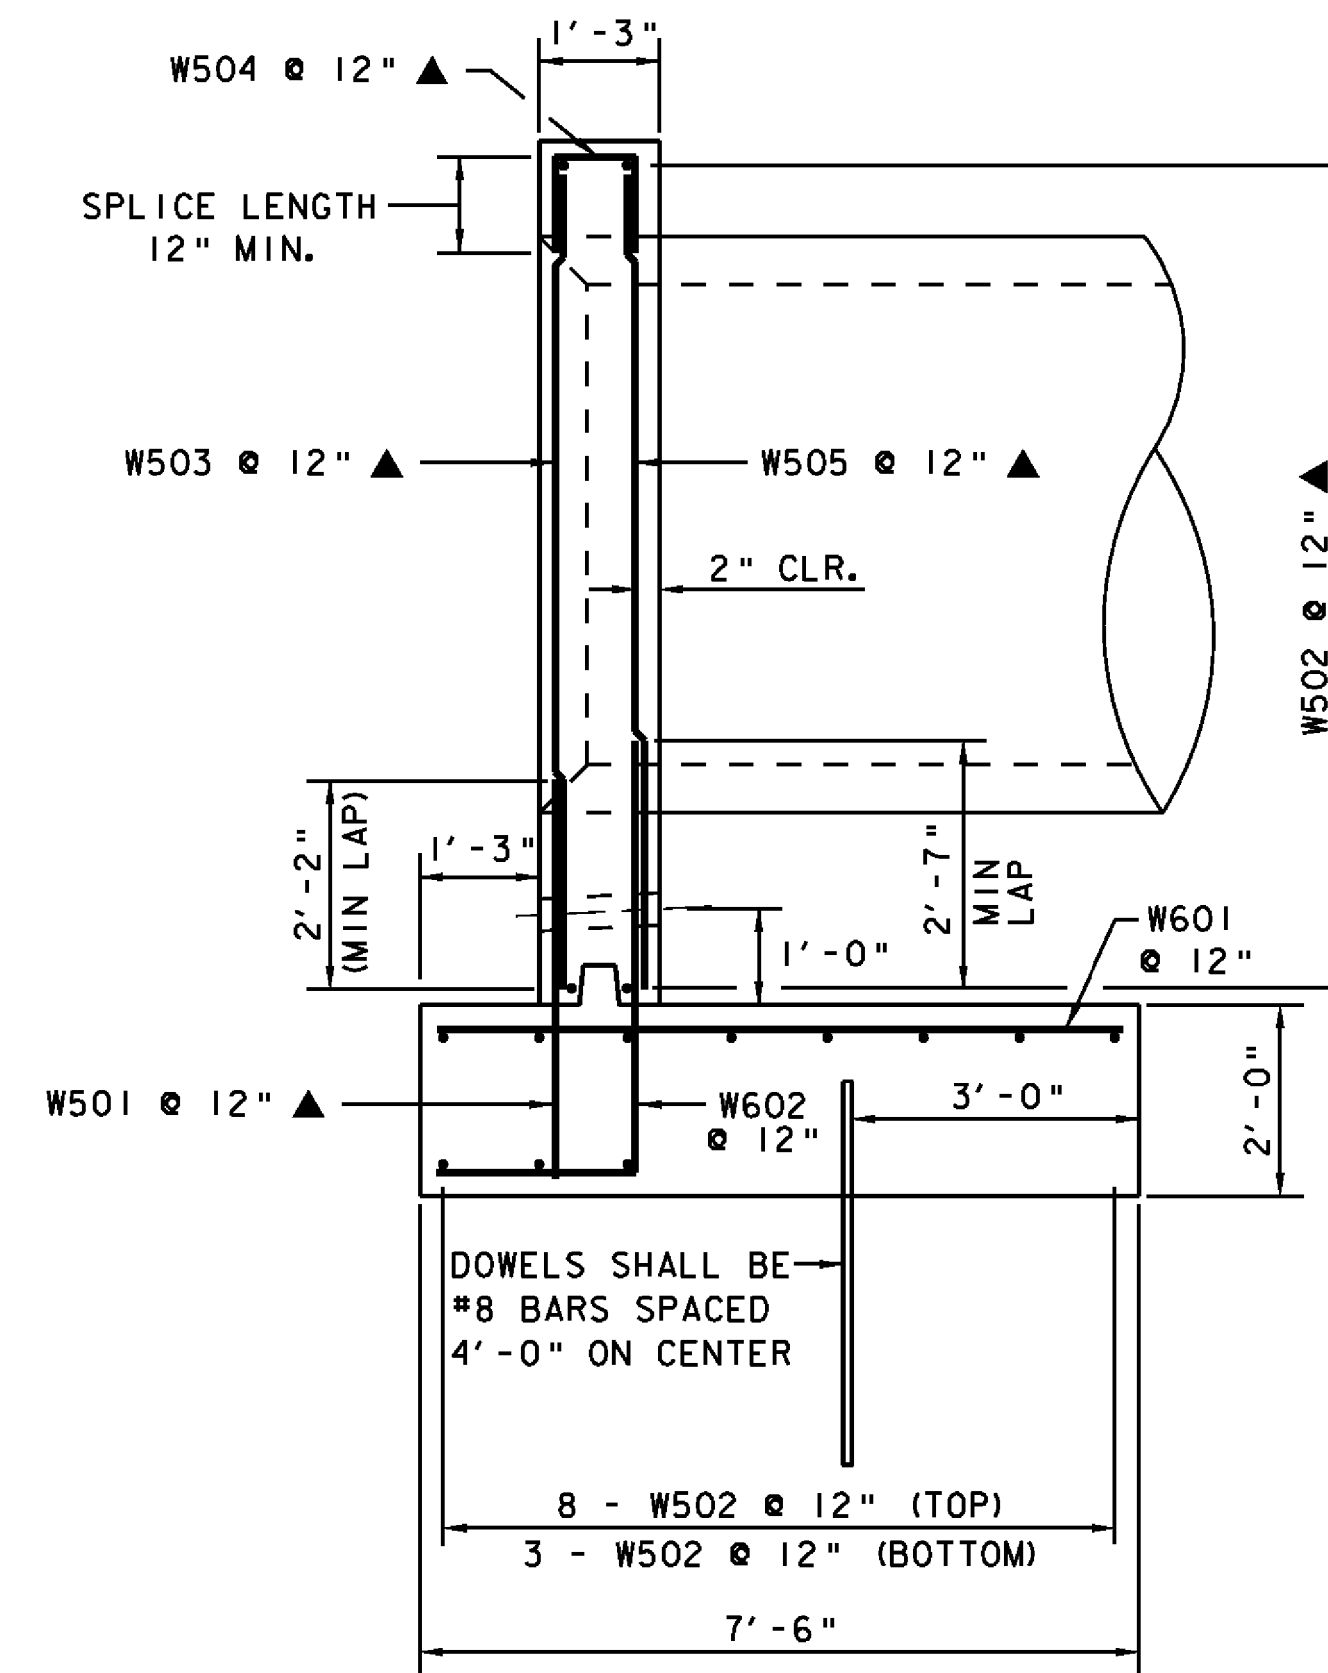


HEADWALL SECTION

SCALE 1/2" = 1'-0"

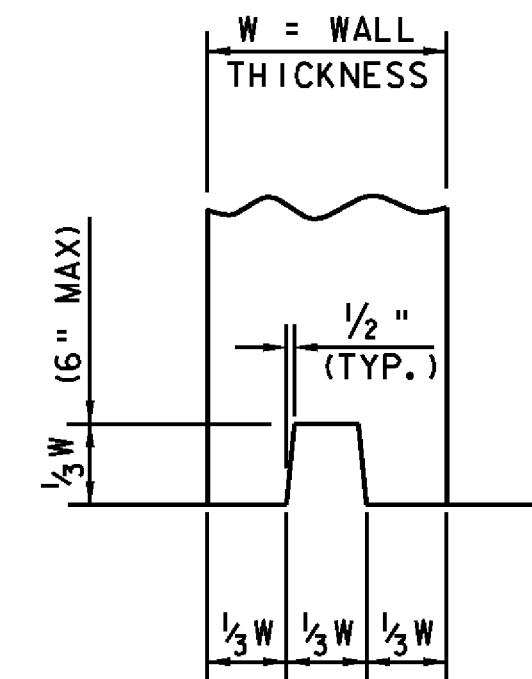

DETAIL 'A'
NOT TO SCALE

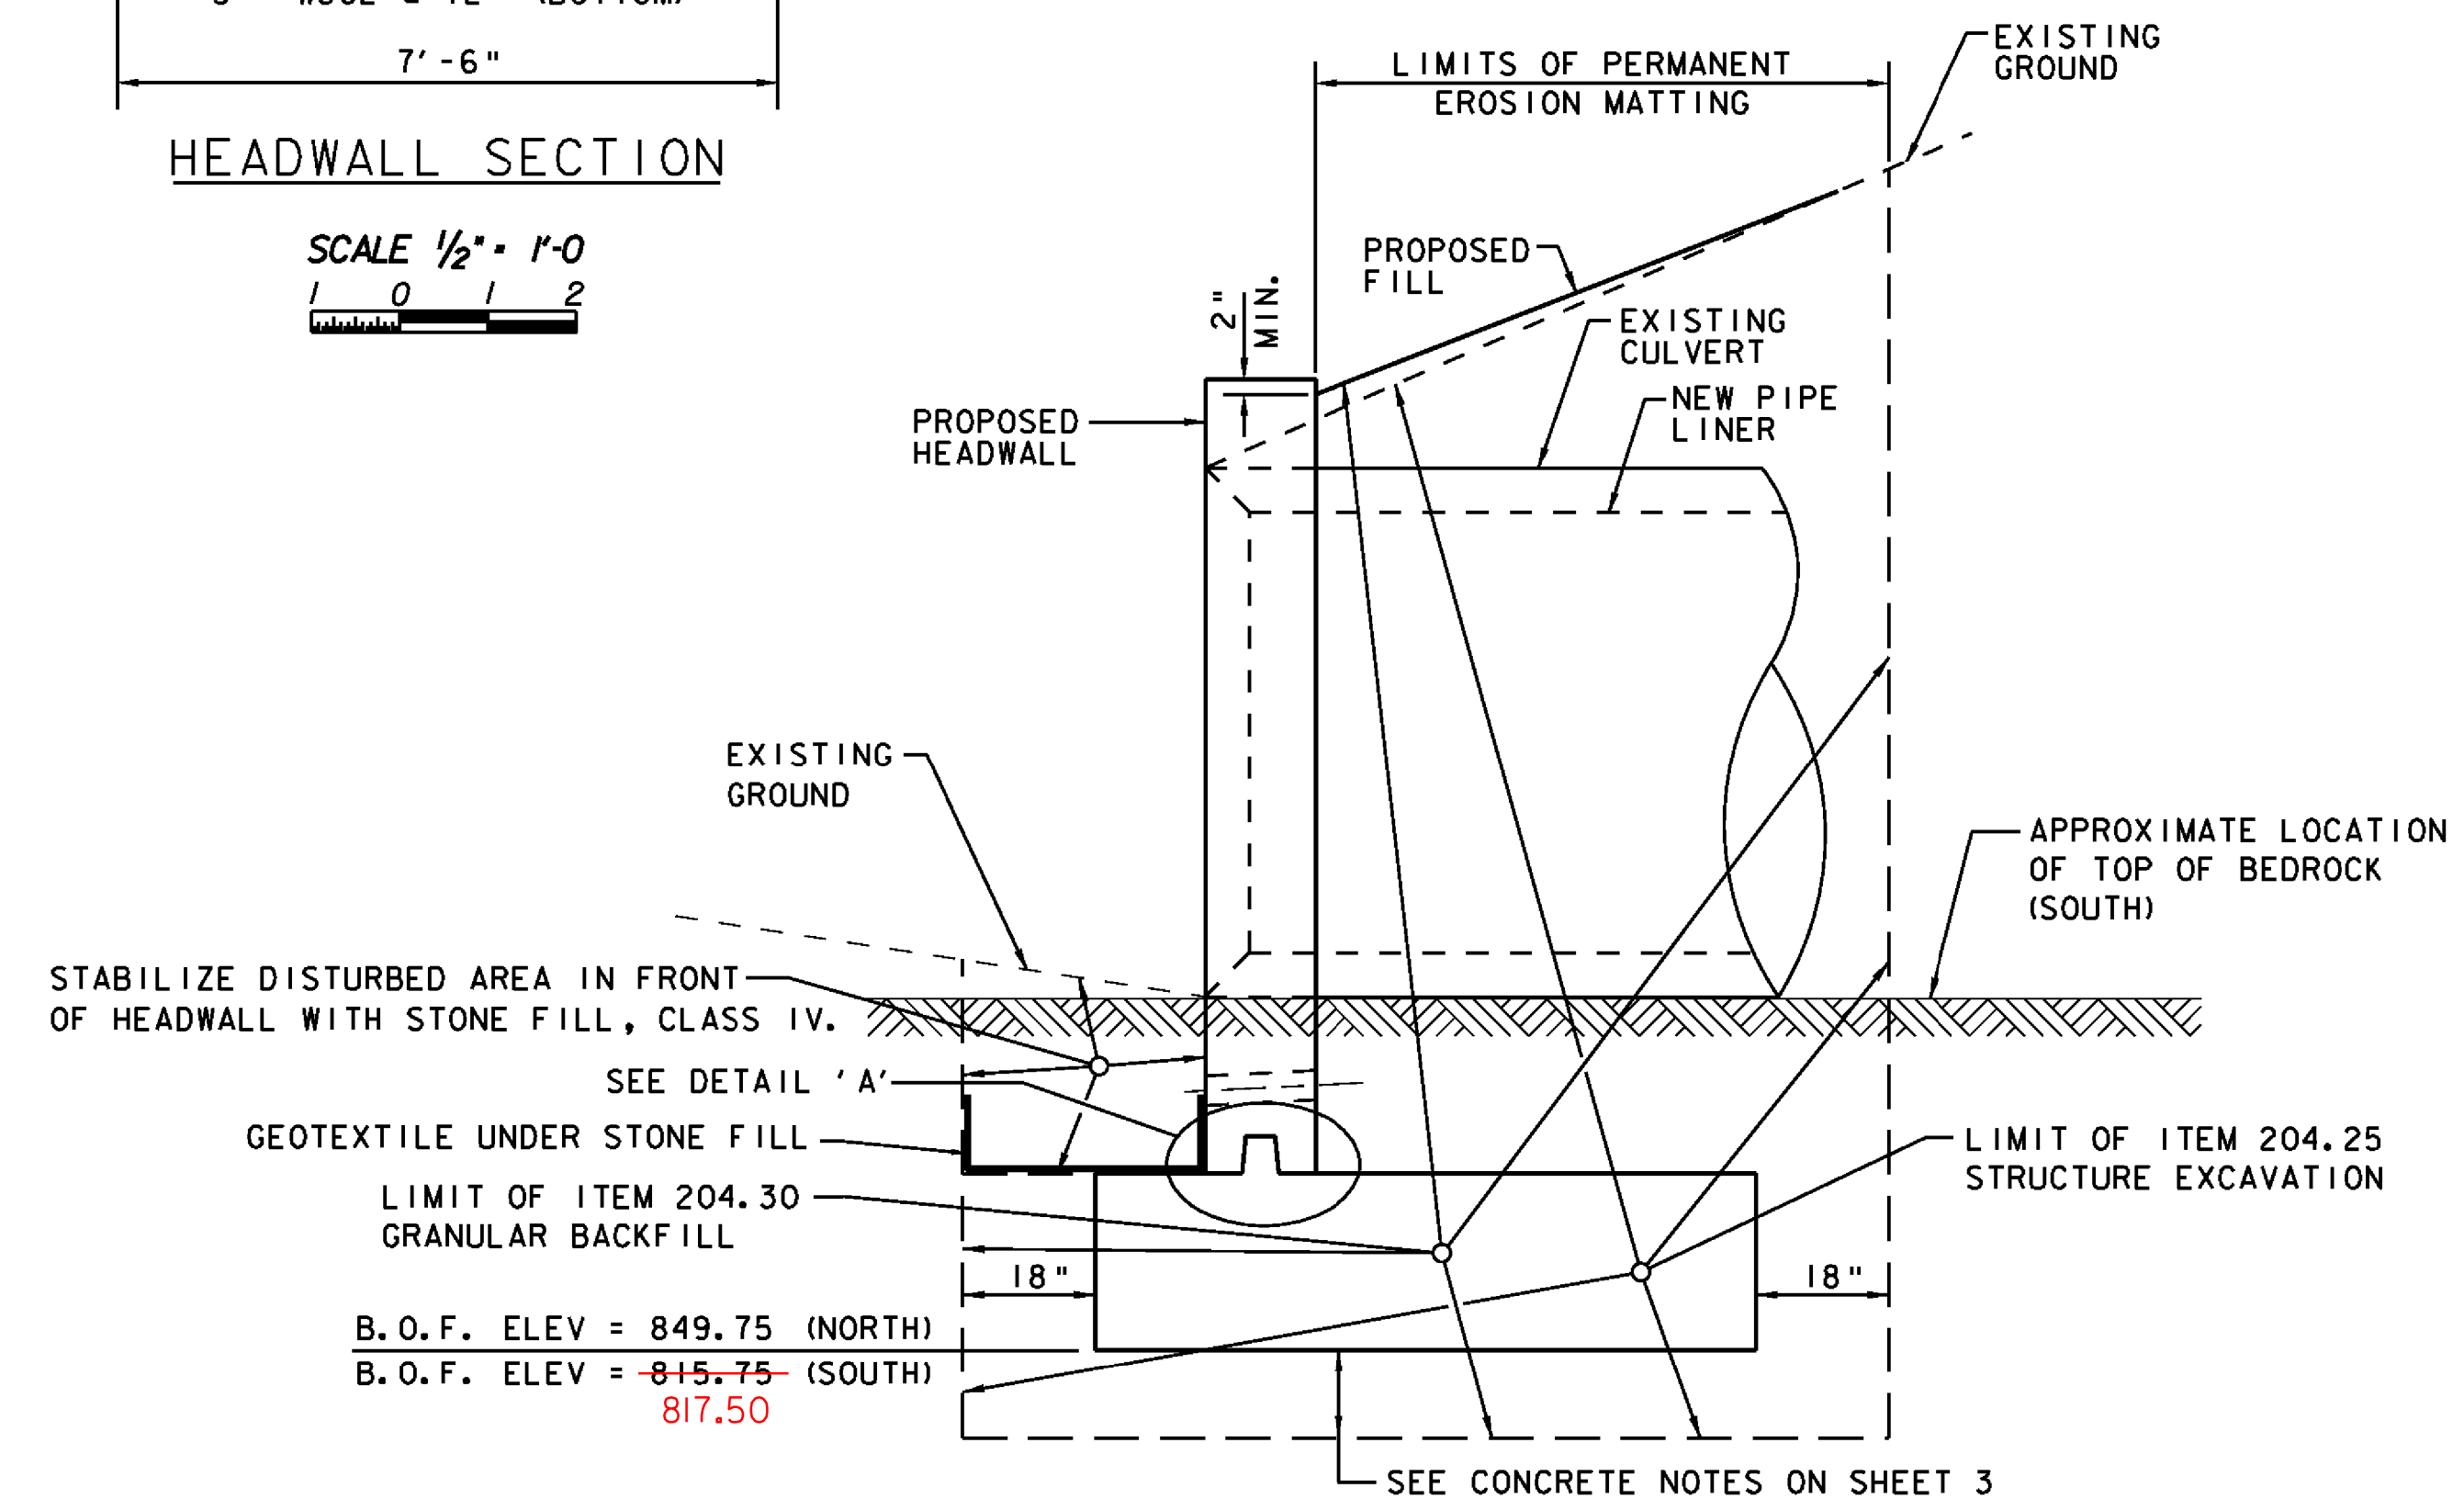

PROPOSED HEADWALL SECTION

SCALE 1/2" = 1'-0"

PROJECT NAME: LYNDON - DERBY
PROJECT NUMBER: IM CULV (I9)

FILE NAME: headwall72lyndon.dgn
PROJECT LEADER: DMB
DESIGNED BY: LKW
HEADWALL DETAILS - LYNDON 96-2N&S

PLOT DATE: 24-AUG-2009
DRAWN BY: SLM
CHECKED BY: WLD
SHEET 25 OF 28

