




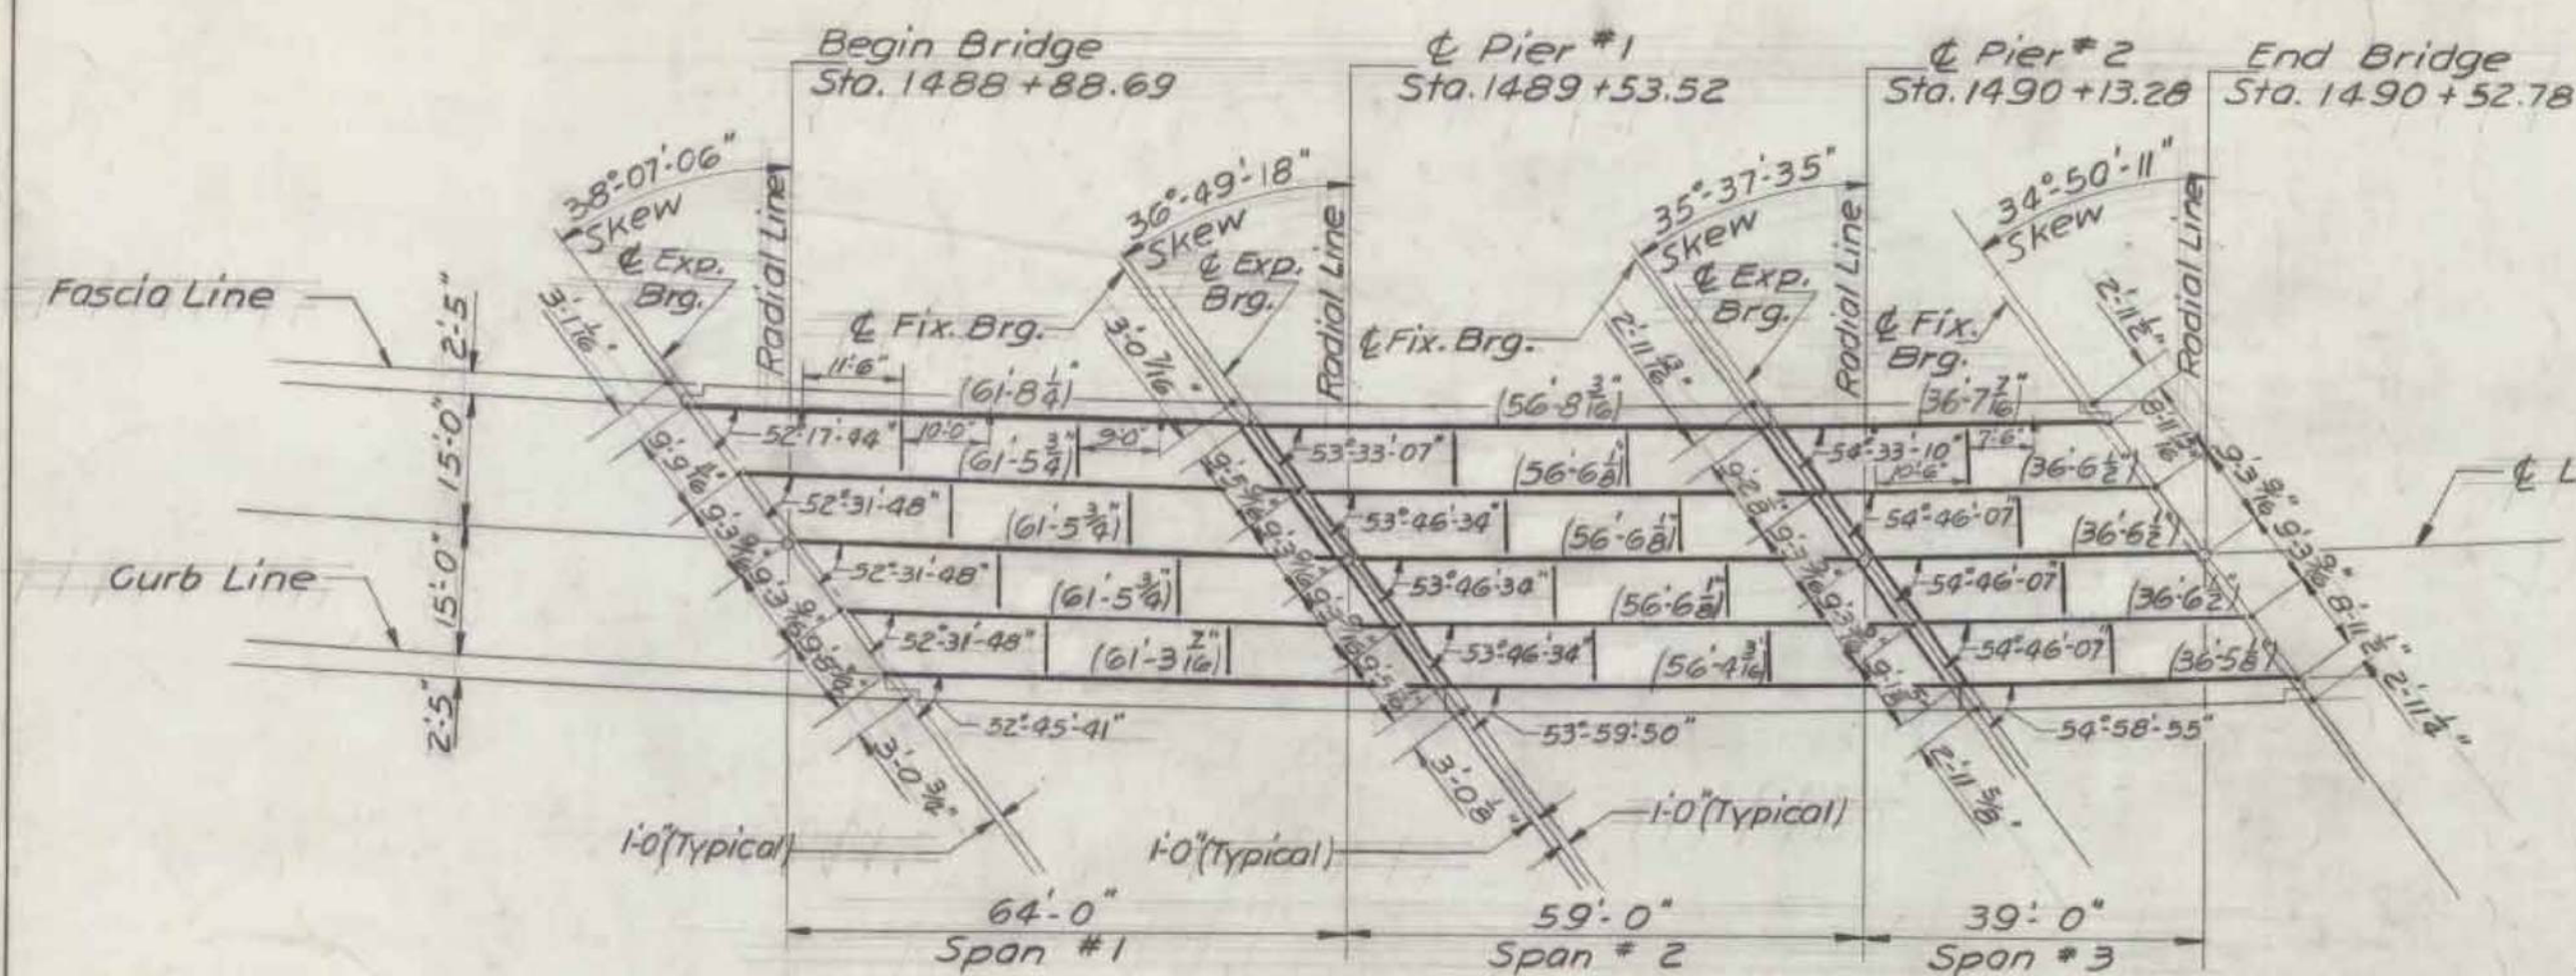


FRAMING PLAN - LEFT LANE
Scale: 1" = 20'

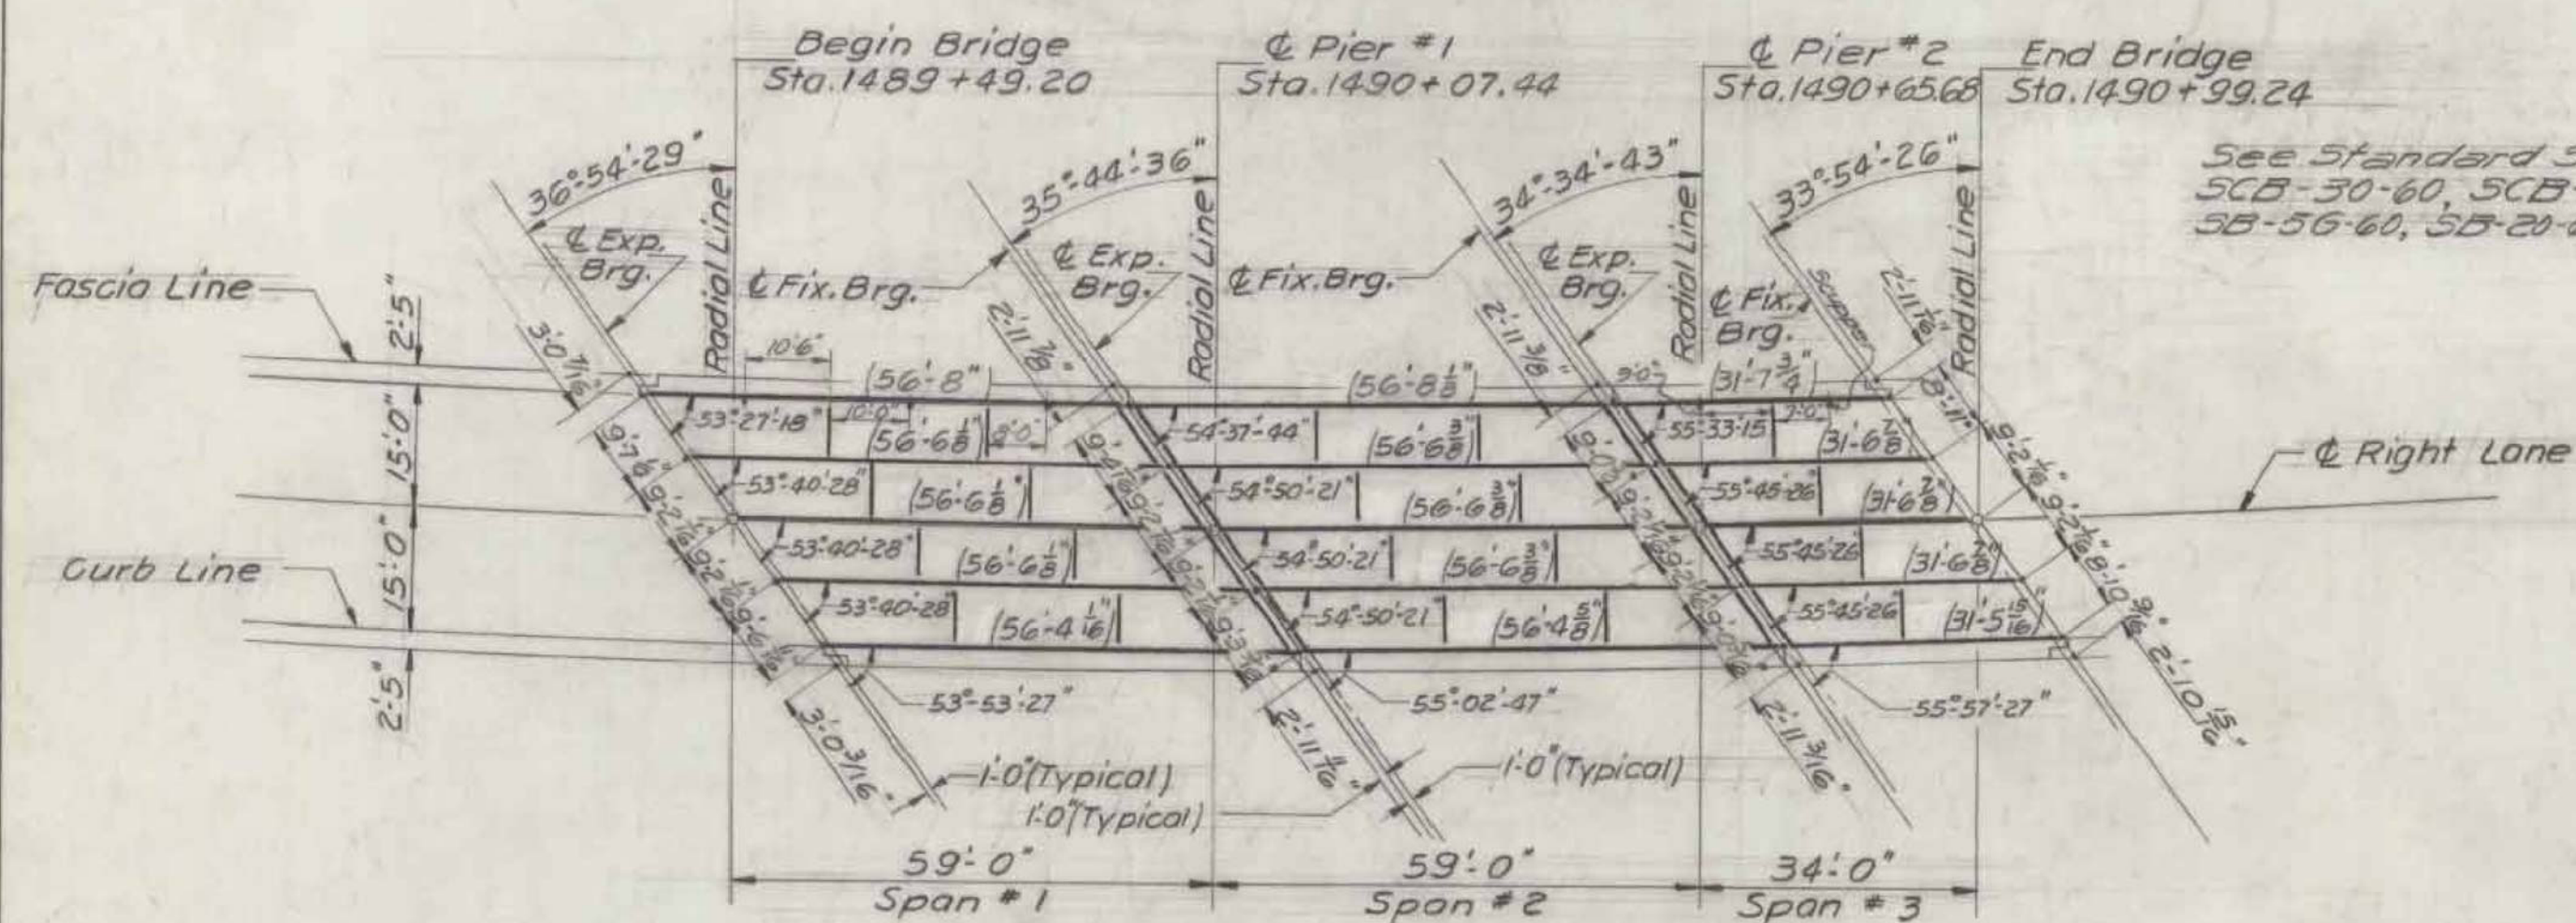


FRAMING PLAN - RIGHT LANE
Scale: 1" = 20'

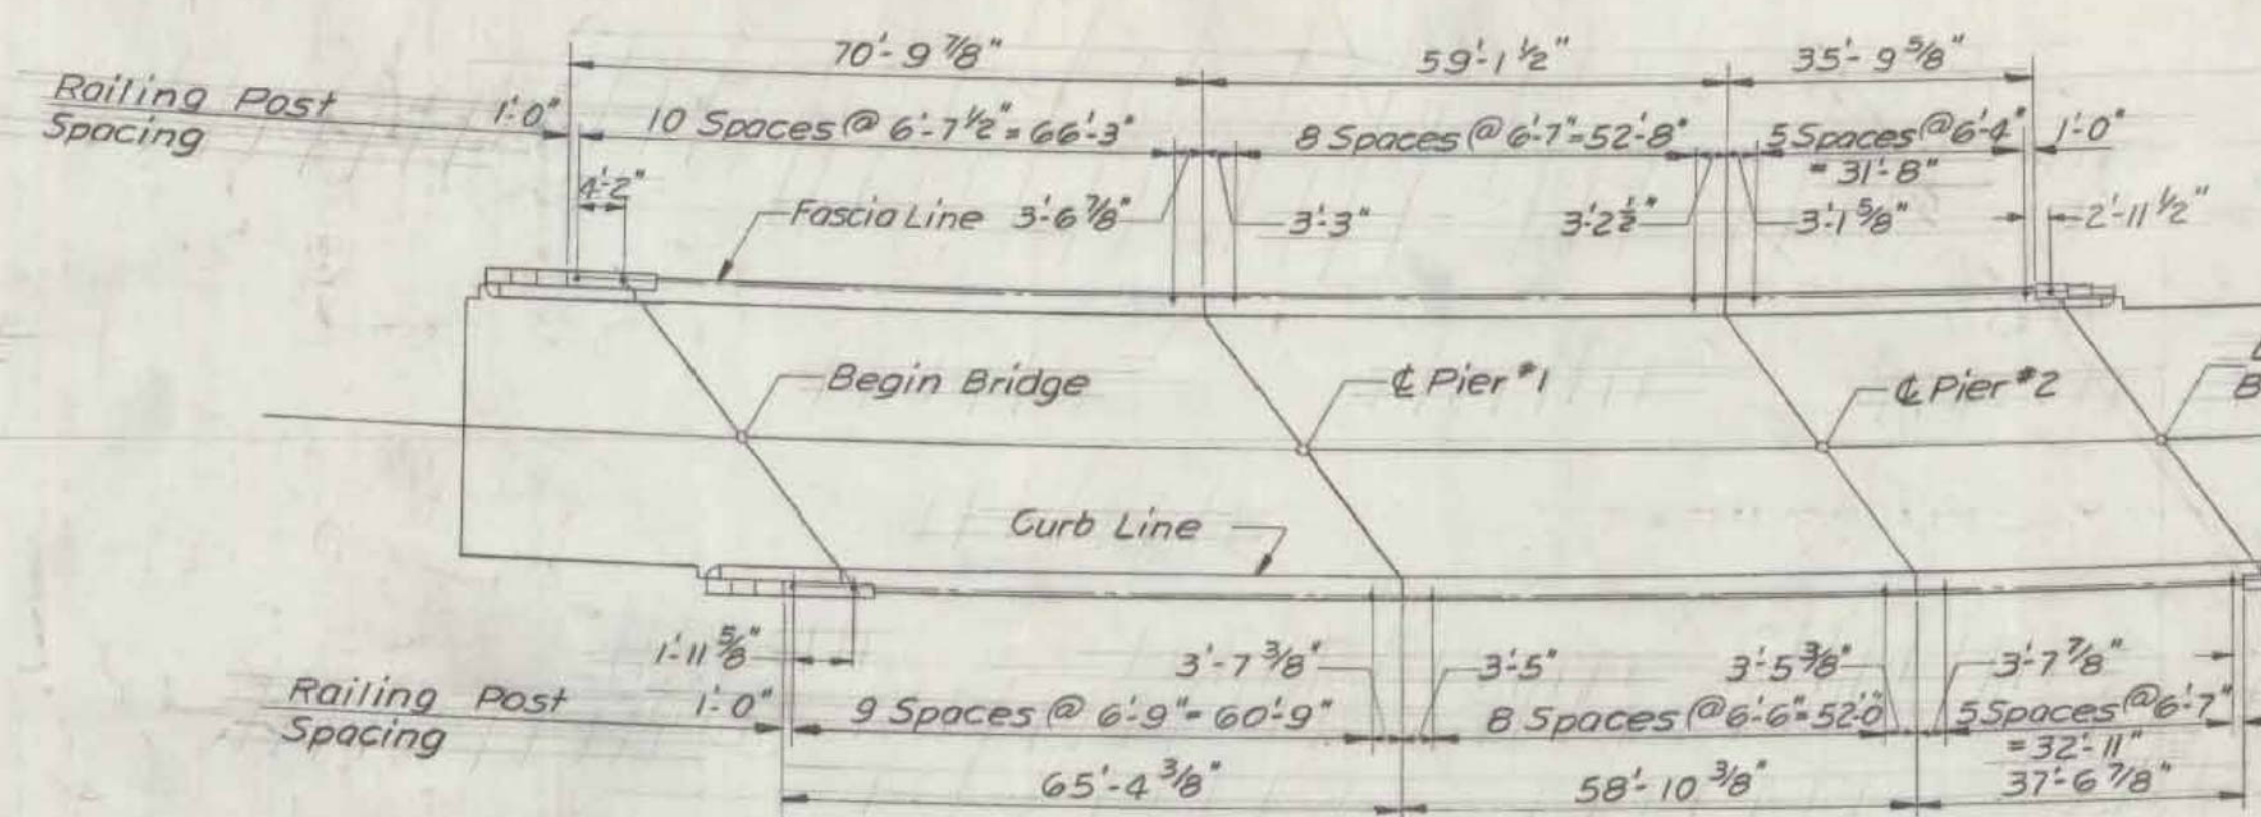

RAILING PLAN - LEFT LANE

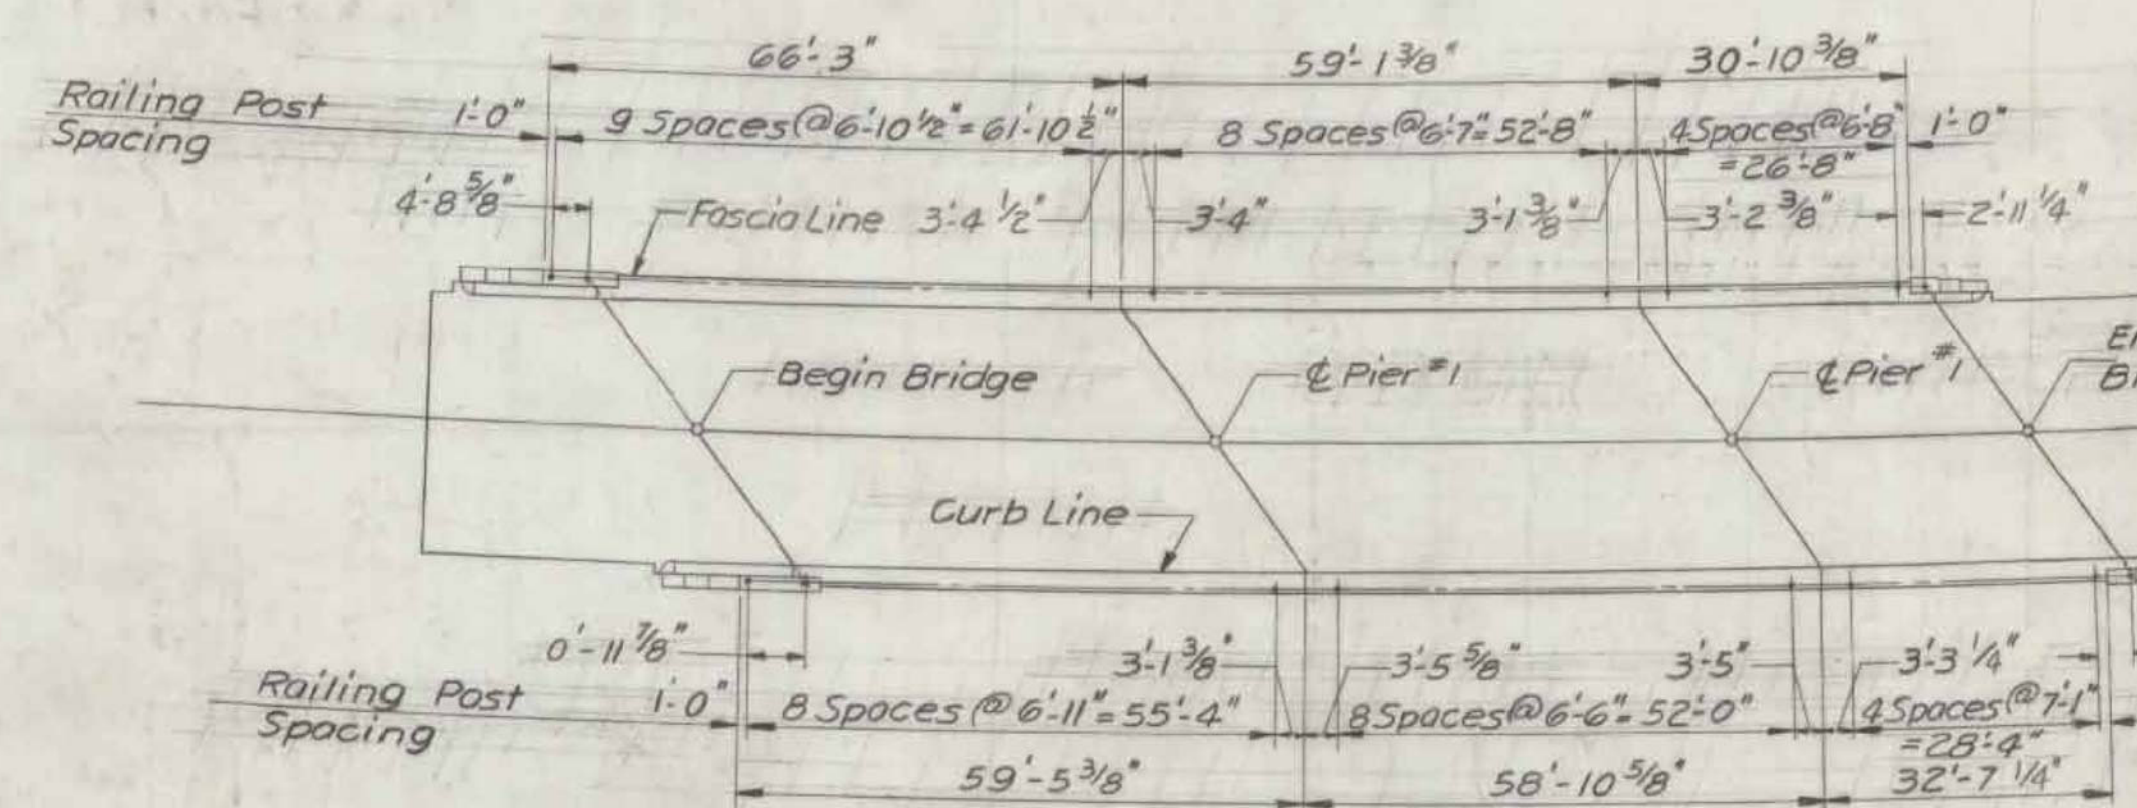

RAILING PLAN - RIGHT LANE

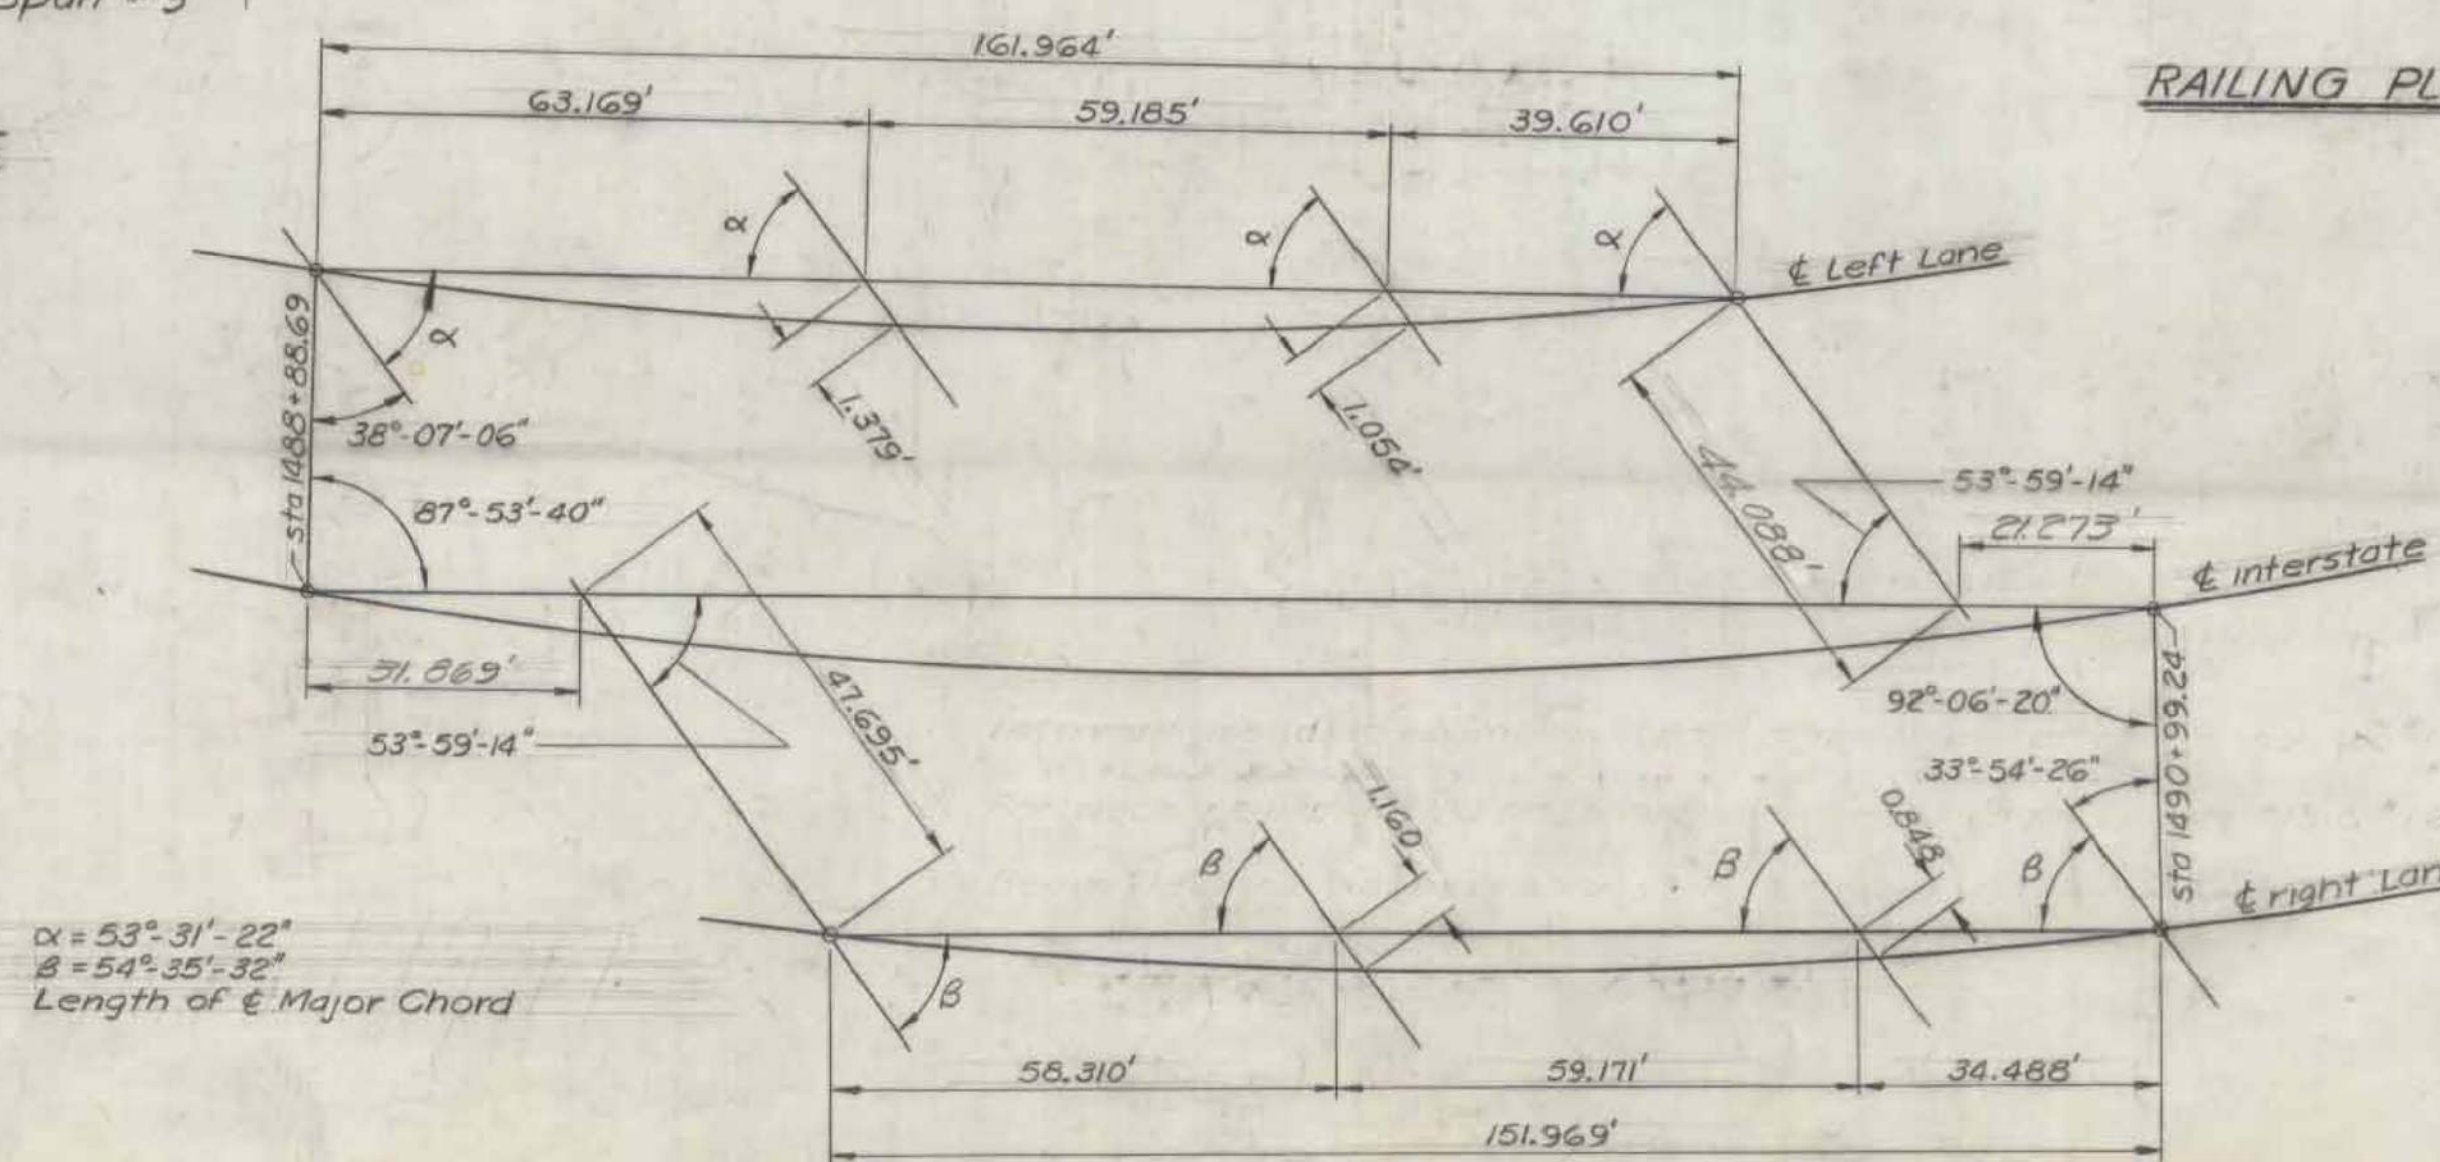

LAYOUT FROM MAJOR CHORD

NOTES

1. Intermediate diaphragm piers shall be 18' x 42'.
2. For deck reinforcing bars, use #15 & #16.
3. Beam lengths in parentheses are center to center of bearings.
4. The structural steel for the location and length shall be spaced at equal

RICHMOND
IM BPNT (3)
SHEET 8 OF 18
BRIDGE 55
FOR REFERENCE ONLY

STA
TOWN
INTER
F
& R
DESIGNED
DRAWN: H
PROJECT
CONTRACT